INDEX TO DRAWINGS	
SHEET NO.	DESCRIPTION
1	TITLE SHEET
2	TYPICAL SECTION
3	DETAIL PLAN
4	CULVERT EXTENSION DETAIL
5 - 7	CROSS SECTIONS
8	STANDARD DETAIL

STATE OF HAWAII DEPARTMENT OF TRANSPORTATION DIVISION OF HIGHWAYS HONOLULU, HAWAII


IMPROVEMENT OF THE


INTERSECTION OF FARRINGTON HIGHWAY & BARBERS POINT INDUSTRIAL PARK ACCESS RD.

EWA, OAHU, HAWAII

PROJECT NO. B-900-01-60 DISTRICT OF EWA ISLAND OF OAHU

AS BUILT PLANS

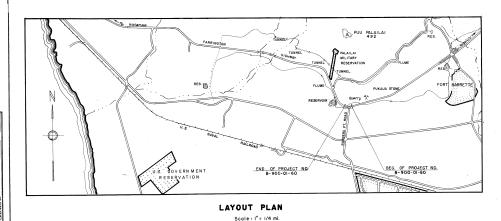

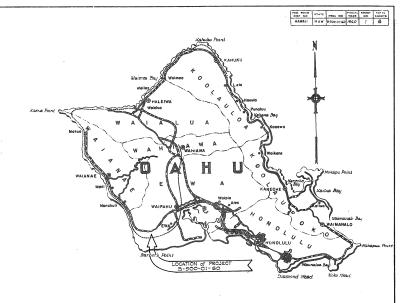

NOTE:
ALL CHANGES MADE DURING CONSTRUCTION
HAVE BEEN NOTED ON THESE TRACINGS IN
RED AND CHECKED BY:

DATE 6/20/60

SHEET No. 1 OF 8 SHEETS

