

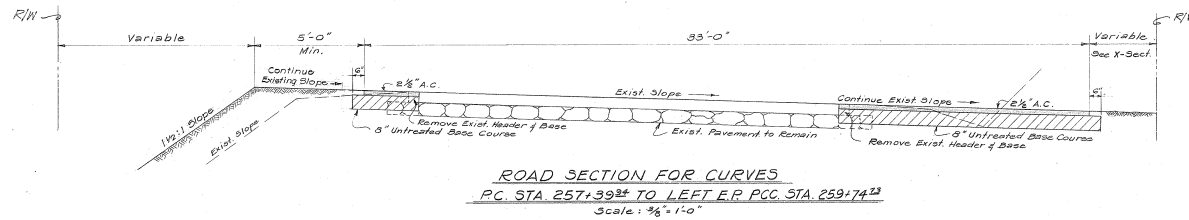
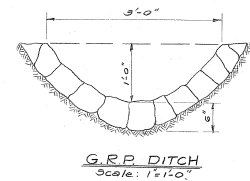
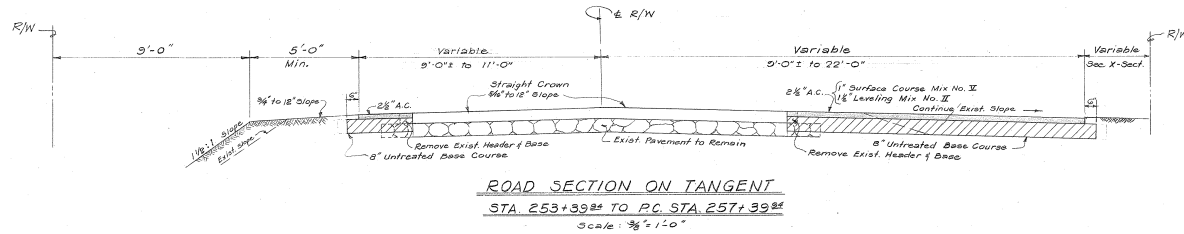


FED. ROAD DIST. NO.	STATE	PROJ. NO.	FISCAL YEAR	SHEET NO.	TOTAL SHEETS
	HAWAII	B-900-01-60	1960	2	8

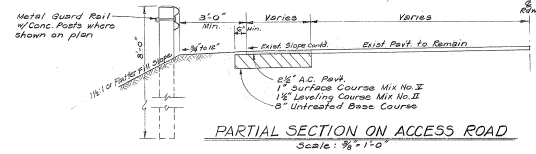

GENERAL NOTES:

- Asphalt Concrete Pavement shall consist of 1" surface course mix No. II and 1 1/2" leveling course mix No. II.
- Prime Coat: Emulsified asphalt mixing type for prime coat shall be applied to the surface of the base course at the rate of 0.35 gal. per sq. yd. before placing leveling course.
- Base Course: Base course shall consist of 1 1/2" max. size aggregate, untreated base, and shall be laid in two layers of 4" compacted thickness each.
- Surface of the existing pavement shall be broomed and given one coat of 0.6 gal. per sq. yd. of emulsified asphalt before laying variable thickness of 1 1/2" max. No. II leveling course or A.C. mix No. II surface course wherever the latter mix is placed directly on existing pavement. Task cost shall be incidental to the A.C. pavement and shall not be paid for separately.

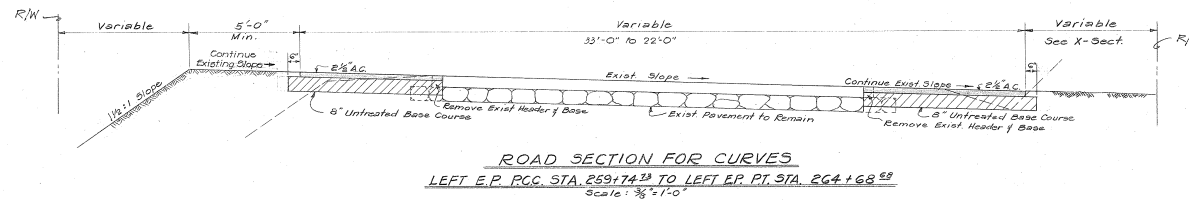

DEPARTMENT OF TRANSPORTATION
STATE OF HAWAII
TYPICAL SECTION
PROJECT No. B-900-01-60
IMPROVEMENT OF THE
INTERSECTION OF FARRINGTON HWY.
& BARBERS PT. INDUSTRIAL PARK
ACCESS ROAD
Scale: As Noted June 1960

DESIGNED BY	DATE
CHECKED BY	
APPROVED BY	
NOTED BY	
REVISIONS	
NO.	