

INDEX TO DRAWINGS	
SHT. NO.	DESCRIPTION
1	TITLE SHEET
2	TYPICAL SECTIONS
3 - 5	PLAN & PROFILE
6	CONNECTIONS & MISC. DETAIL
7	CULVERT PROFILES
8 - 12	BOX CULVERTS
13 - 15	STANDARD DETAILS
15A	TYPICAL CROSS SECTIONS

STATE OF HAWAII

DEPARTMENT OF TRANSPORTATION

HIGHWAYS DIVISION

HONOLULU, HAWAII

AS BUILT

KAENA POINT ROAD


KAENA POINT TRACKING STATION ACCESS ROAD TOWARD MAKUA

FEDERAL DEFENSE ACCESS

PROJECT NO. R-AD 2 (I)

DISTRICT OF WAIANAE
ISLAND OF OAHU

	SCALE		
PLAN	1"	=	100'
PROFILE	HOR. 1"	=	100'
	VERT. 1"	=	10'

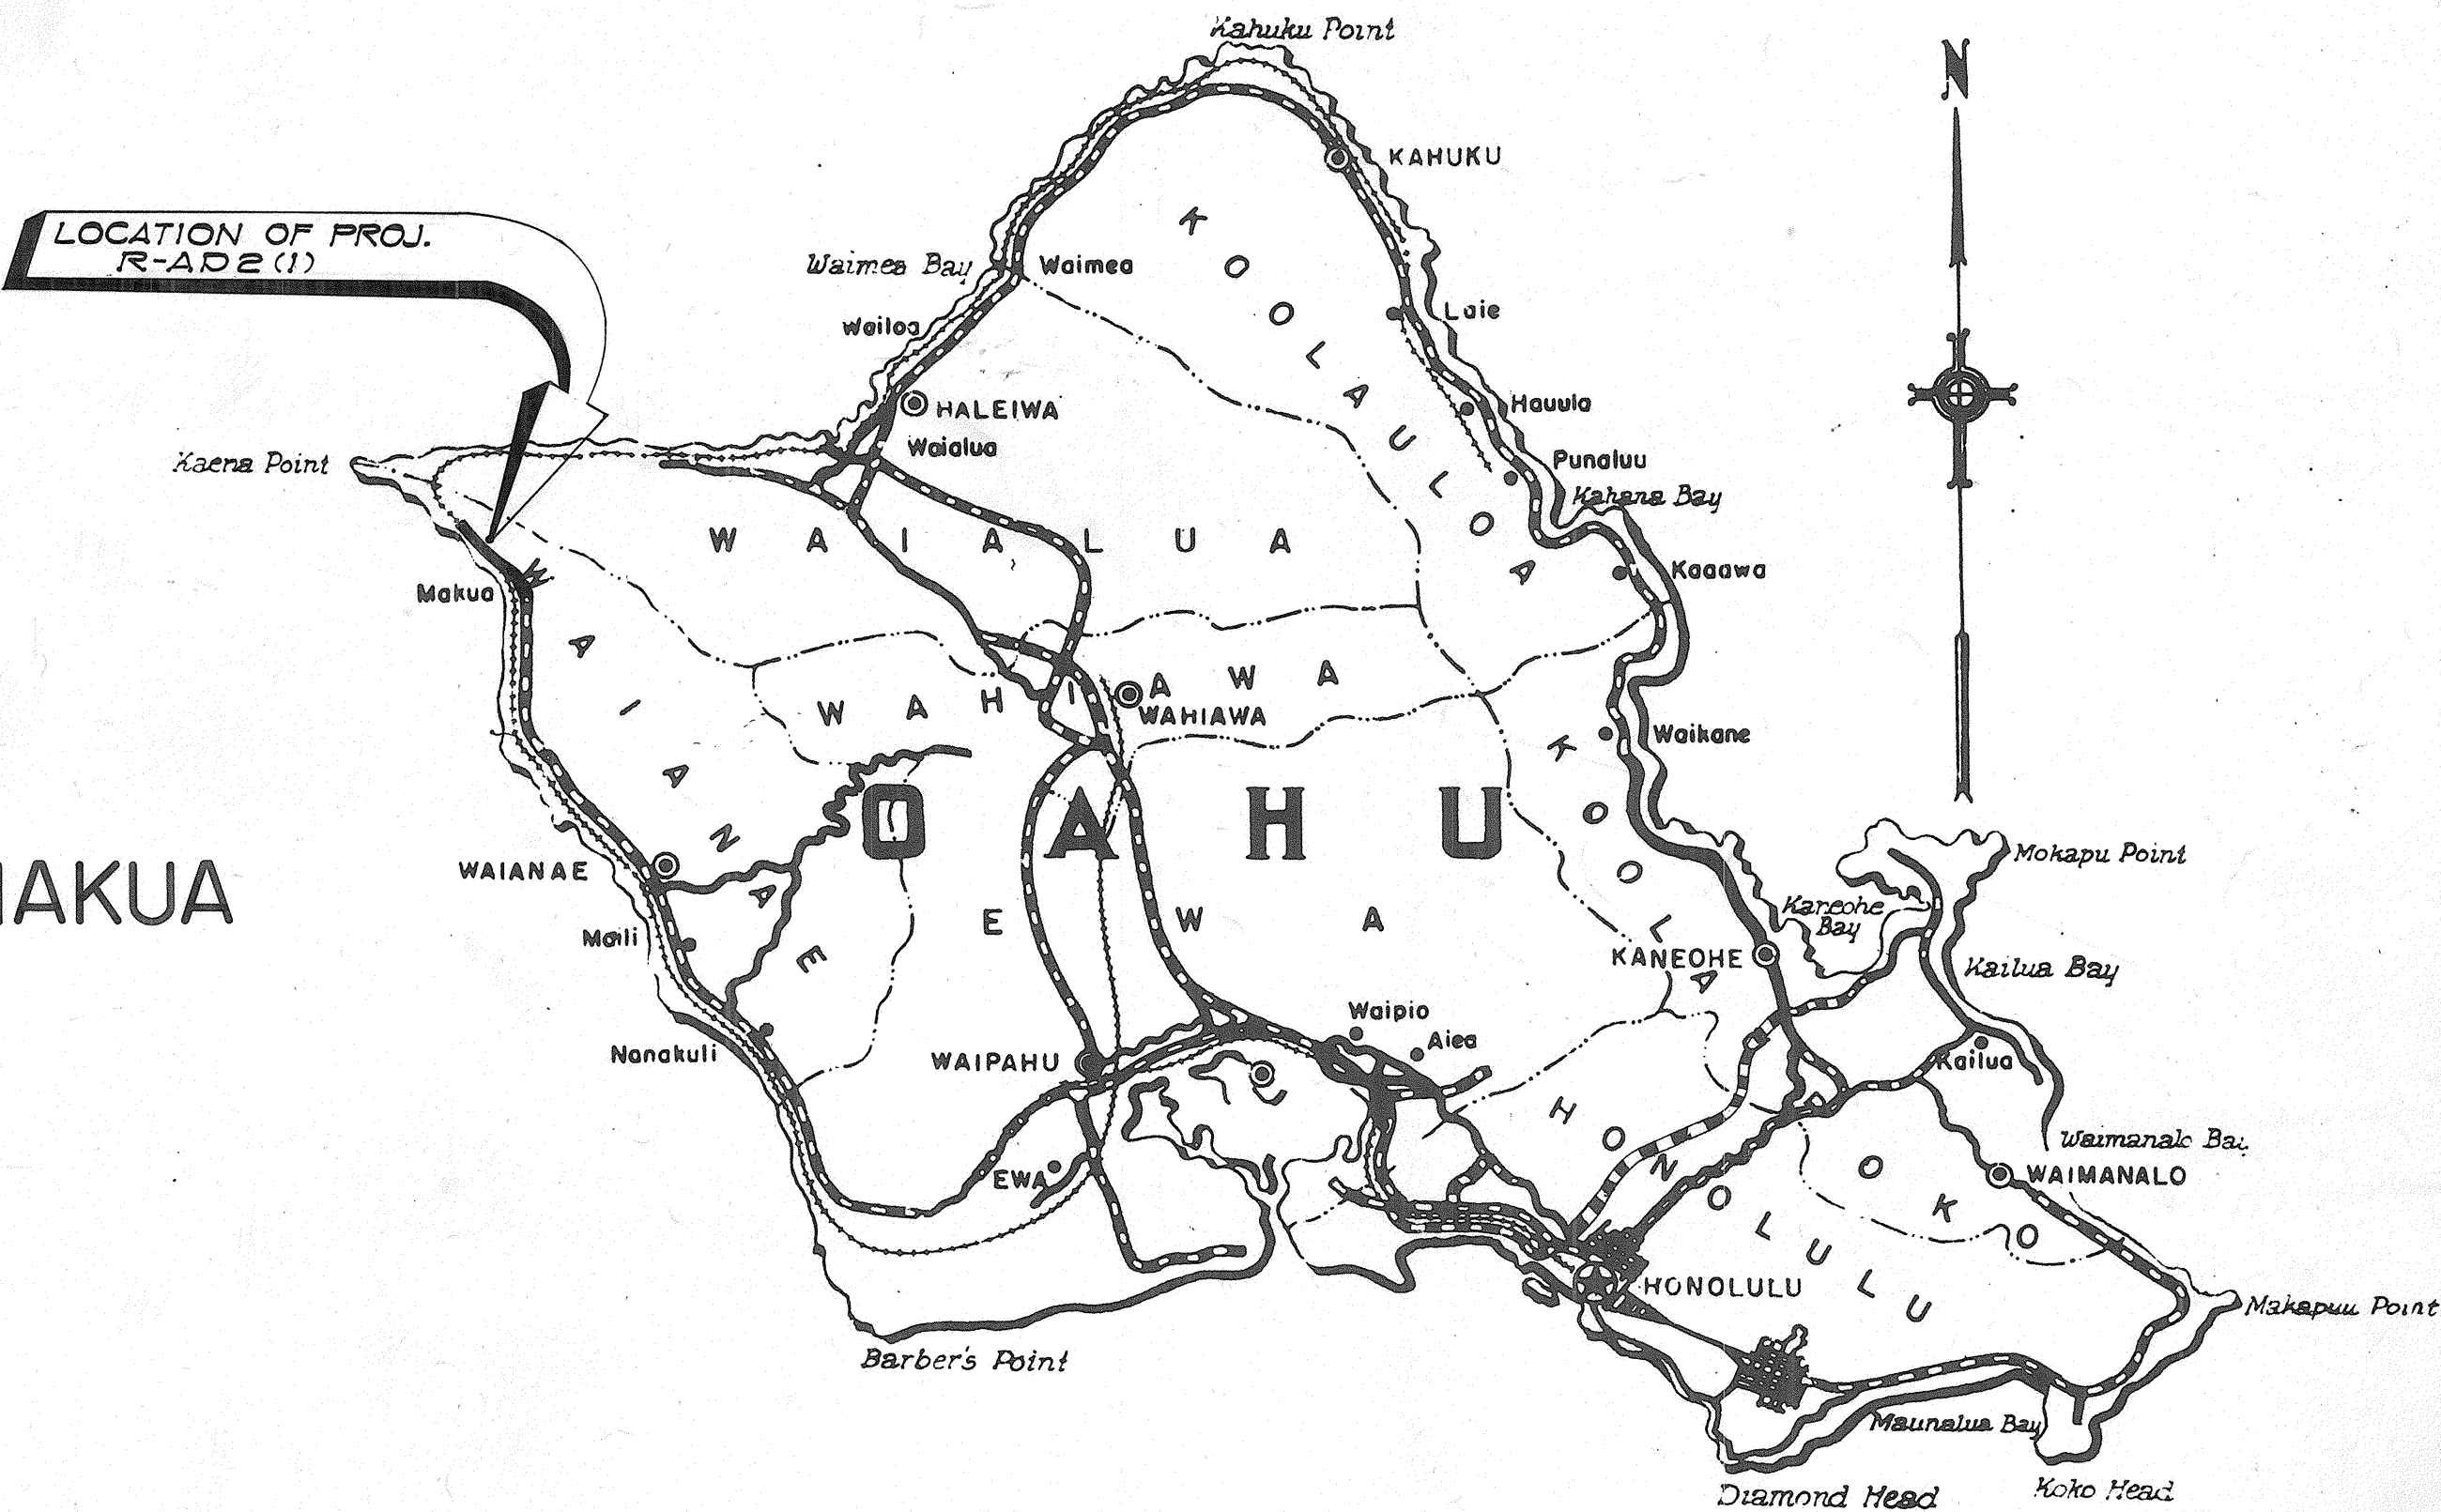

Federal Aid Projects Previously Constructed Or Under Construction

DESIGN CLASSIFICATION

ADT (1962)	600
ADT (1982)	1,700
DHV	13 %
D	75/25
T	5 %
V	50 M.P.H.

NOTE: ALL CHANGES MADE DURING
CONSTRUCTION ARE SHOWN
IN RED ON THESE TRACINGS
AND CHECKED BY.

George K. Waite

RESIDENT ENGINEER

July 19, 1966

DATE

APPROVED: DATE:

Kaipo G. Kauka

ACT'G DIRECTOR OF TRANSPORTATION


DEPARTMENT OF COMMERCE

BUREAU OF PUBLIC ROADS

APPROVED:

DIVISION ENGINEER

DATE

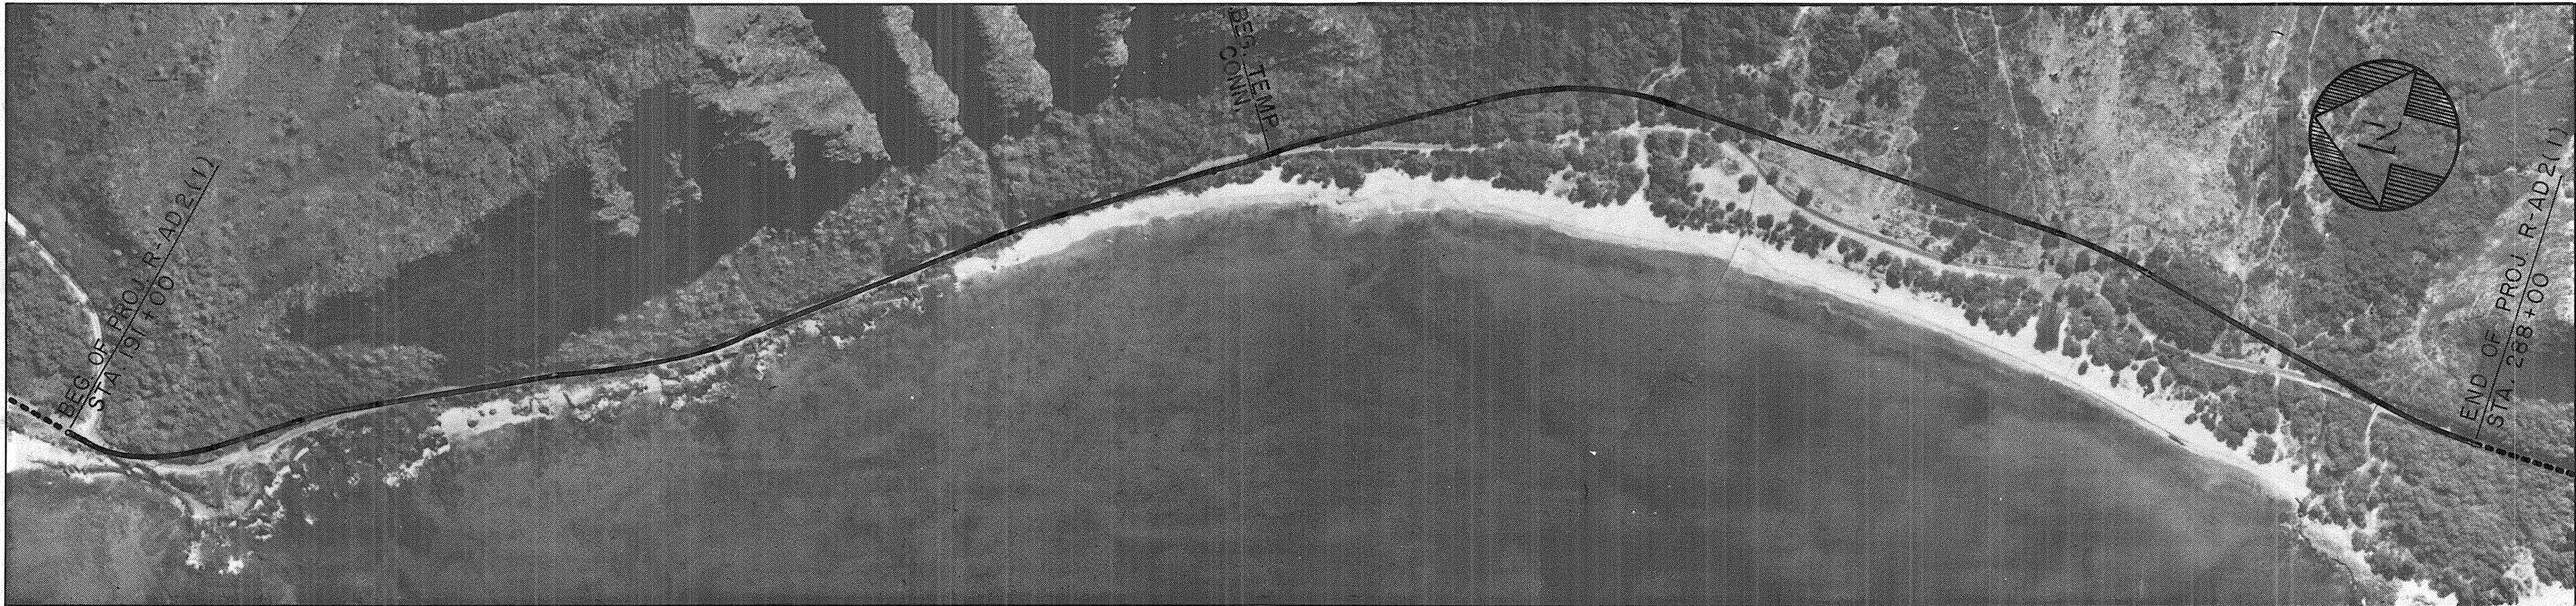

LAYOUT PLAN

SCALE: 1" = 500'

GROSS & NET LENGTH OF PROJECT.....1.837 Mi.

SURVEY PLOTTED BY	DATE
DESIGNED BY	
TRACED BY	
QUANTITIES CHECKED BY	
CHECKED BY	
ORIGINAL PLAN	
NOTE BOOK	
No.	