

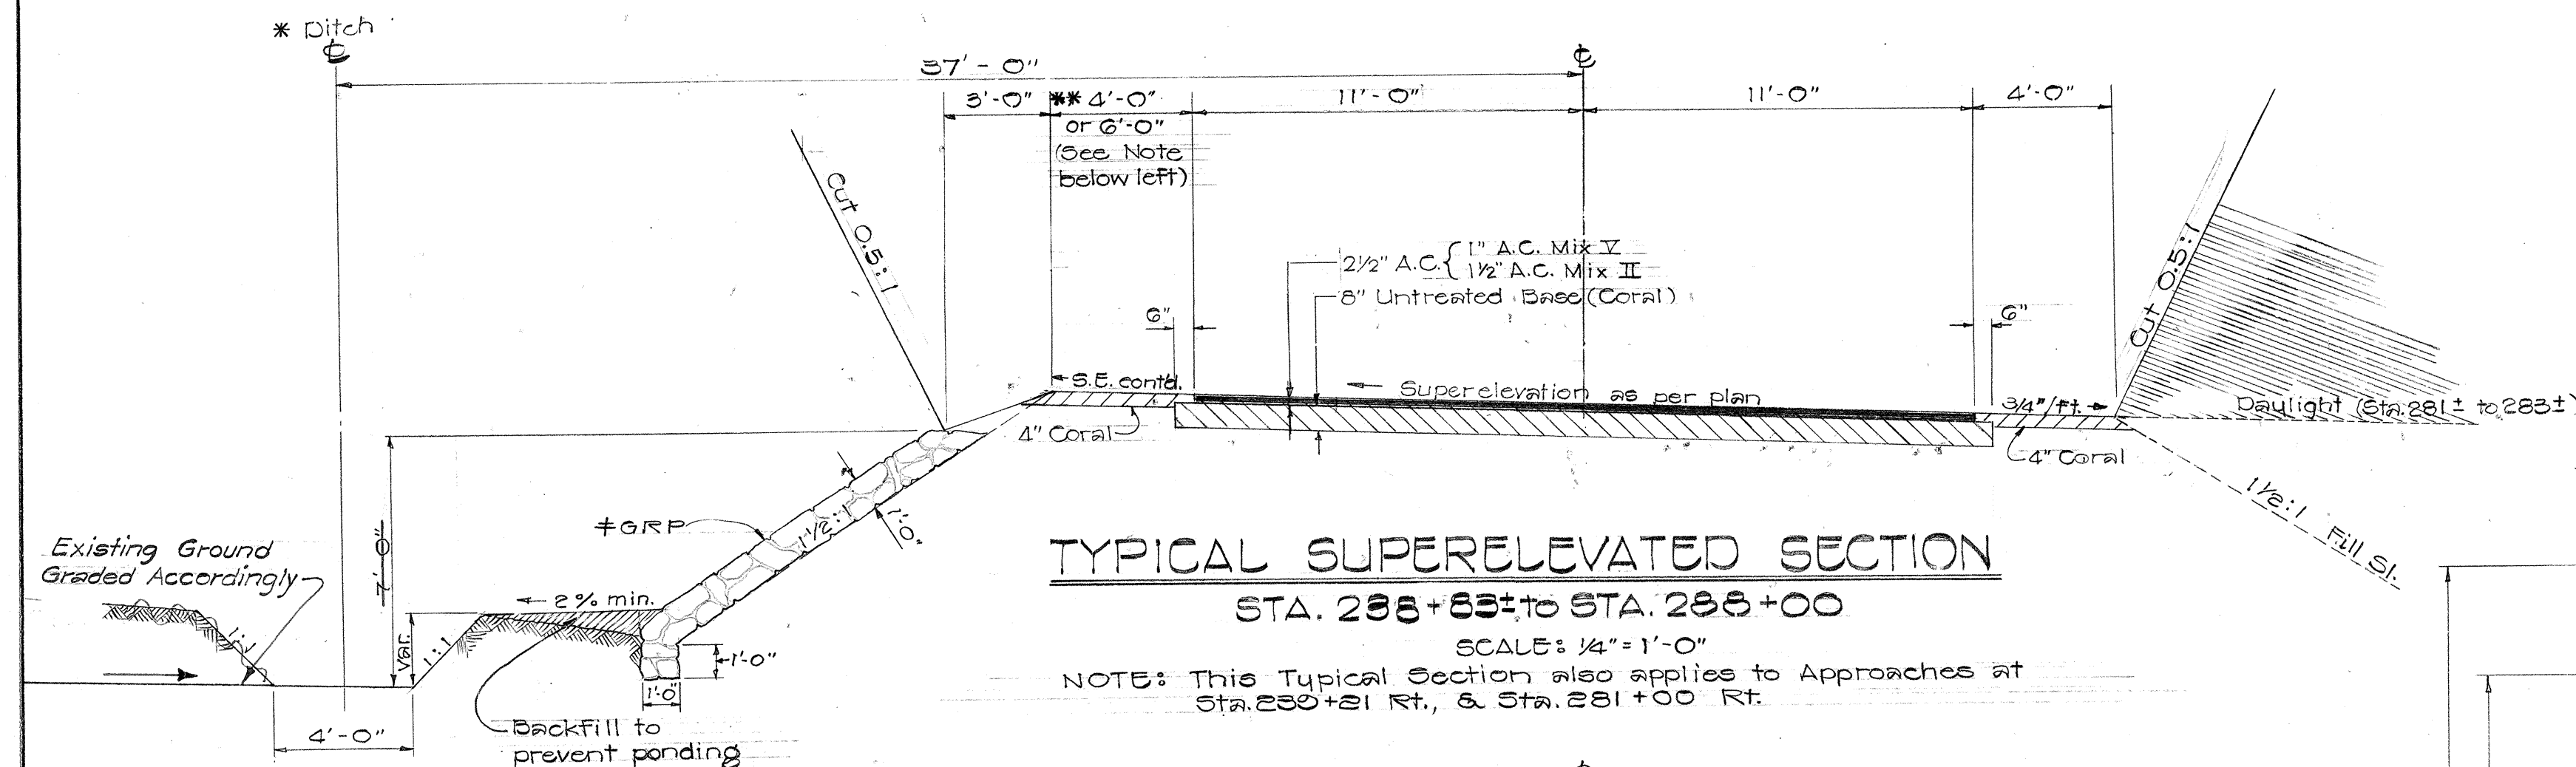
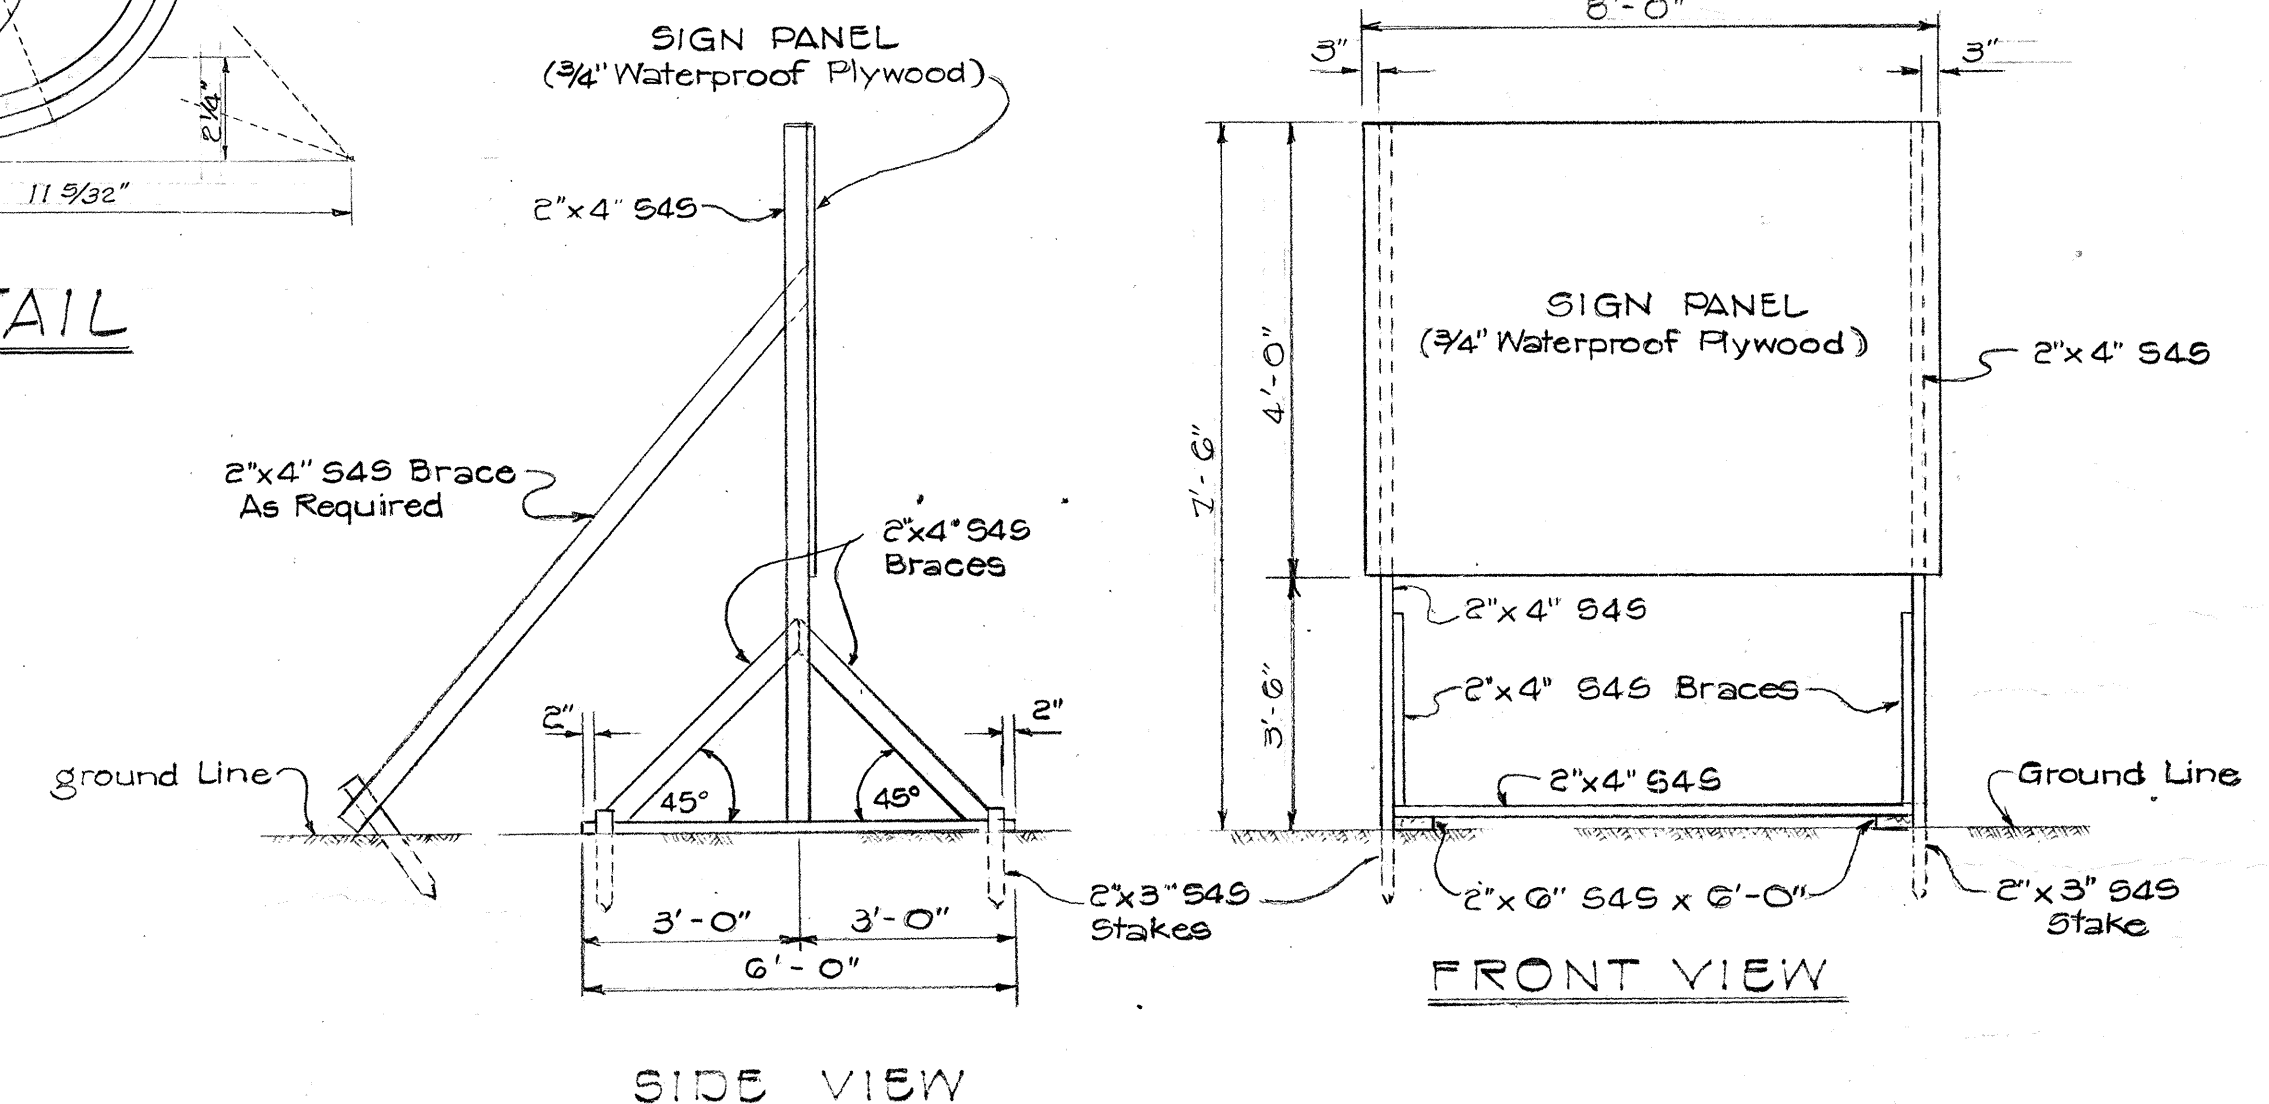
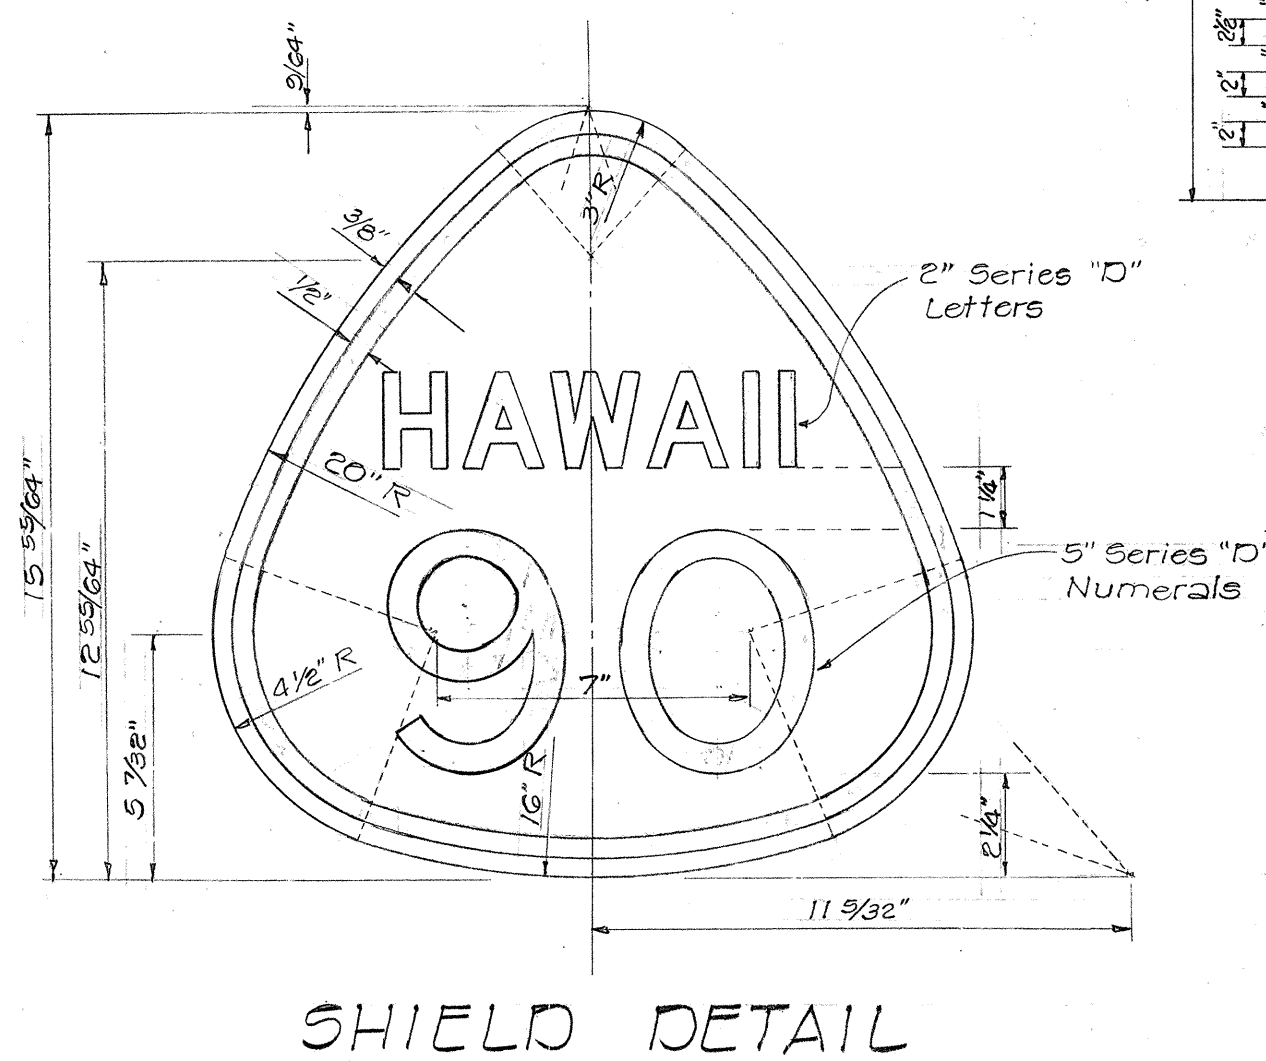
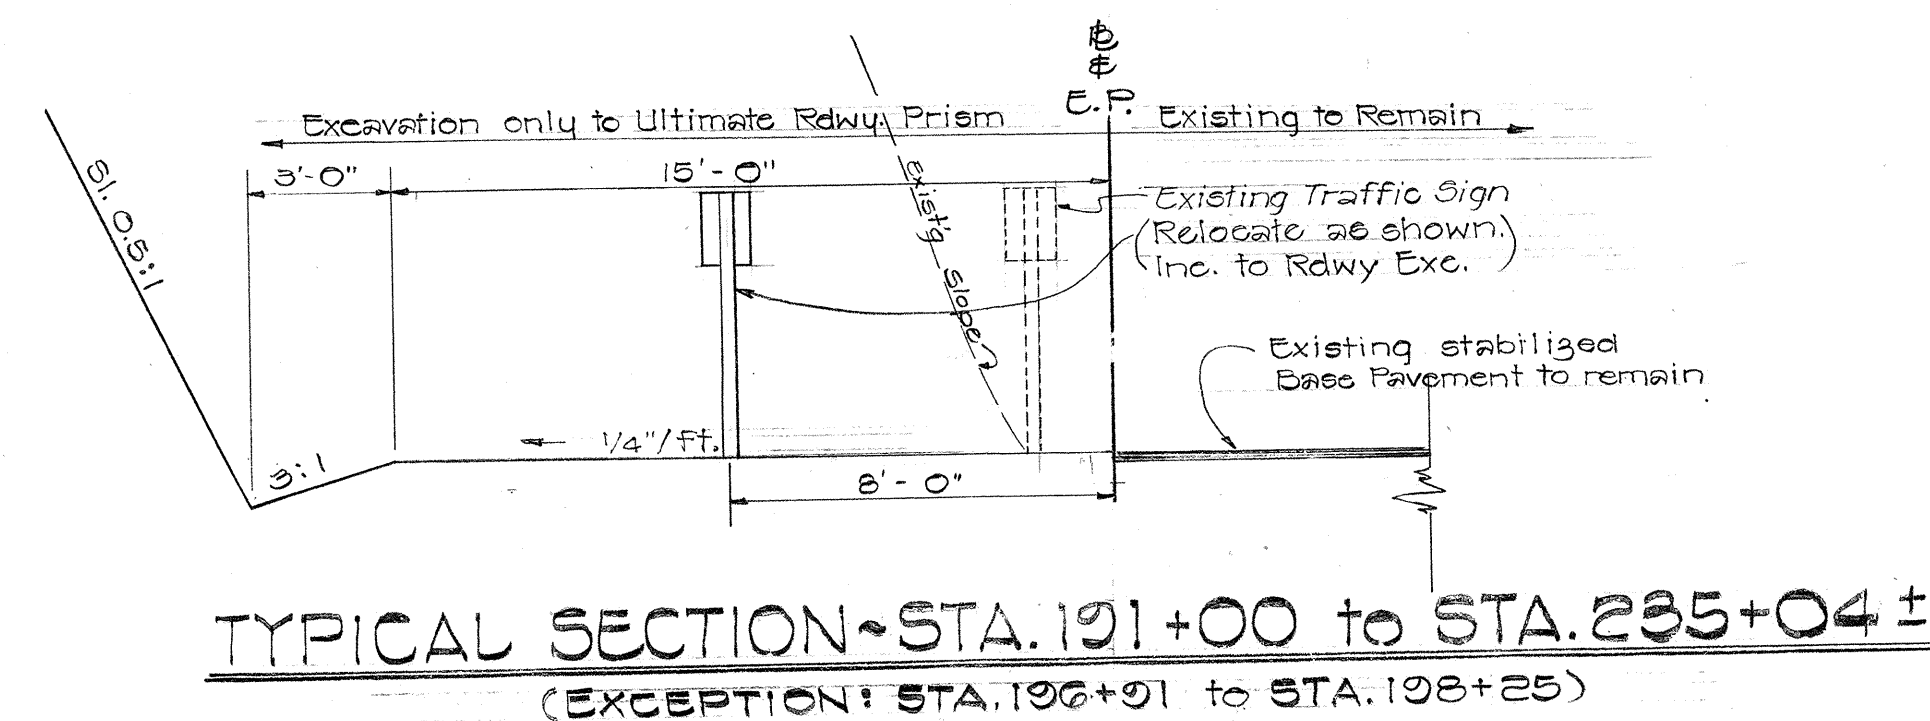


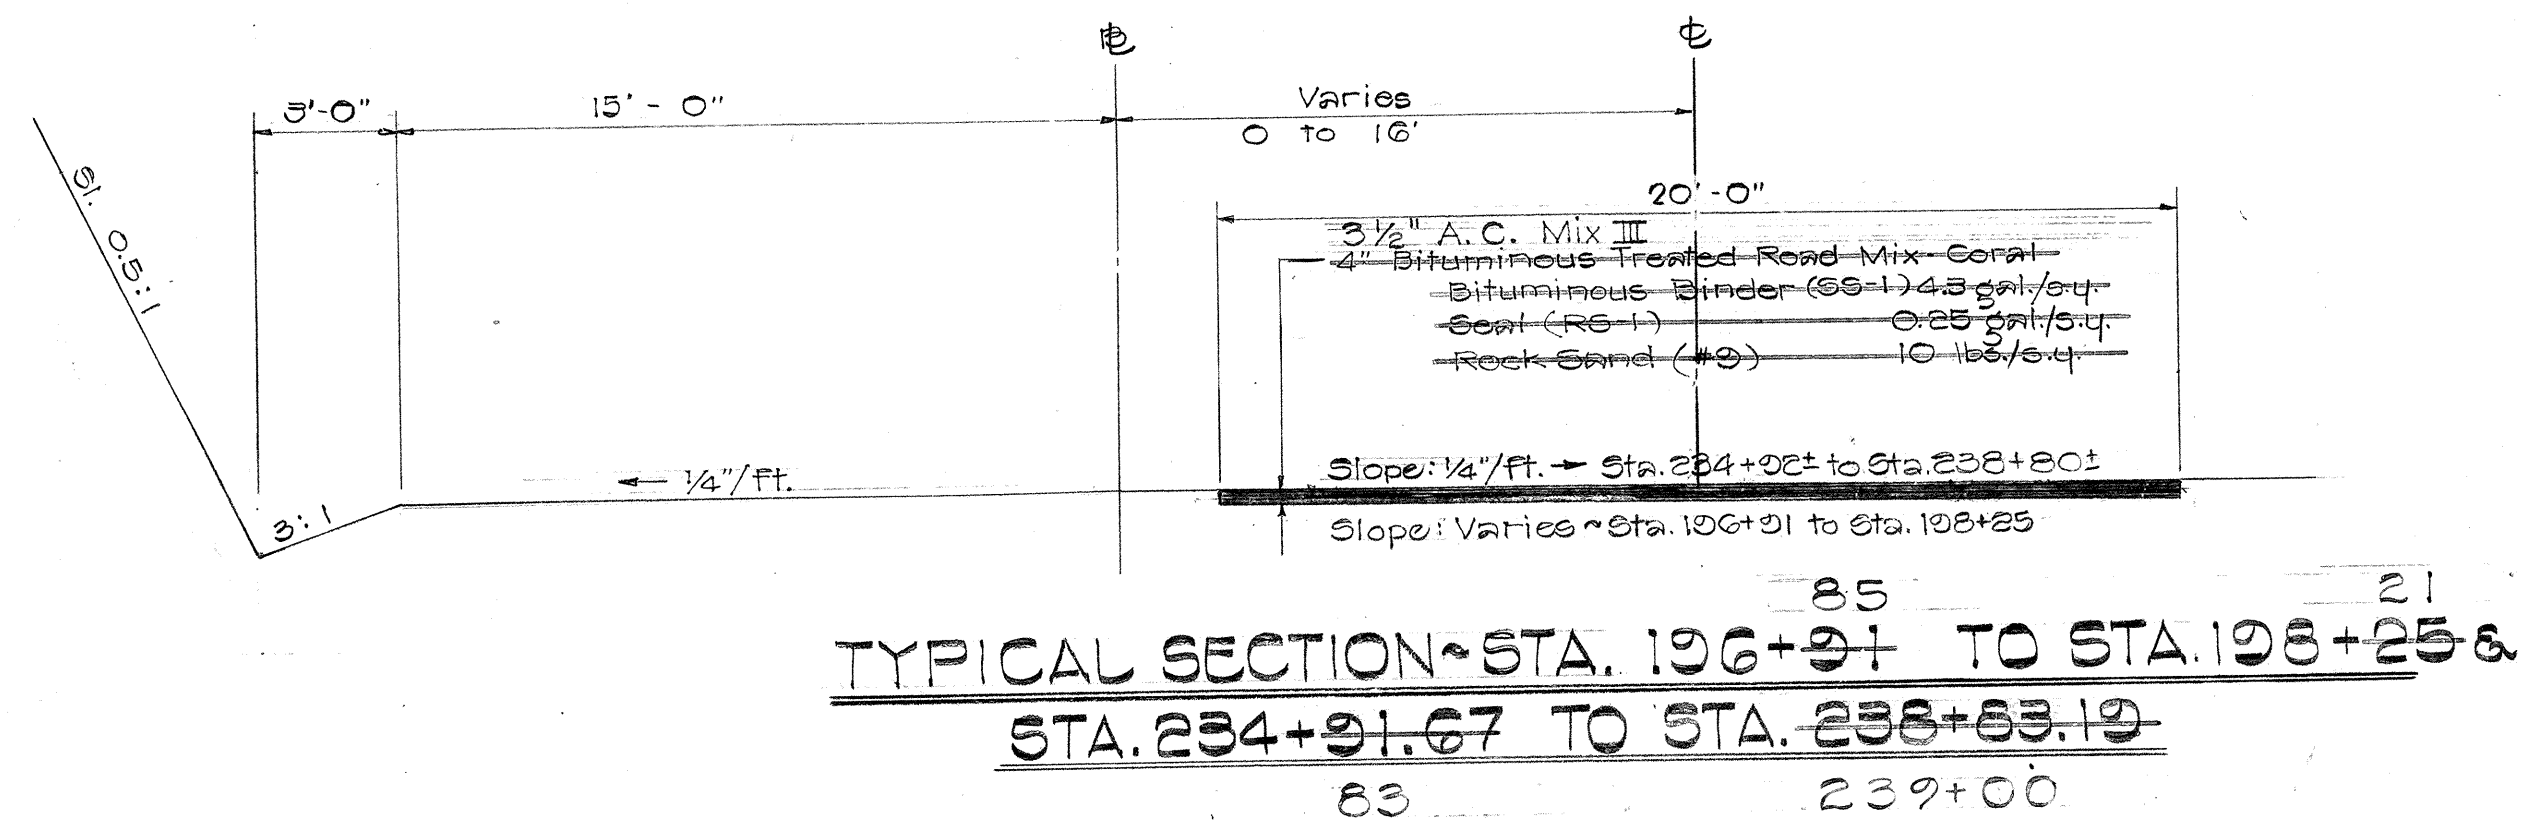

NOTE:

- * Intercepting Ditch - Sta. 280±30± Lt. to Sta. 285±50± Lt. only.
- + GRP Facing - Sta. 240+75 Lt. to Sta. 255±75± Lt. only.
- ** Shoulder shall be widened to 6'-0" Sta. 240+00± to Sta. 260±00± Lt. & Rt. Sta. 264+00± to Sta. 273±00± Lt. & Rt. Sta. 278+00± to Sta. 280±60± Lt. & Rt. Sta. 281+00± to 286±00 Rt.

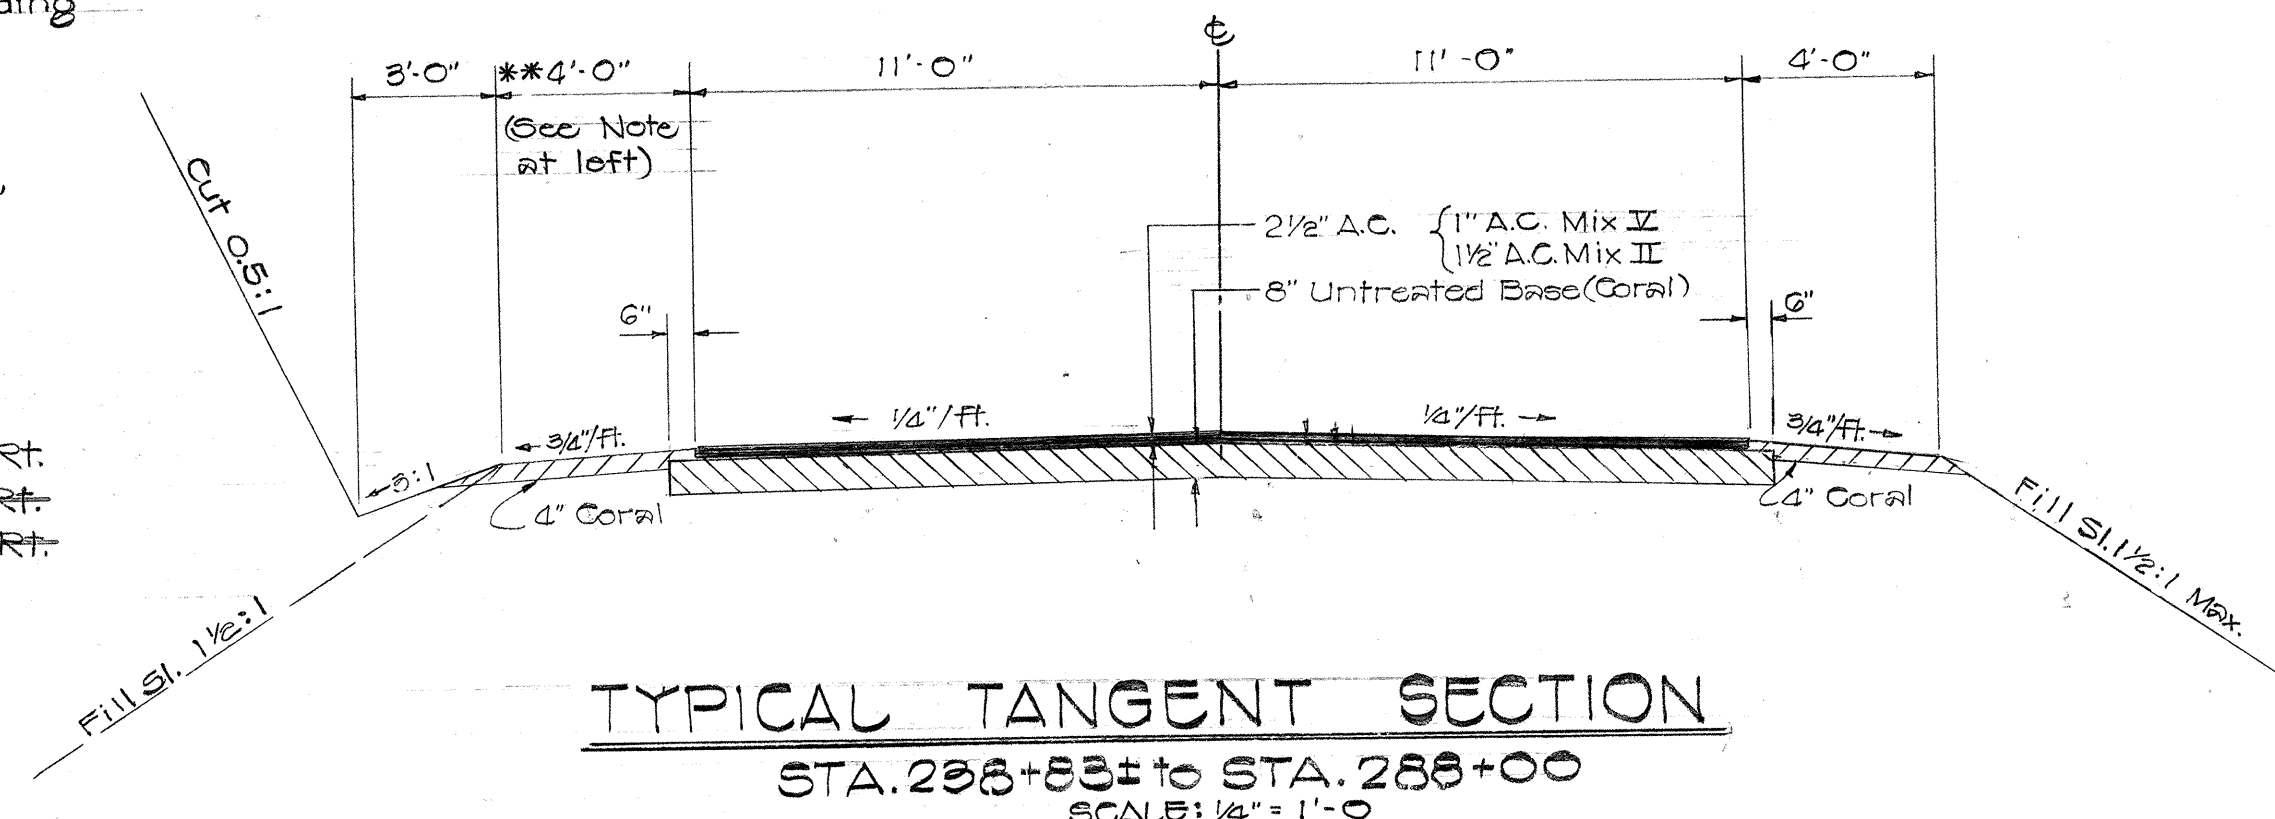


PROJECT CONSTRUCTION IDENTIFICATION SIGN

NOT TO SCALE

GENERAL NOTES

1. The legend shall be black on white background.
2. All letters shall be of size and design shown and conform with "Standard Alphabets for Highway Signs" as set forth by the Public Roads Administration, Federal Work Agency.
3. Letters shall be Series "D" sizes as shown.
4. Contractor shall be responsible for maintenance of sign.
5. Contractor shall fill in proper figures in place of Ciphers as ordered by the State Department of Transportation.

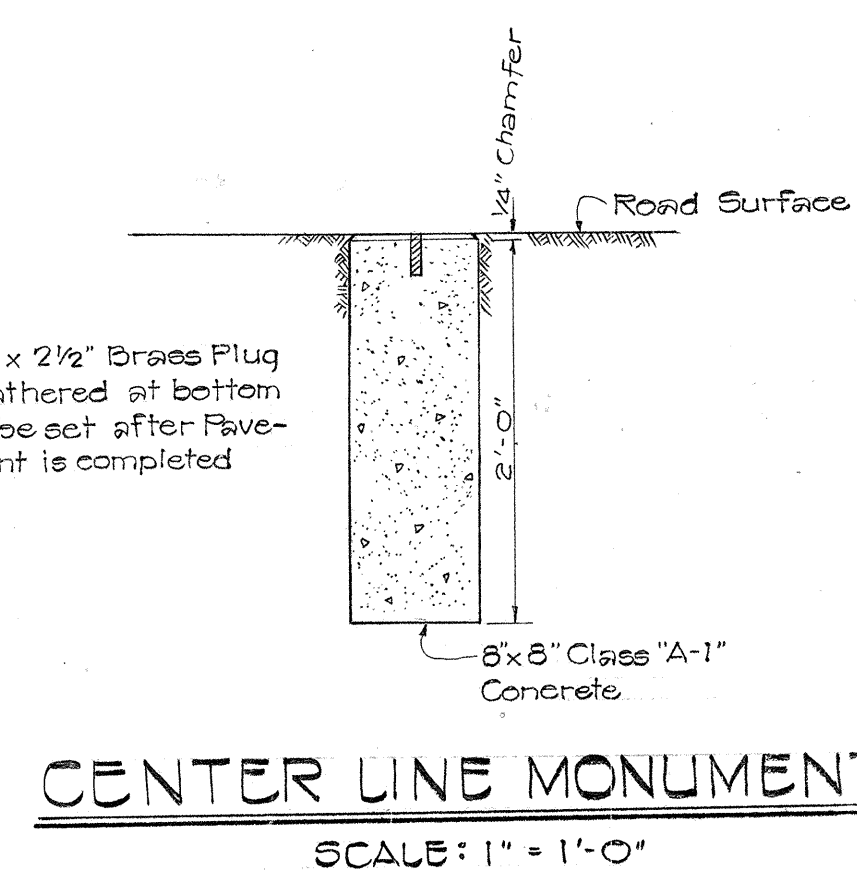

STATE OF HAWAII
DEPARTMENT OF TRANSPORTATION
HIGHWAYS DIVISION

**TYPICAL SECTIONS
AND
MISCELLANEOUS DETAILS**

PROJ. No. R-AD2(1)

SCALE: AS NOTED
MARCH 1963
SHEET No. OF SHEETS