
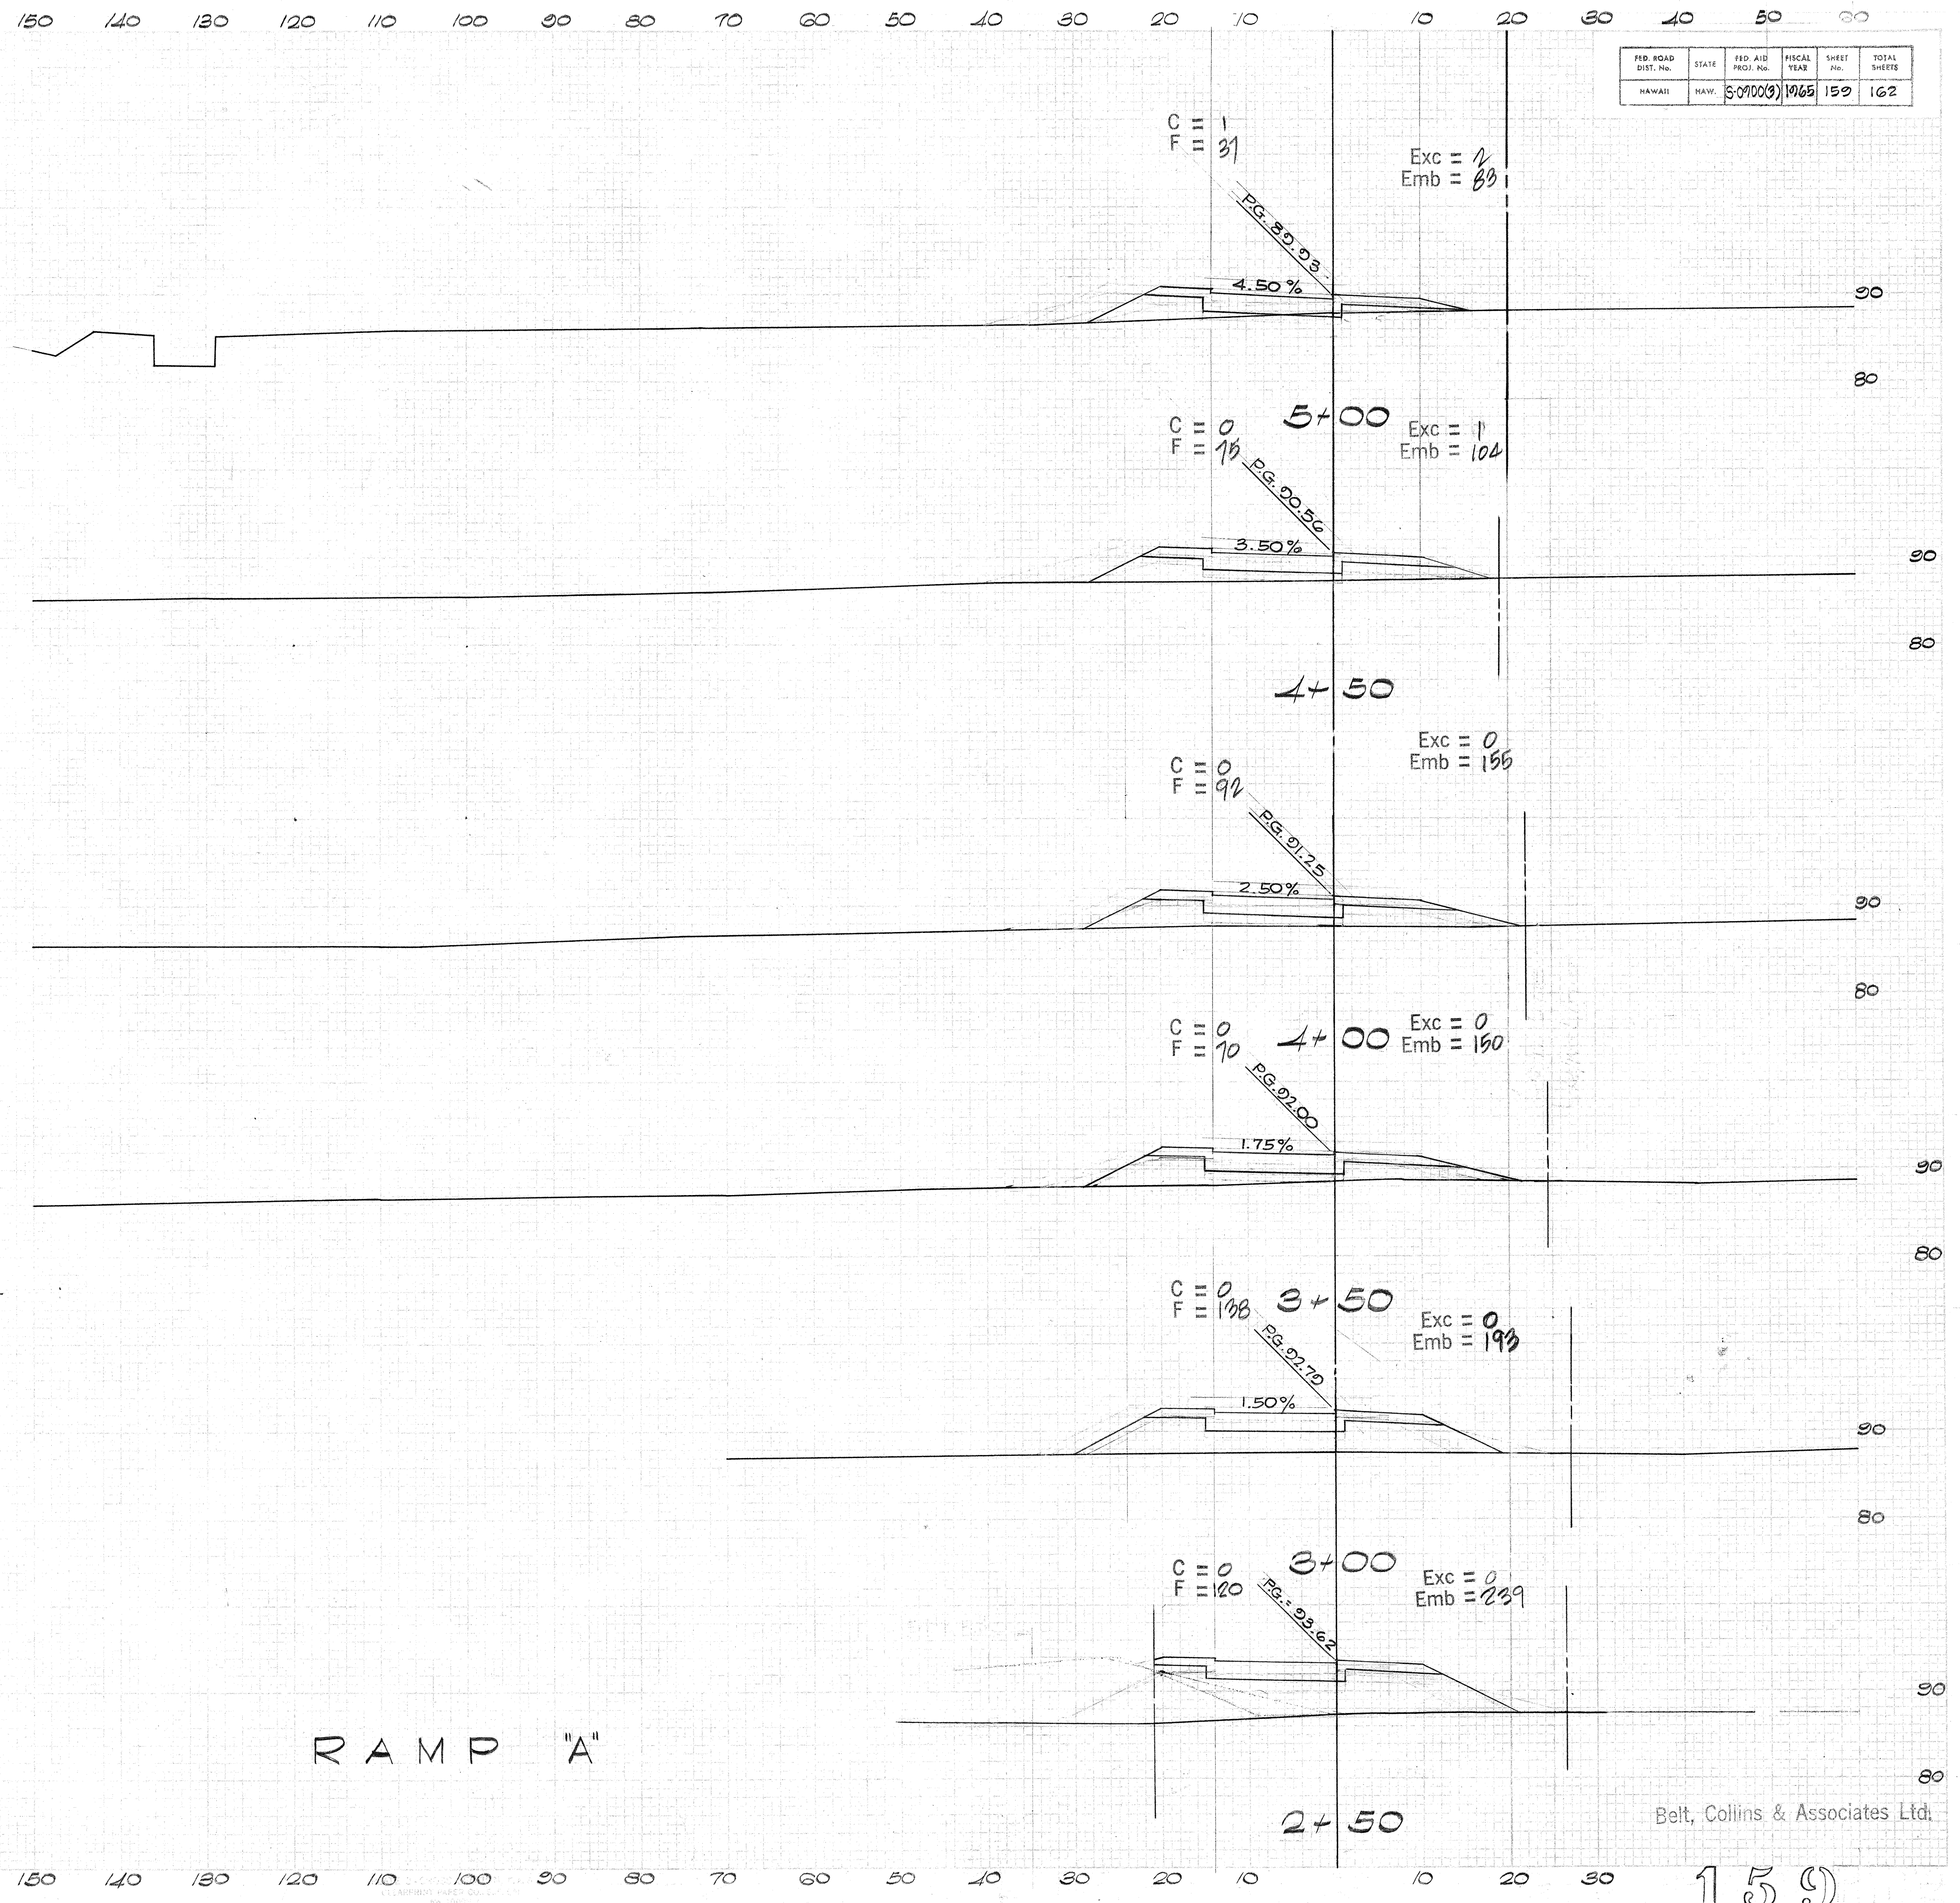


FED. ROAD DIST. No.	STATE	FED. AID PROJ. No.	FISCAL YEAR	SHEET No.	TOTAL SHEETS
HAWAII	HAW.	5-07000(9)	1965	159	162

REVISIONS
 NO. DATE BY
 1 10/1/65 JCL
 2 10/1/65 JCL
 3 10/1/65 JCL



REVISIONS
 NO. DATE BY
 1 10/1/65 JCL
 2 10/1/65 JCL
 3 10/1/65 JCL

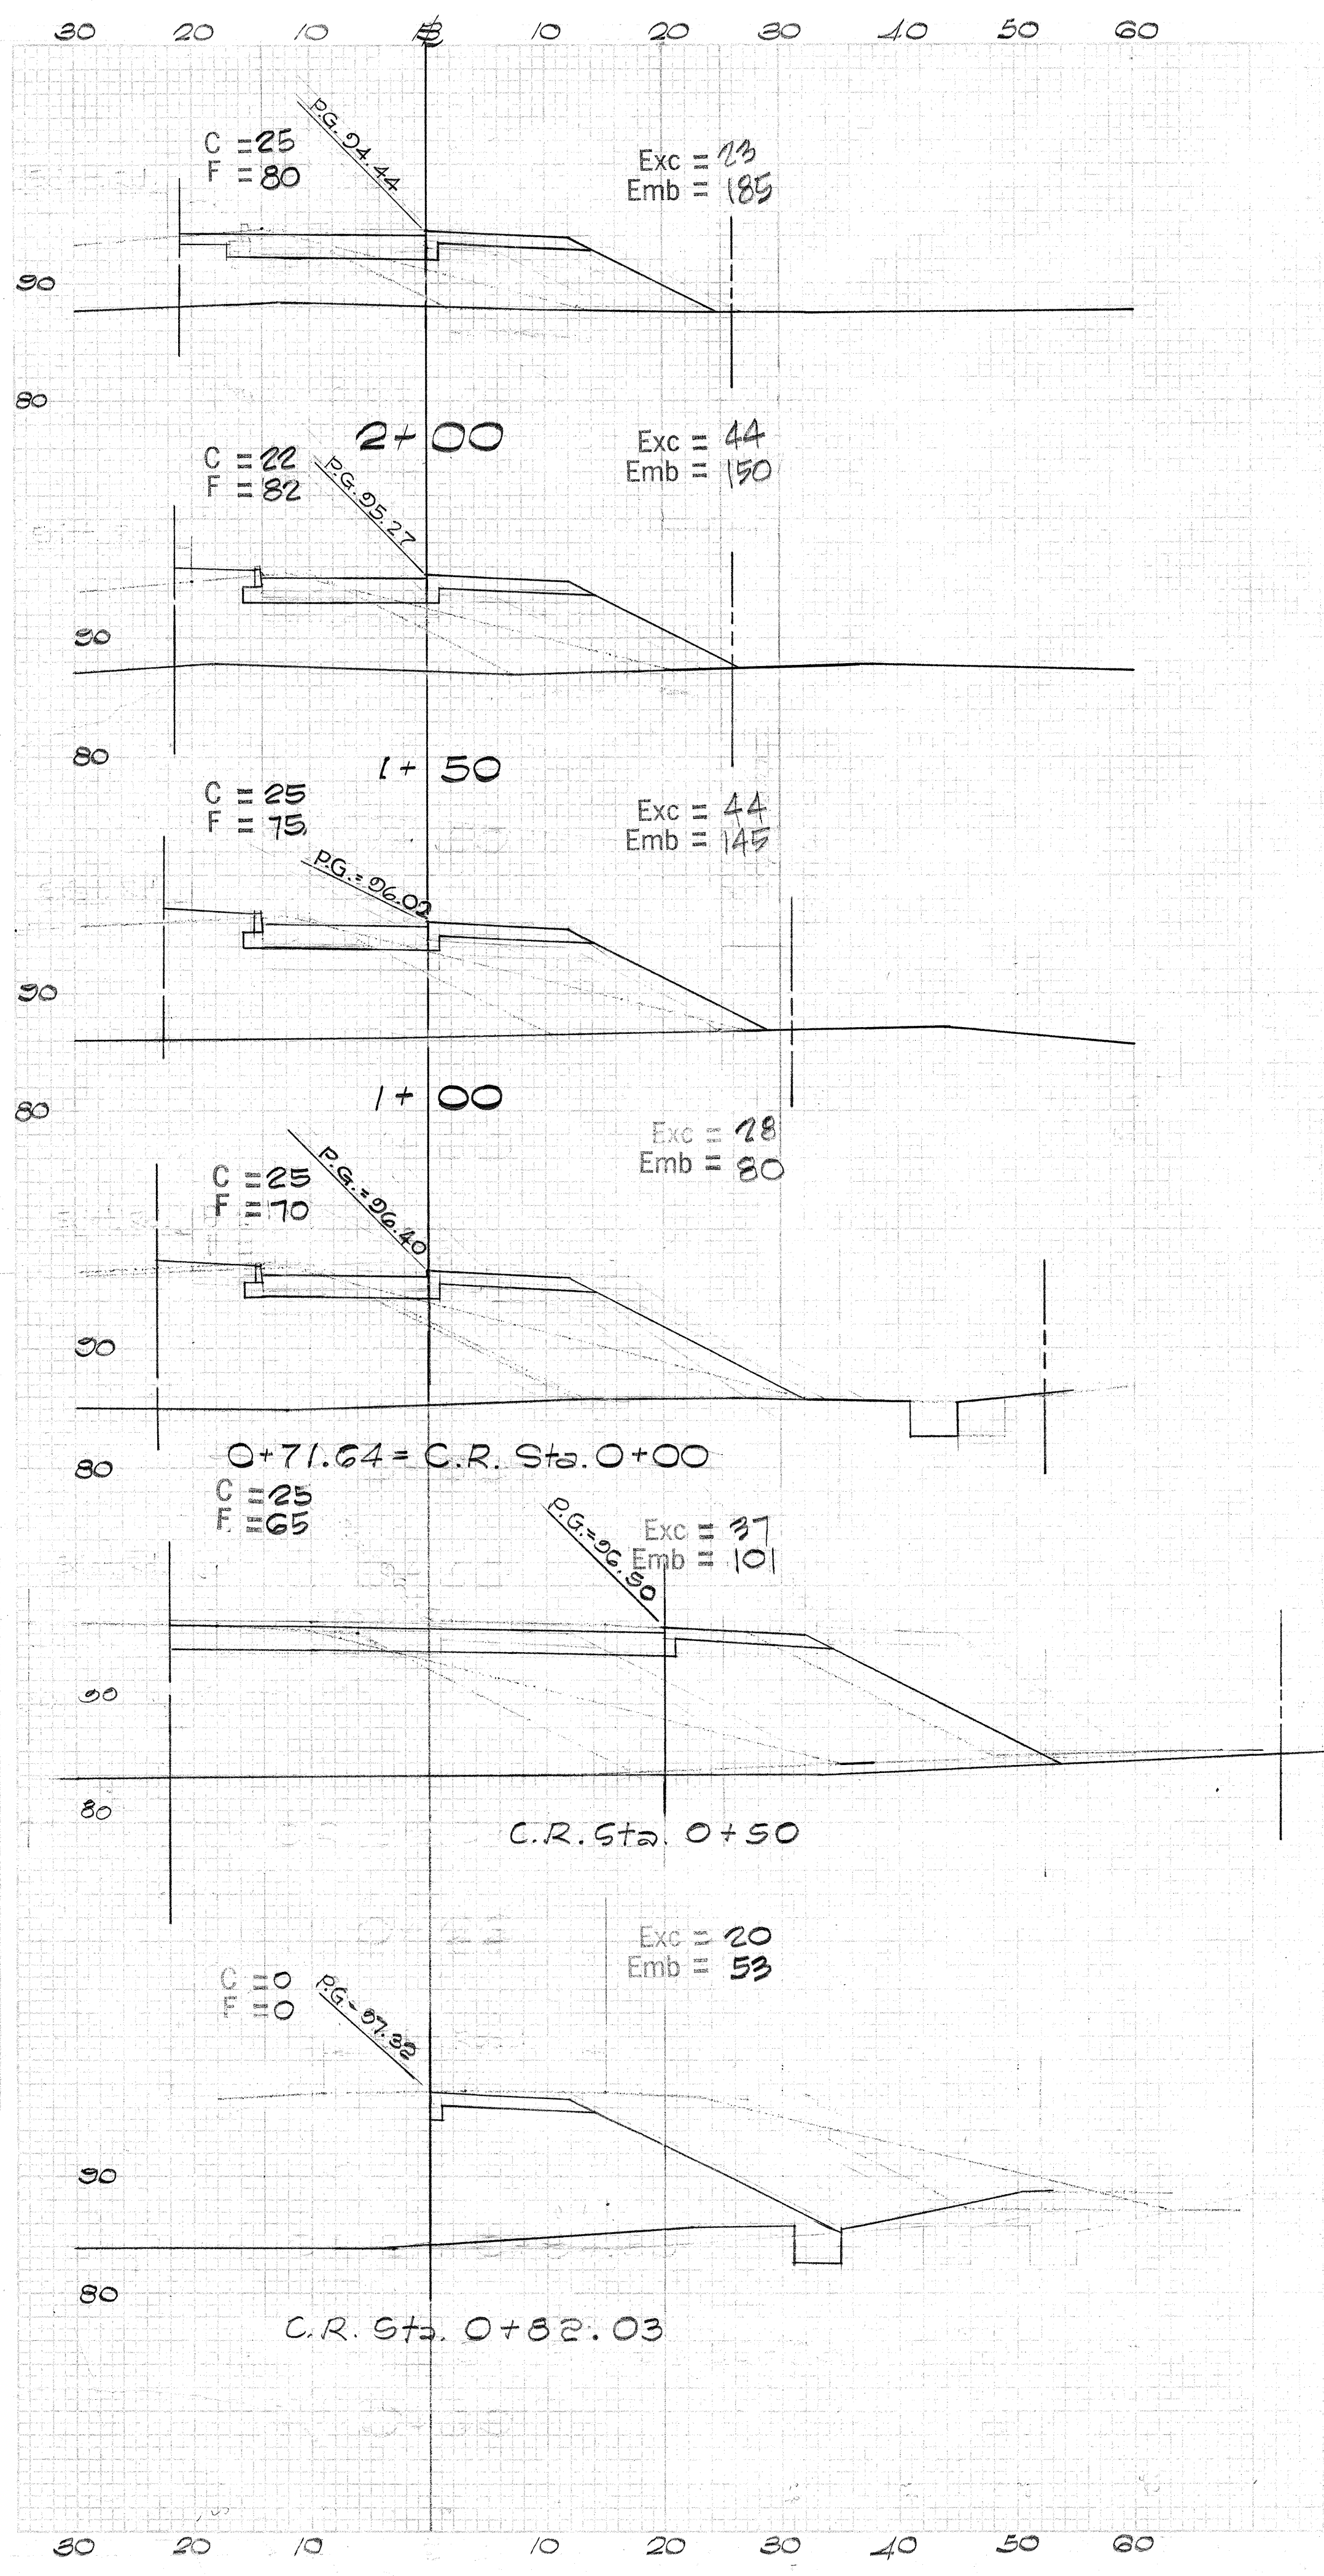

RAMP "A"

Belt, Collins & Associates Ltd.

FED. ROAD DIST. No.	STATE	FED. AID PROJ. No.	FISCAL YEAR	SHEET No.	TOTAL SHEETS
HAWAII	HAW.	S-070008	1965	160	162

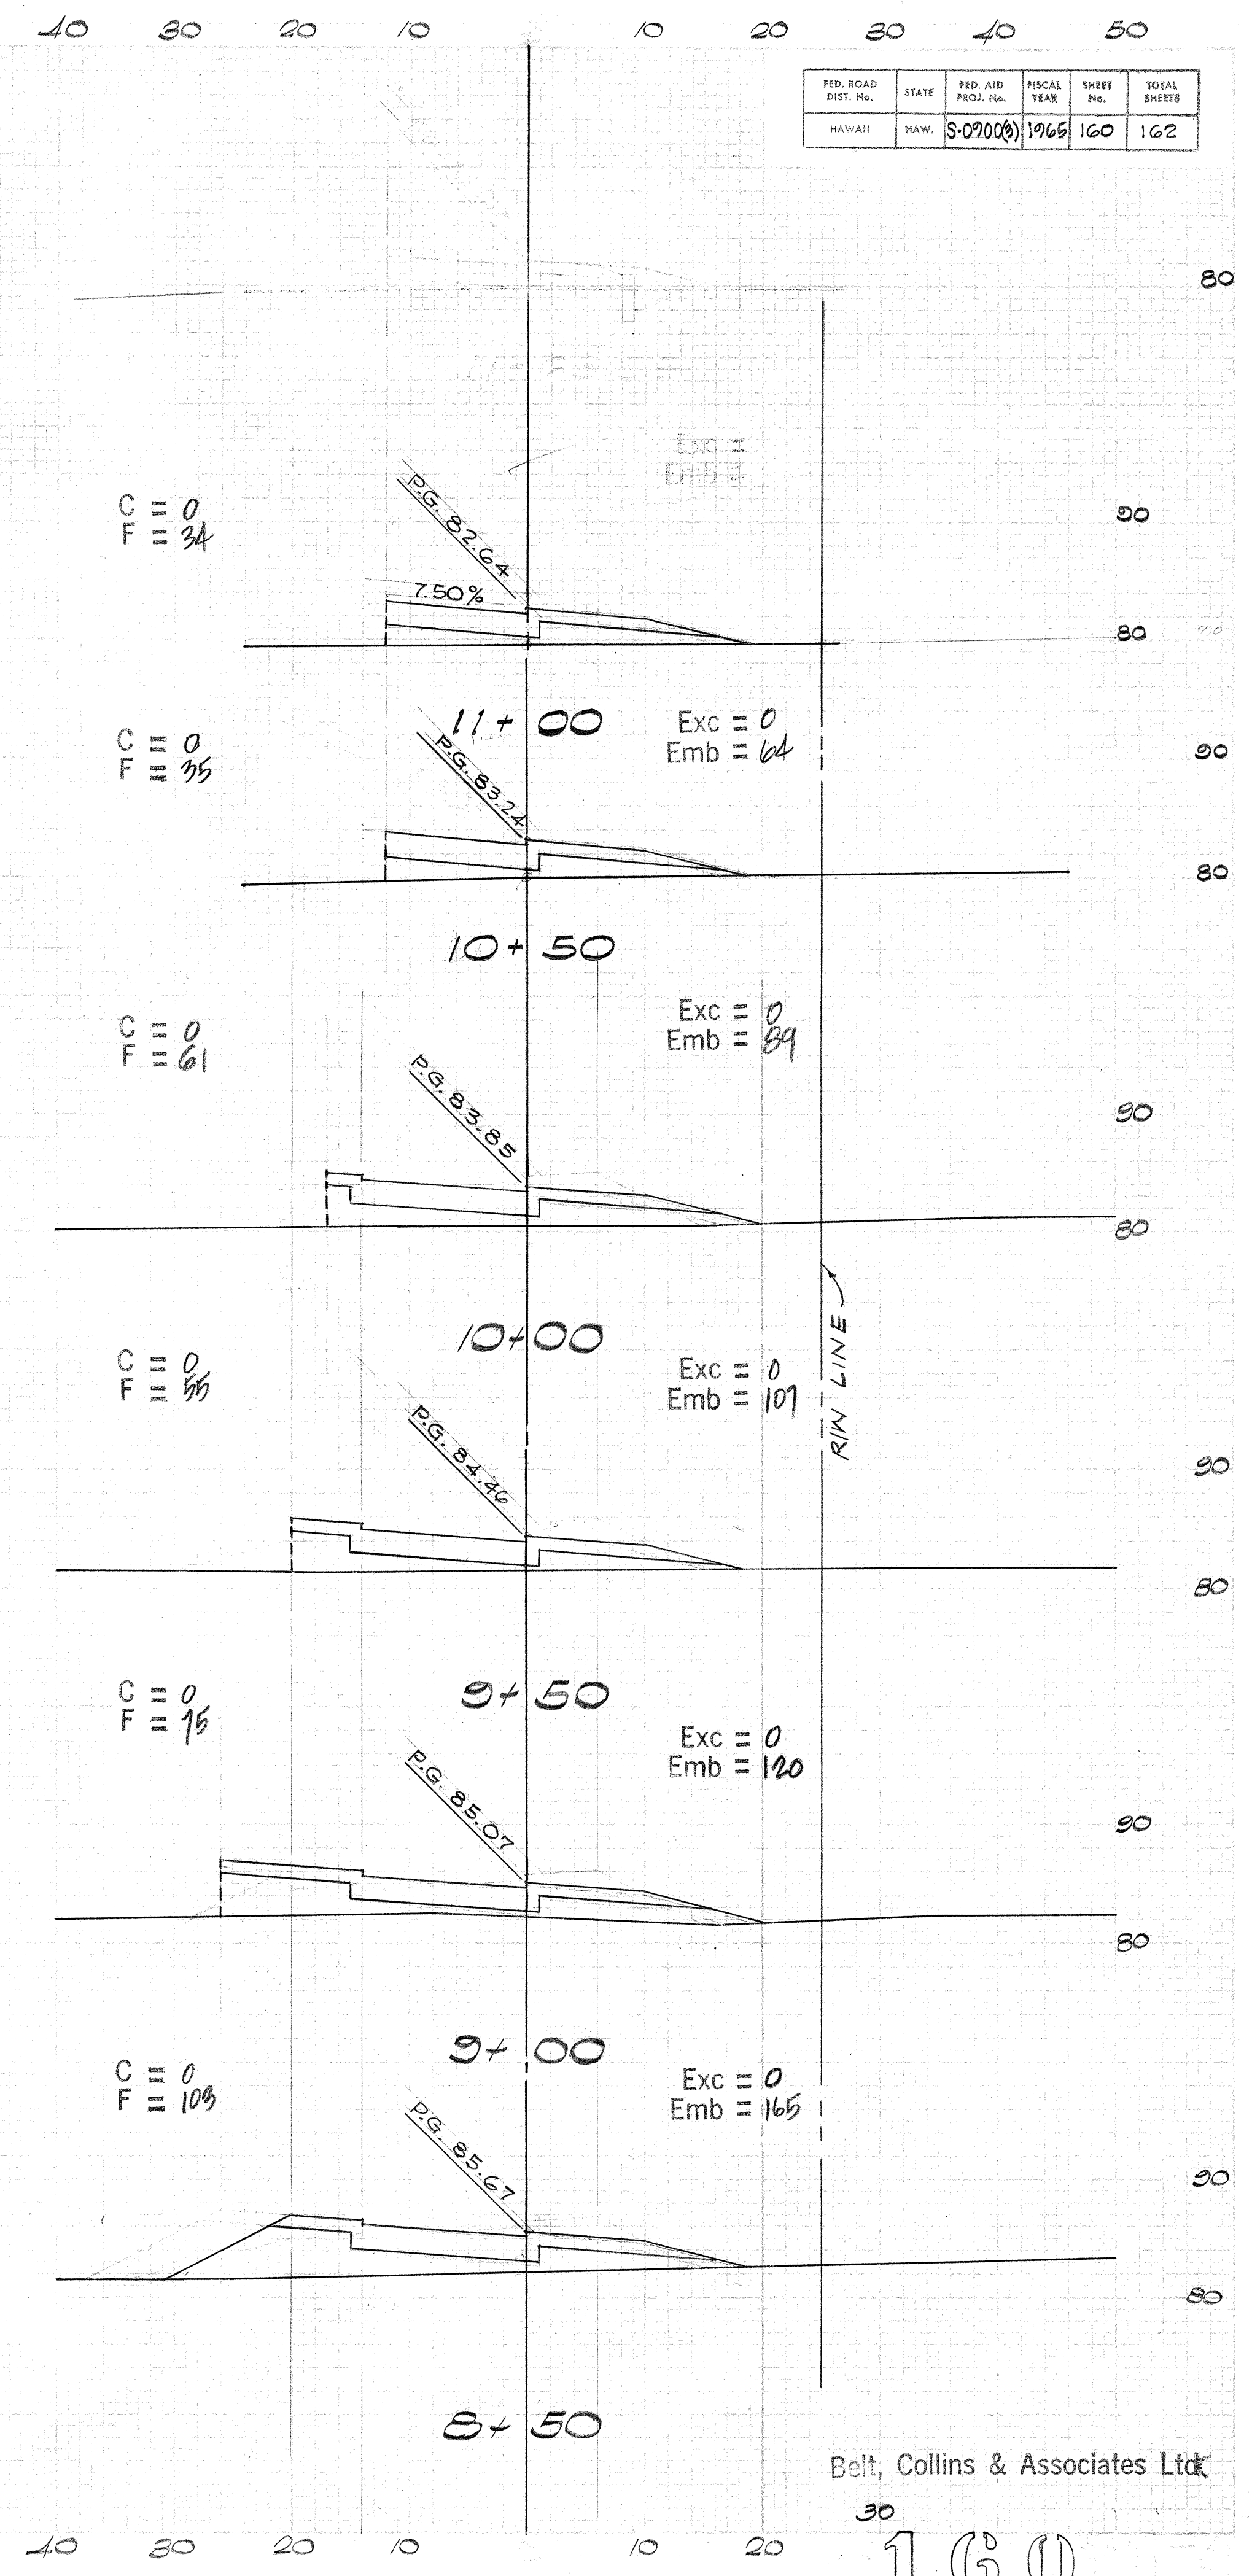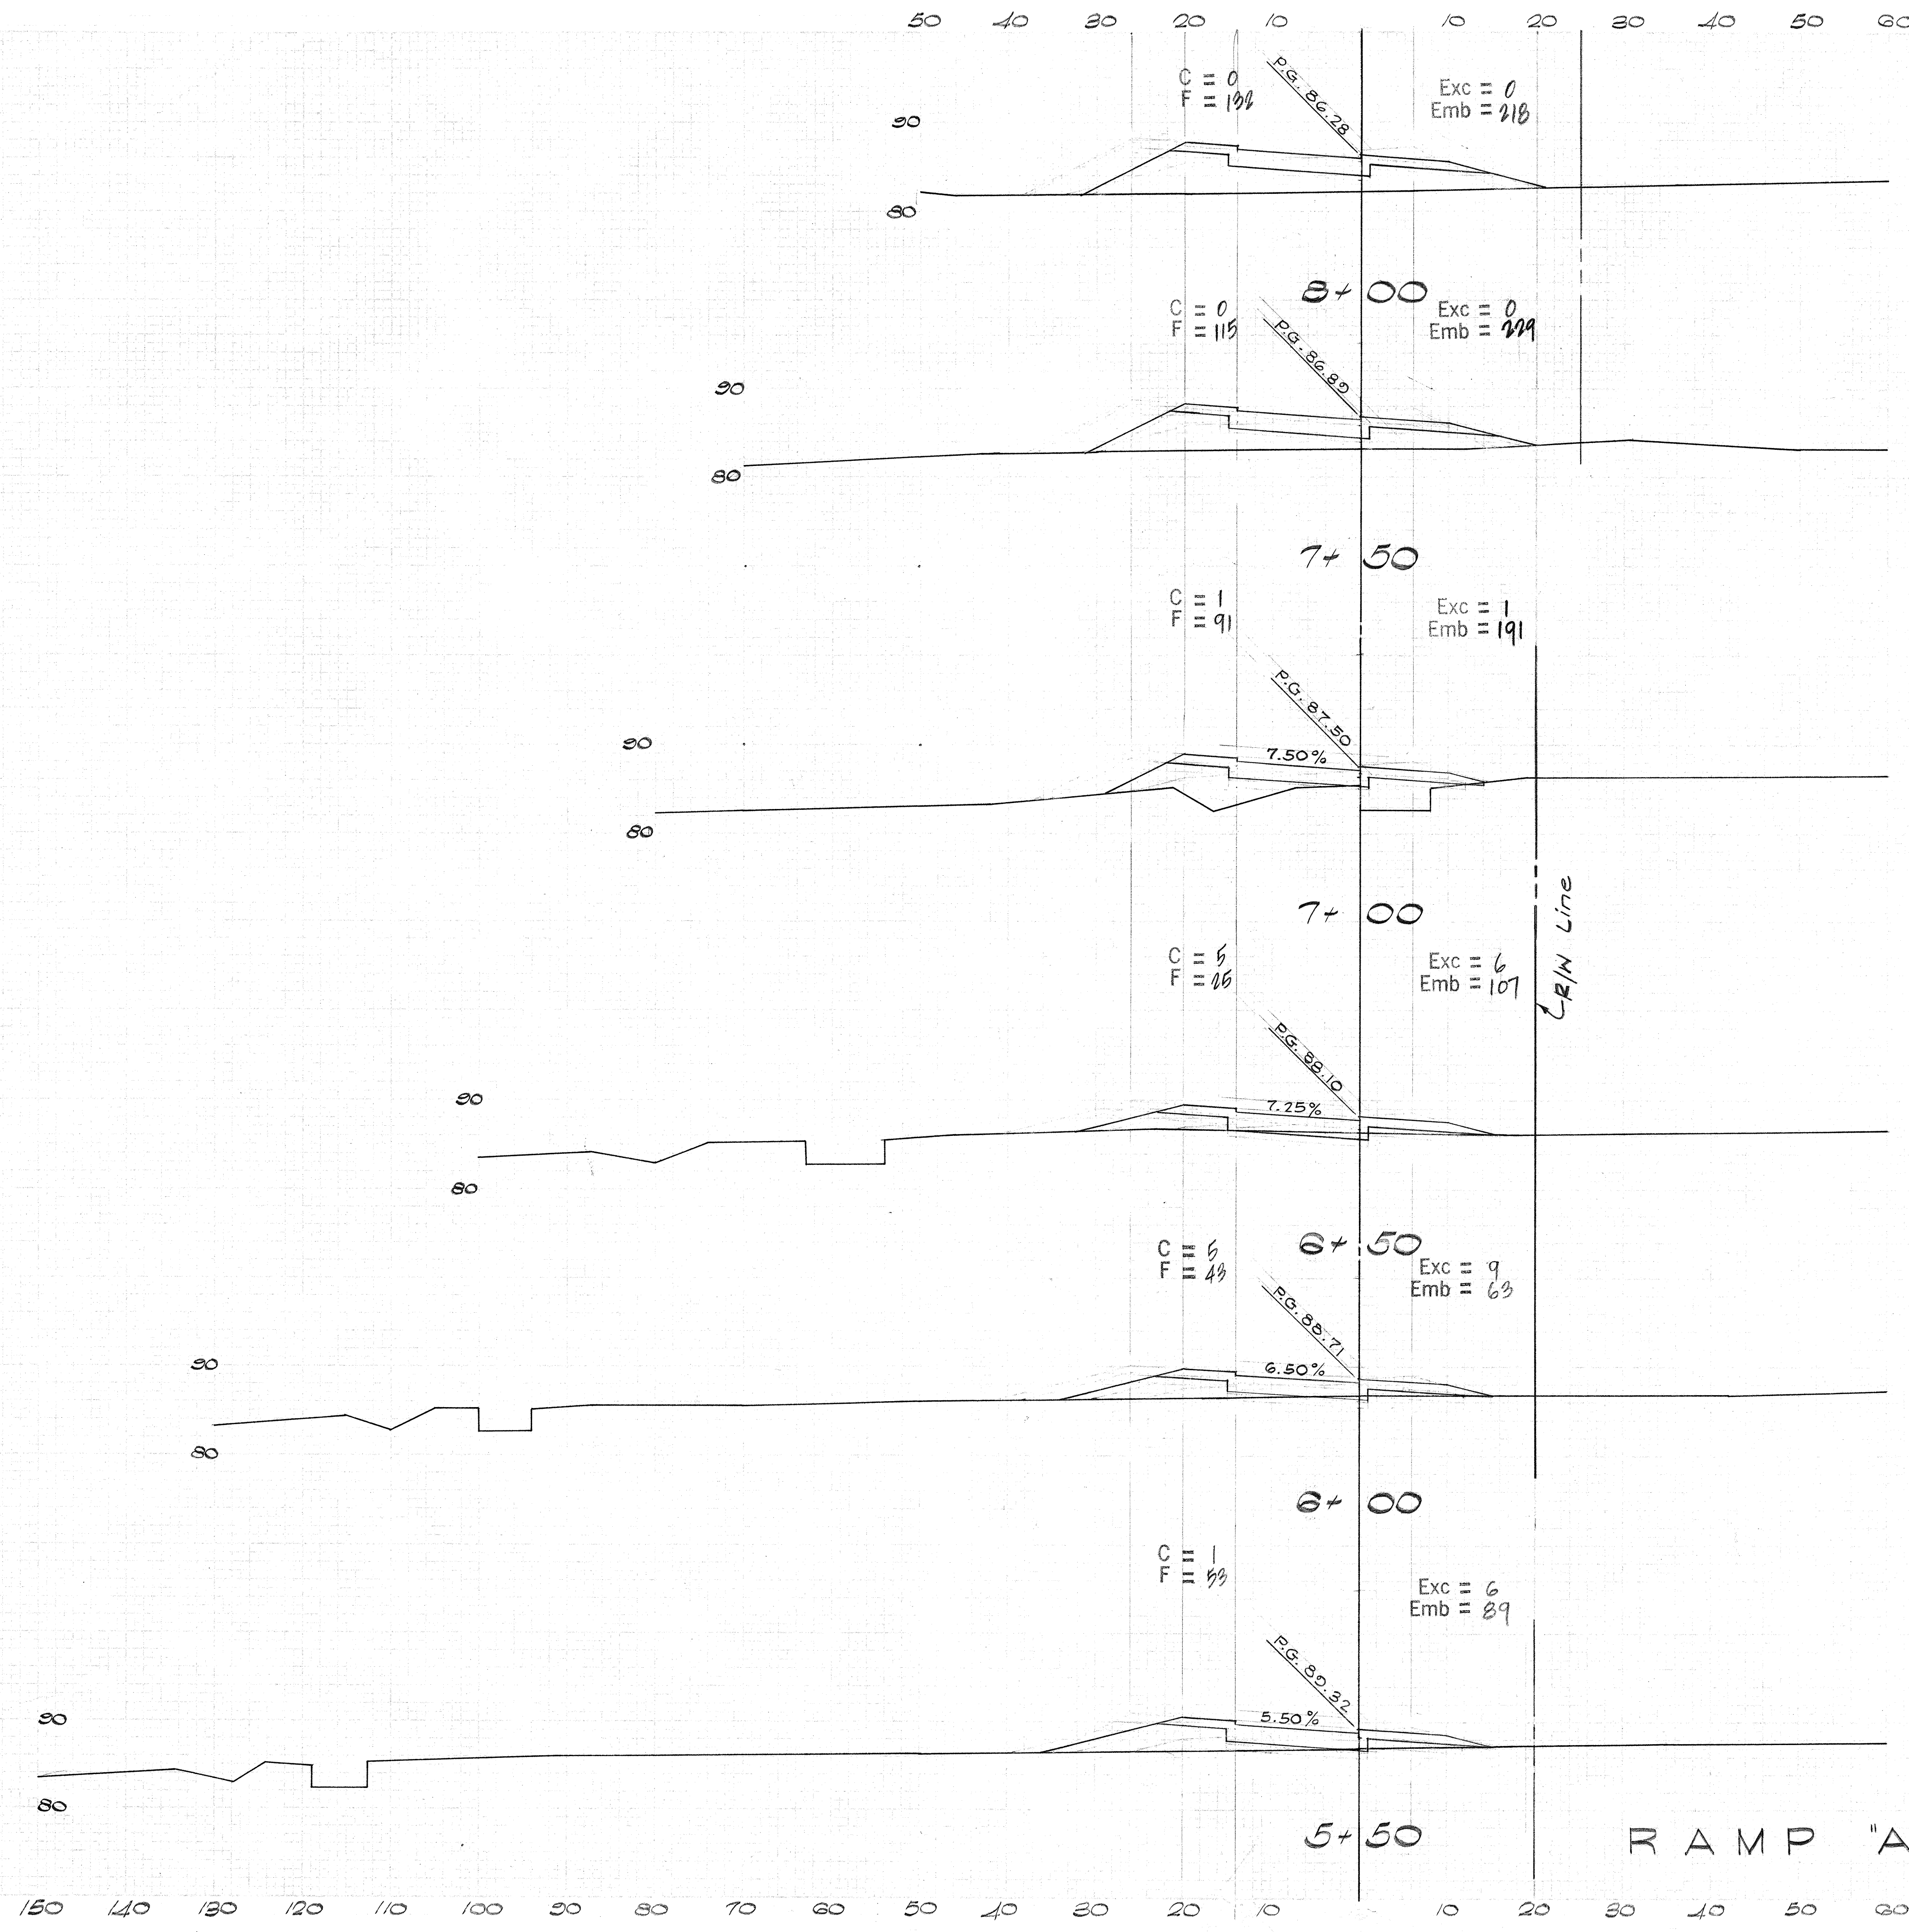

Belt, Collins & Associates Ltd.