




STATE	FISCAL YEAR	SHEET NO.	TOTAL SHTS.
HAWAII	1967	14	76

PROJECT NO. B-900-01-64 UNIT I

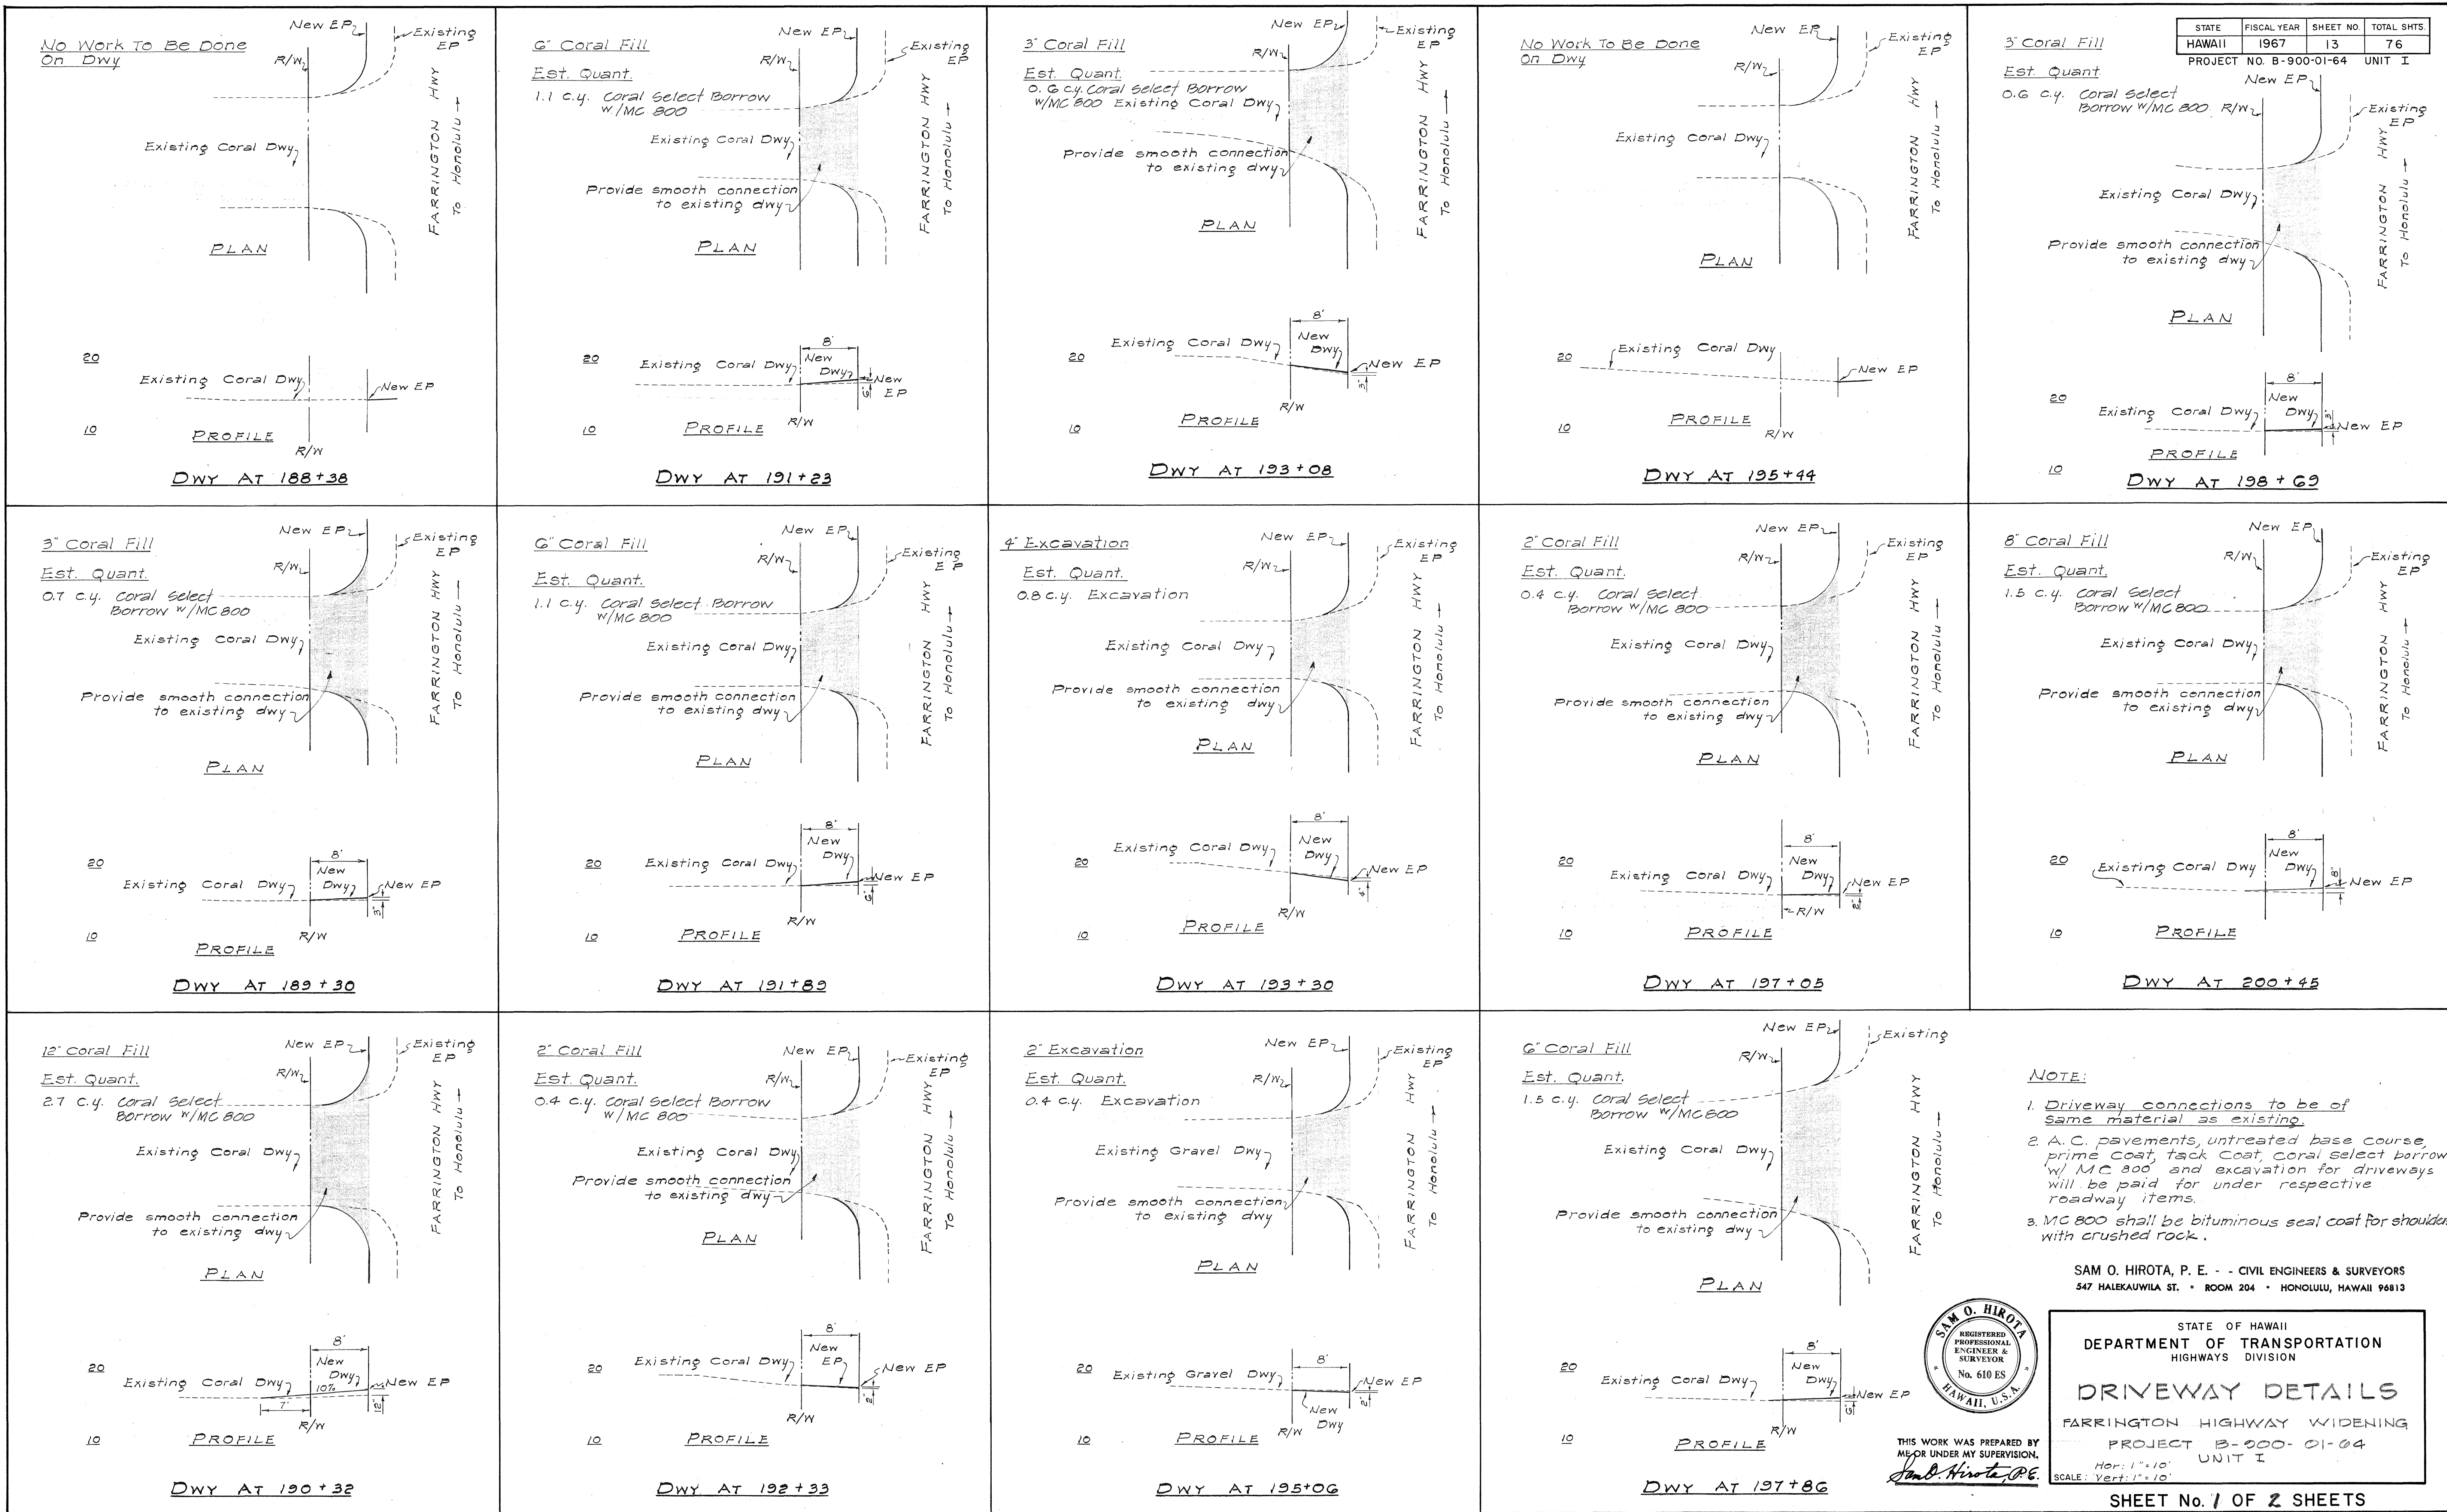