


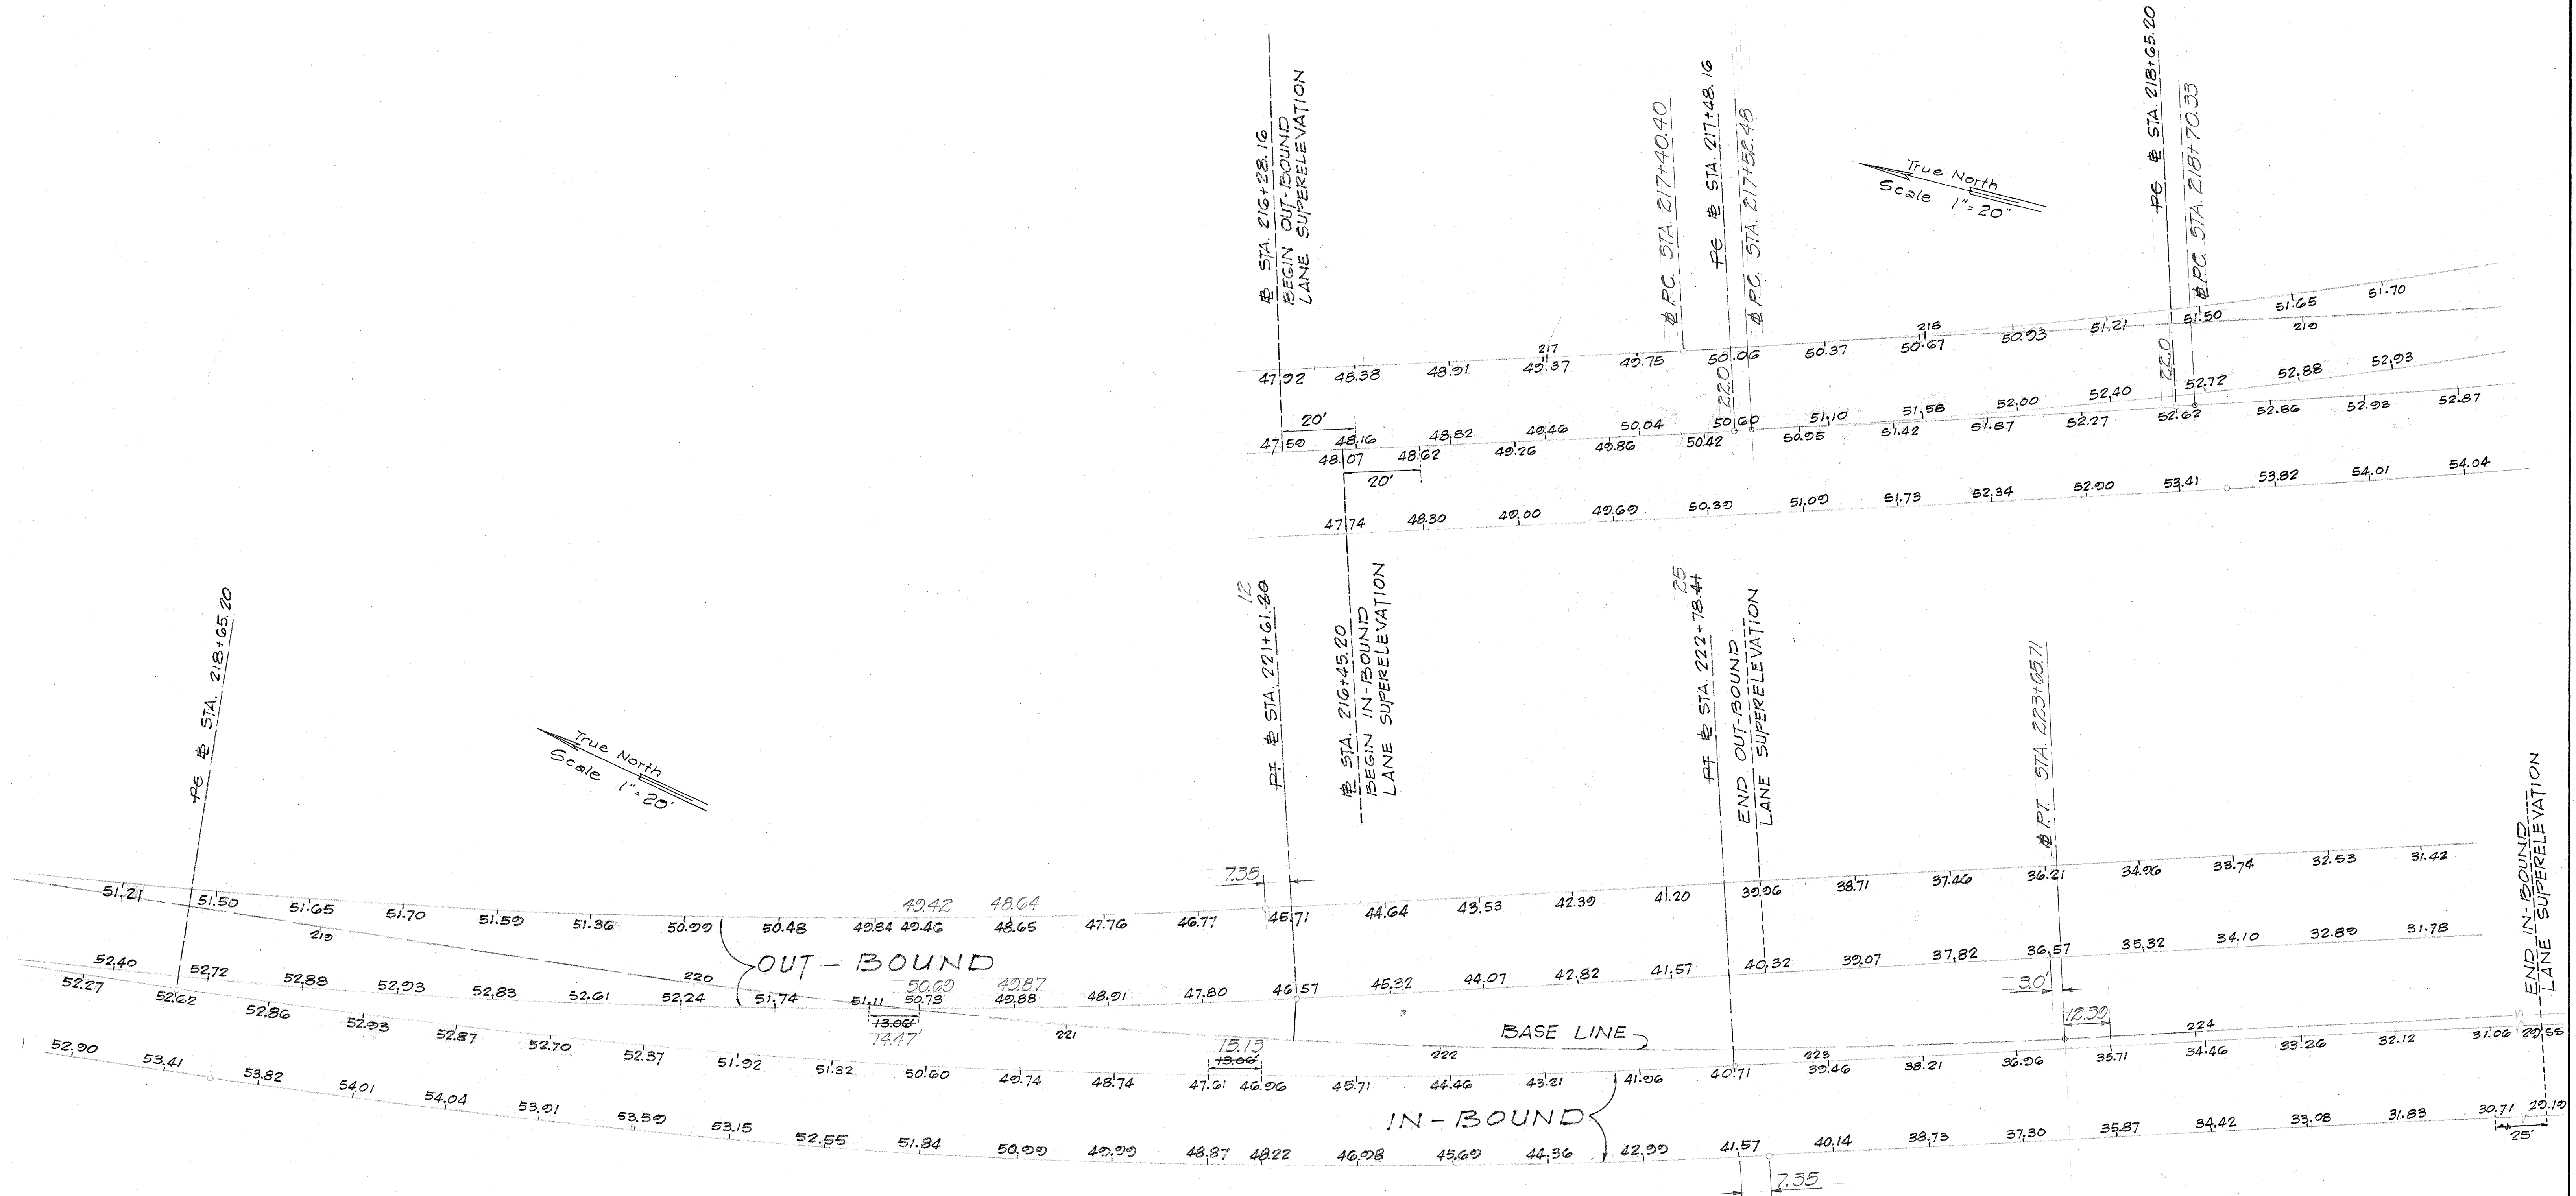

NOTE

- ALL PAV'T GRADES ARE 25' APART ALONG INSIDE EDGE OF ROADWAY PAV'T UNLESS OTHERWISE SPECIFIED.
- SEE TRANSITION DETAILS SH. 11 FOR TIES TO BASE LINE.



THIS WORK WAS PREPARED BY ME OR UNDER MY SUPERVISION.
Sam O. Hirota, P.E.

SAM O. HIROTA, P. E. - CIVIL ENGINEERS & SURVEYORS
 547 HALEKAUWILA ST. • ROOM 204 • HONOLULU, HAWAII 96813


STATE OF HAWAII
 DEPARTMENT OF TRANSPORTATION
 HIGHWAYS DIVISION
PAVEMENT GRADE DETAILS
 FROM STA. 216+28.16 TO STA. 224+28.41
 FARRINGTON HIGHWAY WIDENING
 PROJECT B-900-01-64
 UNIT I
 SCALE 1"=20'

STATE	FISCAL YEAR	SHEET NO.	TOTAL SHTS.
HAWAII	1967	10	76

PROJECT NO. B-900-01-64 UNIT I


NEW & P.C. STA. 230+79.45

True North
Scale 1" = 20'

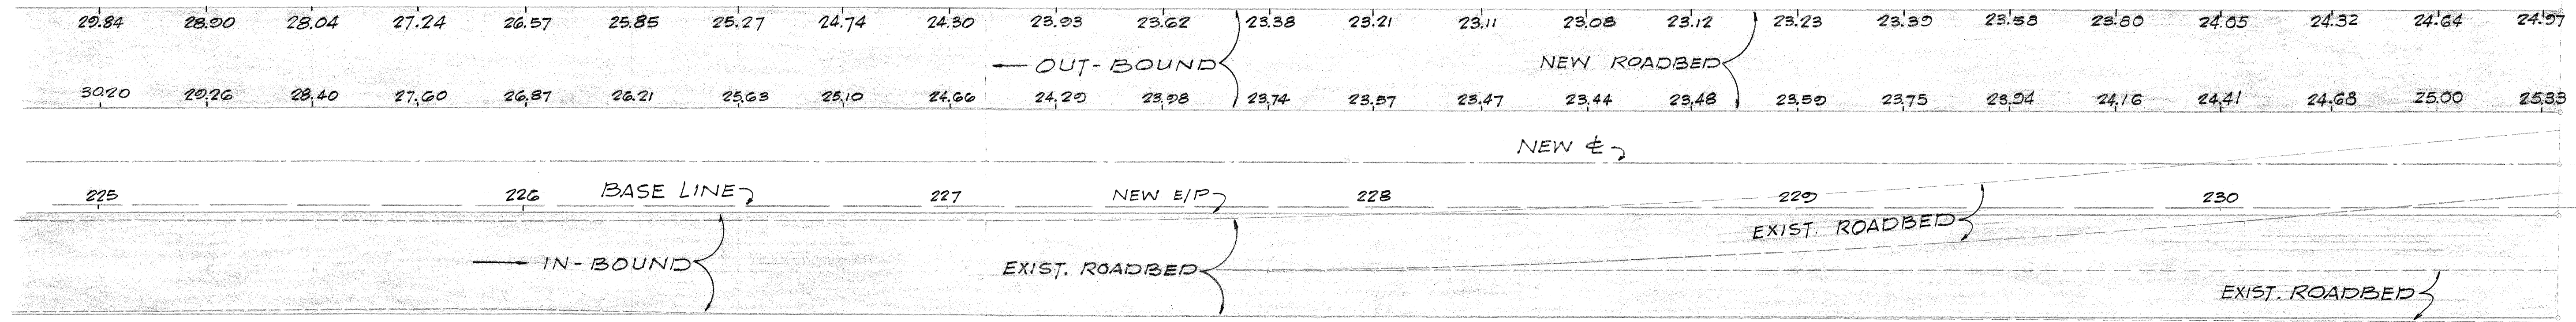

NOTE
ALL GRADES SHOWN ARE 25'
APART ALONG BASE LINE
STARTING FROM STA. 225+00

NEW & P.C. STA. 230+79.45
E TO NEW & = 10.00'

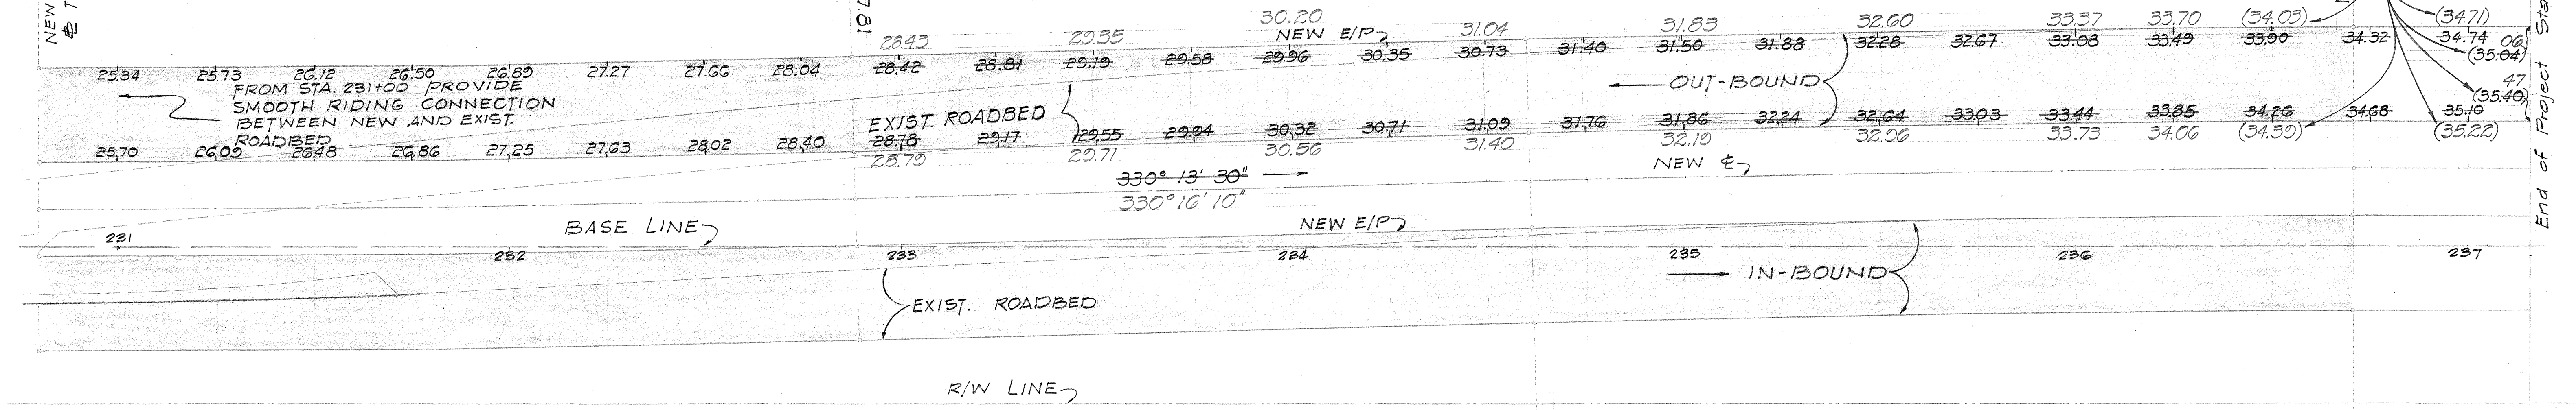

End of Project Sta. 237+15.80
15.71

STATE OF HAWAII
DEPARTMENT OF TRANSPORTATION
HIGHWAYS DIVISION

PAVEMENT GRADE DETAILS
FROM STA. 225+00 TO STA. 237+15.80
FARRINGTON HIGHWAY WIDENING
PROJECT B-900-01-64
UNIT I

SCALE: 1" = 20'

SHEET No. 2 OF 2 SHEETS