

INDEX TO DRAWINGS	
COMPOSITE AND SET SHT. NO.	DESCRIPTION
1	TITLE SHEET
2-3	TYPICAL ROADWAY SECTIONS
4-8	PLAN & PROFILE
9-10	PAVEMENT GRADE DETAILS
11	TRANSITION DETAILS
12	INTERSECTION DETAILS
13-14	DRIVEWAY DETAILS
15-20	ORDER OF WORK AND DETOURS
21-22	ROADWAY SIGNS AND LANDSCAPING
23-33	STD. ROADWAY SIGNS & GUARDRAILS
34-38	RETAINING WALL DETAILS
39-43	CULVERT DETAILS
44	TYPICAL CUTOFF DITCH
45	TYPE "B" SHOULDER DROP INTAKE
46-47	STD. DRAINAGE DETAILS
48-54	PILI-O-KOE BRIDGE
55-60	MISCELLANEOUS STD. DETAILS
61-63	RIGHT-OF-WAY
64-72	CROSS SECTIONS
73-74	UTILITIES
75-76	UTILITY DETAILS


STATE	FISCAL YEAR	SHEET NO.	TOTAL SHTS.
HAWAII	1967	1	76
PROJECT NO. B-900-01-64			UNIT I

STATE OF HAWAII  
DEPARTMENT OF TRANSPORTATION  
HIGHWAYS DIVISION  
HONOLULU, HAWAII  
"AS BUILT"  
PLANS OF  
**FARRINGTON HIGHWAY WIDENING**  
ULEHAWA STREAM TO PILIOKOE GULCH  
(NANAKULI BRIDGE TO PILIOKOE GULCH)  
PROJECT B-900-01-64, UNIT I

DISTRICTS OF EWA & WAIANAE  
ISLAND OF OAHU

SCALES:  
PLAN & PROFILE ..... HOR. 1" = 50'  
VER. 1" = 10'  
CROSS SECTIONS ..... HOR. 1" = 10'  
VER. 1" = 10'


LAYOUT PLAN:  
GROSS LENGTH OF PROJECT ..... 0.997 MI.  
BRIDGES OVER 20'-0" SPAN ..... 0.011 MI.  
NET LENGTH OF ROADWAY ..... 0.986 MI.

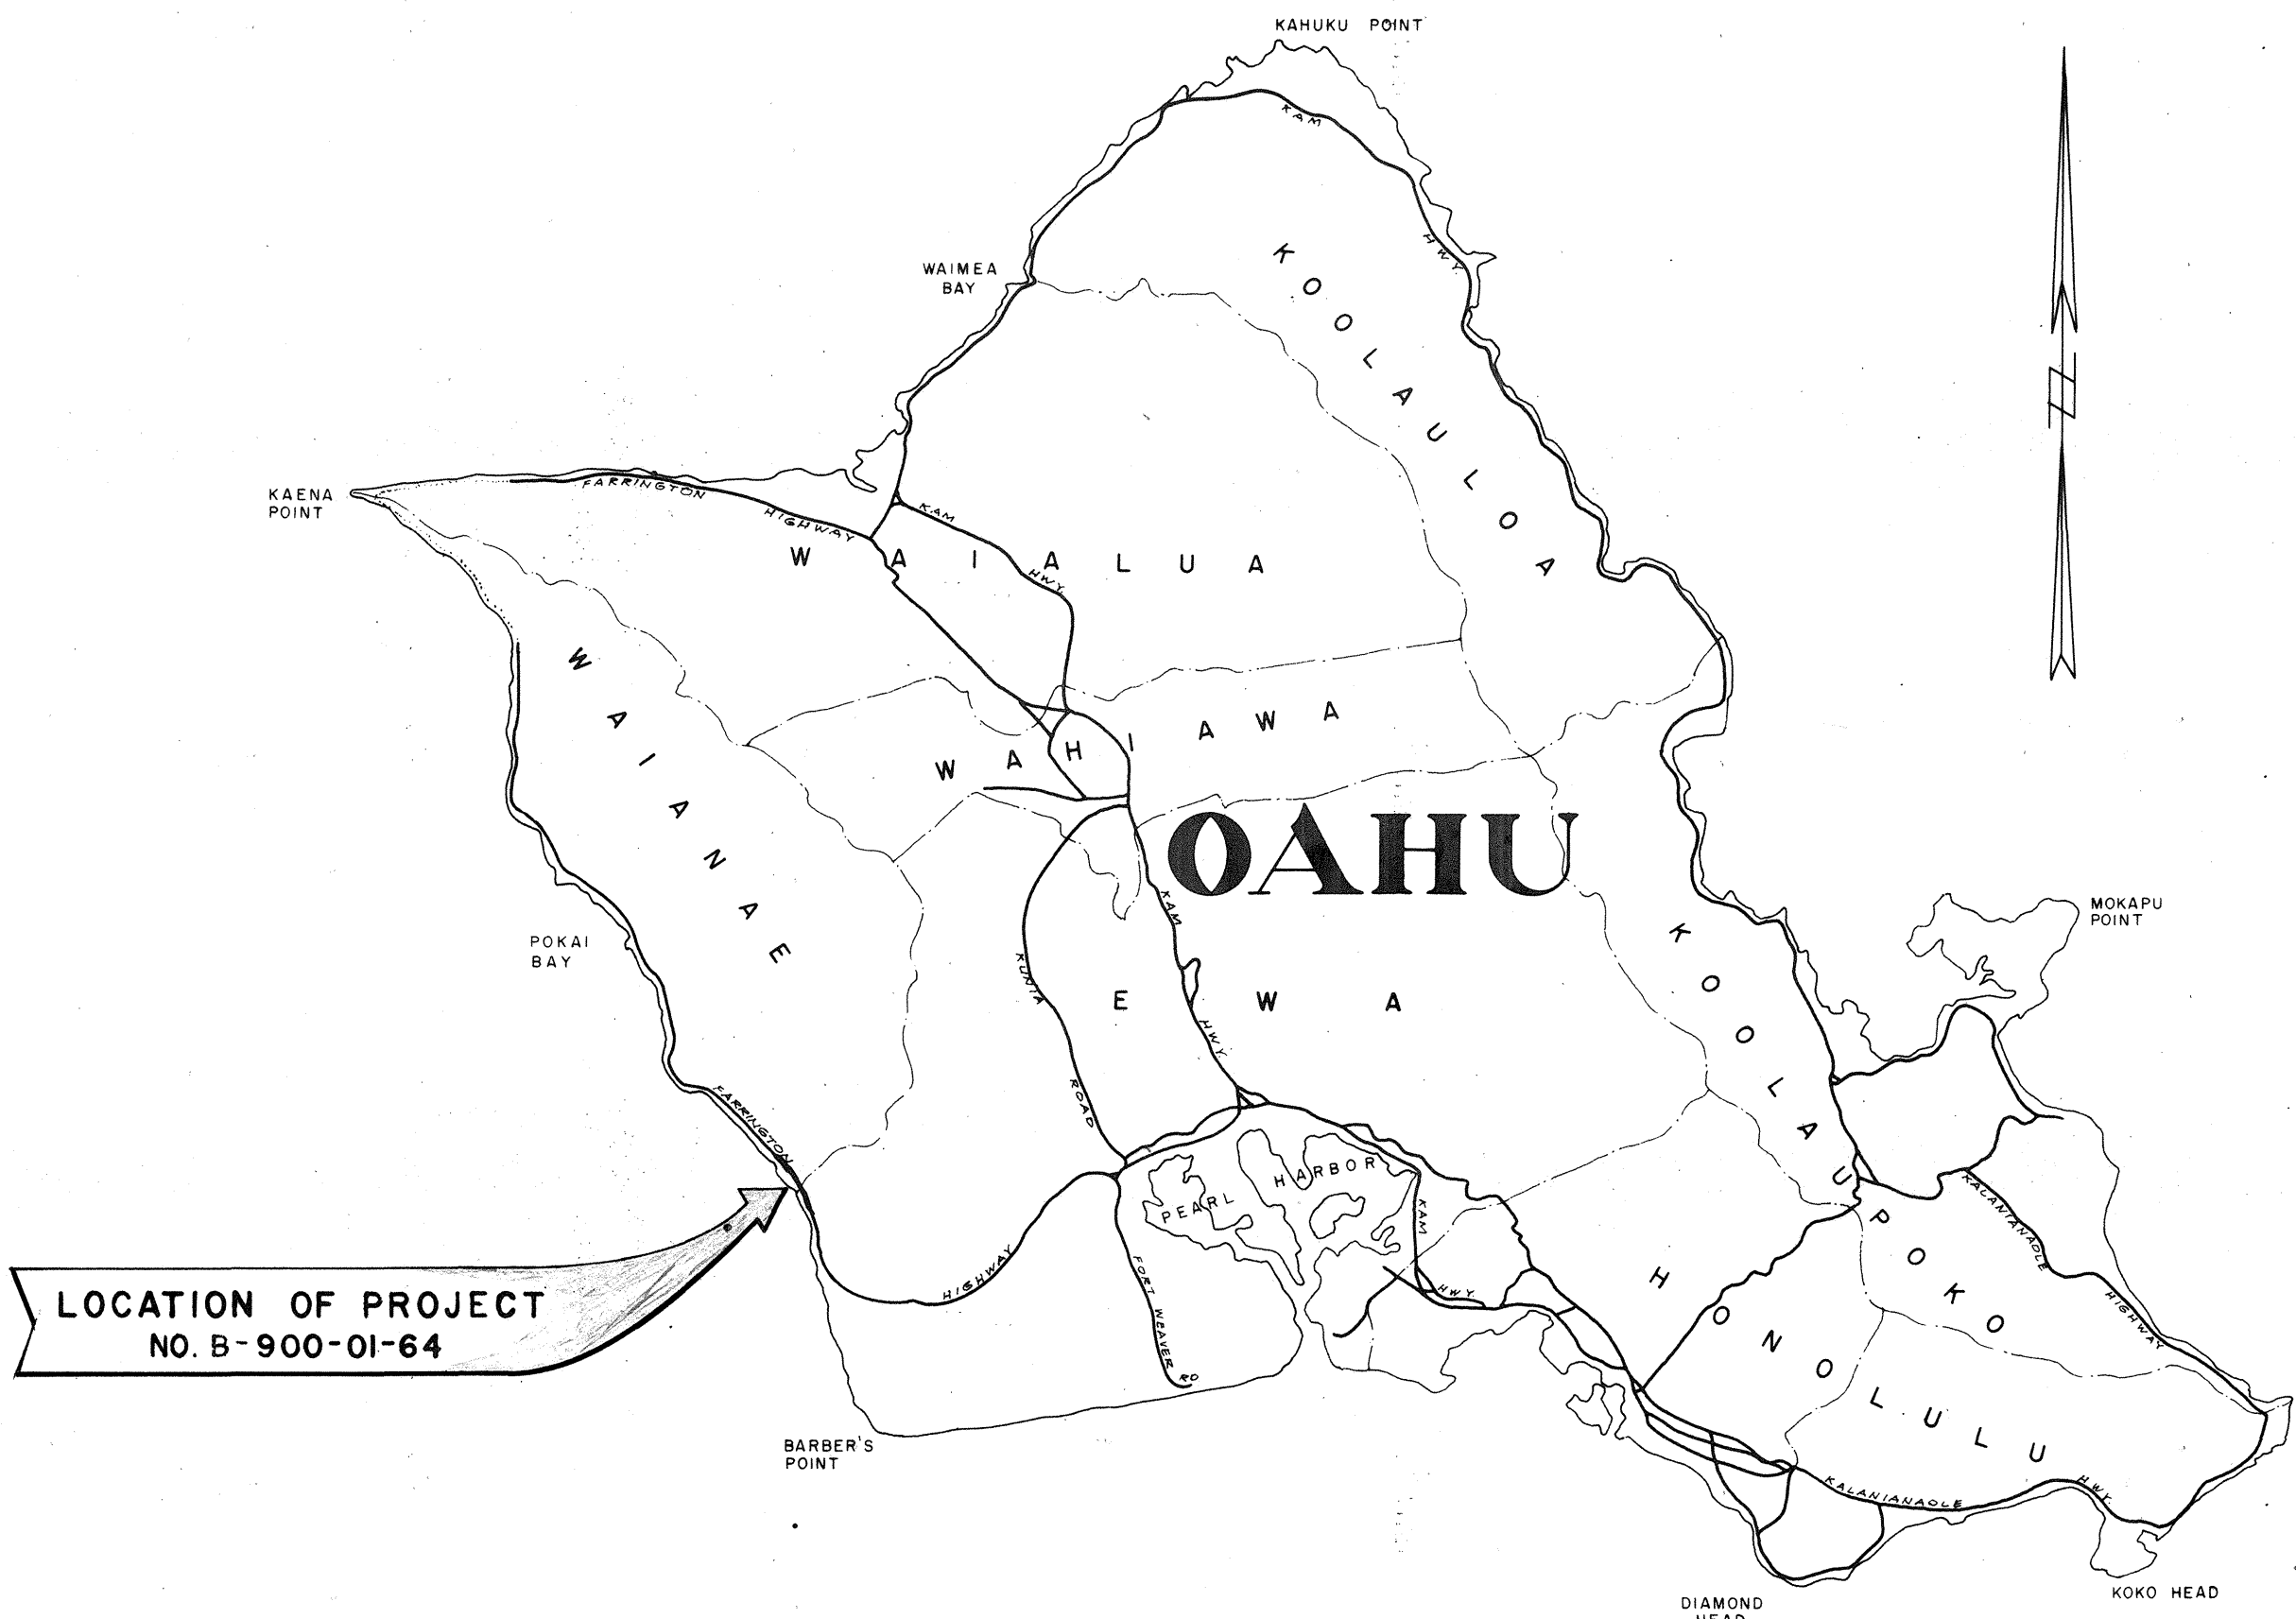


NOTE:  
ALL CHANGES MADE DURING CONSTRUCTION HAVE BEEN INCORPORATED ON THESE PLANS IN RED EXCEPT CHANGES IN THE ORIGINAL THEORETICAL QUANTITIES. FOR ACTUAL QUANTITIES, REFER TO PROJECT LEDGER AND COMPUTATION BOOK.

*Leong J. Kau*  
RESIDENT ENGINEER  
11/26/73  
DATE

Plans Prepared By,  
**SAM O. HIROTA, P. E.**  
CIVIL ENGINEERS & SURVEYORS

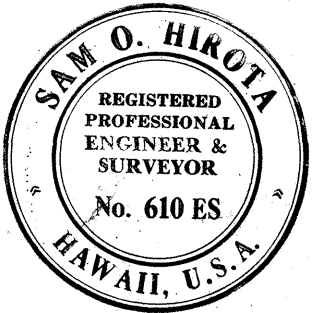

THIS WORK WAS PREPARED BY  
ME OR UNDER MY SUPERVISION.  
*Sam O. Hirota, P.E.*

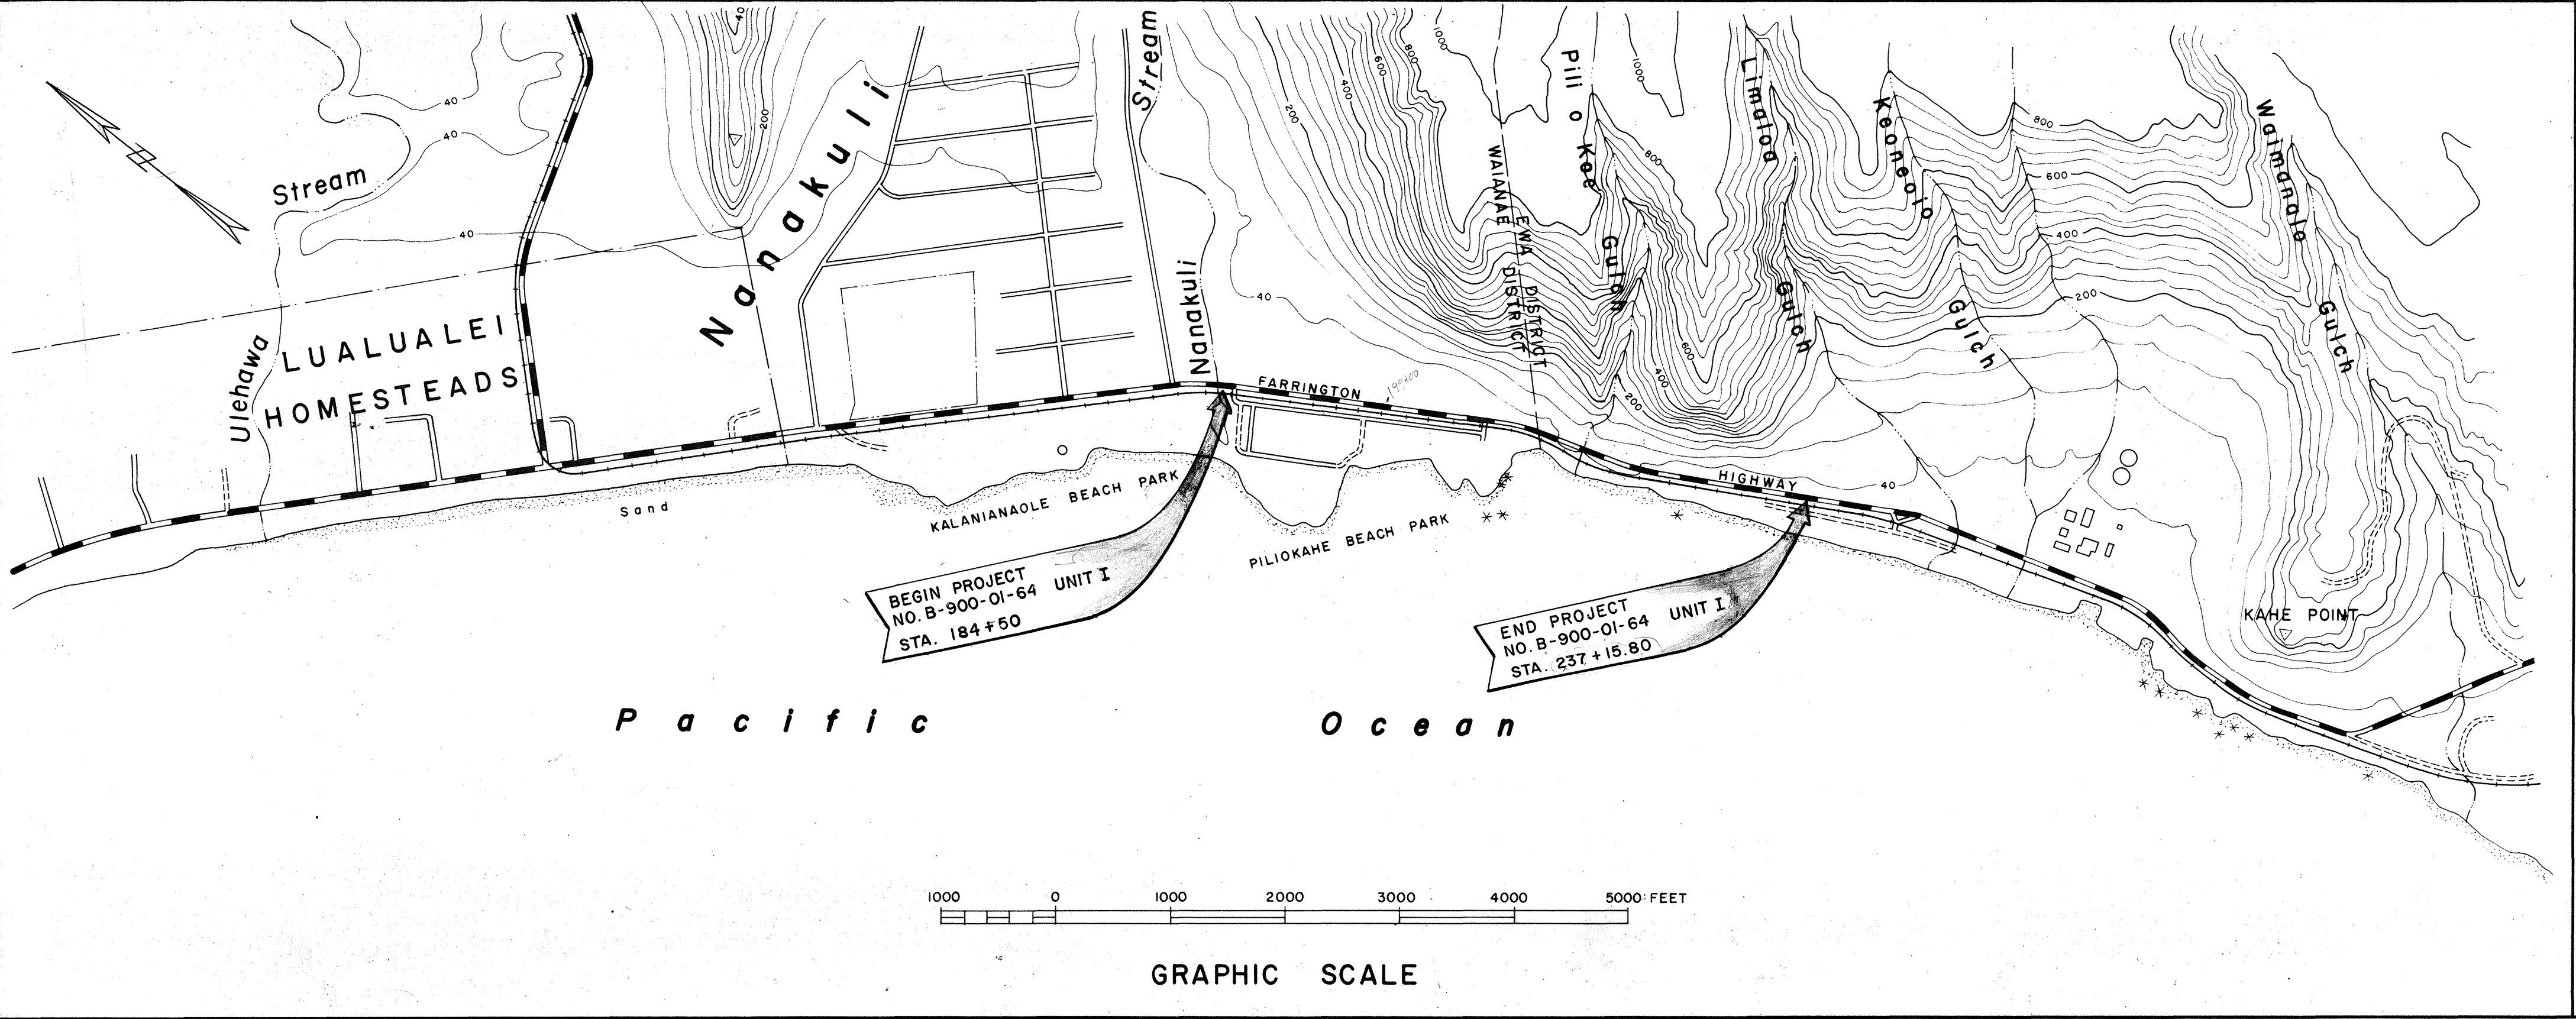

DEPARTMENT OF TRANSPORTATION  
STATE OF HAWAII  
APPROVED:  
*John H. Smith*  
10/25/67  
DATE