

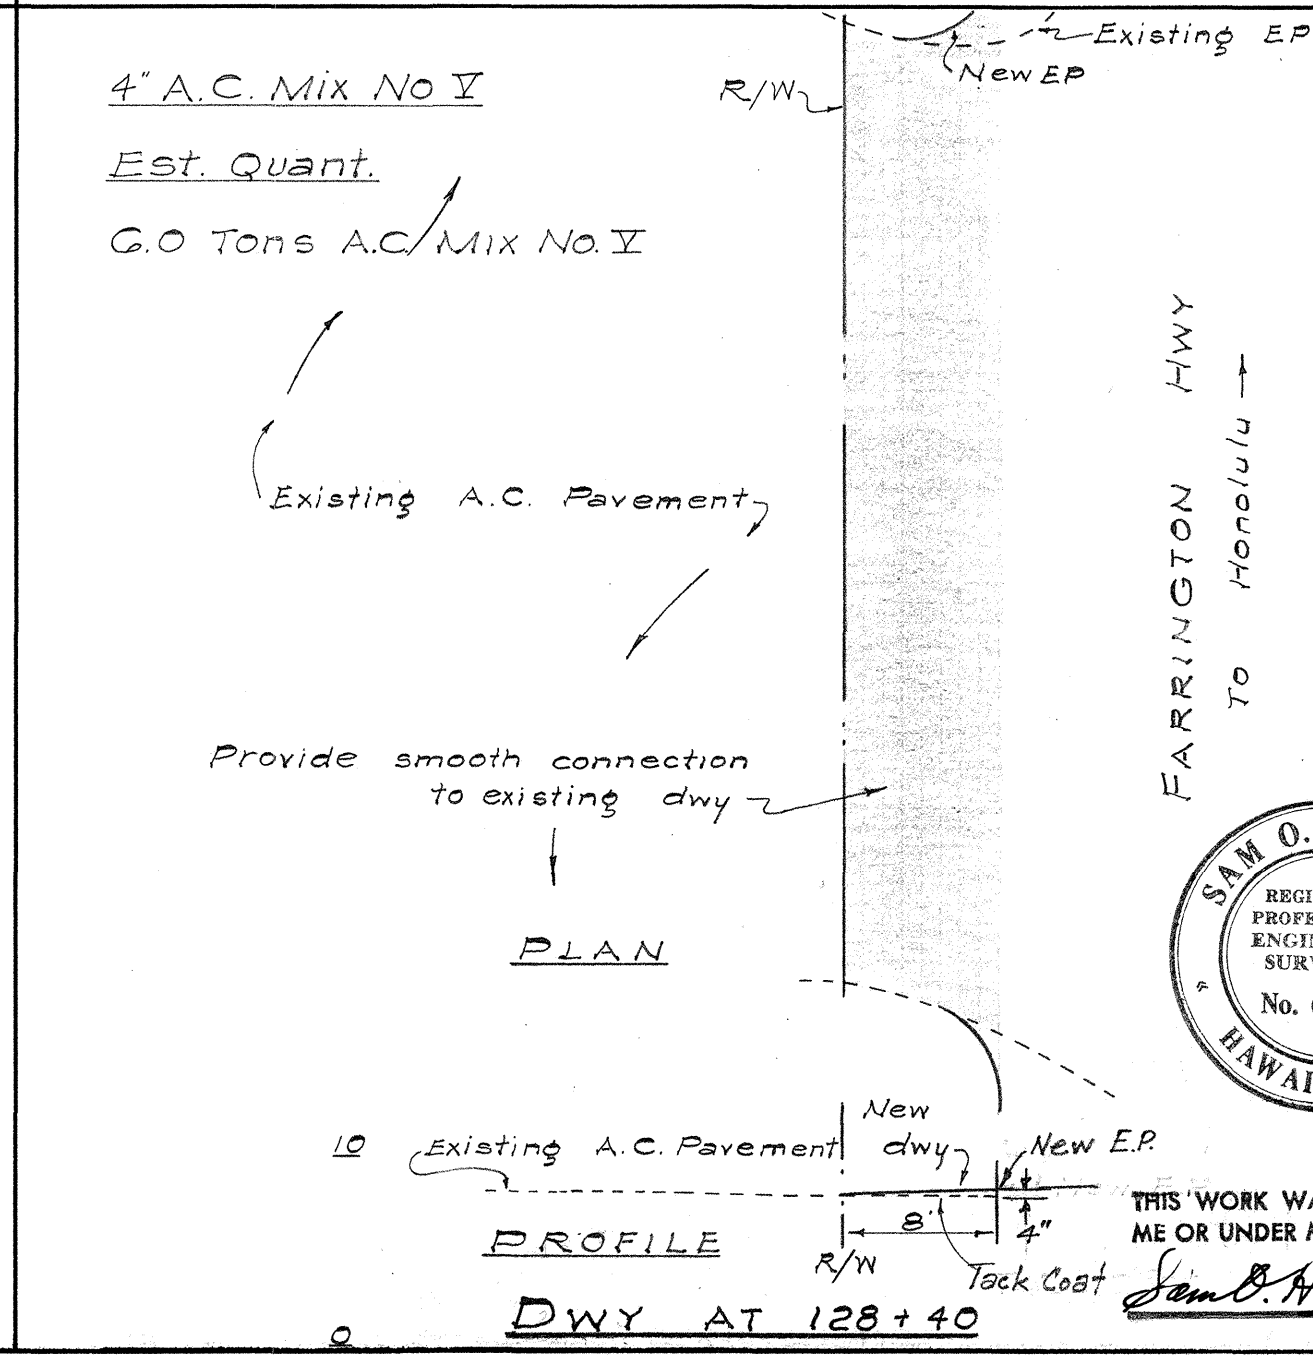
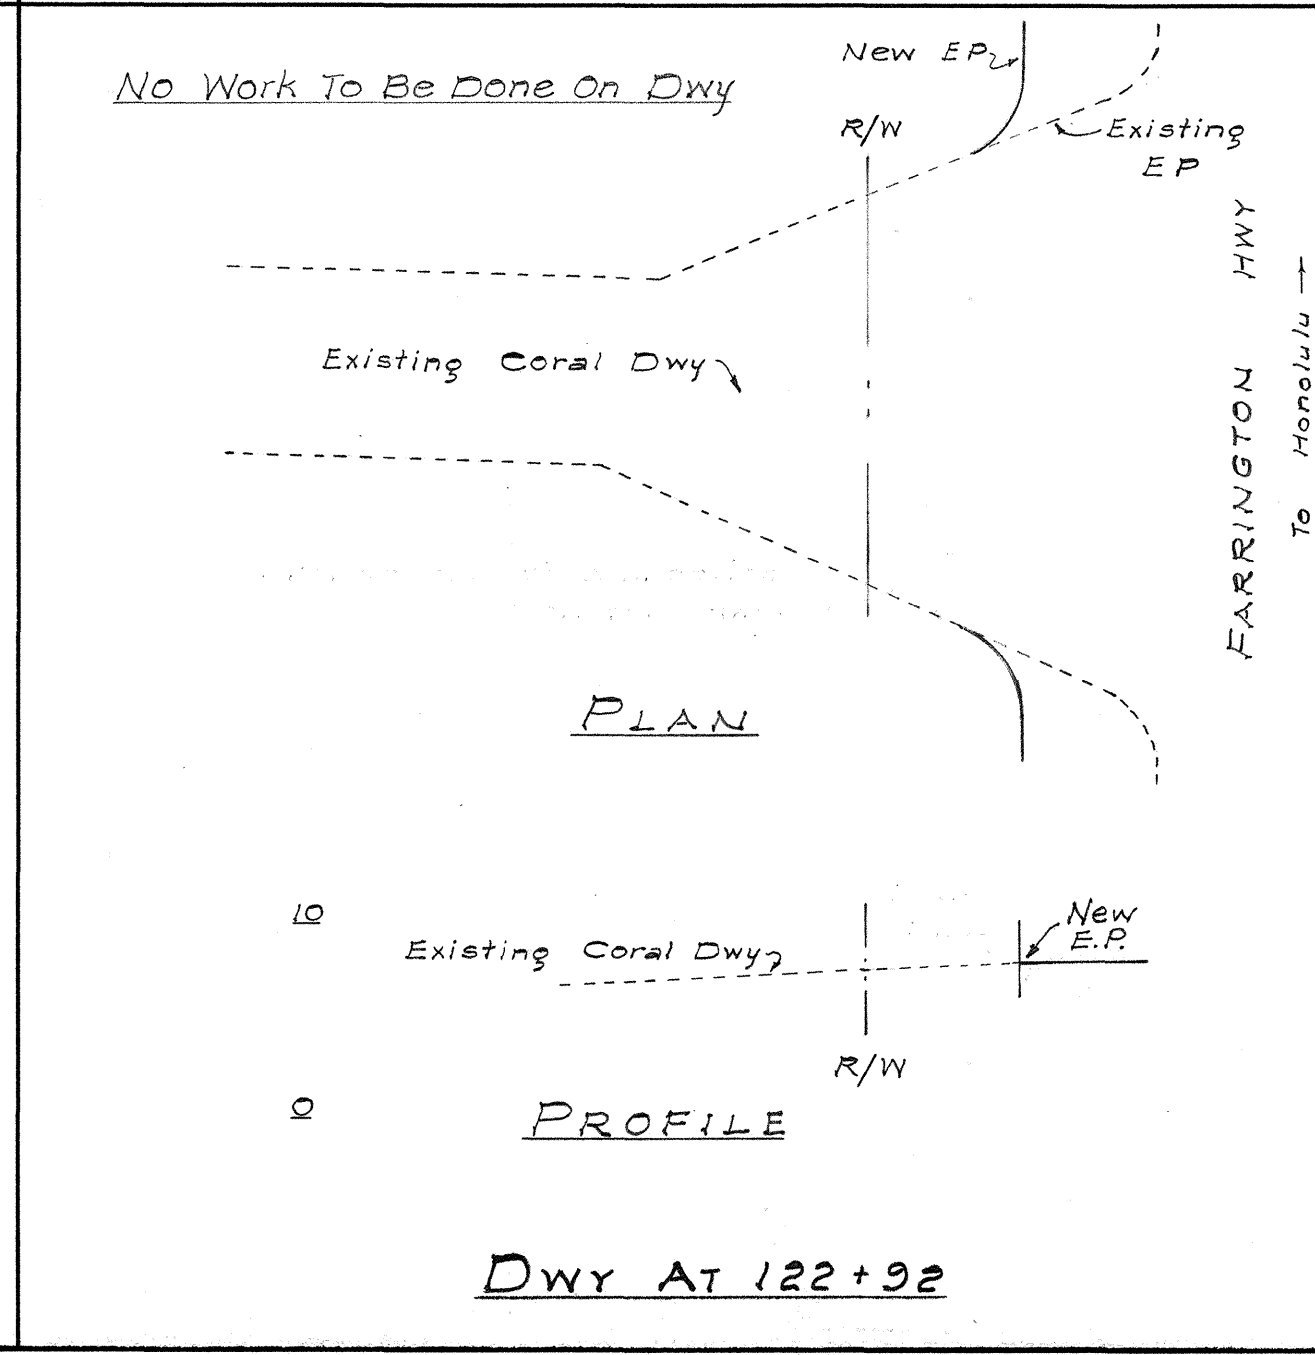
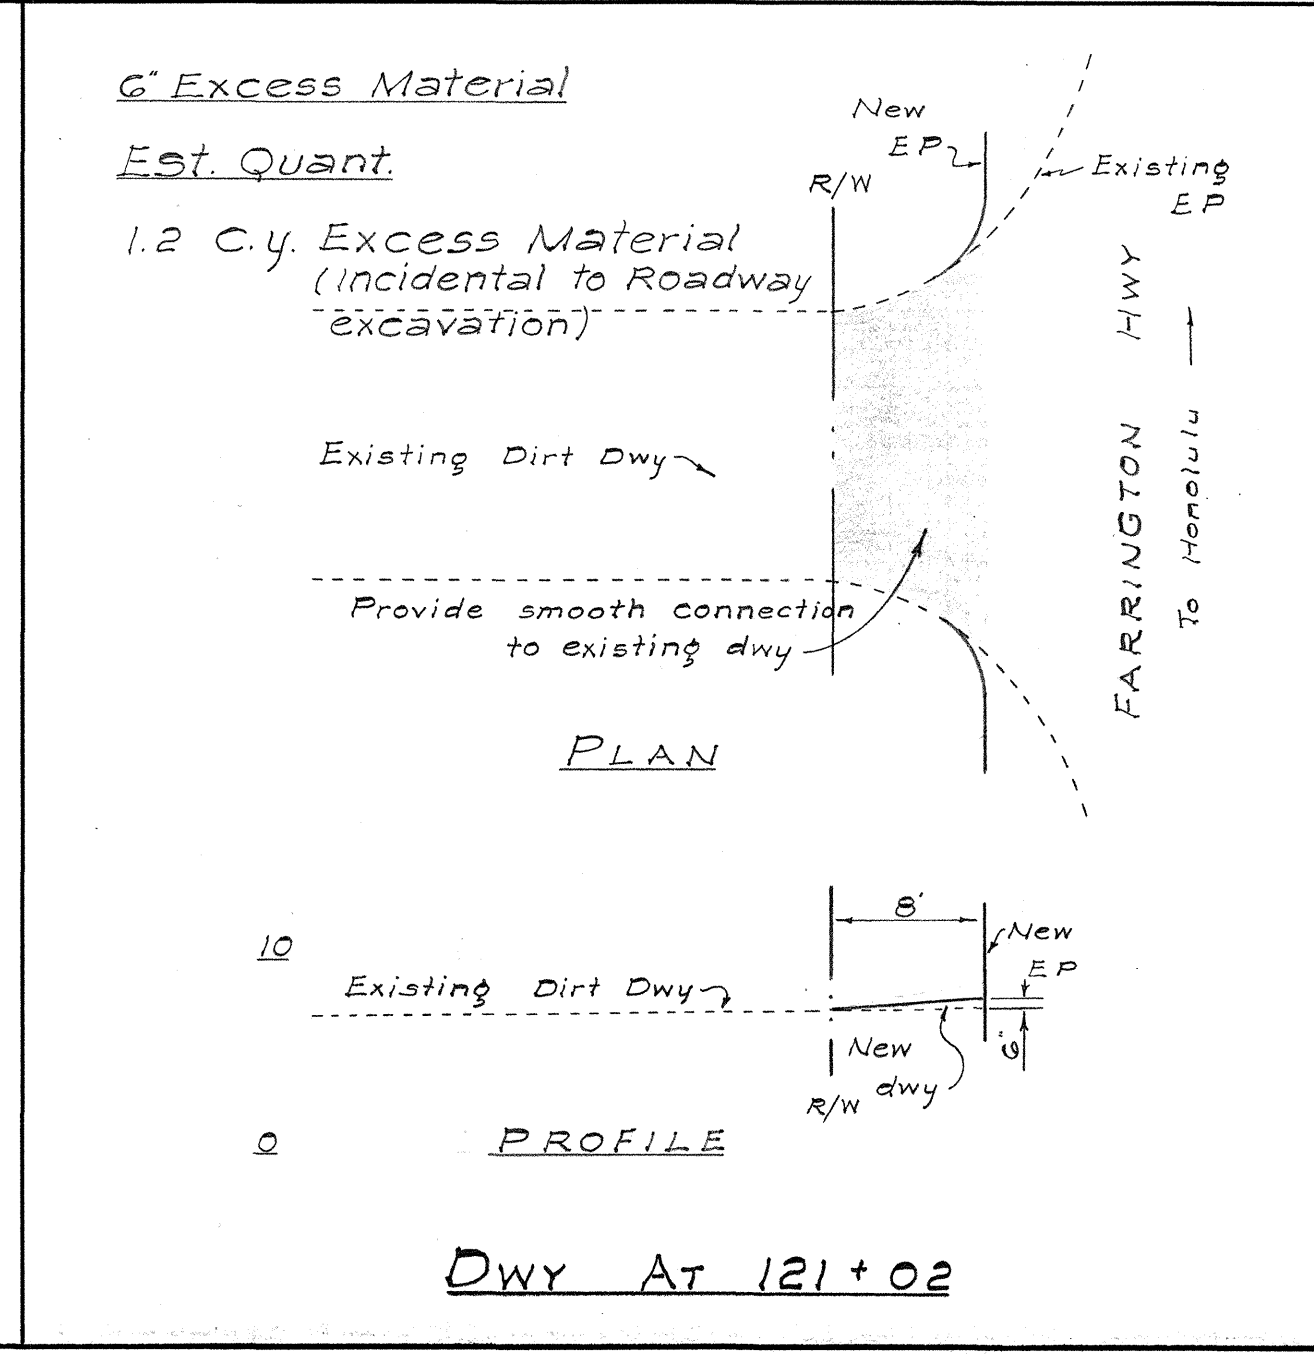
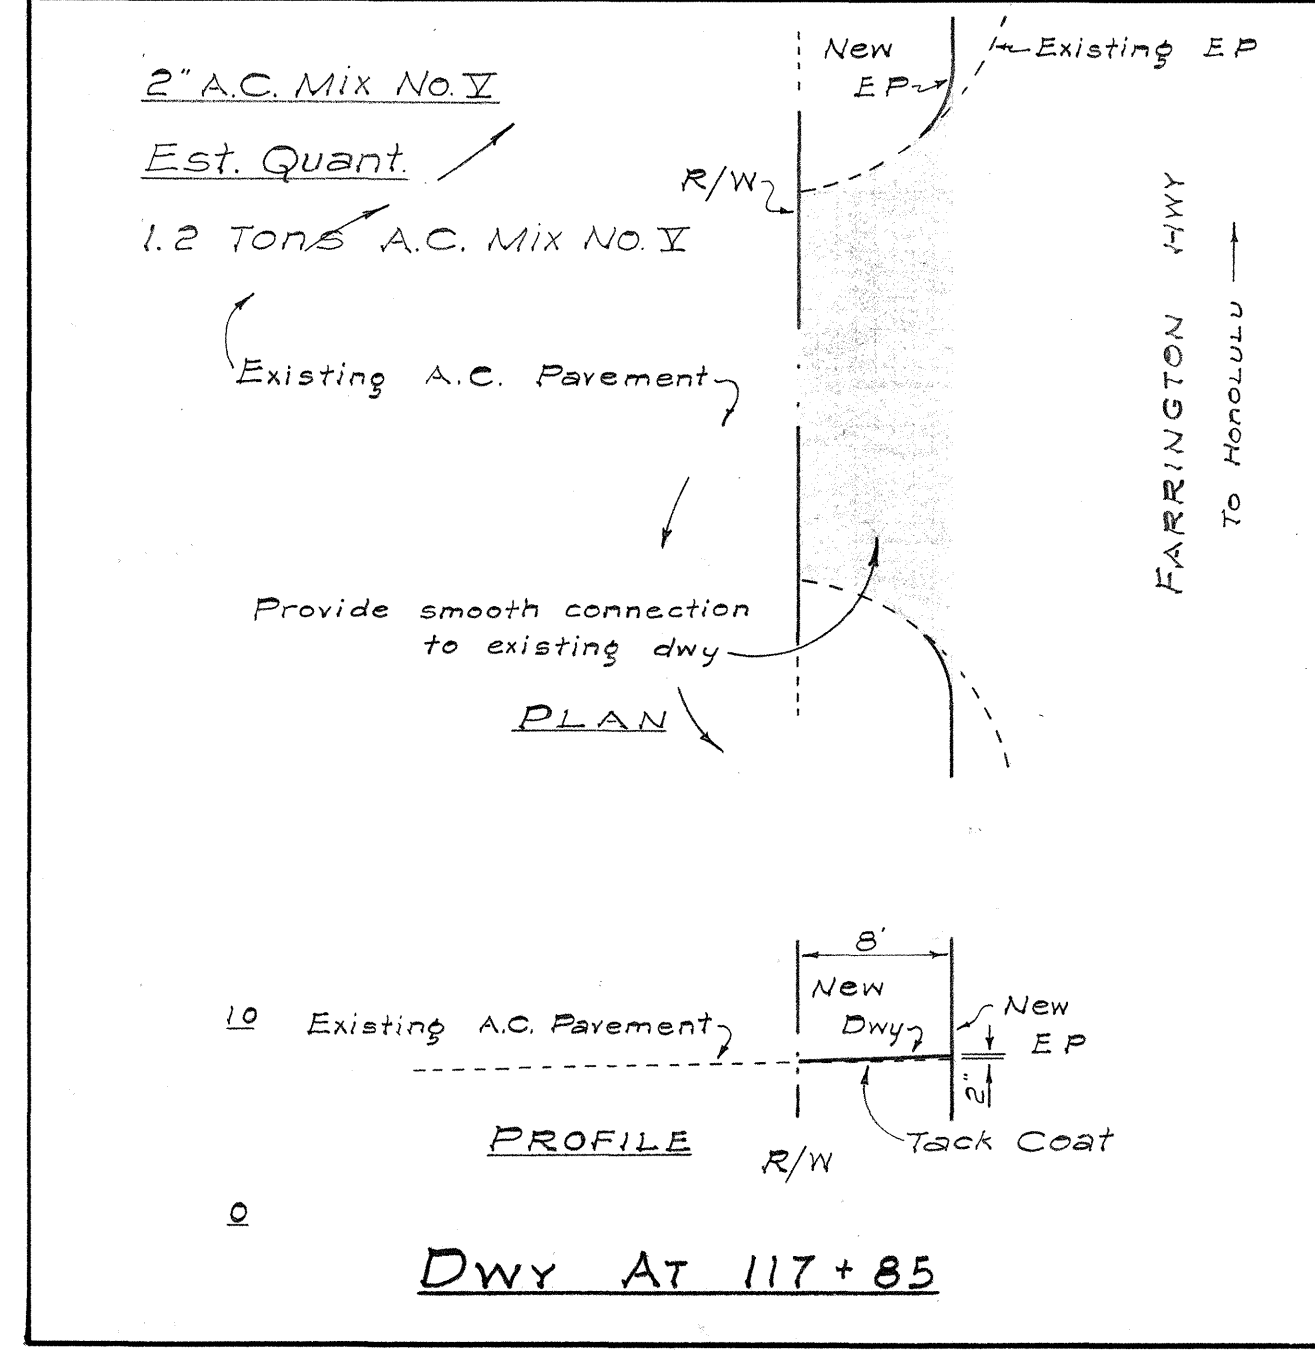
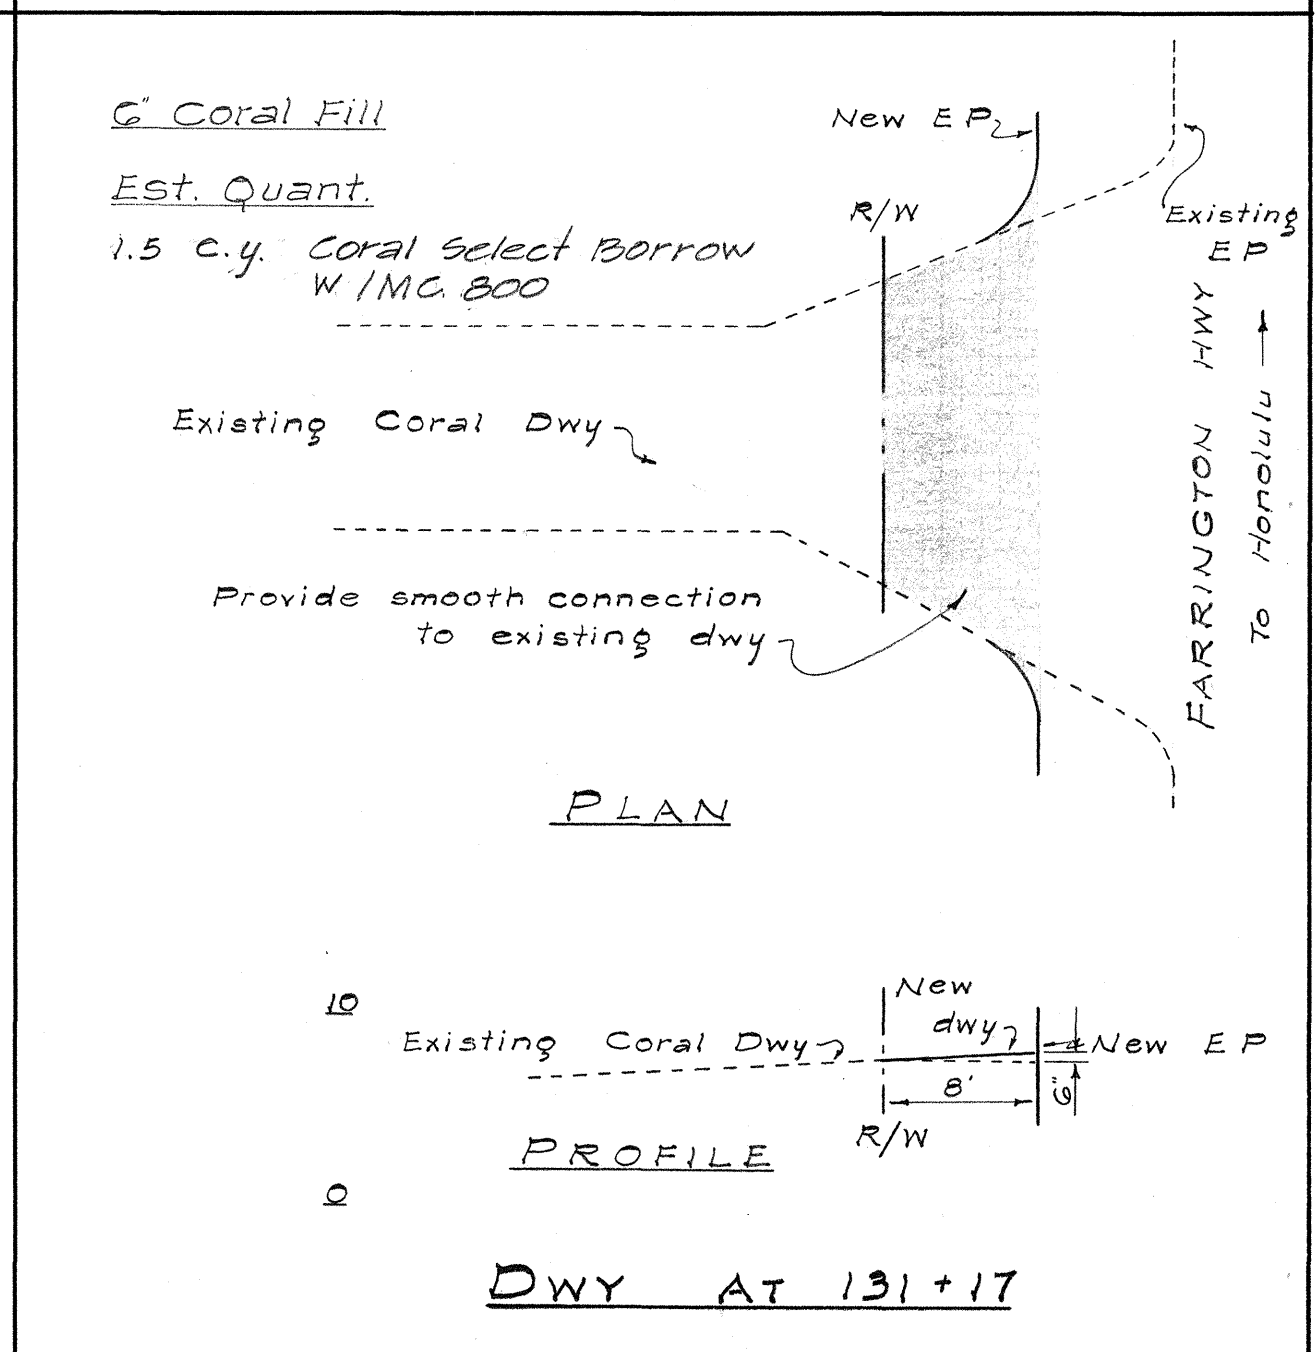
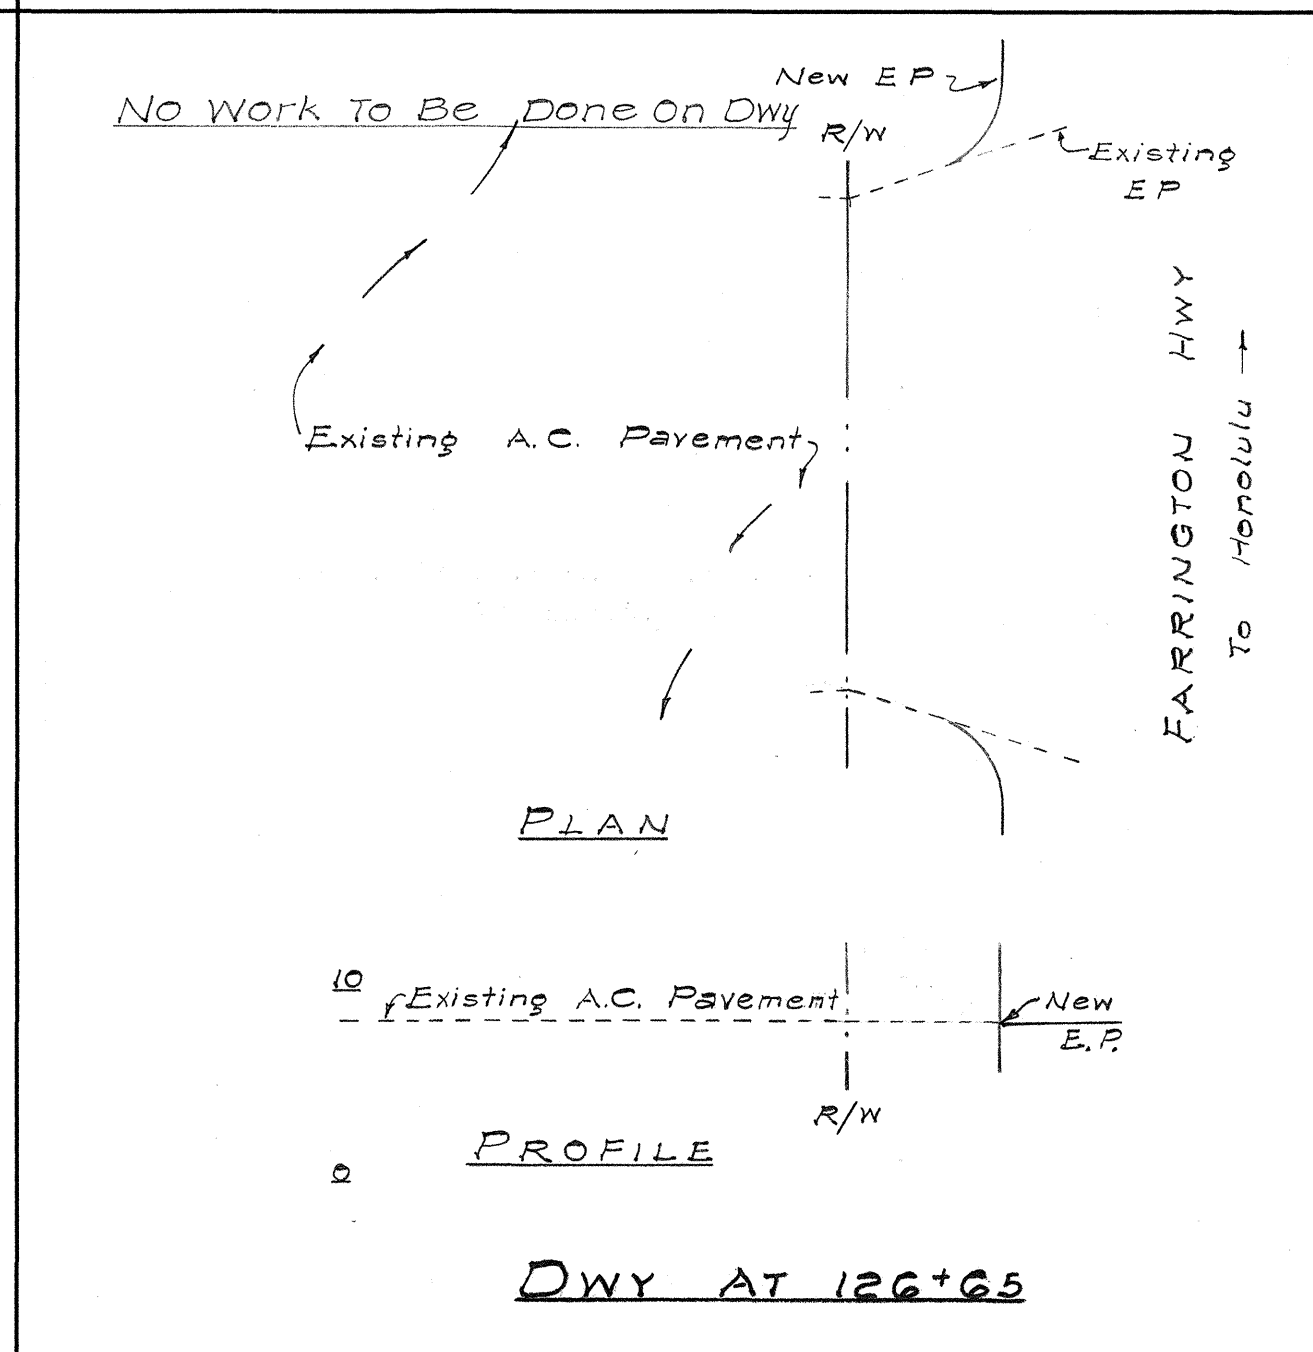
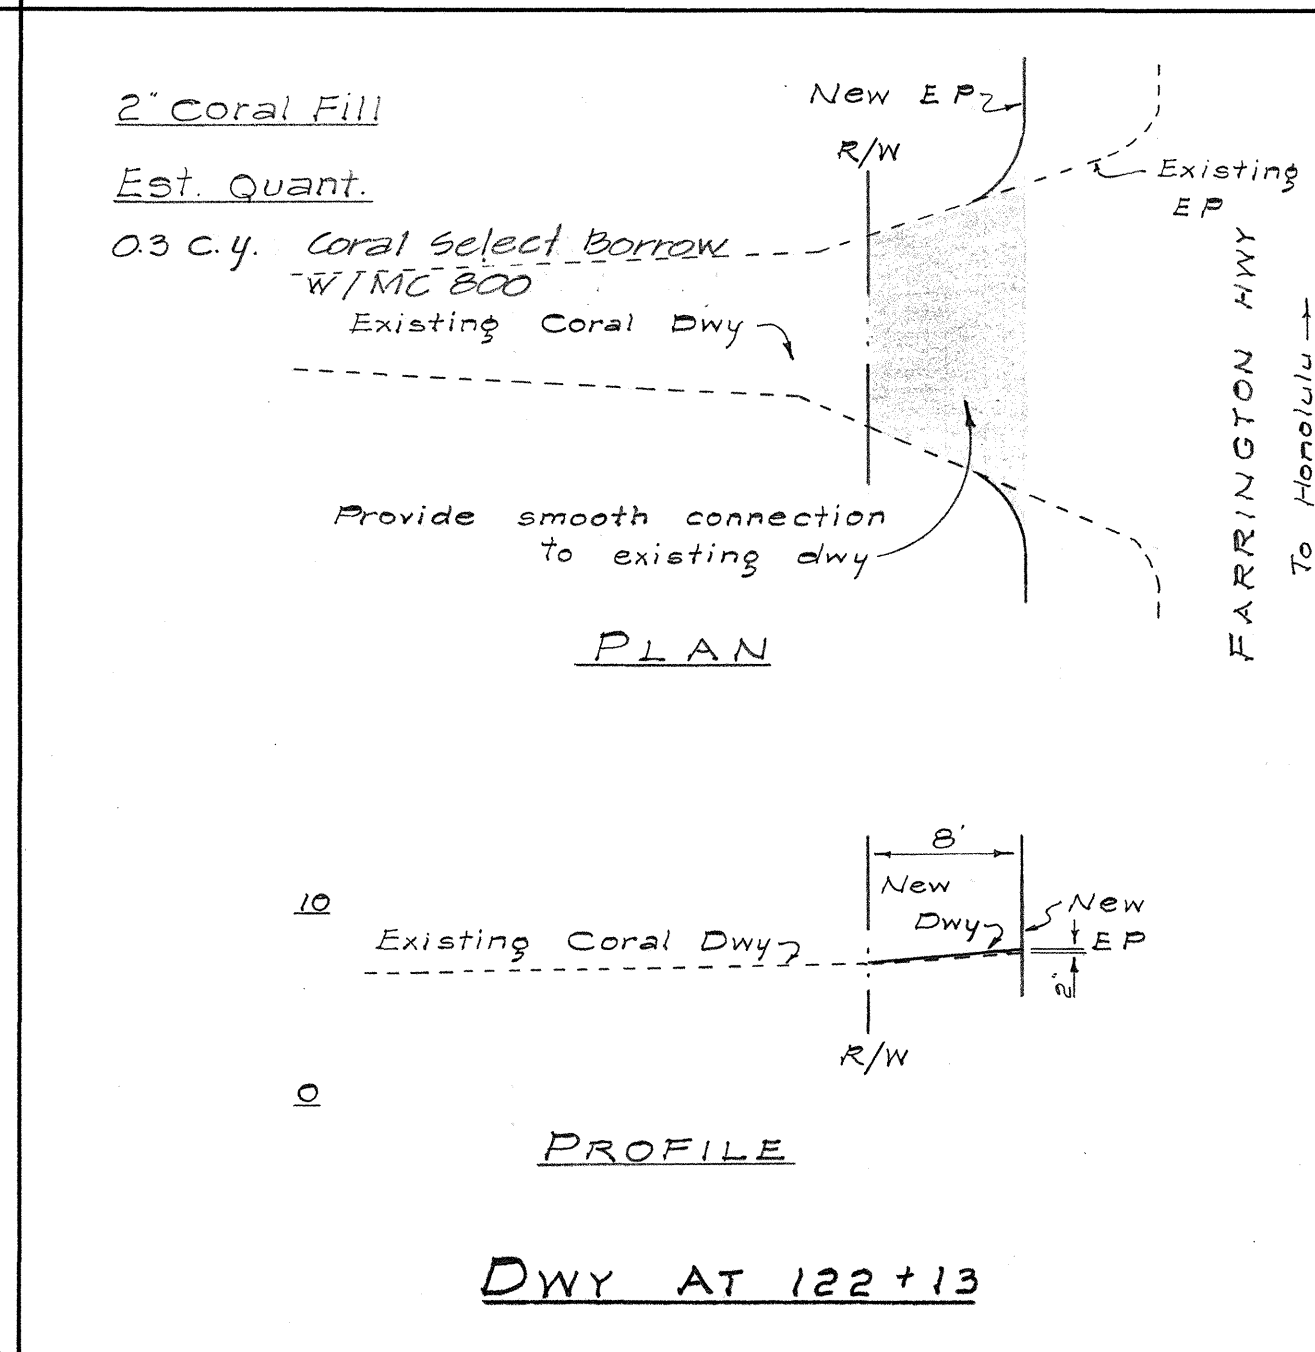
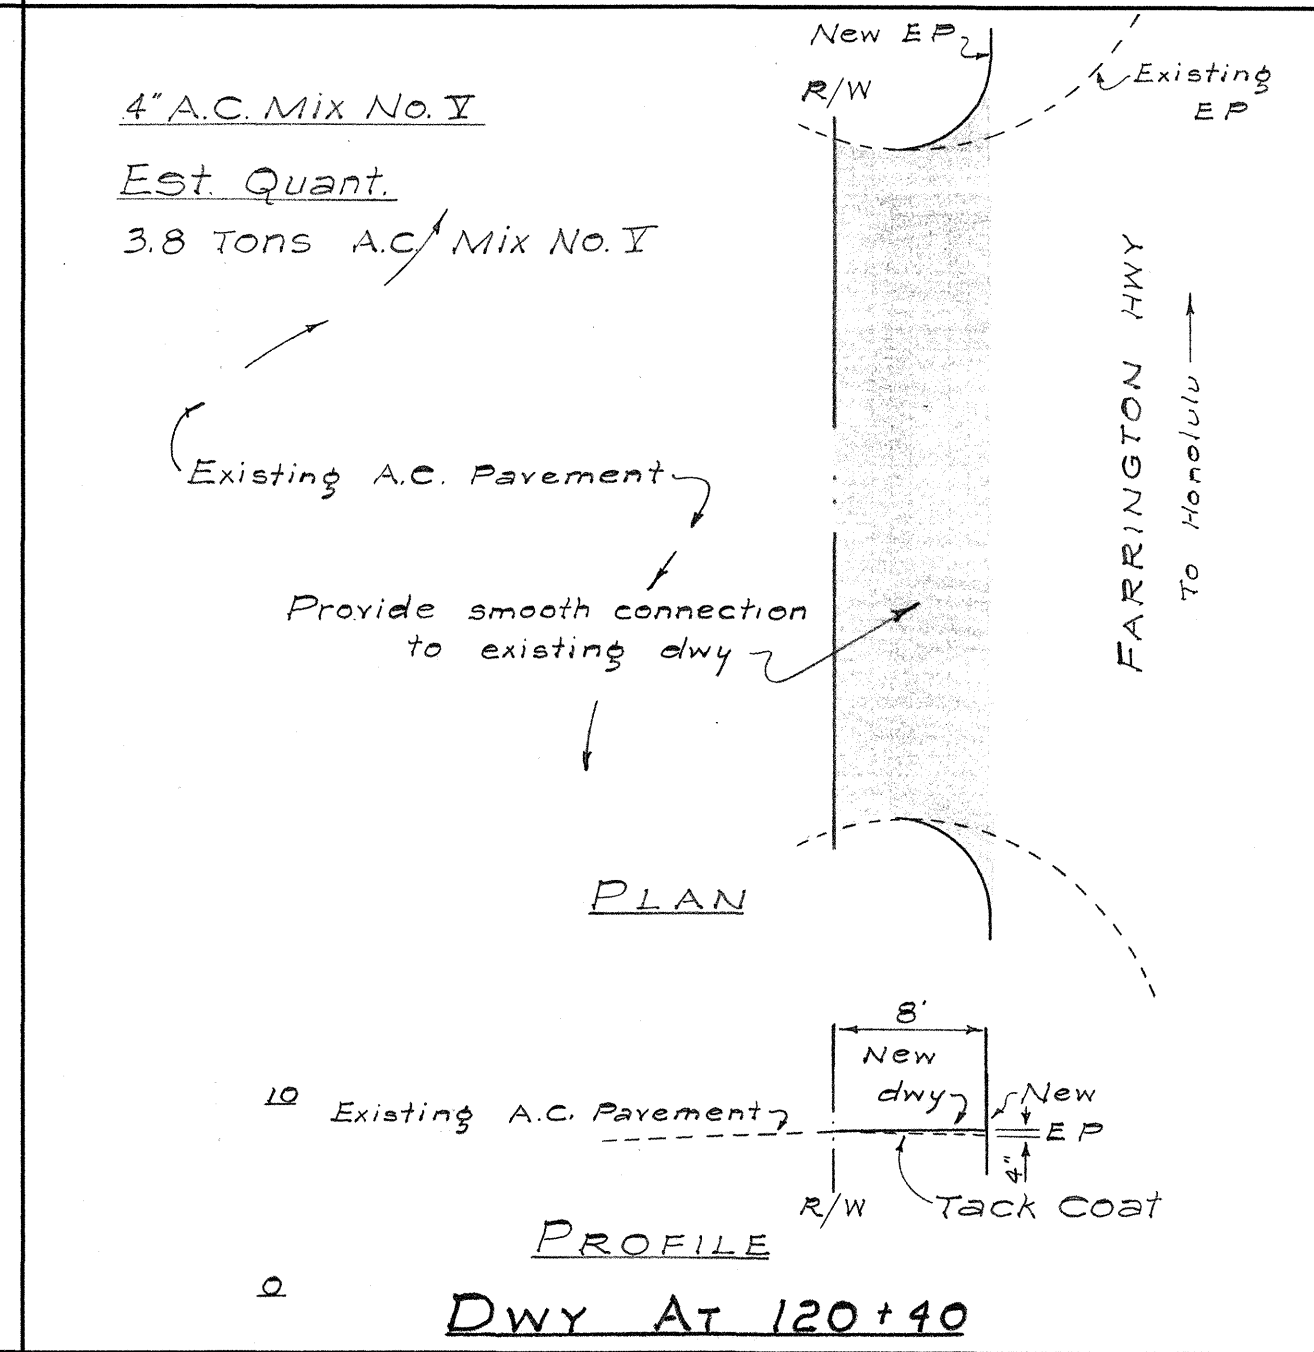
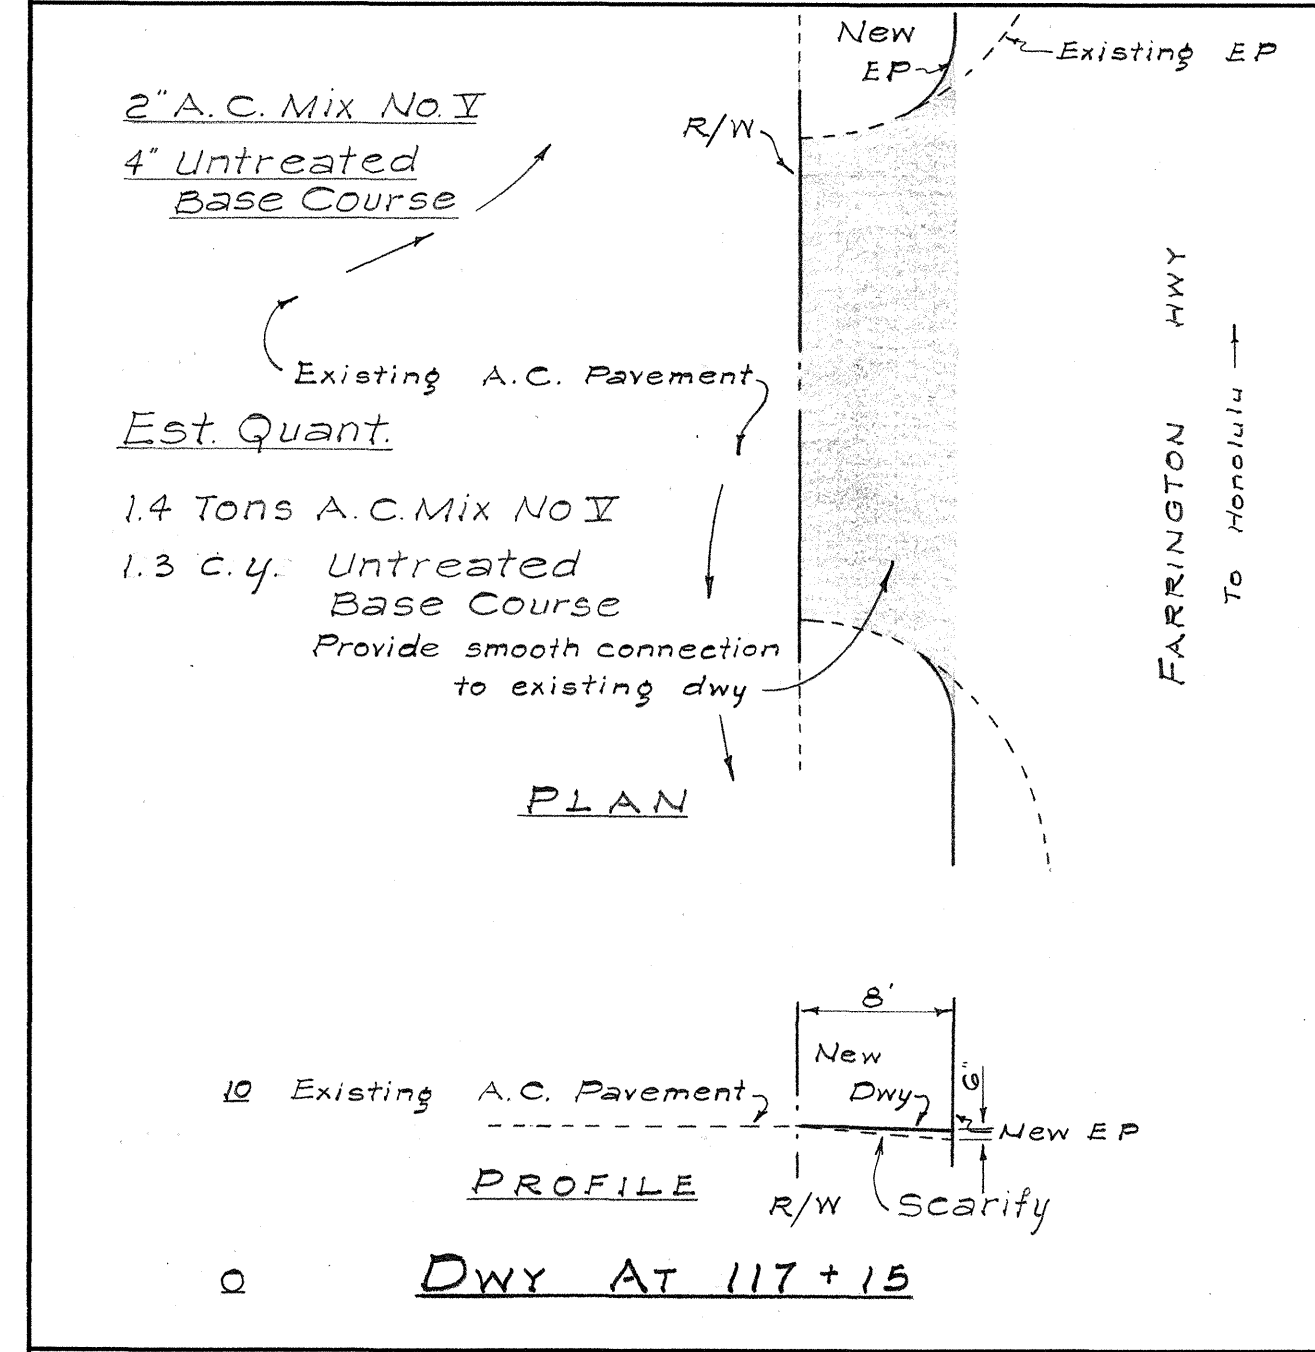
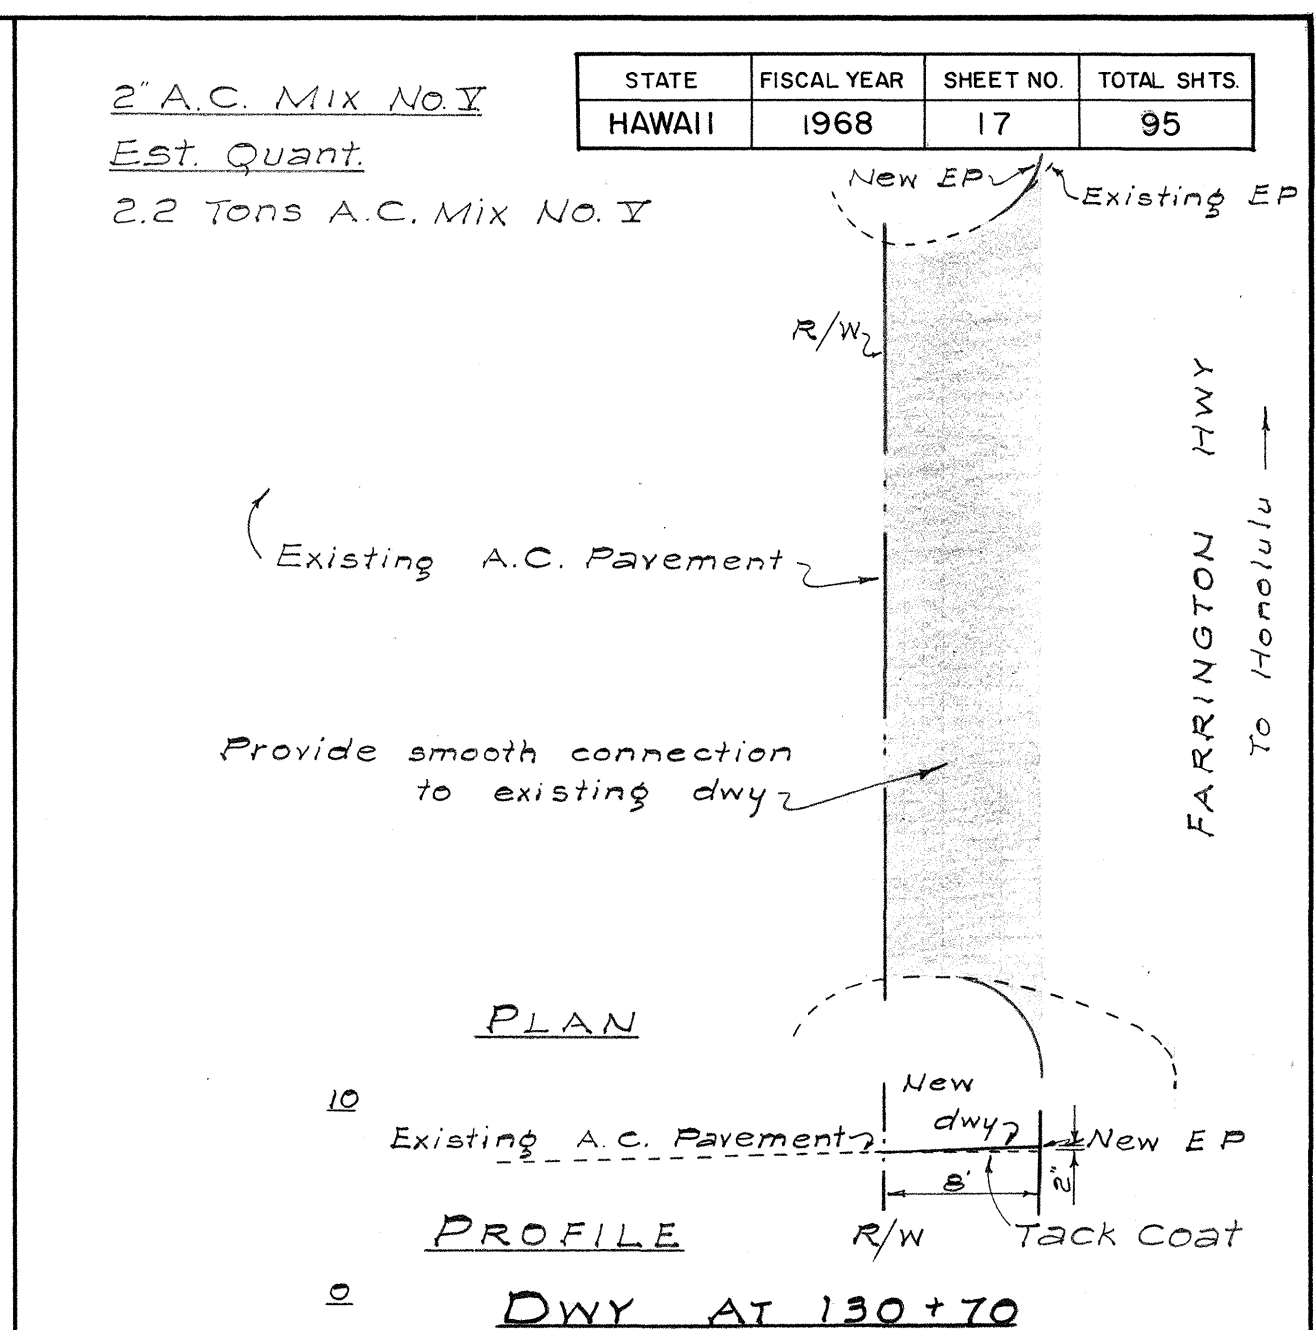
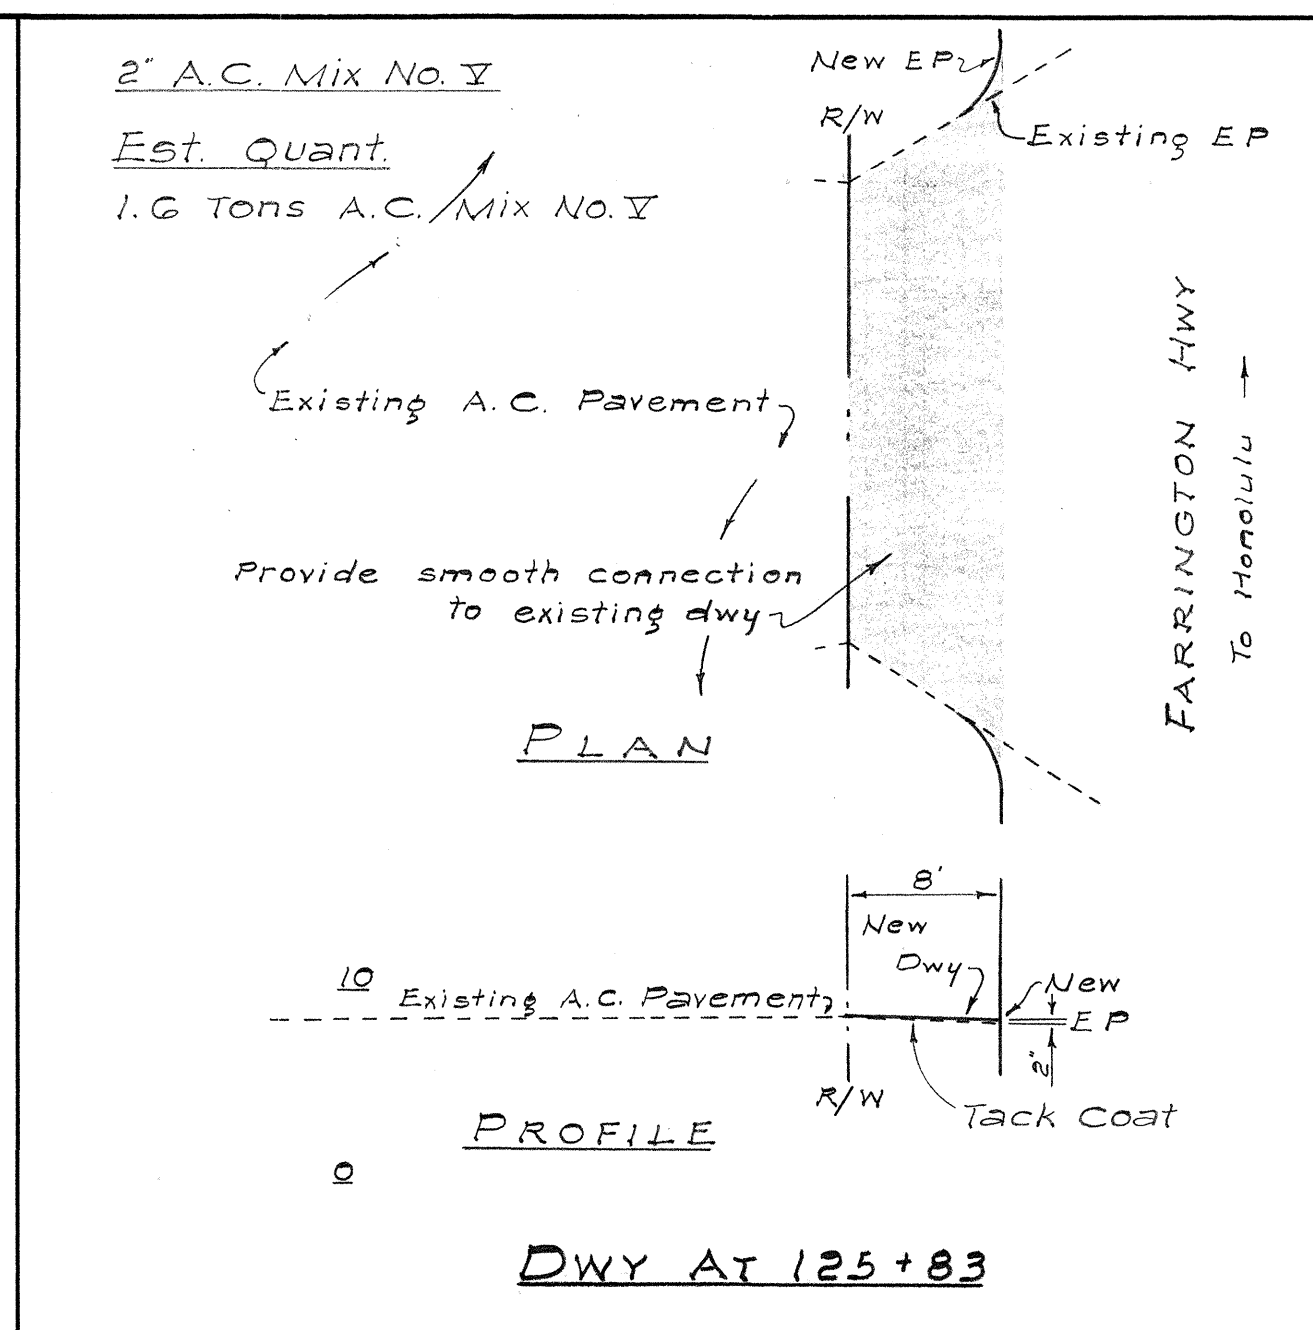
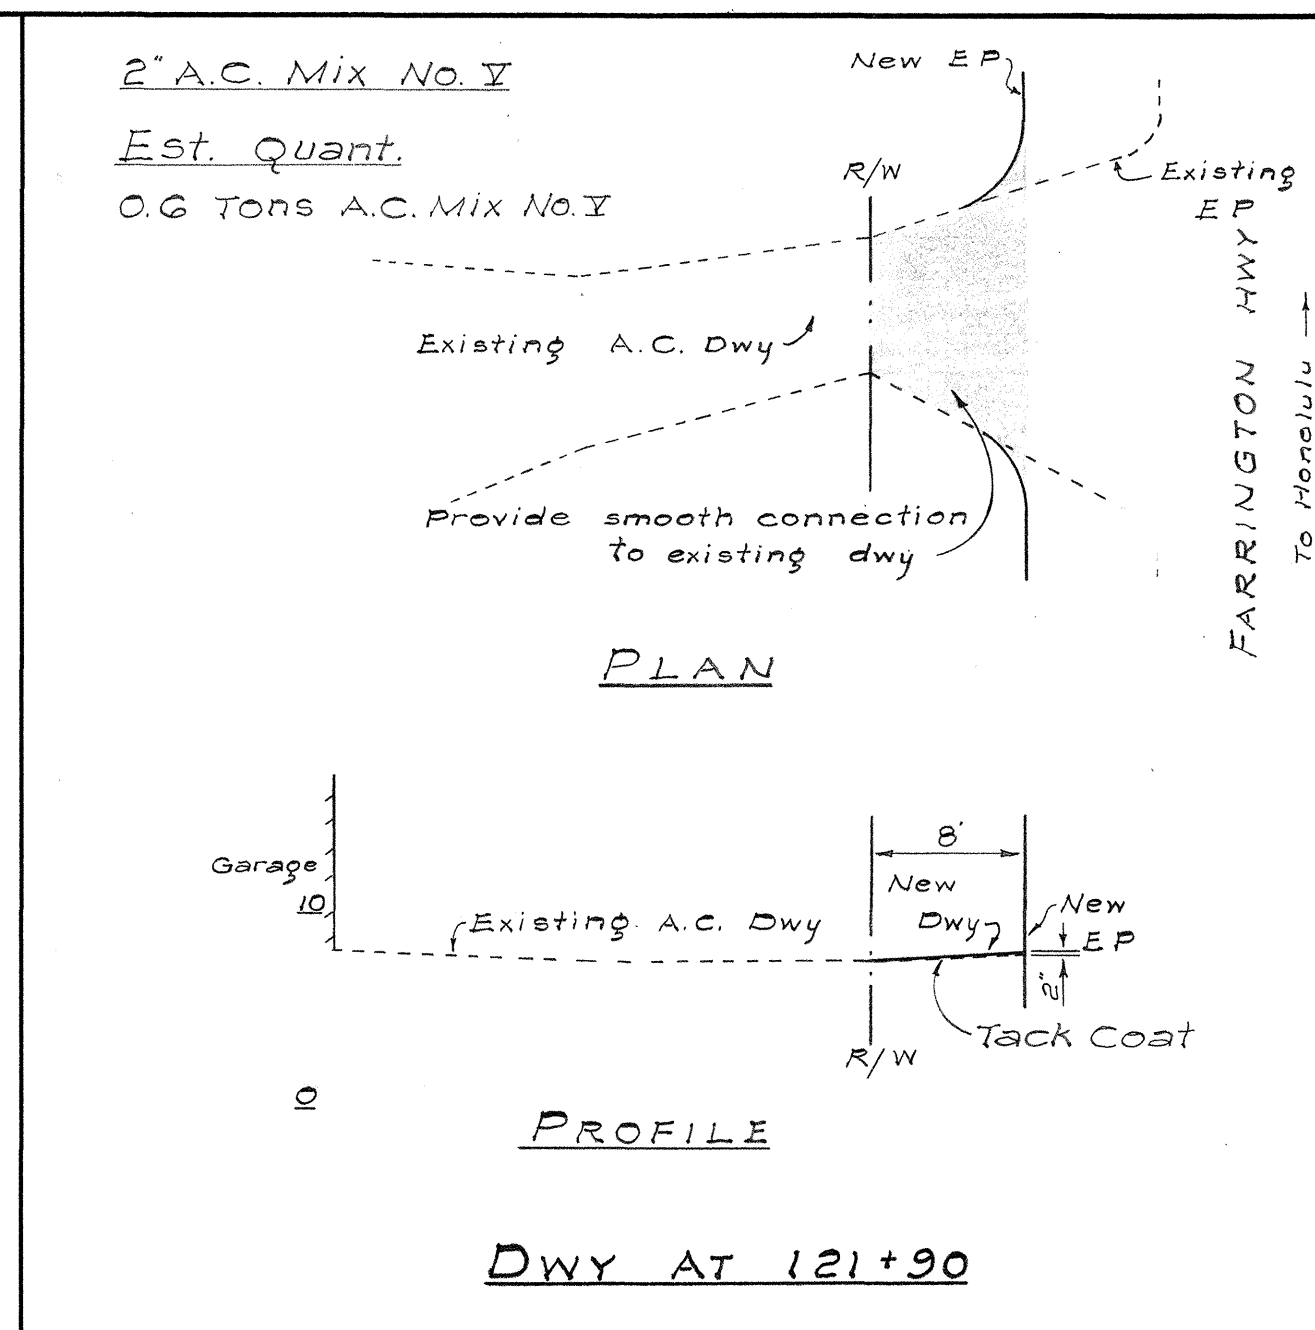


STATE	FISCAL YEAR	SHEET NO.	TOTAL SHTS.
HAWAII	1968	17	95

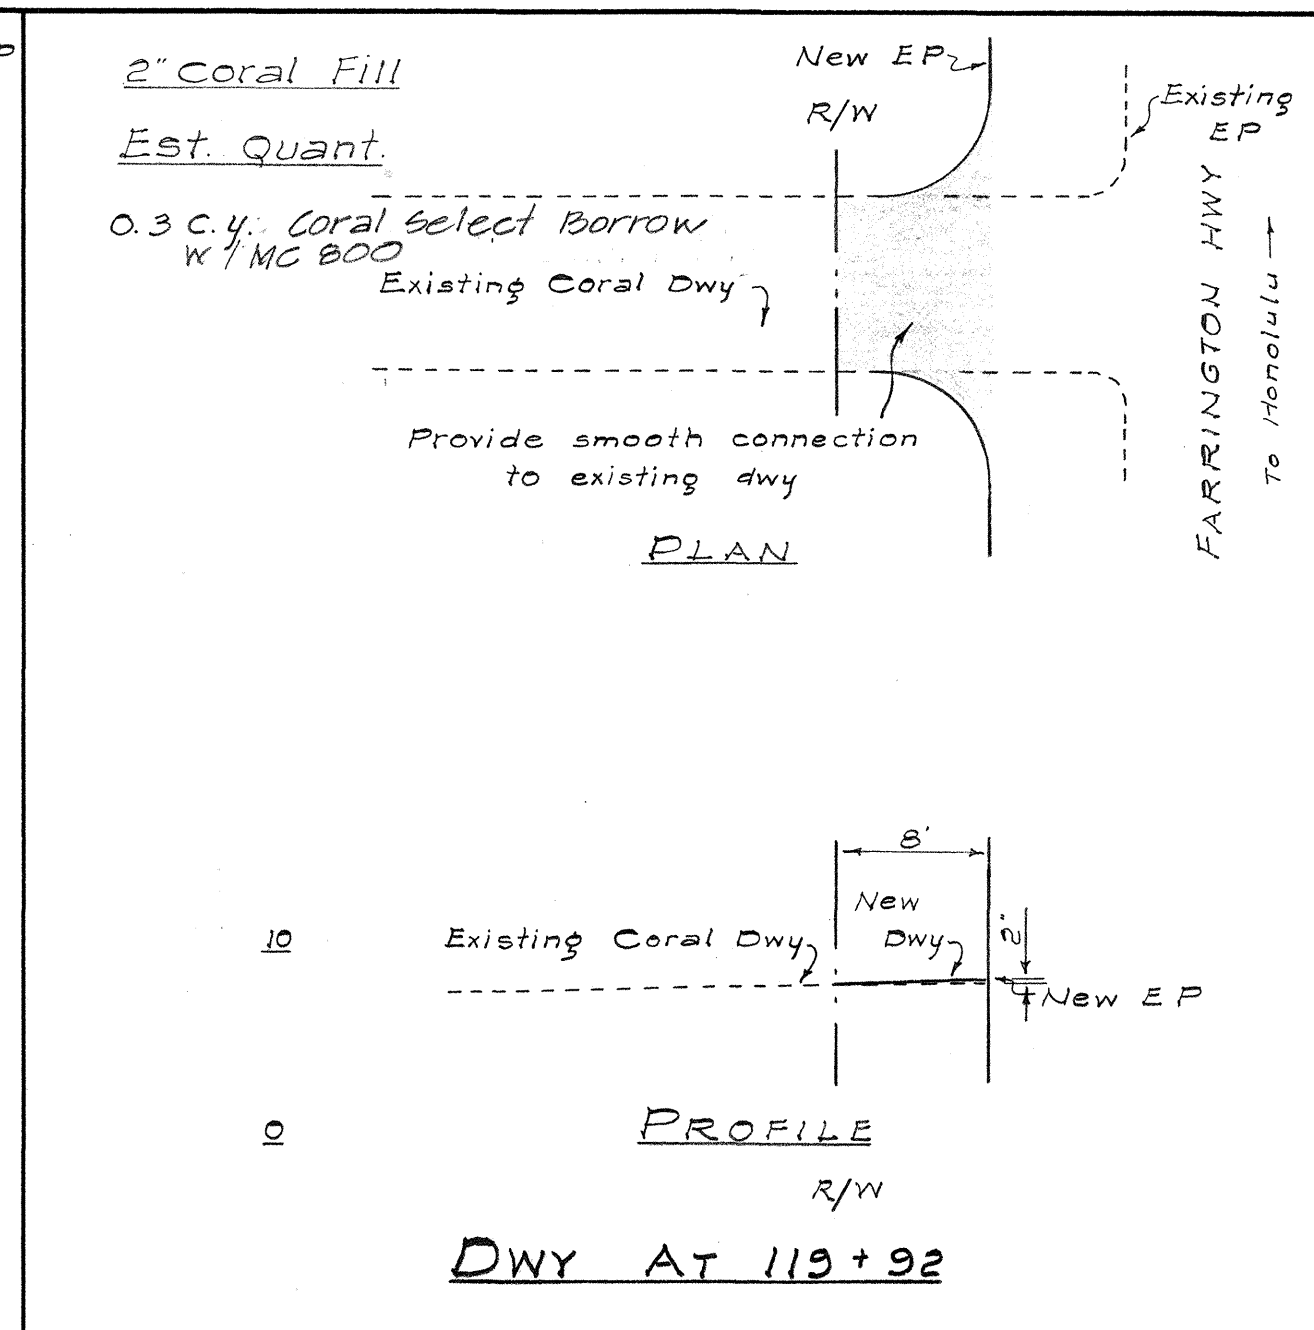

- NOTE:**
1. Driveway connections to be of same material as existing.
 2. A.C. concrete pavement, untreated base course, prime coat, tack coat, coral select borrow with MC 800 and excavation for driveways will be paid for under respective roadway items.
 3. MC 800 shall be bituminous seal coat for shoulders with crushed rock.

SAM O. HIROTA, P. E. - CIVIL ENGINEERS & SURVEYORS
547 HALEKAUWILA ST. • ROOM 204 • HONOLULU, HAWAII 96813

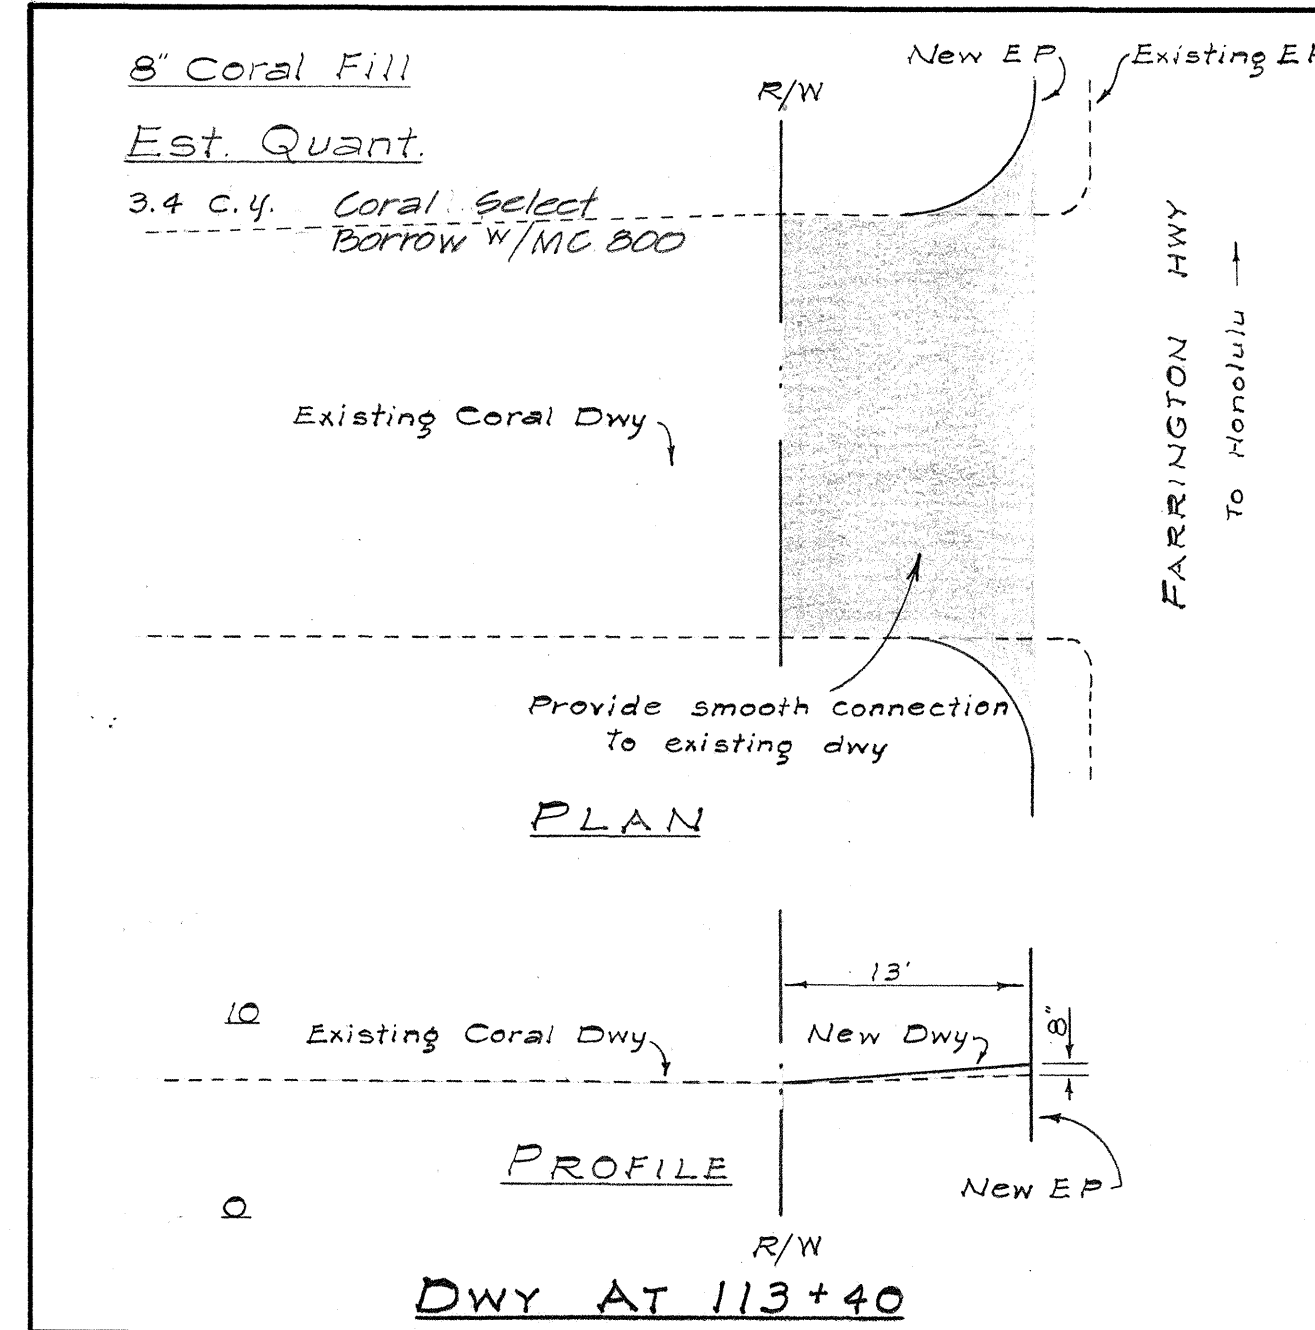

STATE OF HAWAII
DEPARTMENT OF TRANSPORTATION
HIGHWAYS DIVISION

DRIVEWAY DETAILS















FARRINGTON HIGHWAY WIDENING
PROJECT B-200-01-64
UNIT II

THIS WORK WAS PREPARED BY ME OR UNDER MY SUPERVISION.
Sam O. Hirota, P.E.

SCALE: Hor: 1" = 10'
Vert: 1" = 10'

STATE	FISCAL YEAR	SHEET NO.	TOTAL SHTS.
HAWAII	1968	18	95

PROJECT NO. B-900-01-64 UNIT II

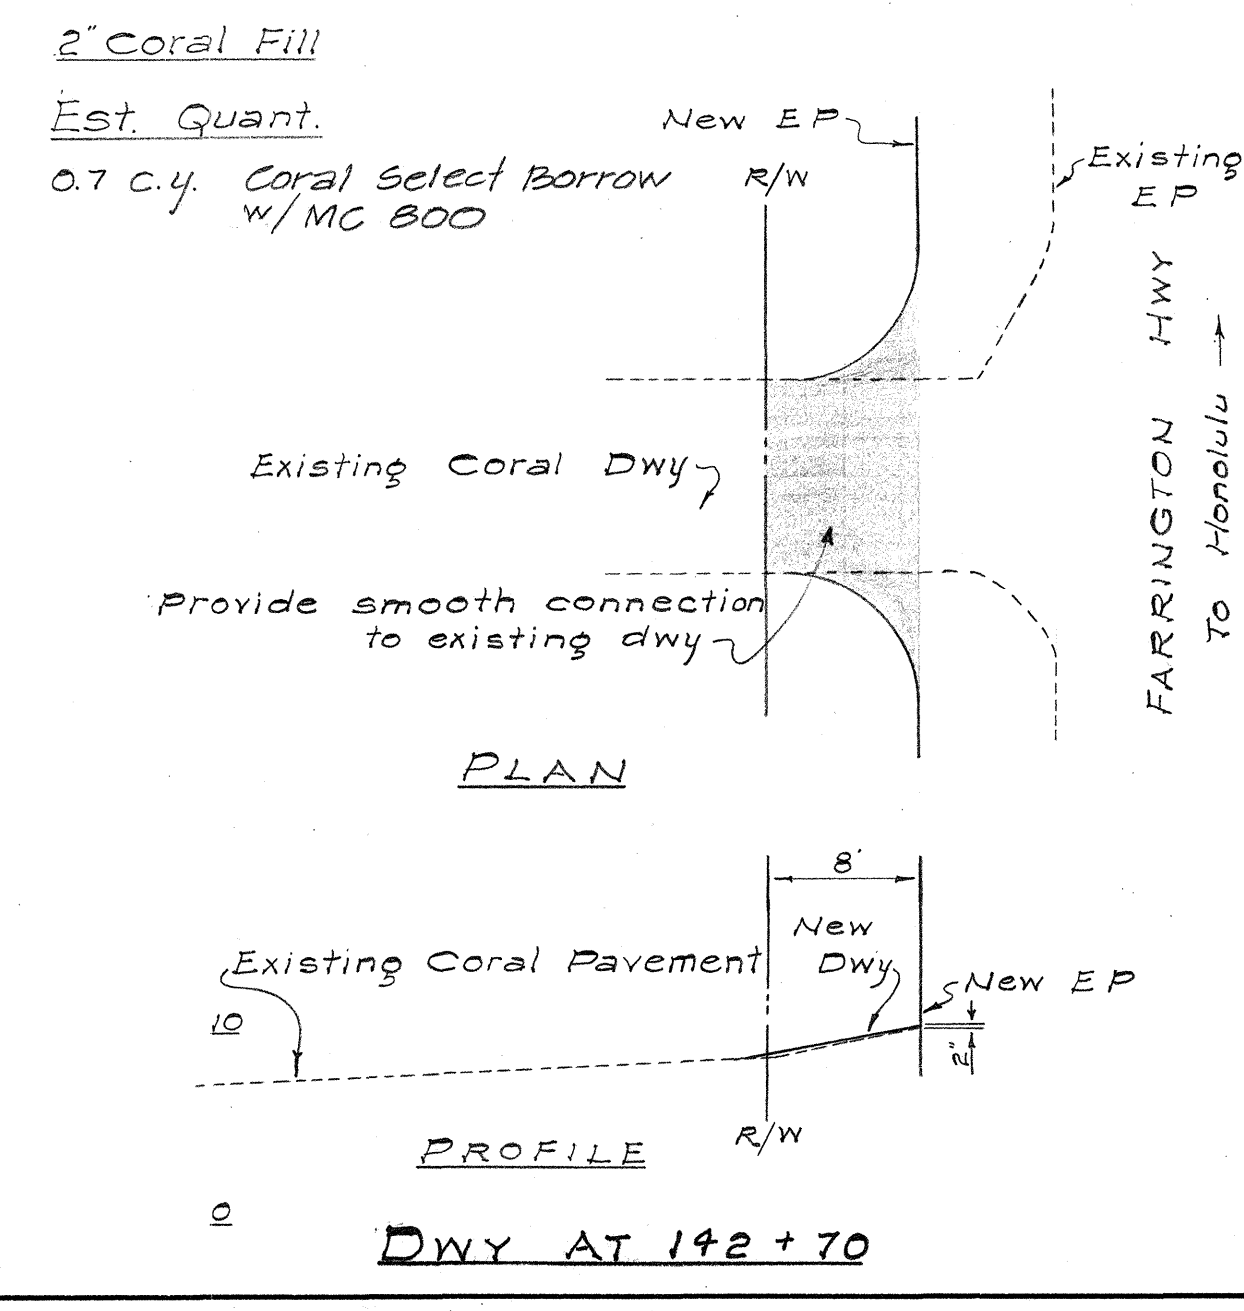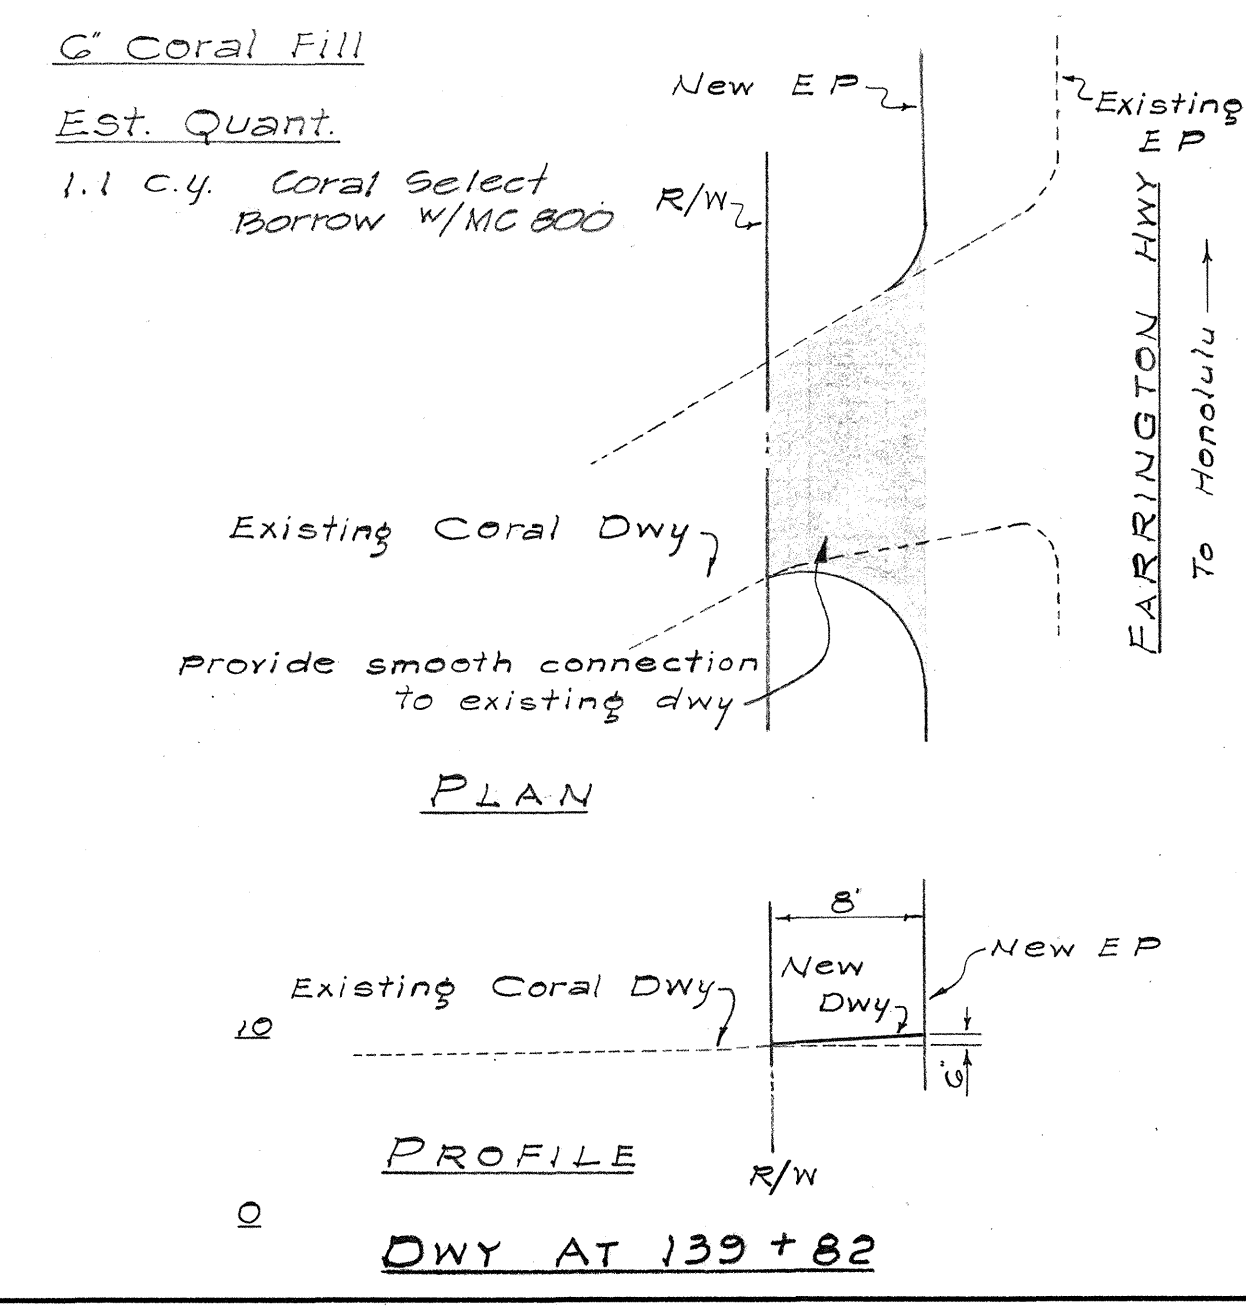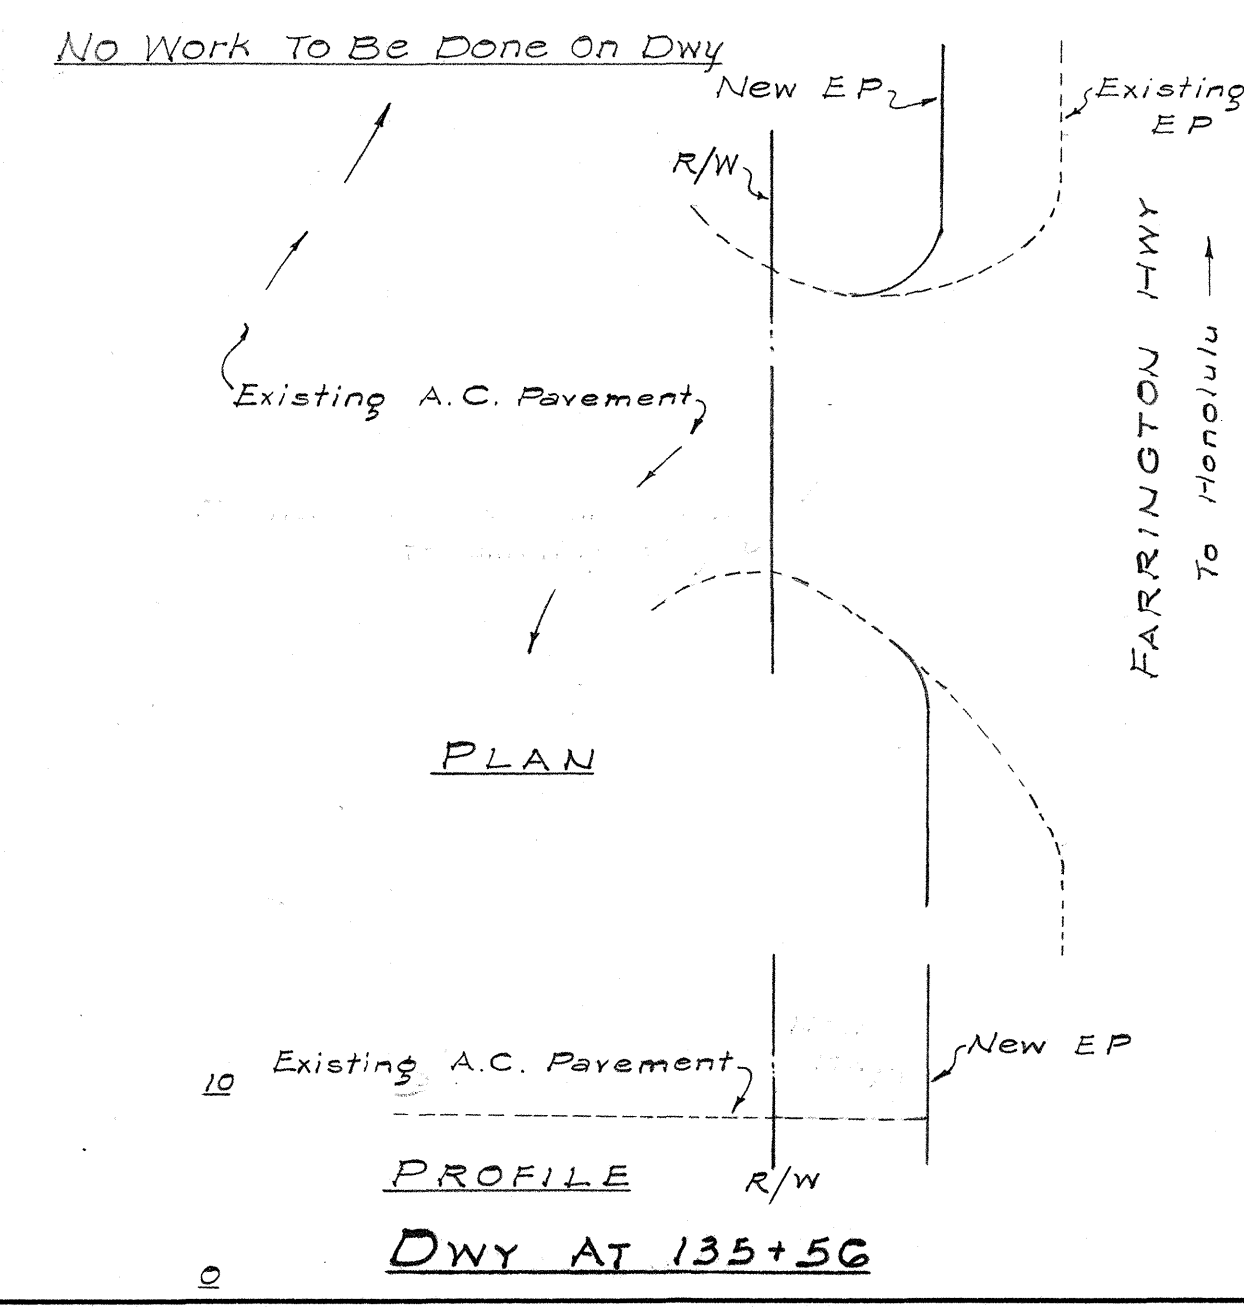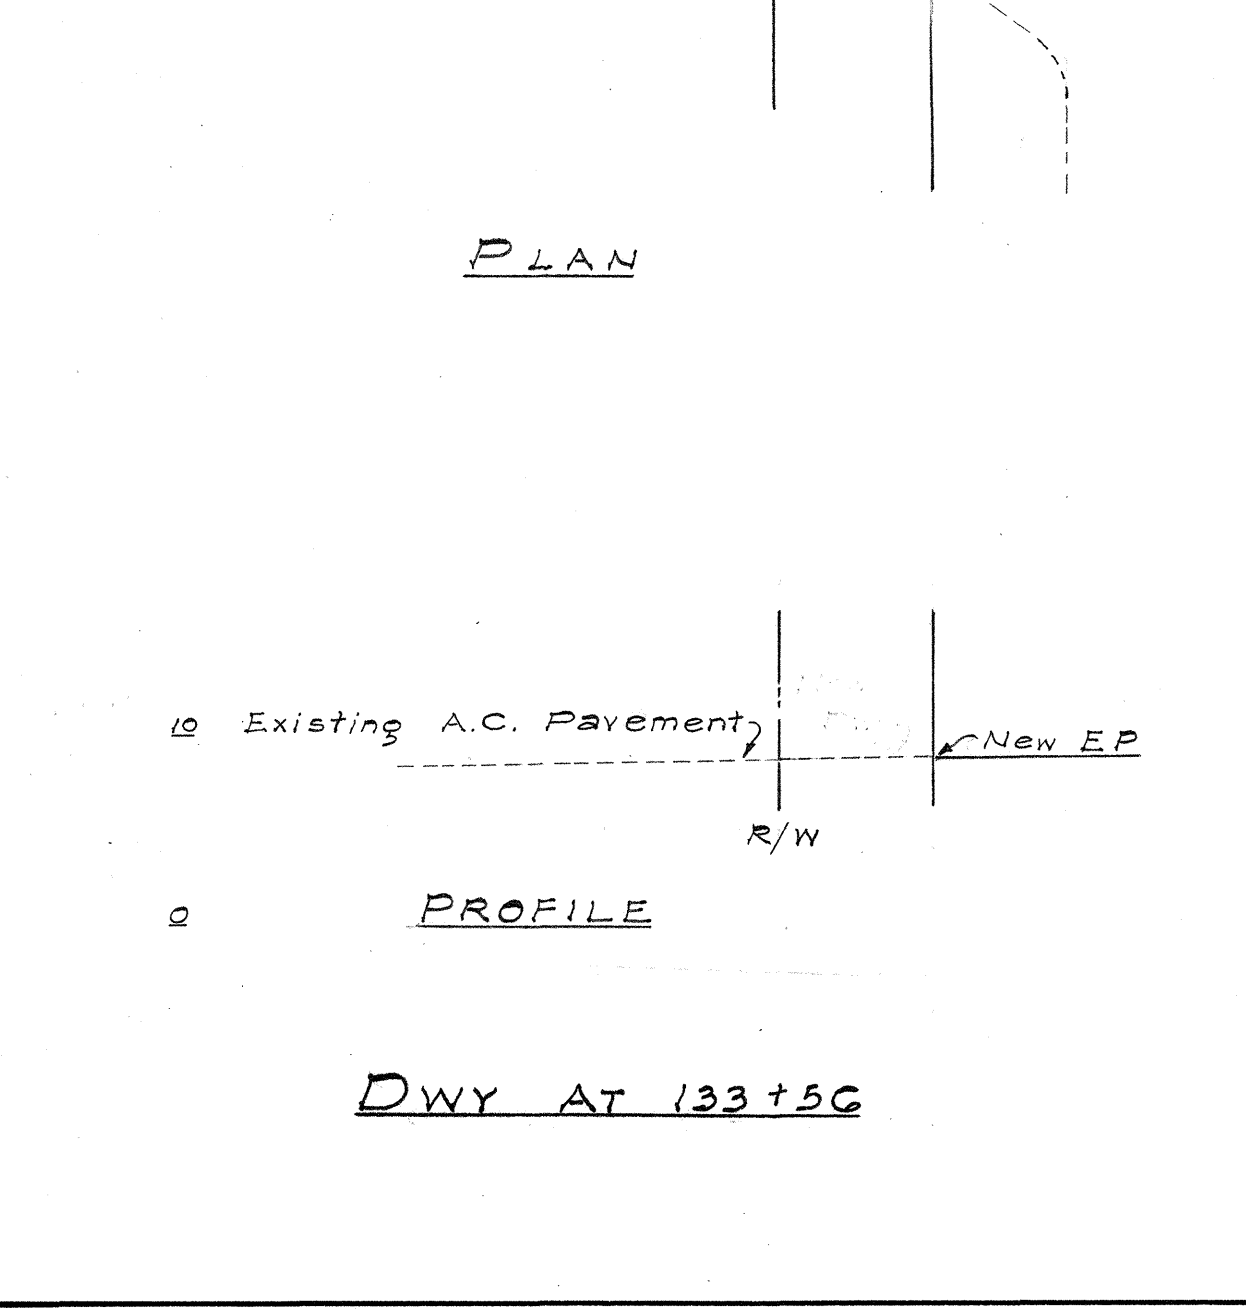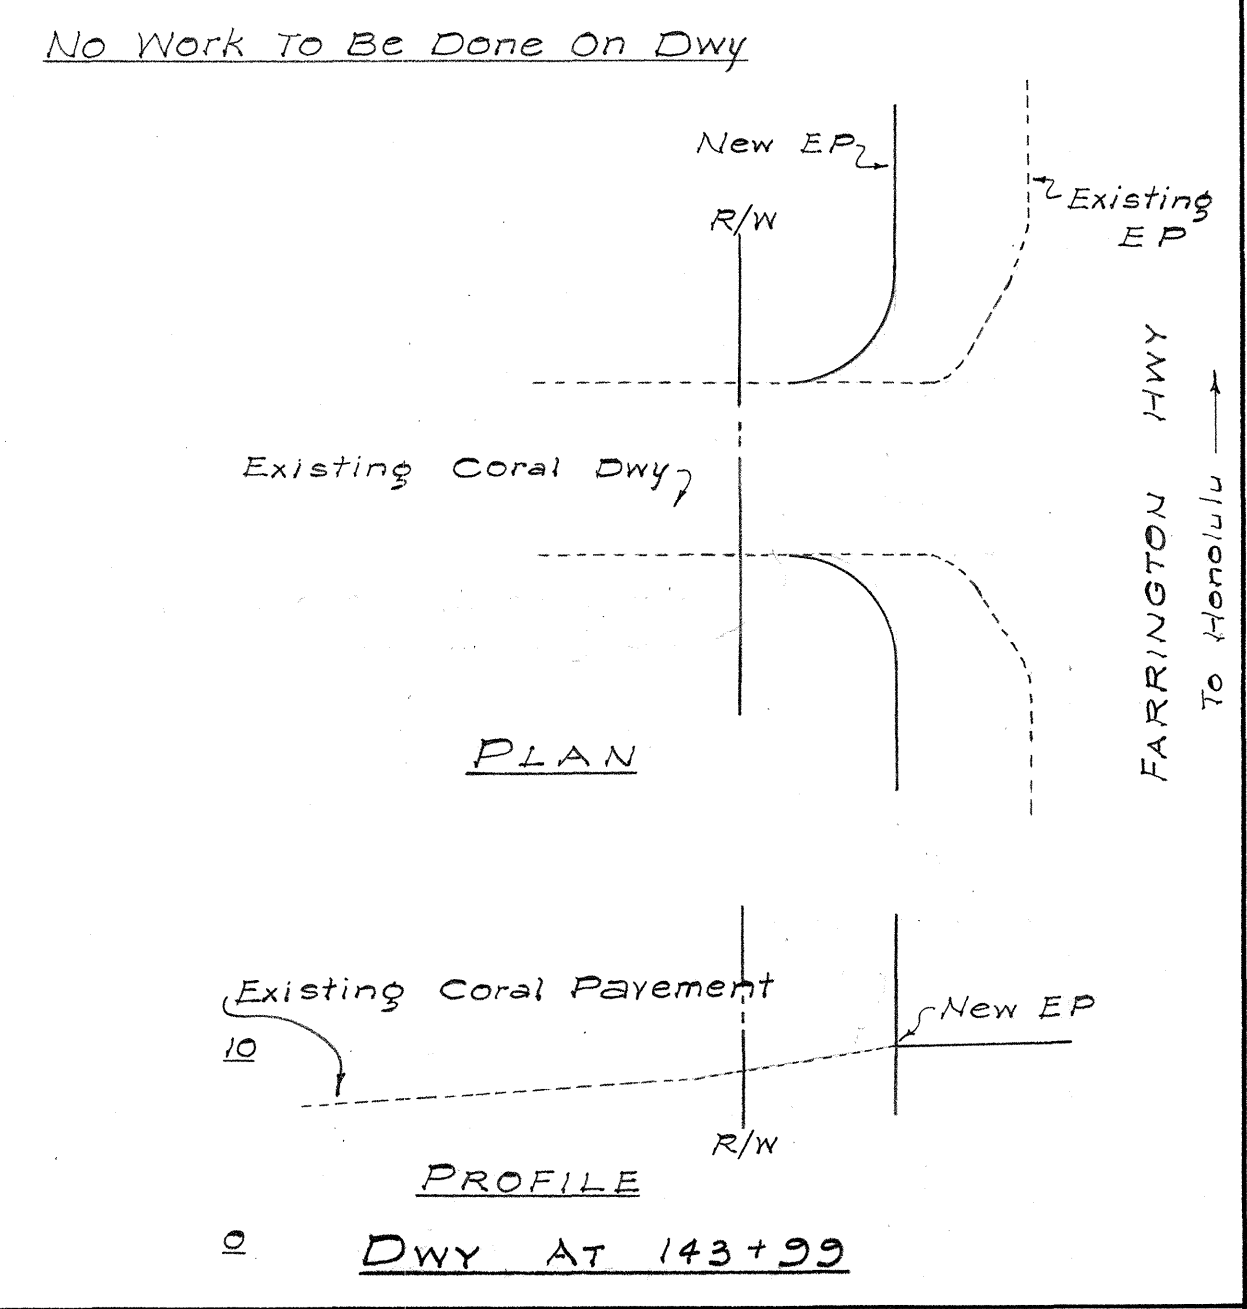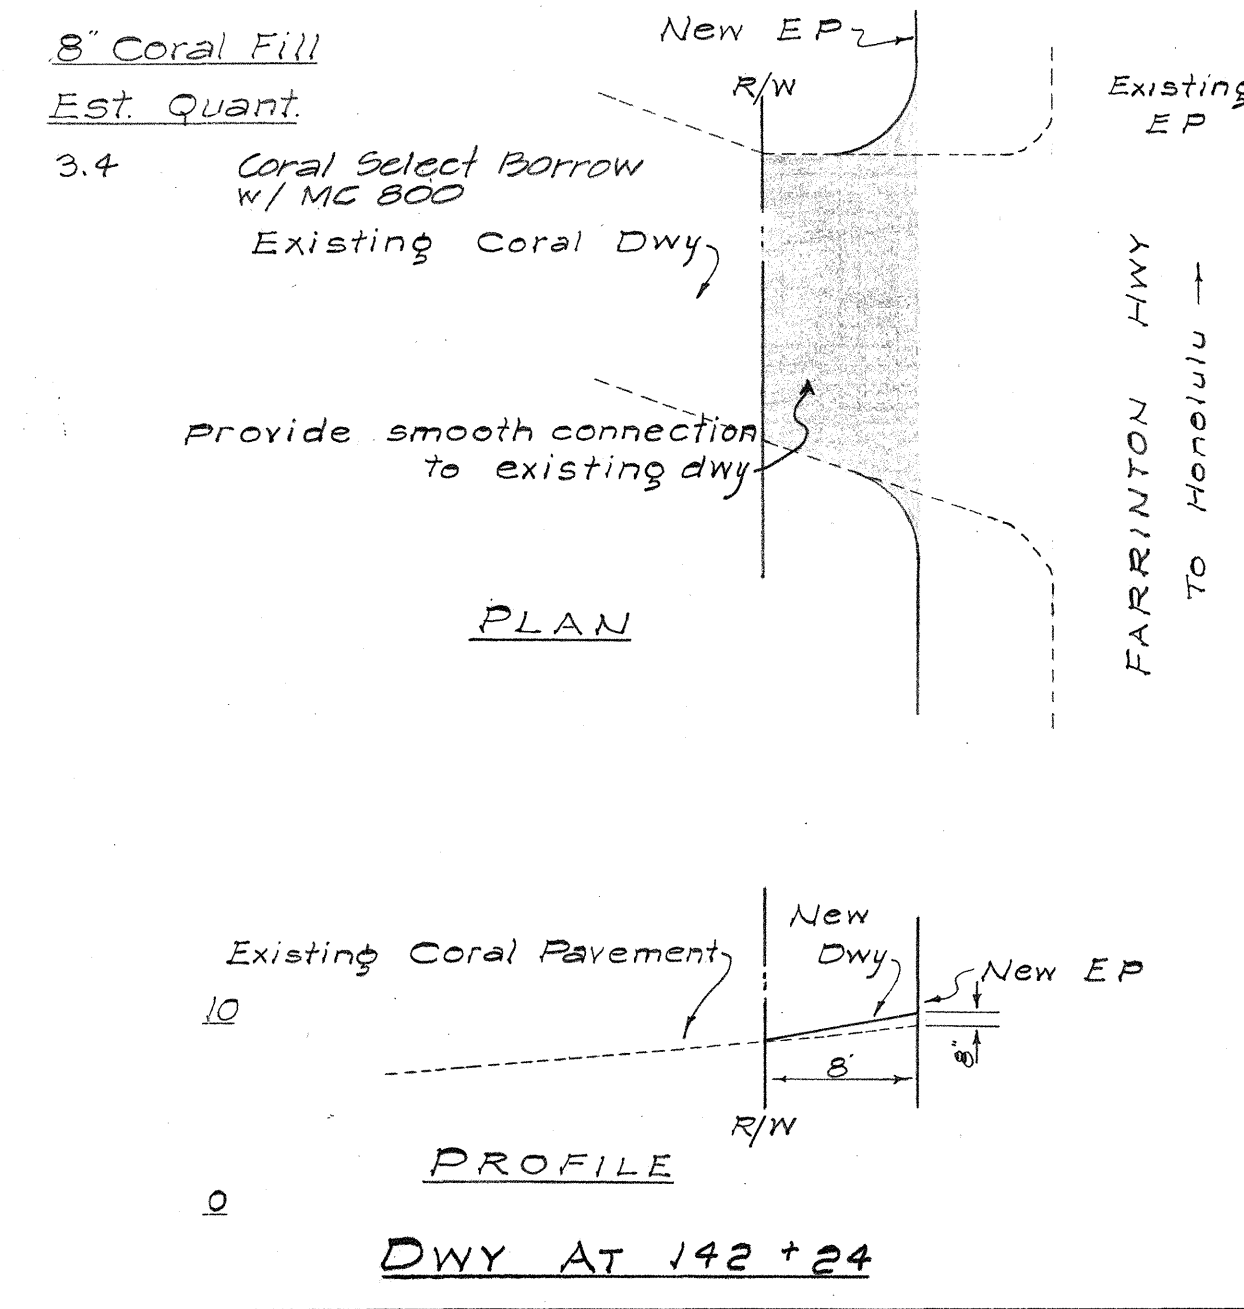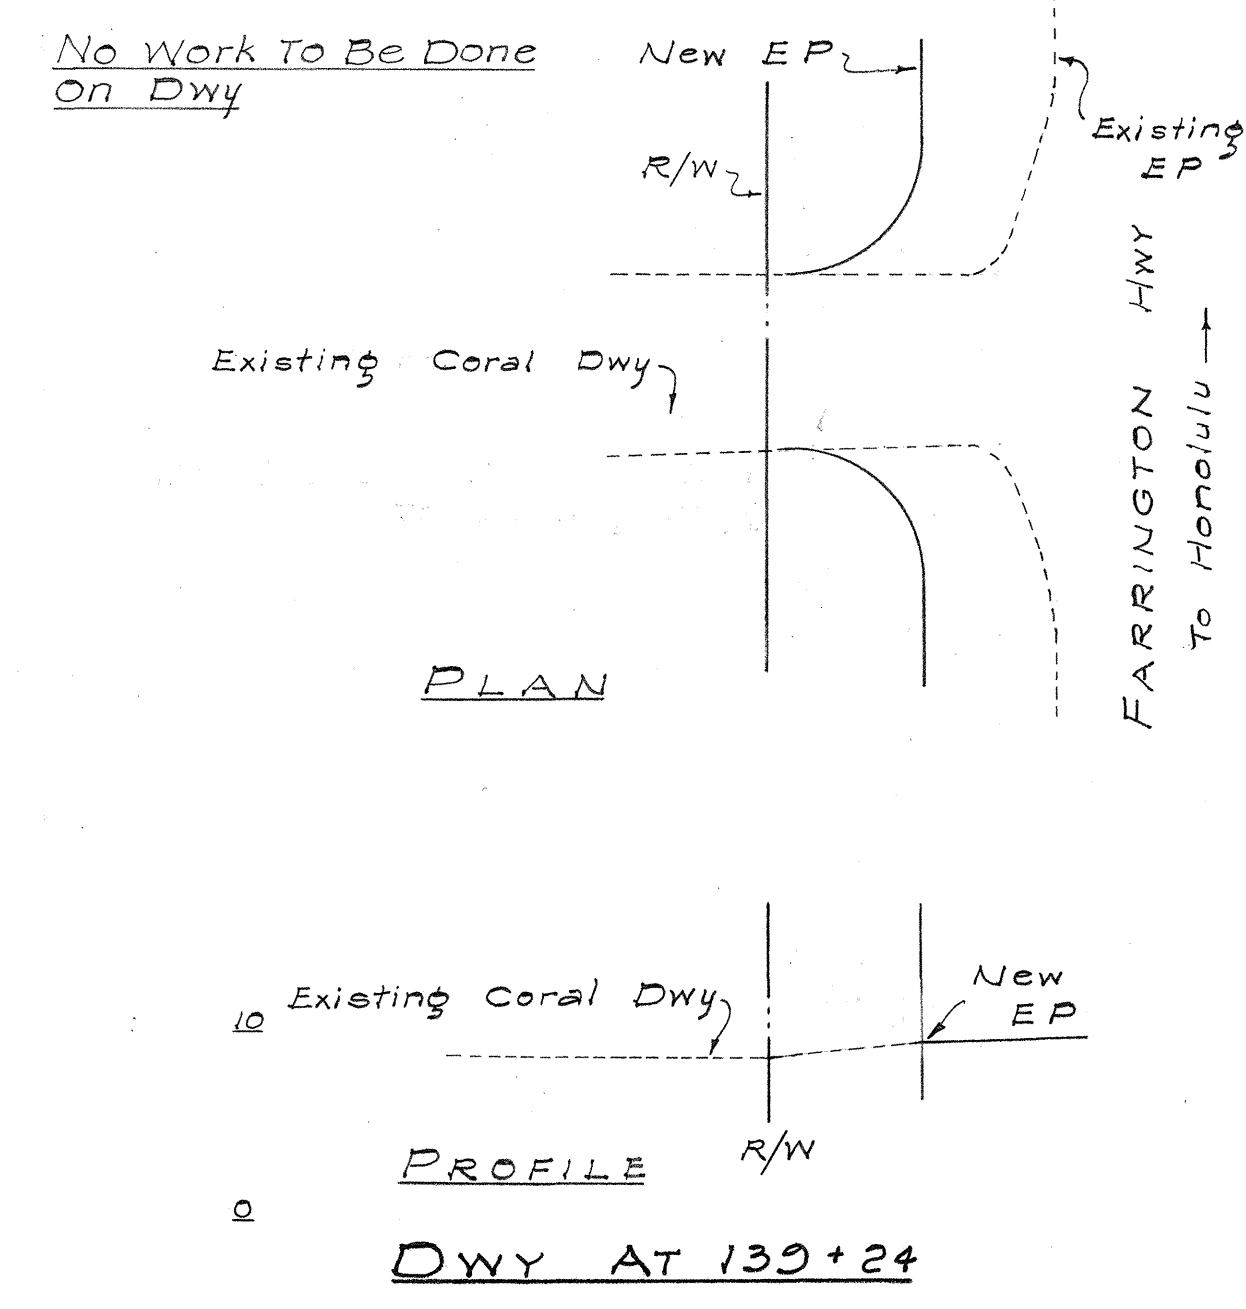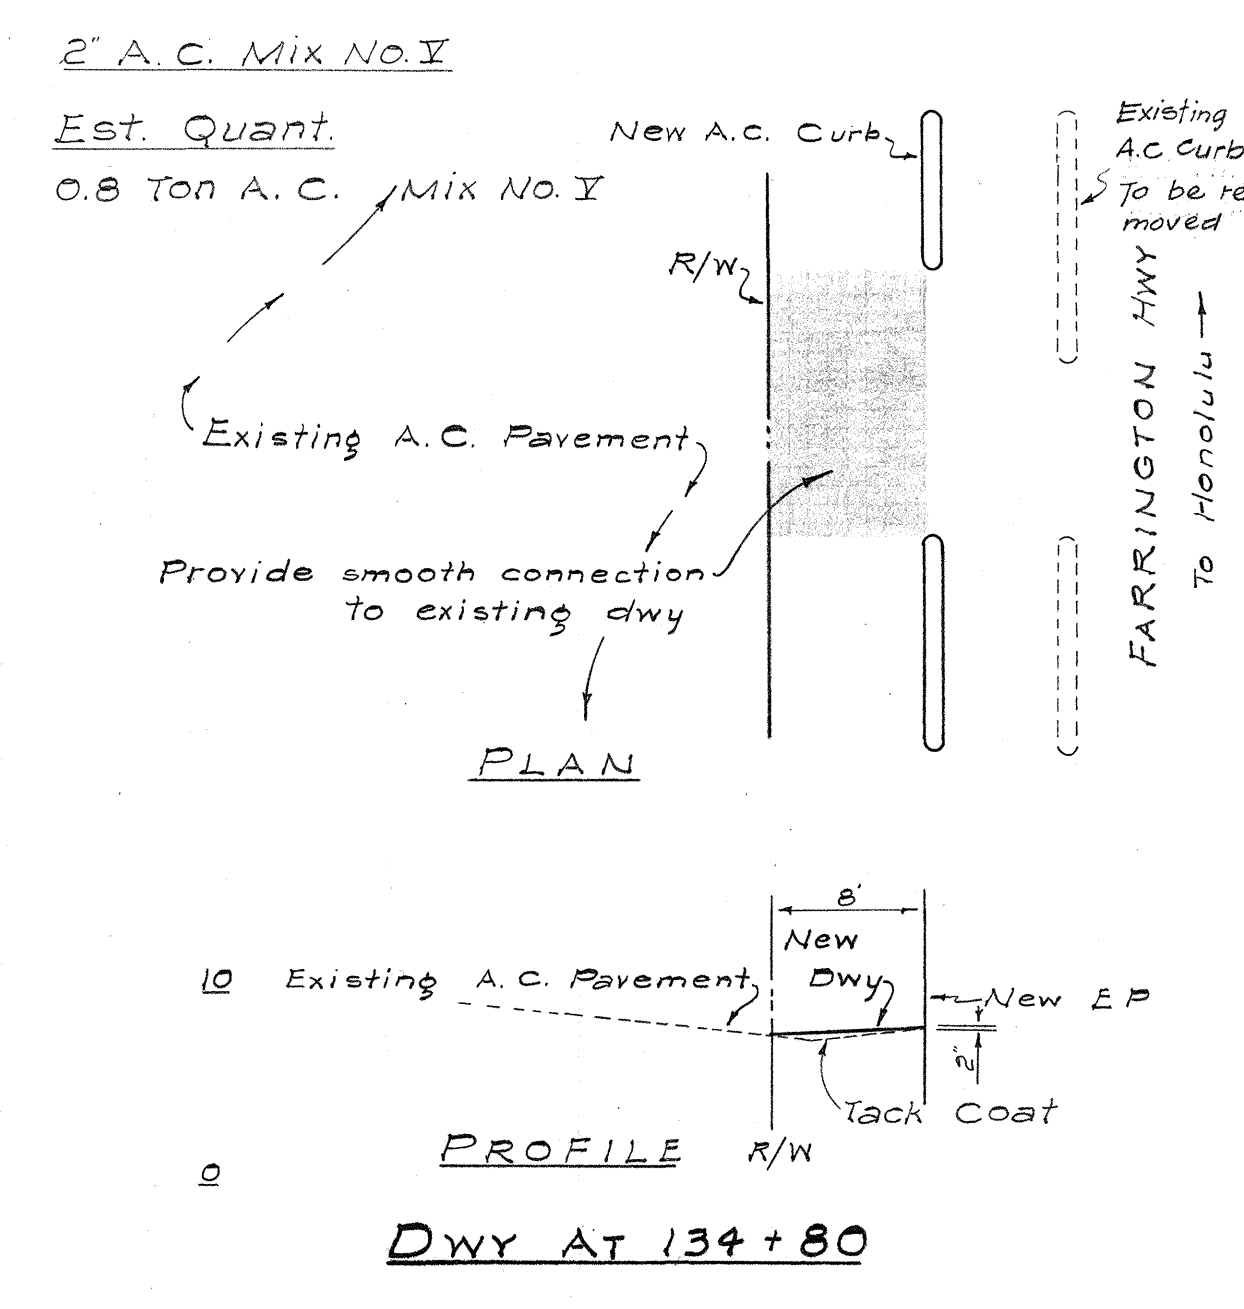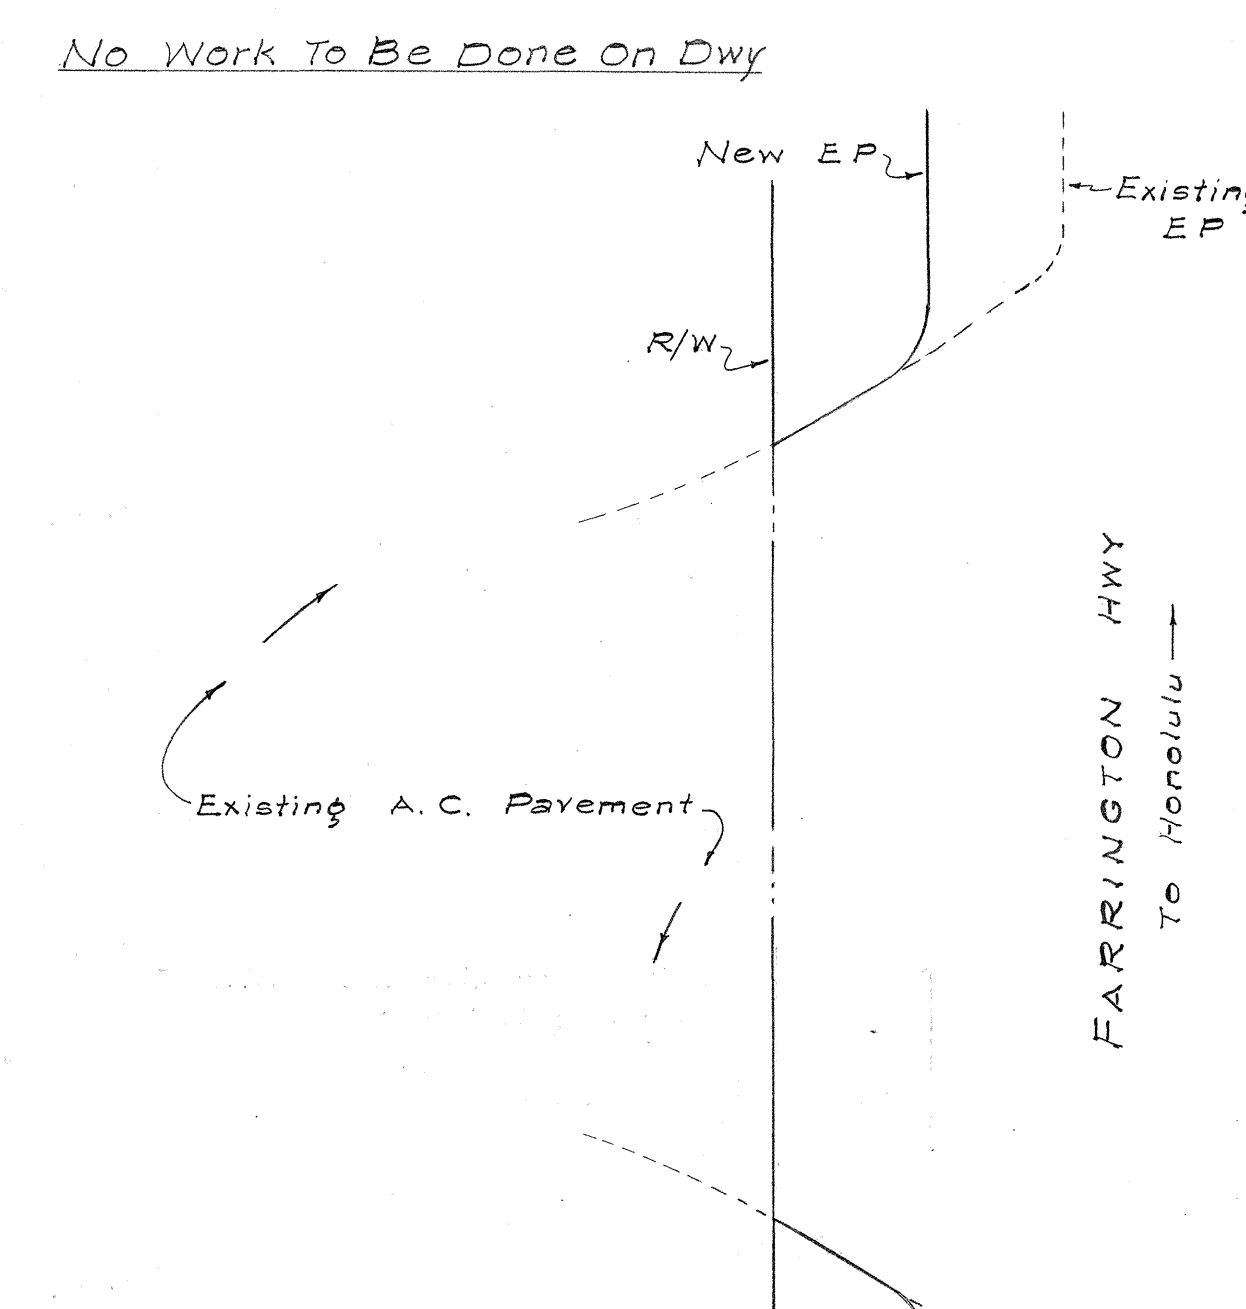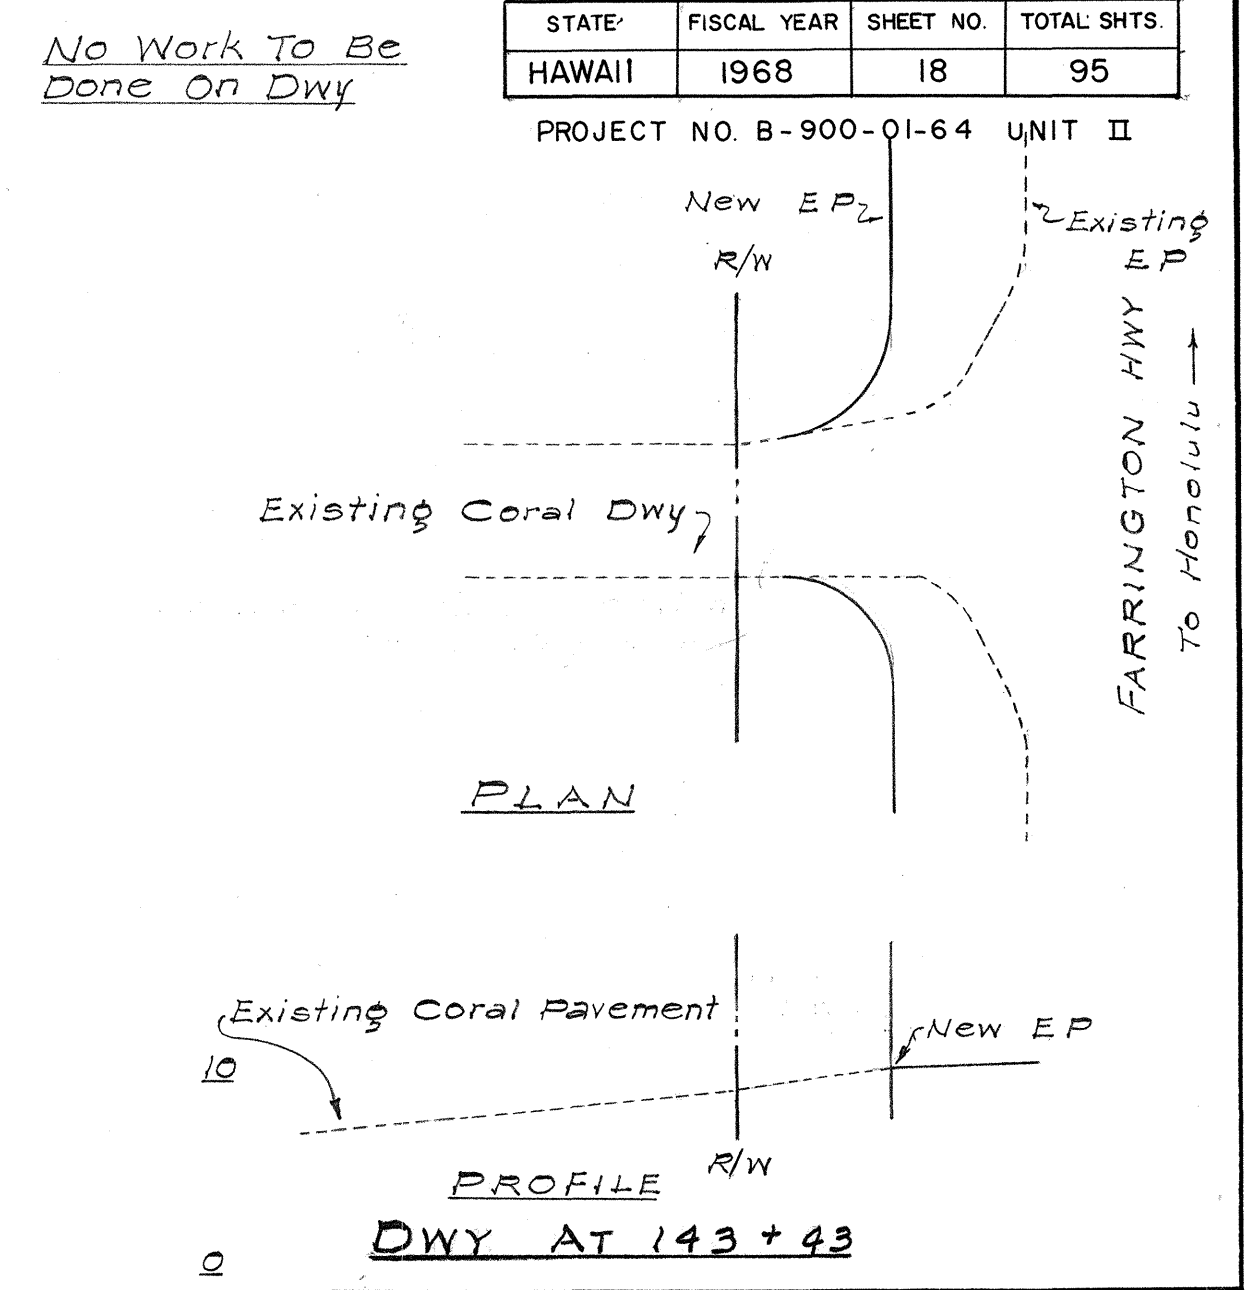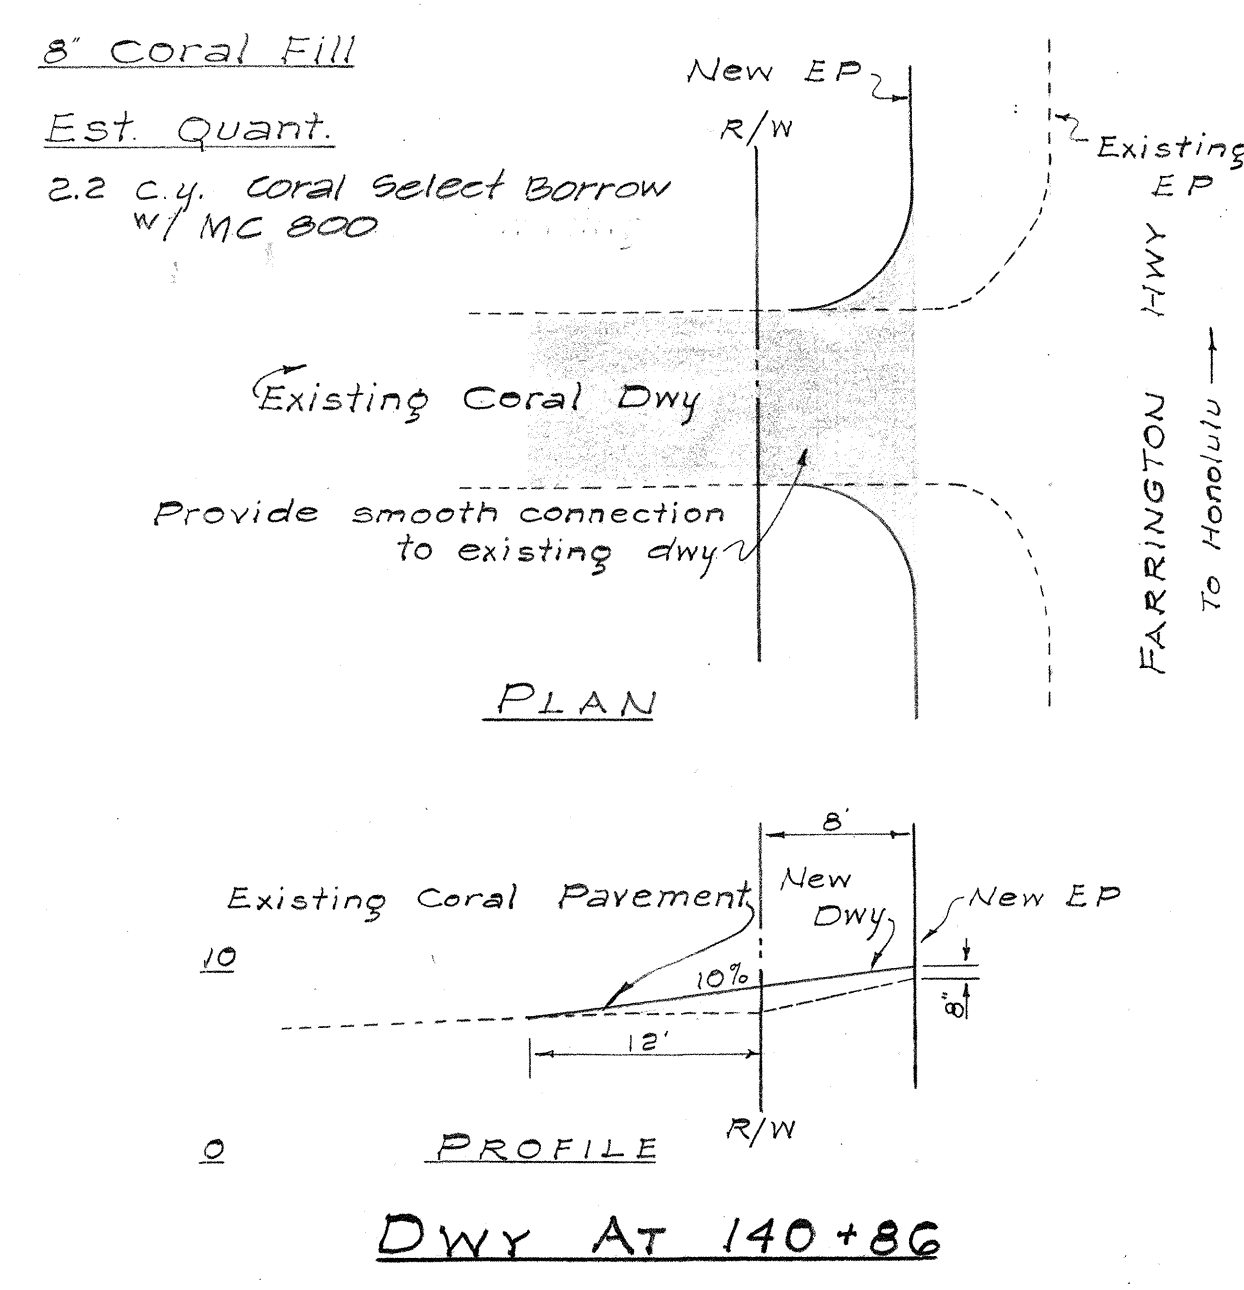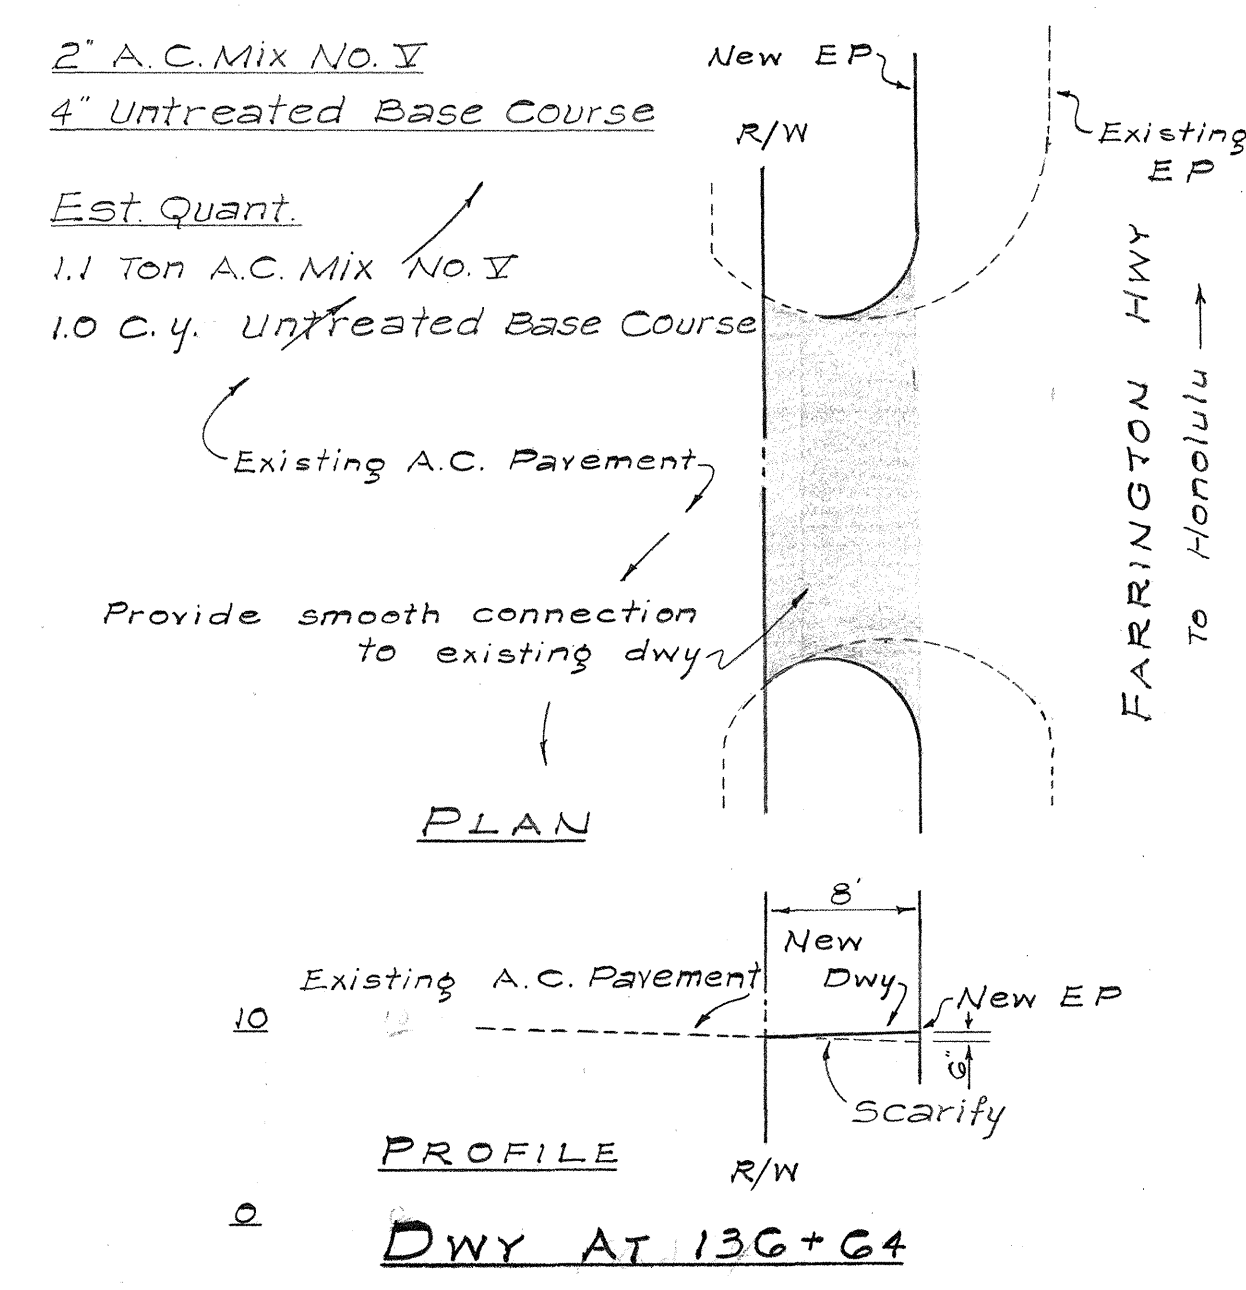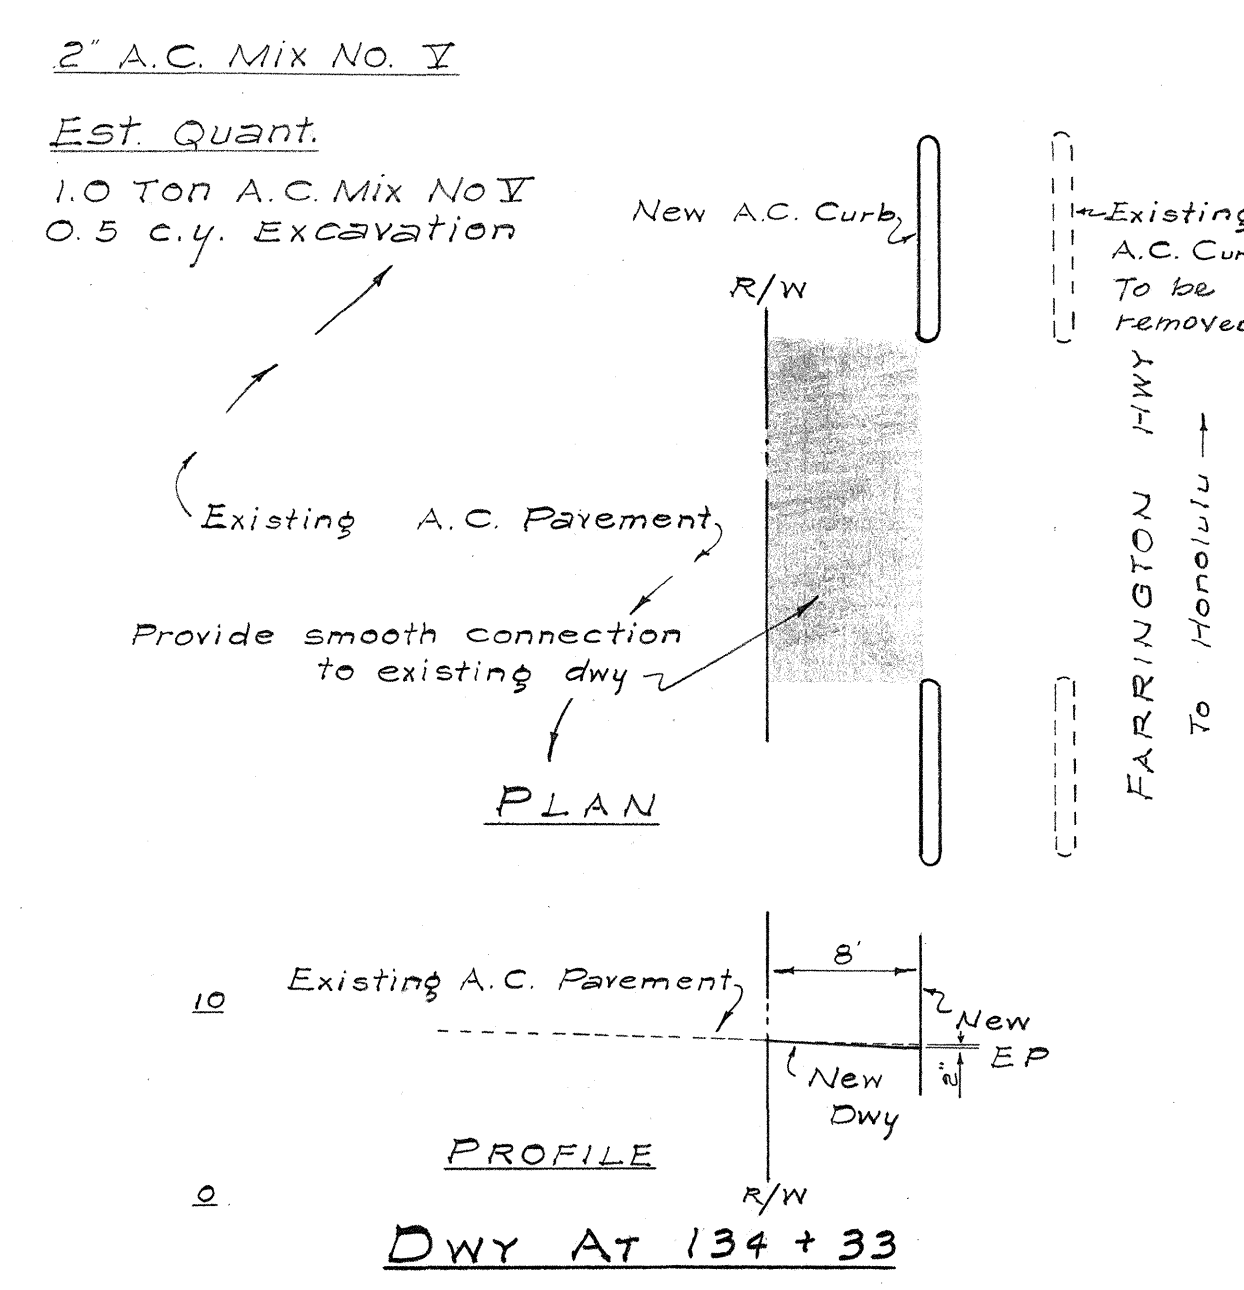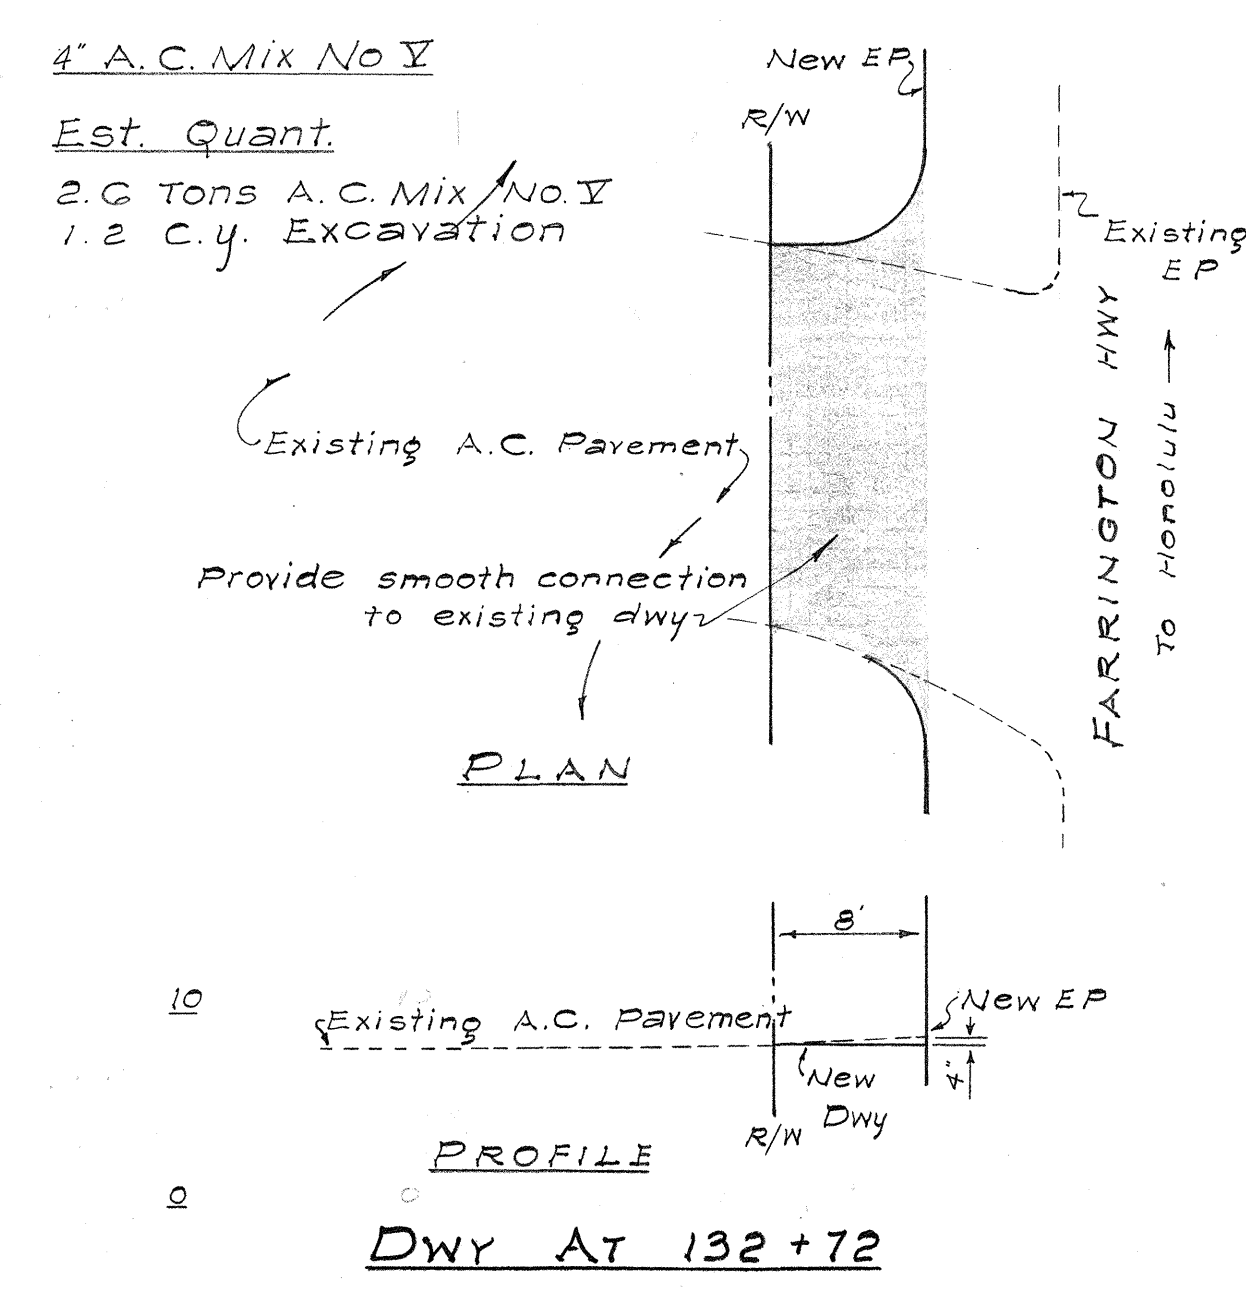

- NOTE:**
1. Driveway connections to be of same material as existing.
 2. A.C. pavements, untreated base course, prime coat, tack coat, coral select borrow w/ M.C. 800 and excavation for driveways will be paid for under respective roadway items.
 3. MC 800 shall be bituminous seal coat for shoulders with crushed rock.

STATE OF HAWAII
 DEPARTMENT OF TRANSPORTATION
 HIGHWAYS DIVISION















DRIVEWAY DETAILS

FARRINGTON HIGHWAY WIDENING
 PROJECT B-900-01-64

UNIT II

SCALE: Hor: 1"=10'
 Vert: 1"=10'

SHEET No. 2 OF 5 SHEETS

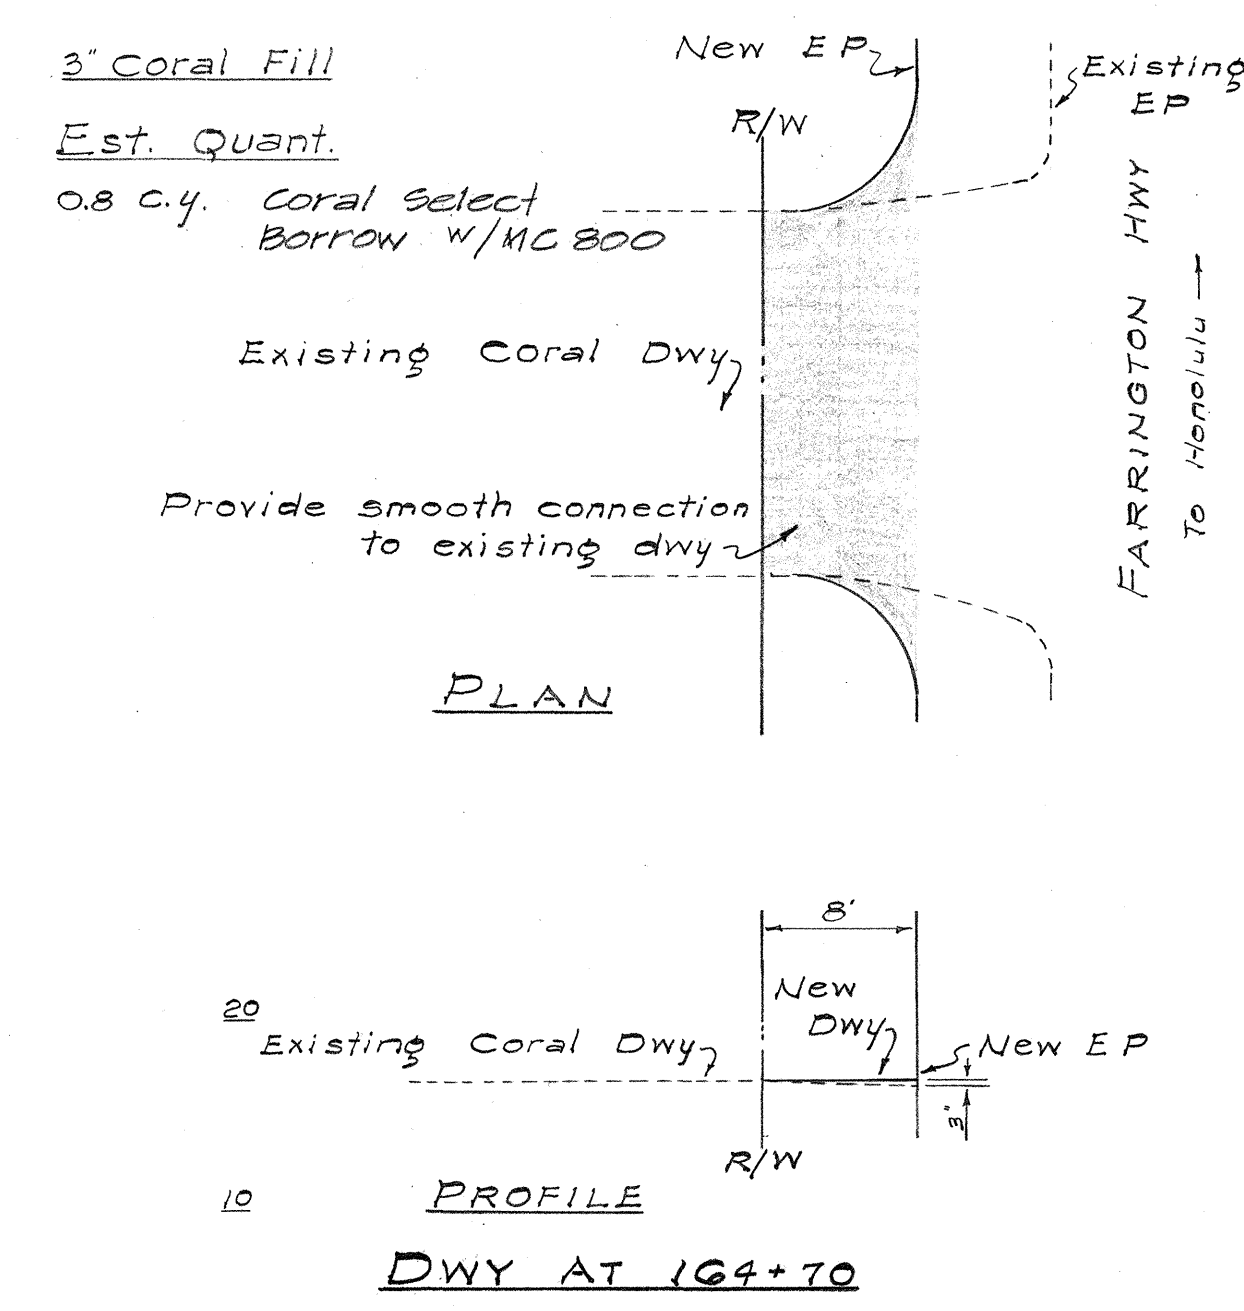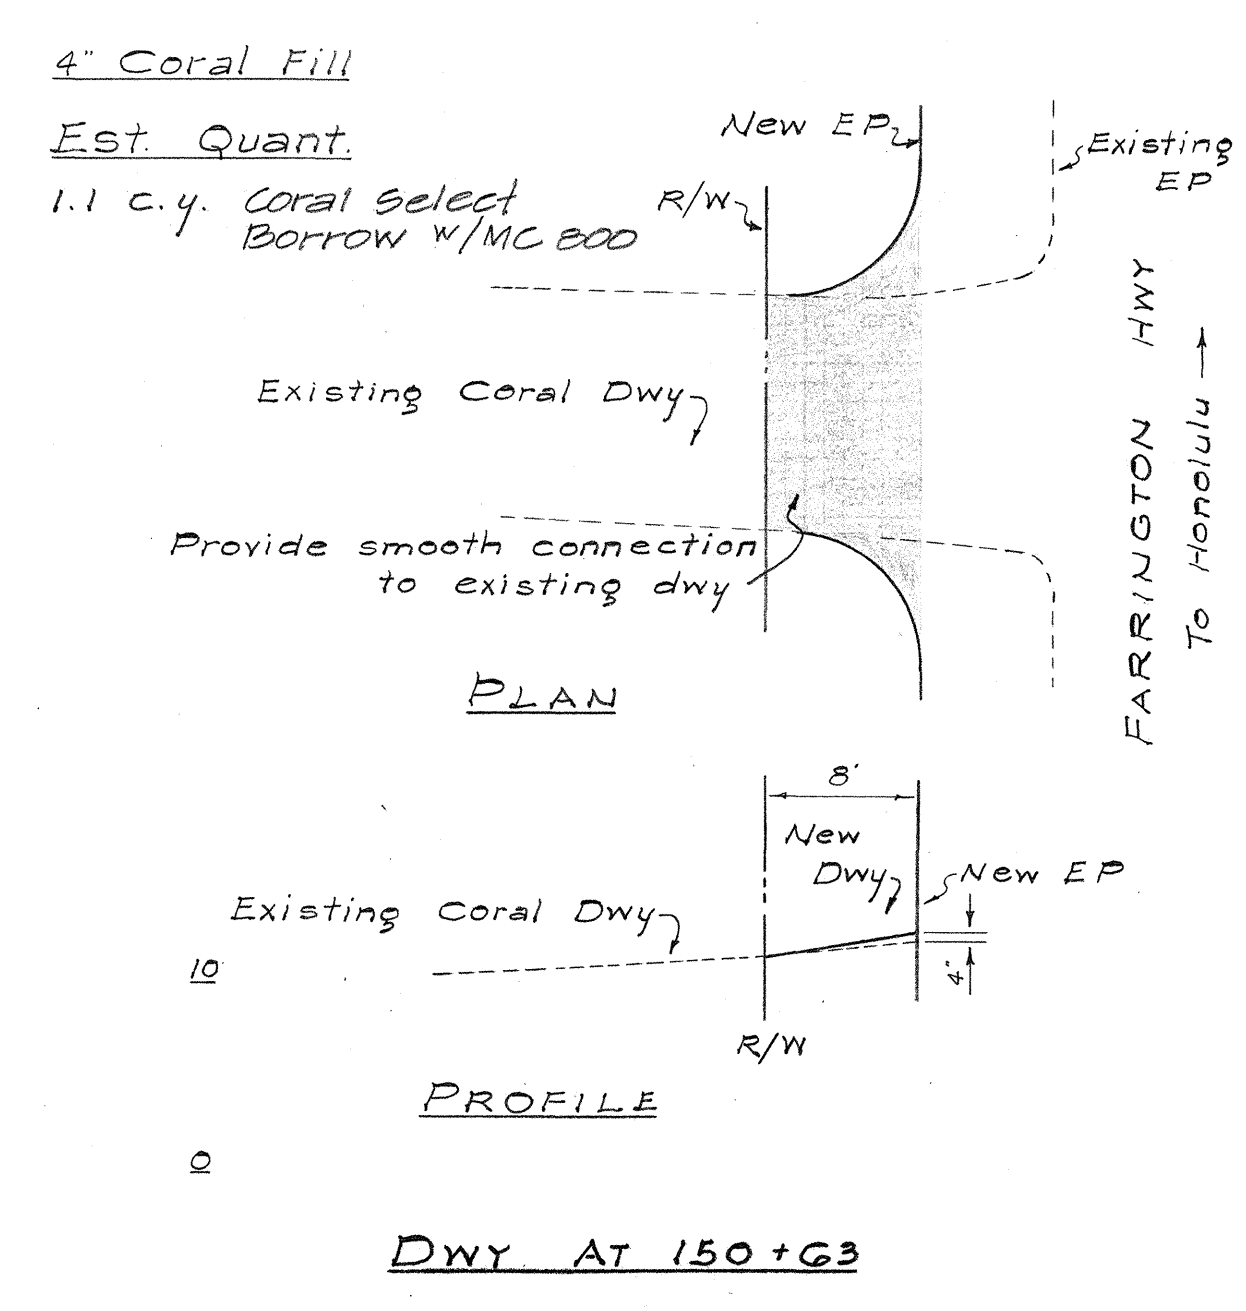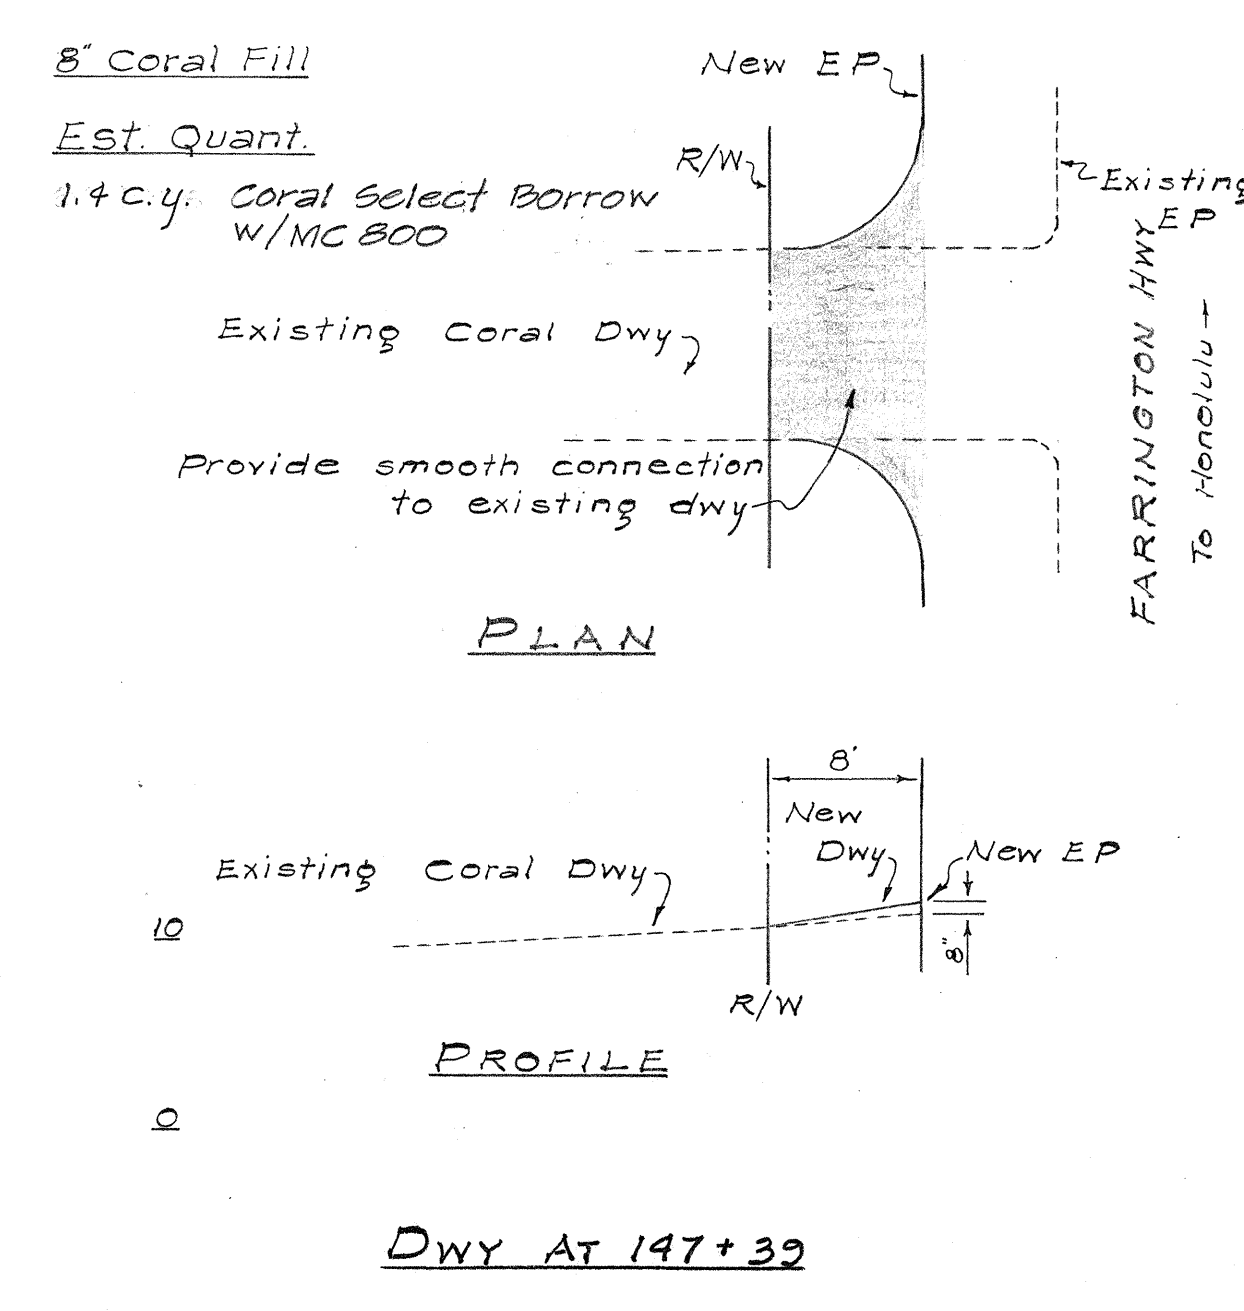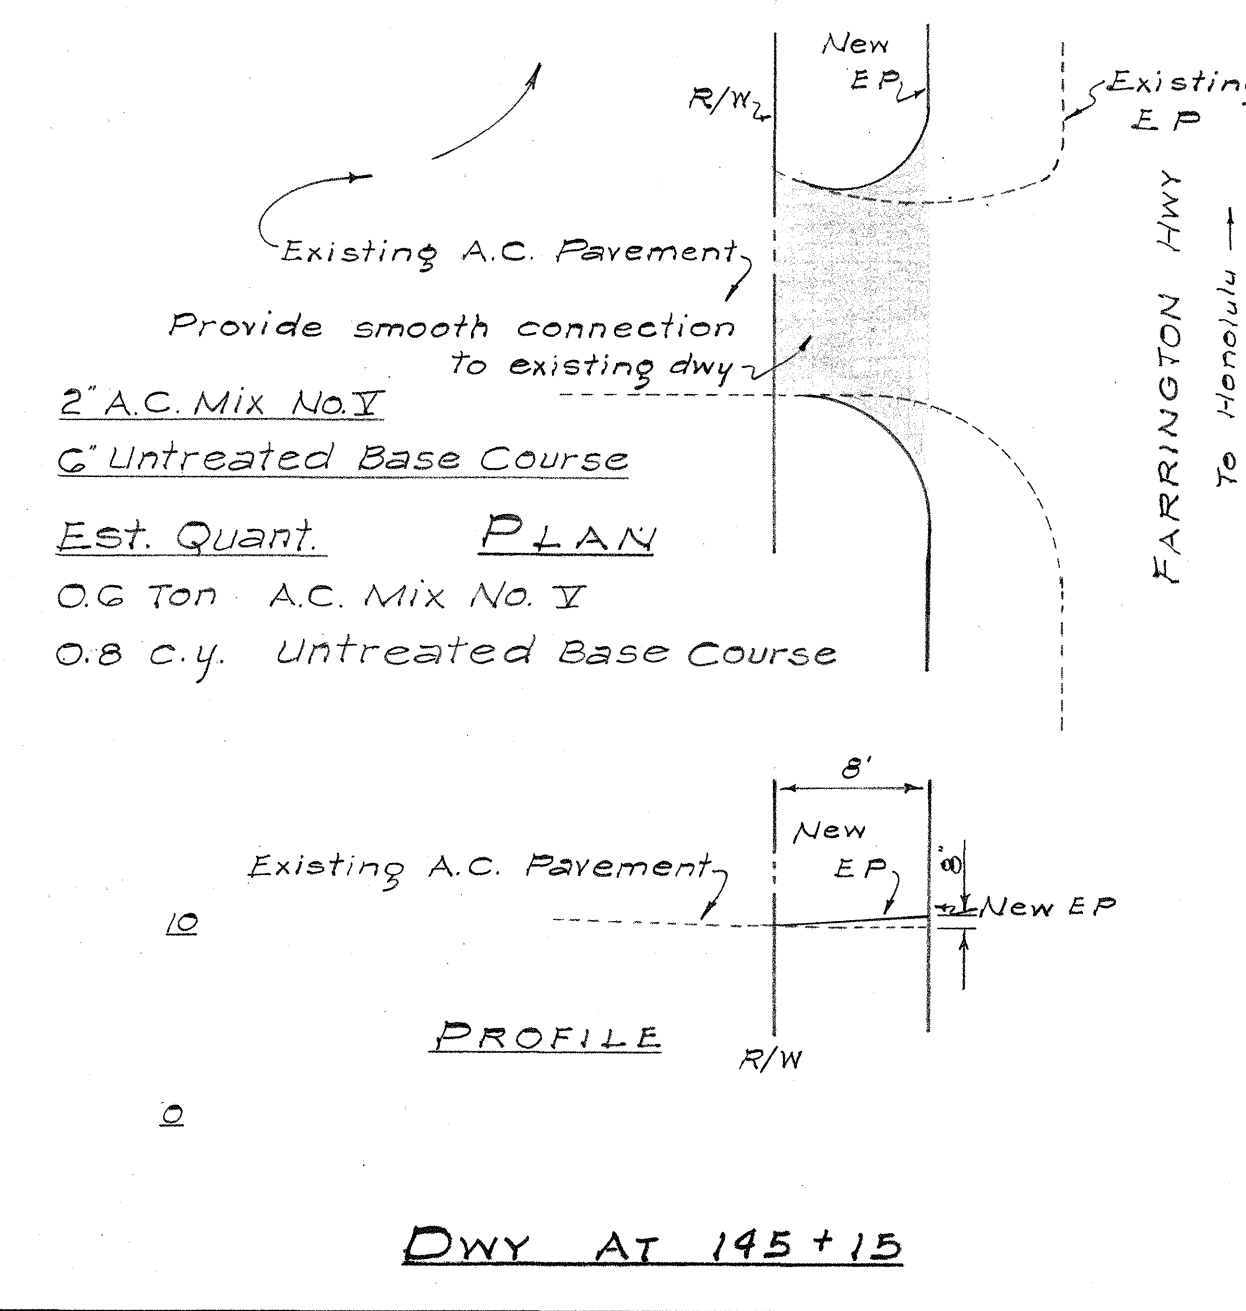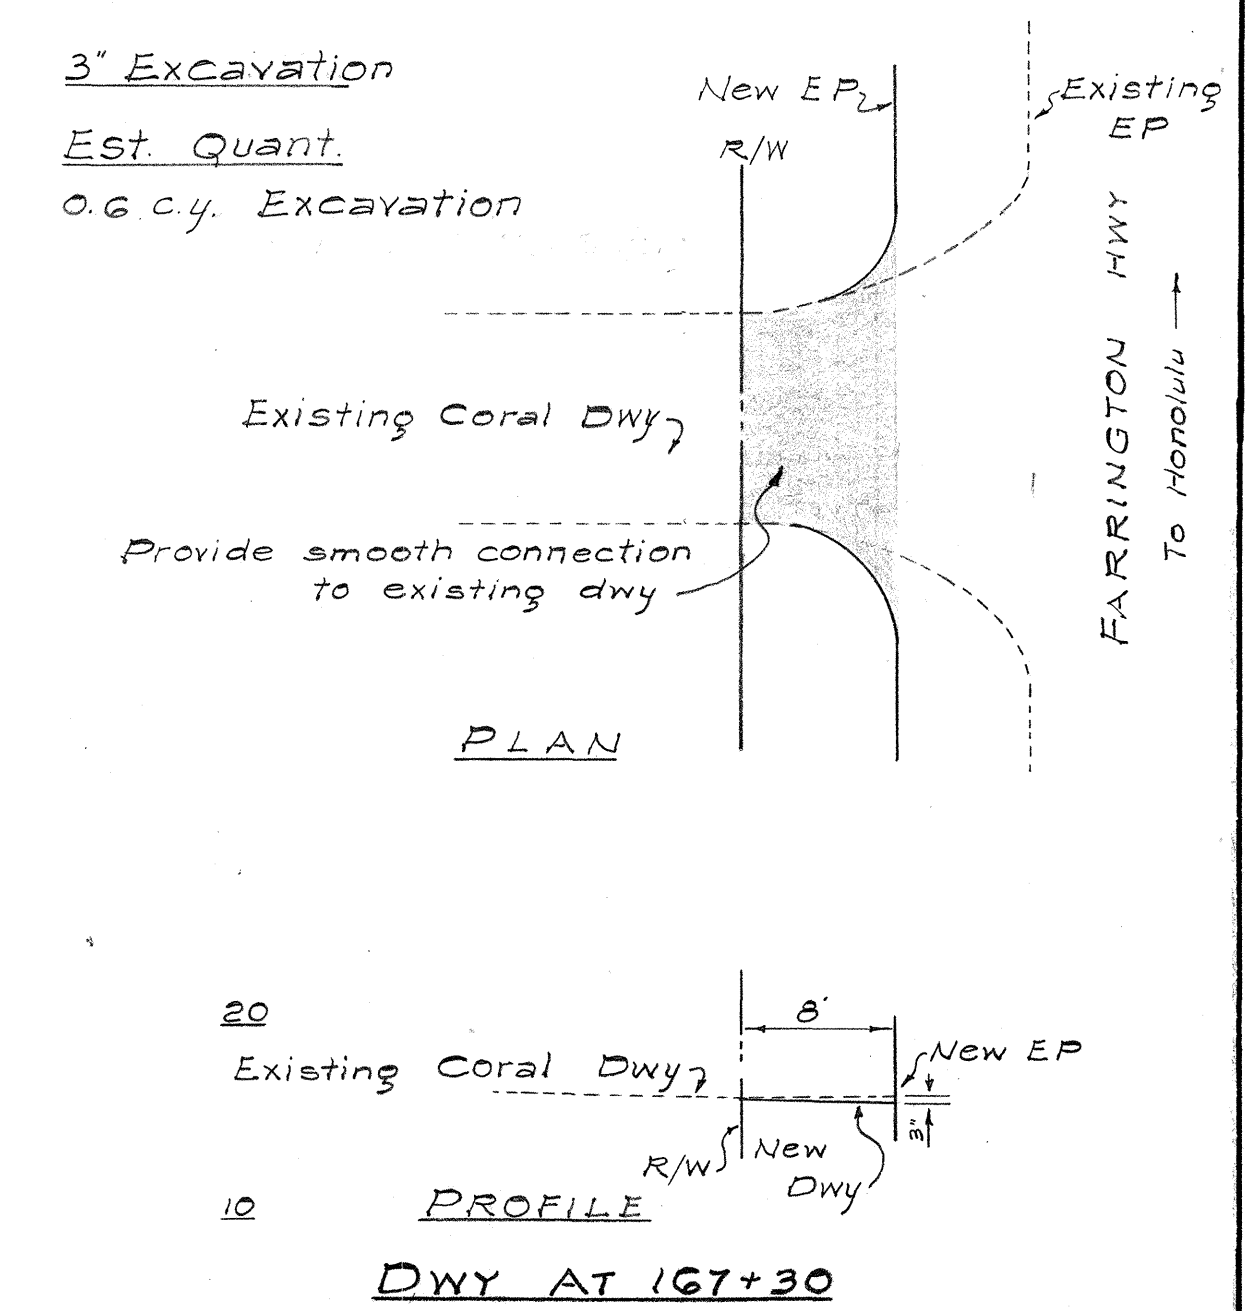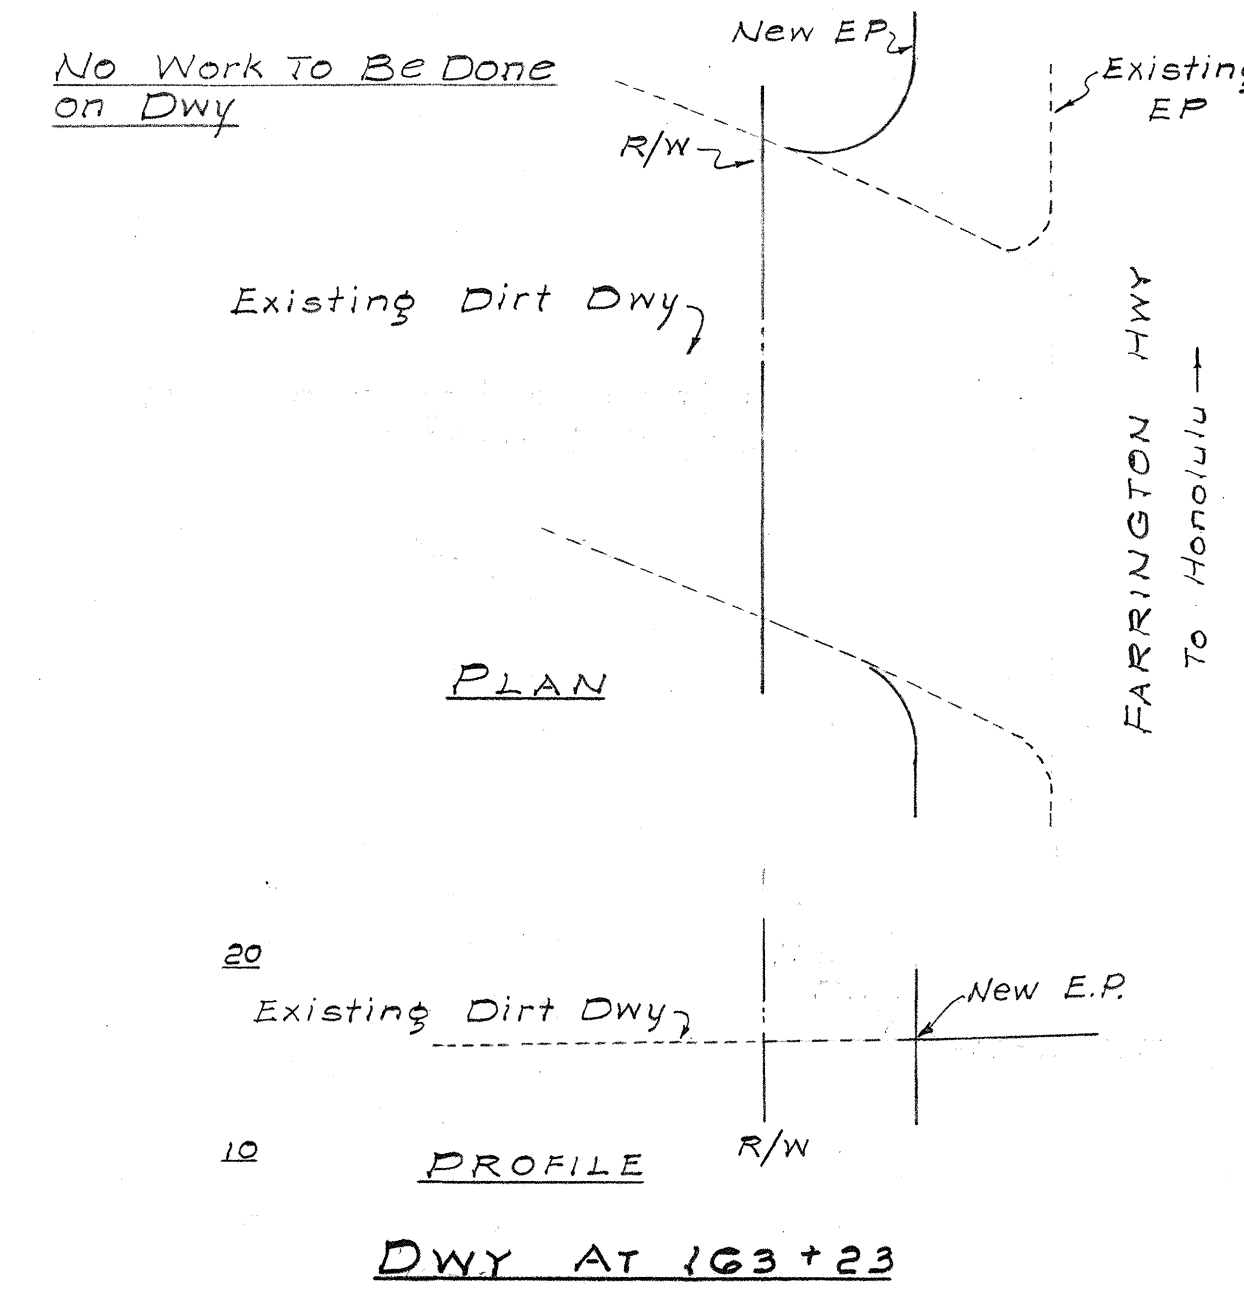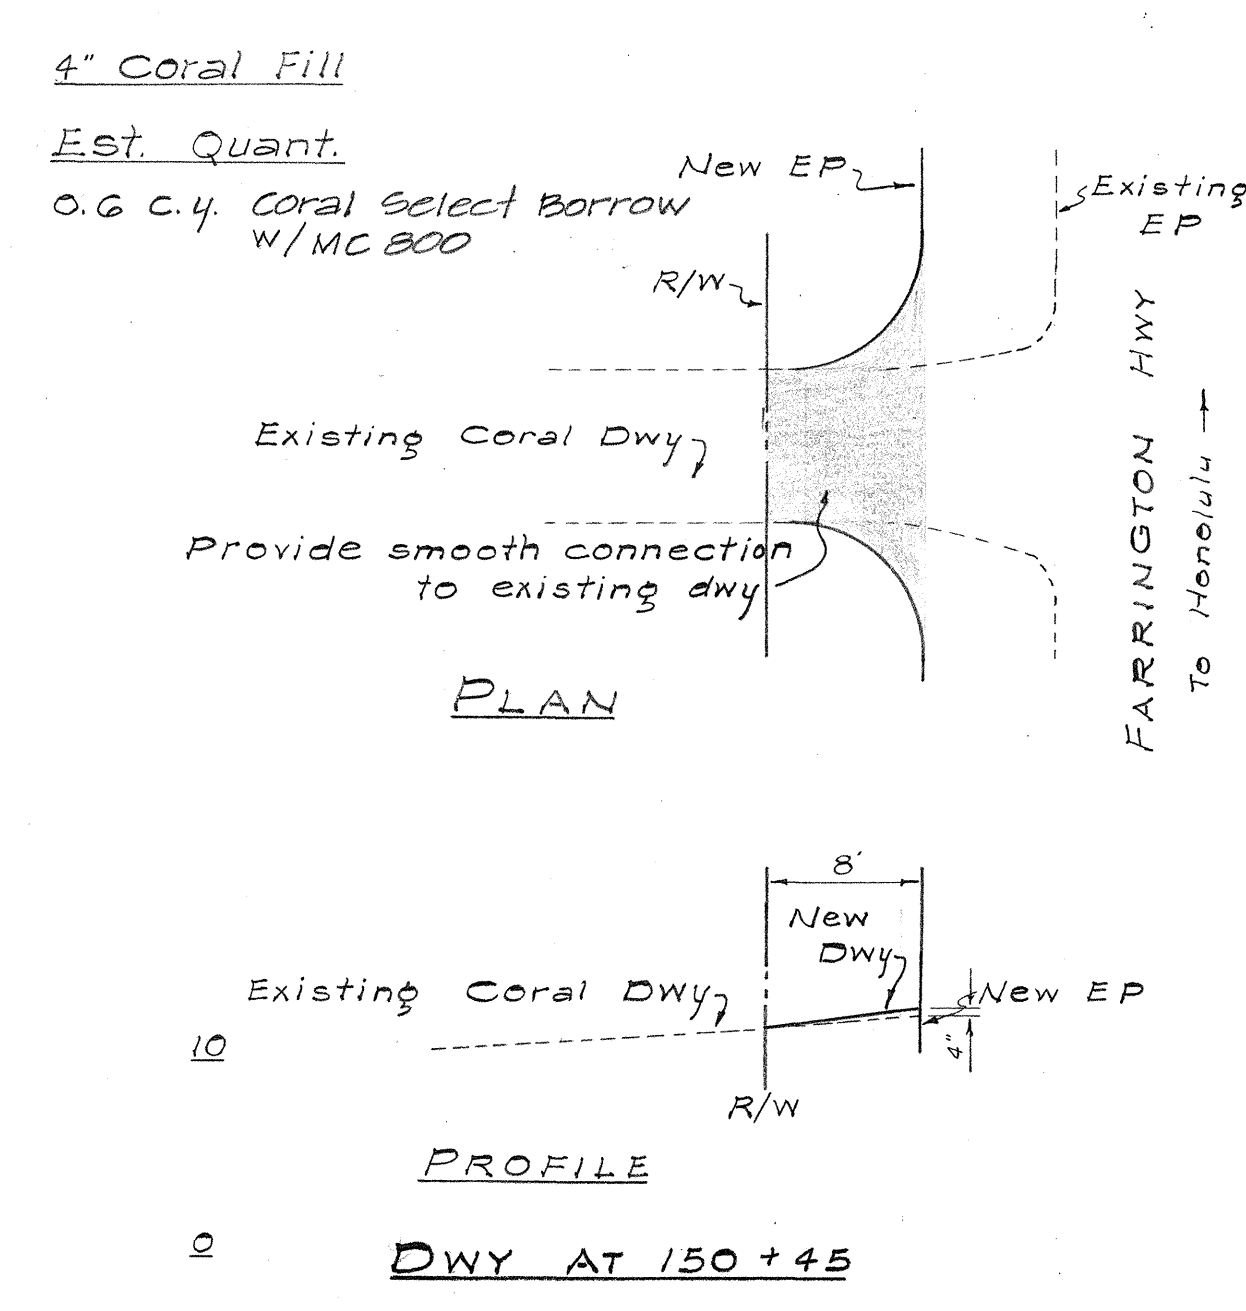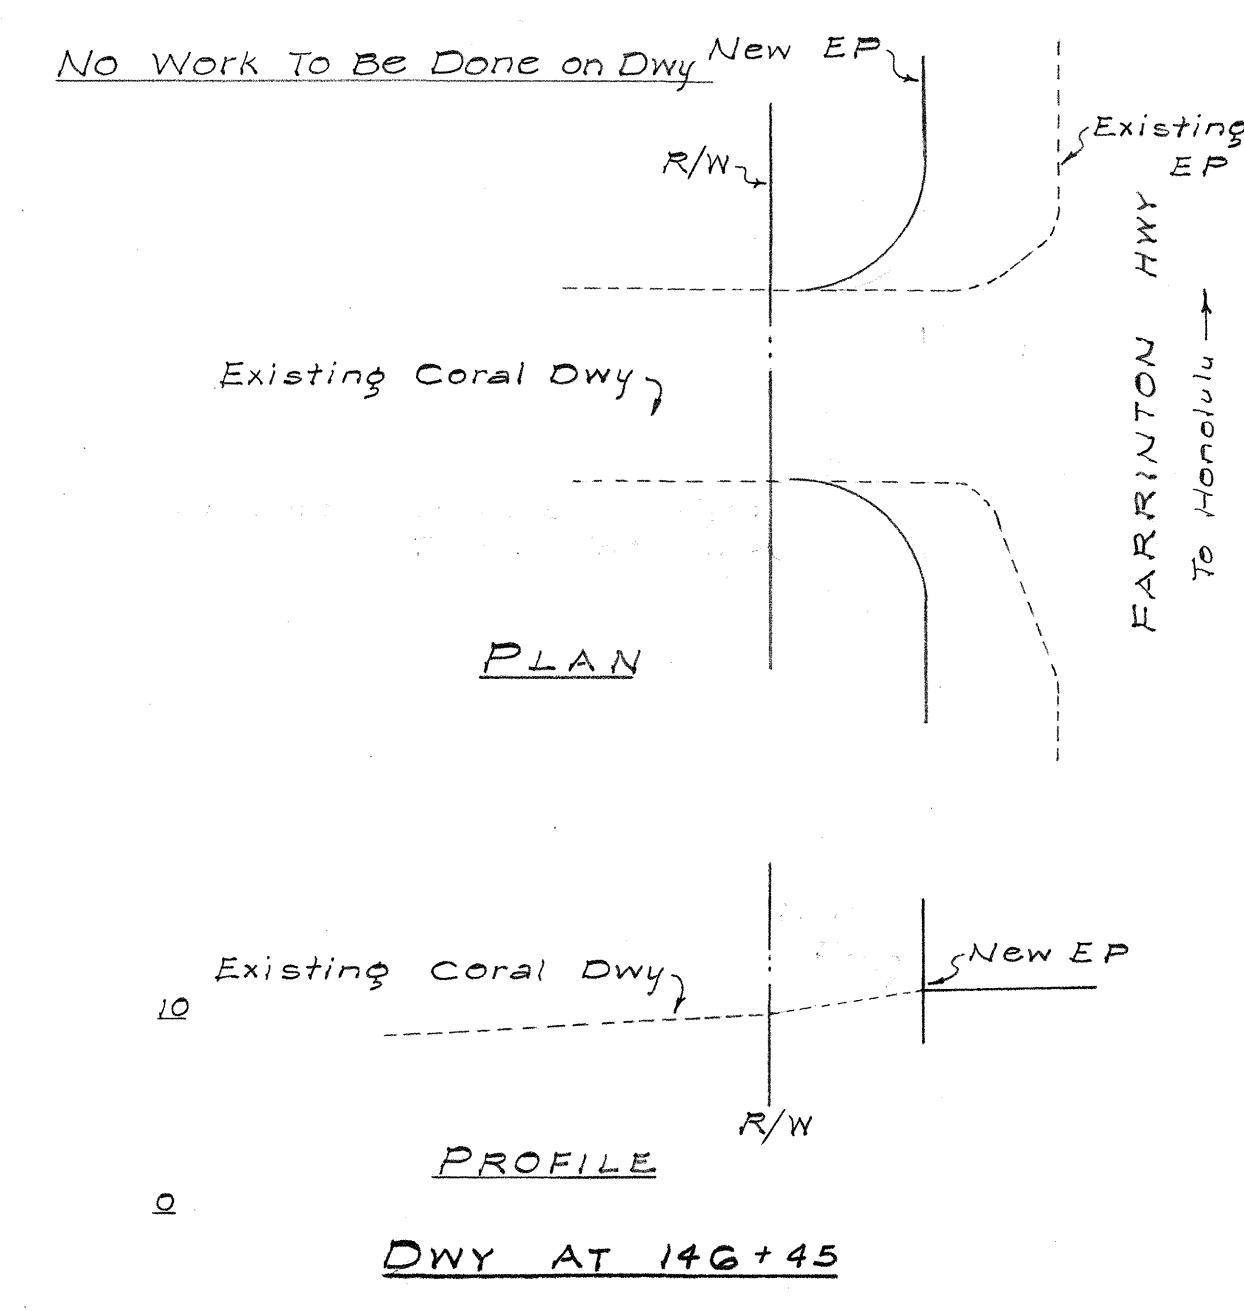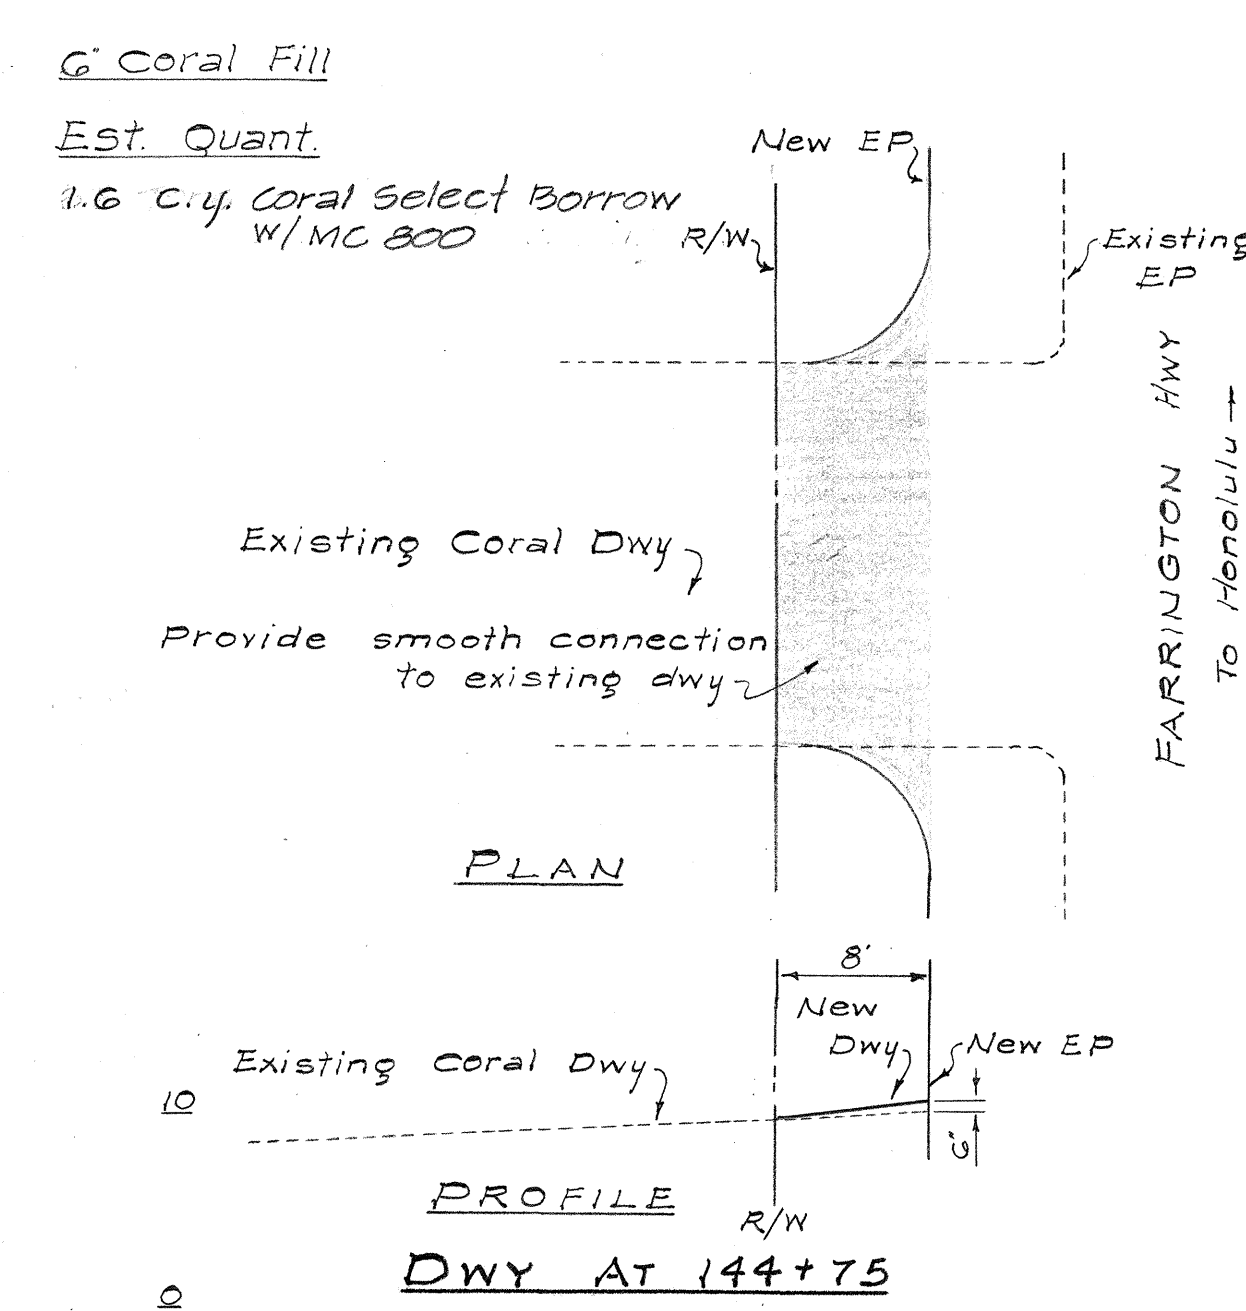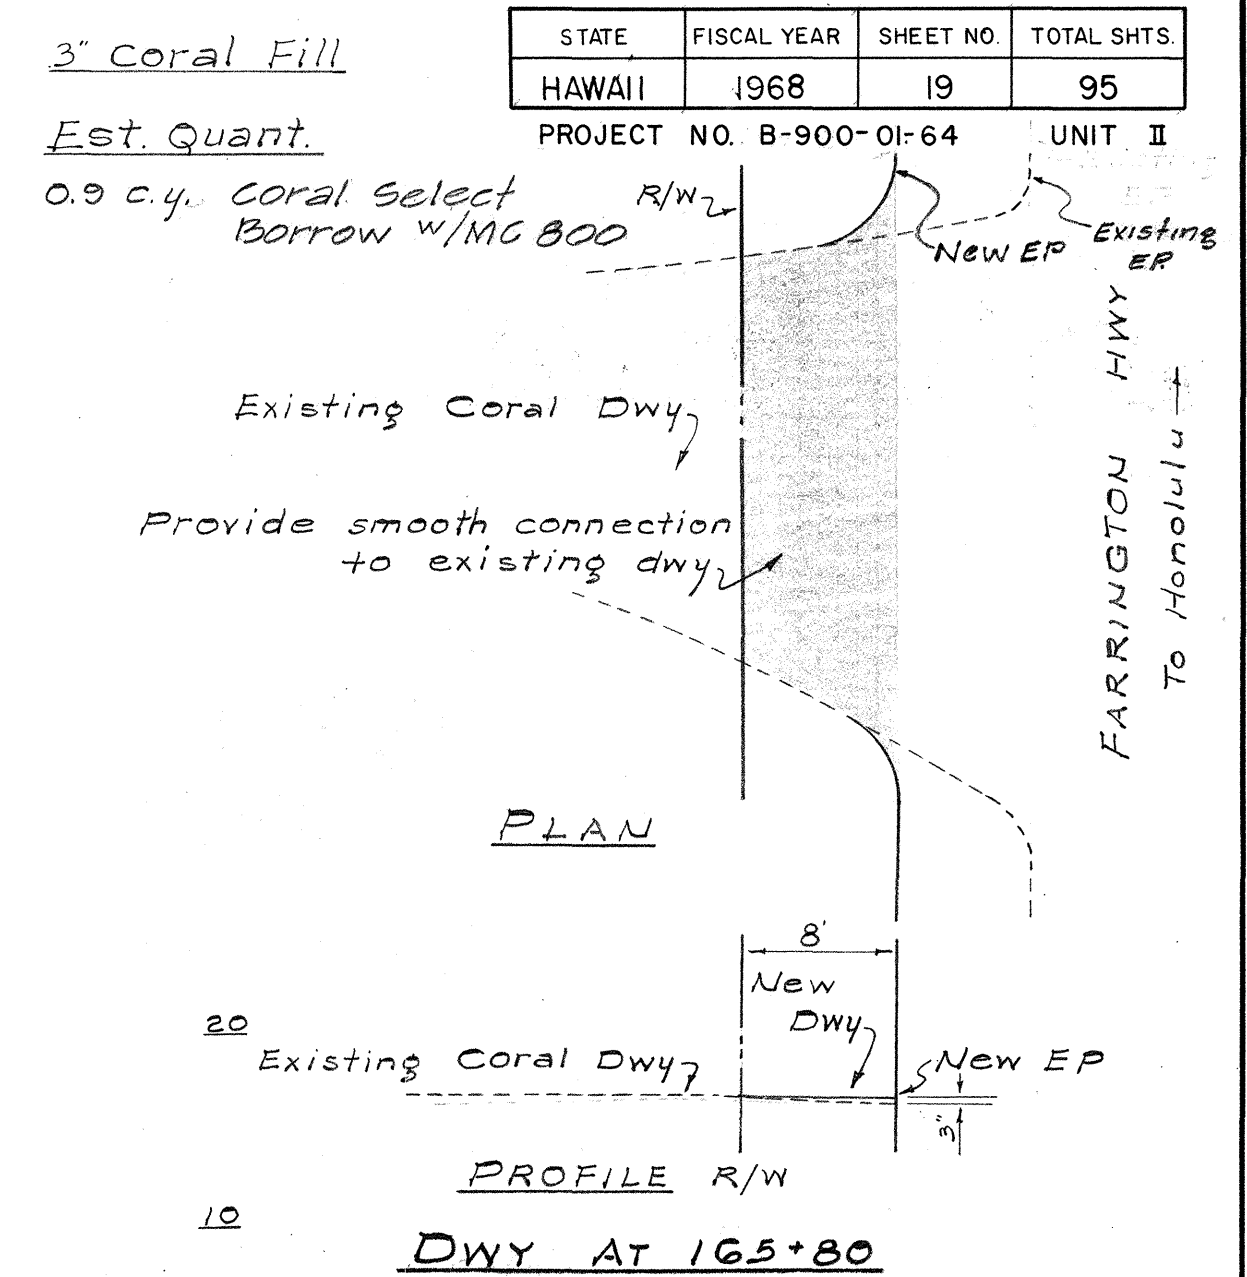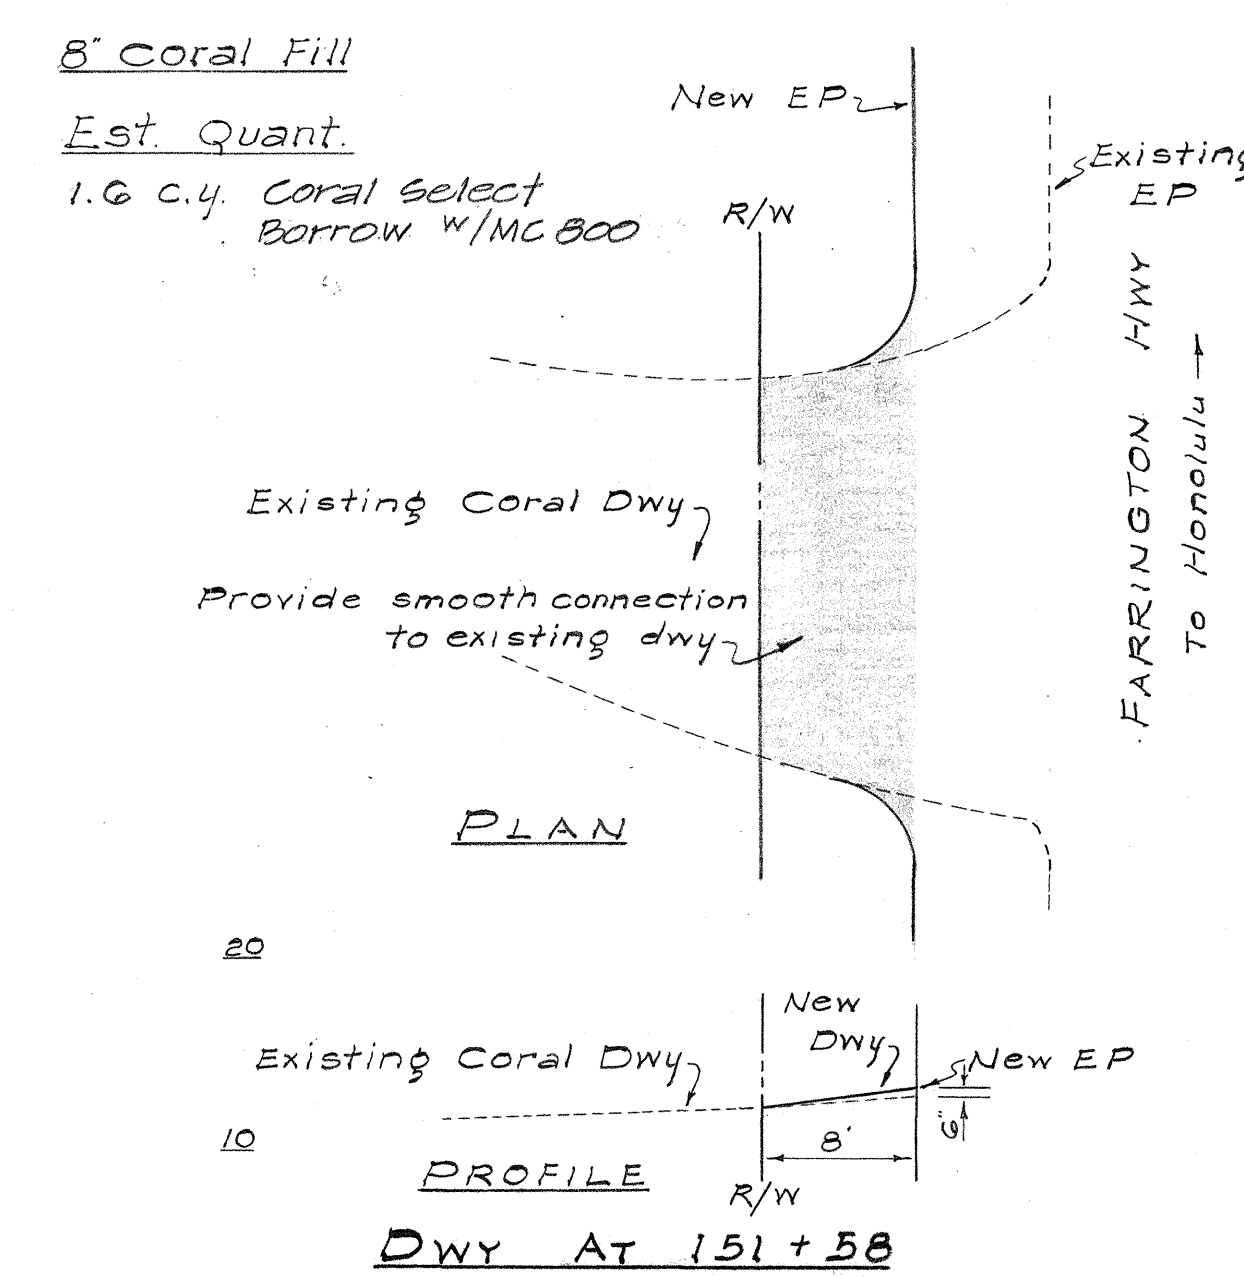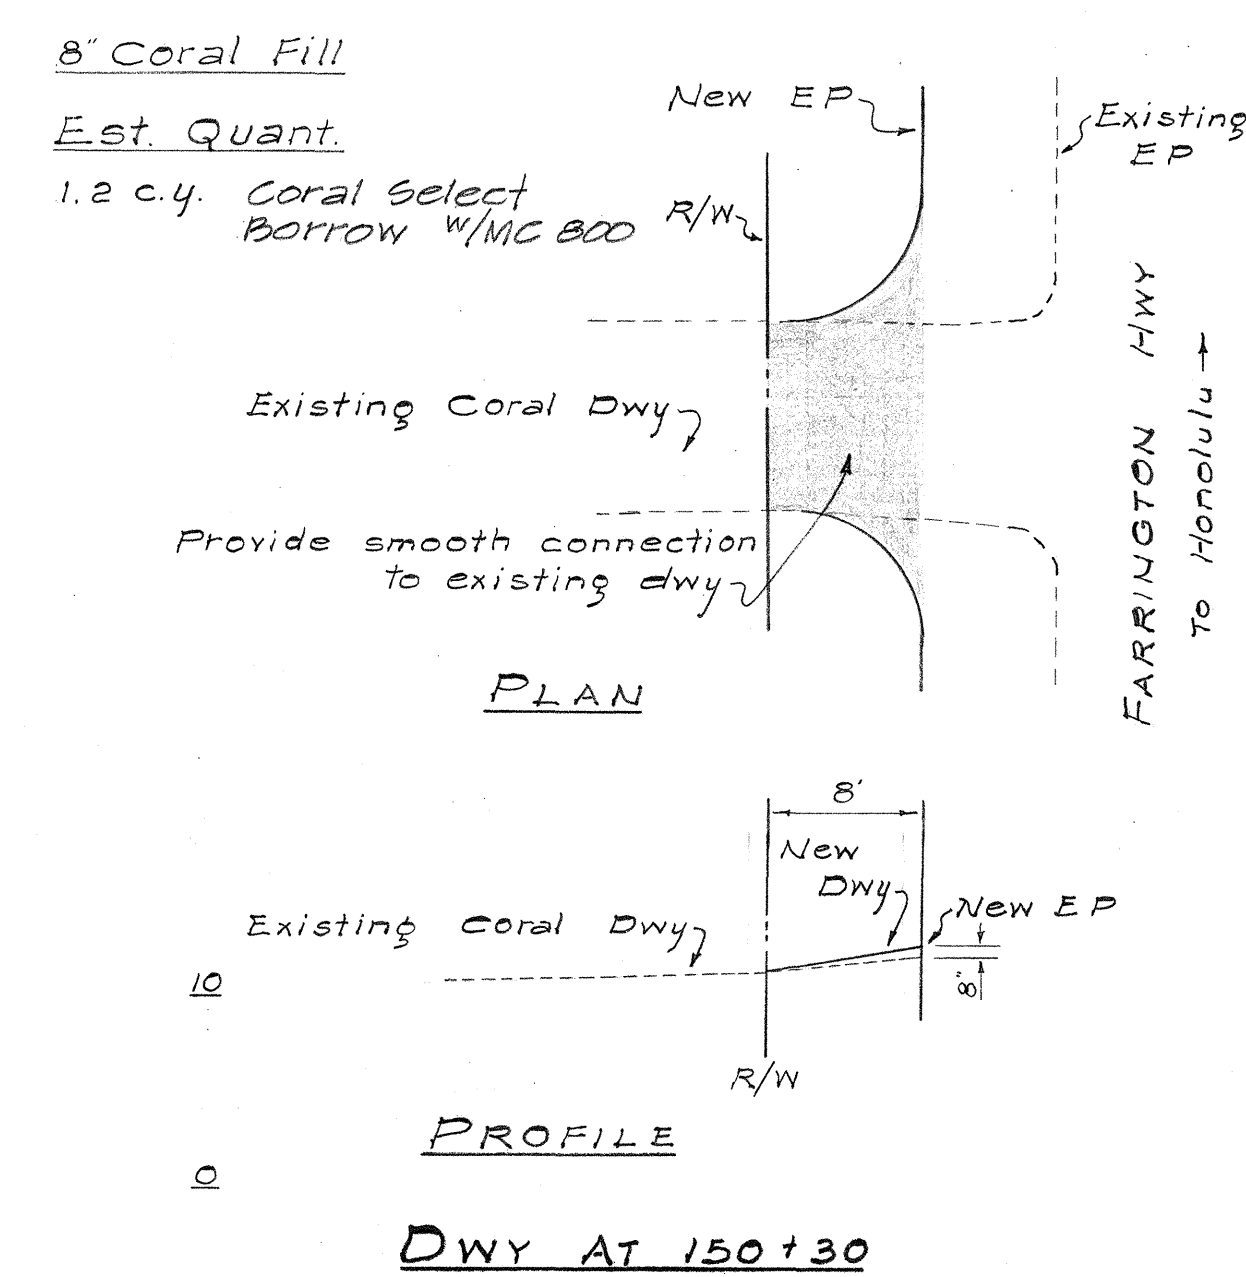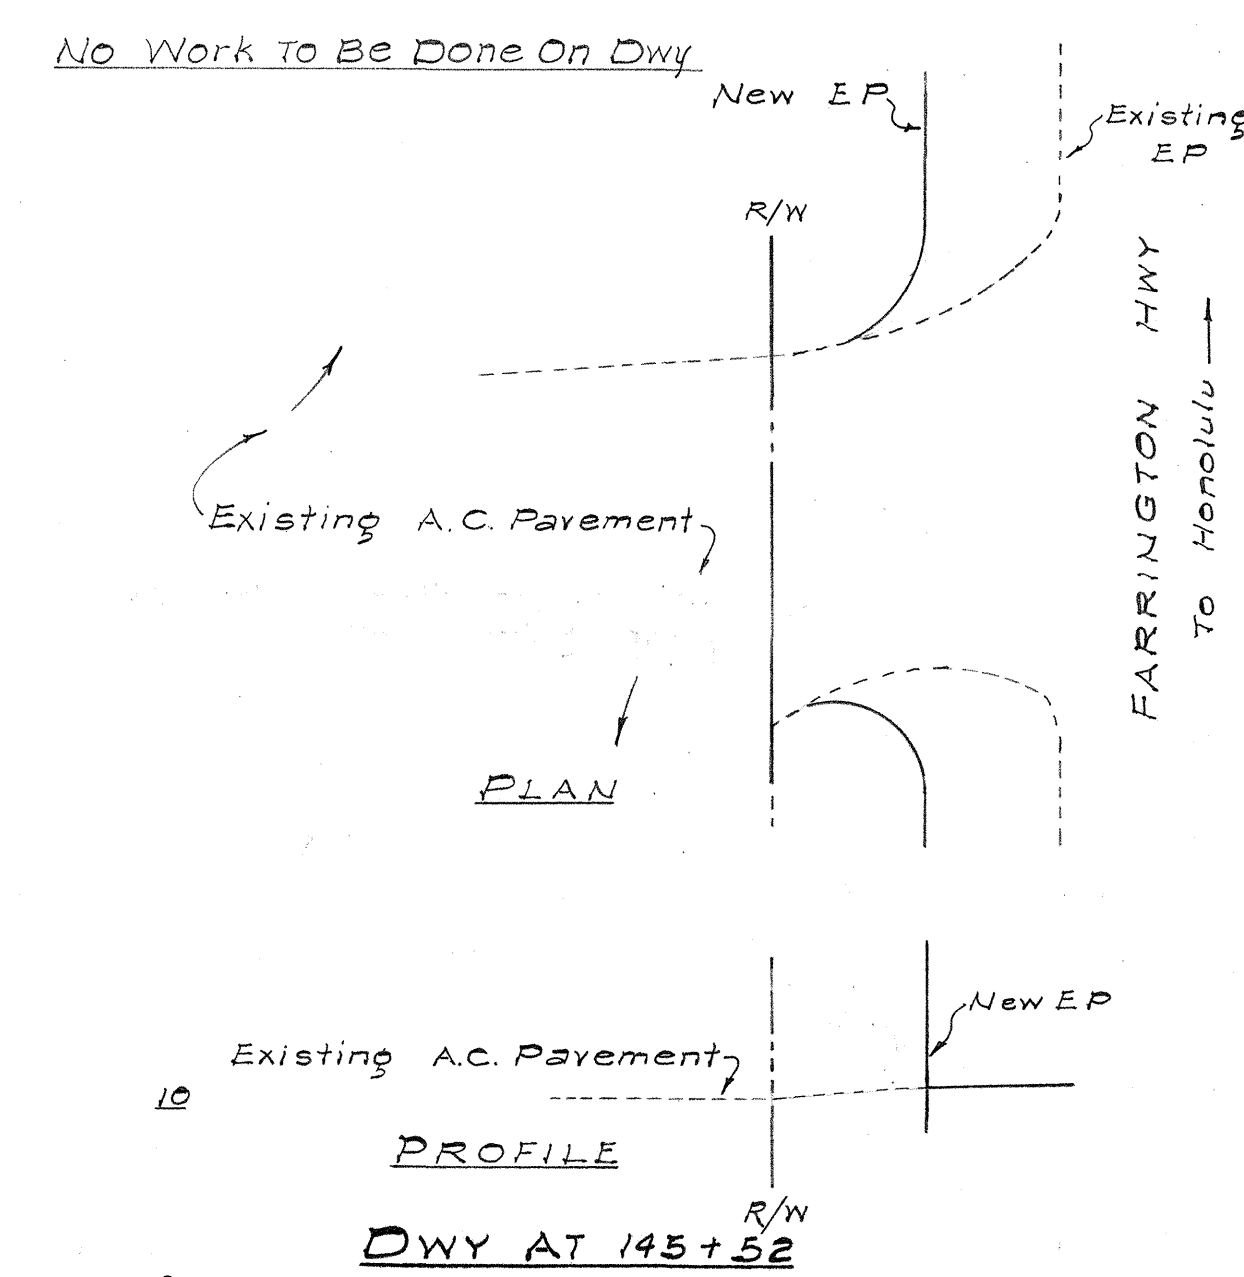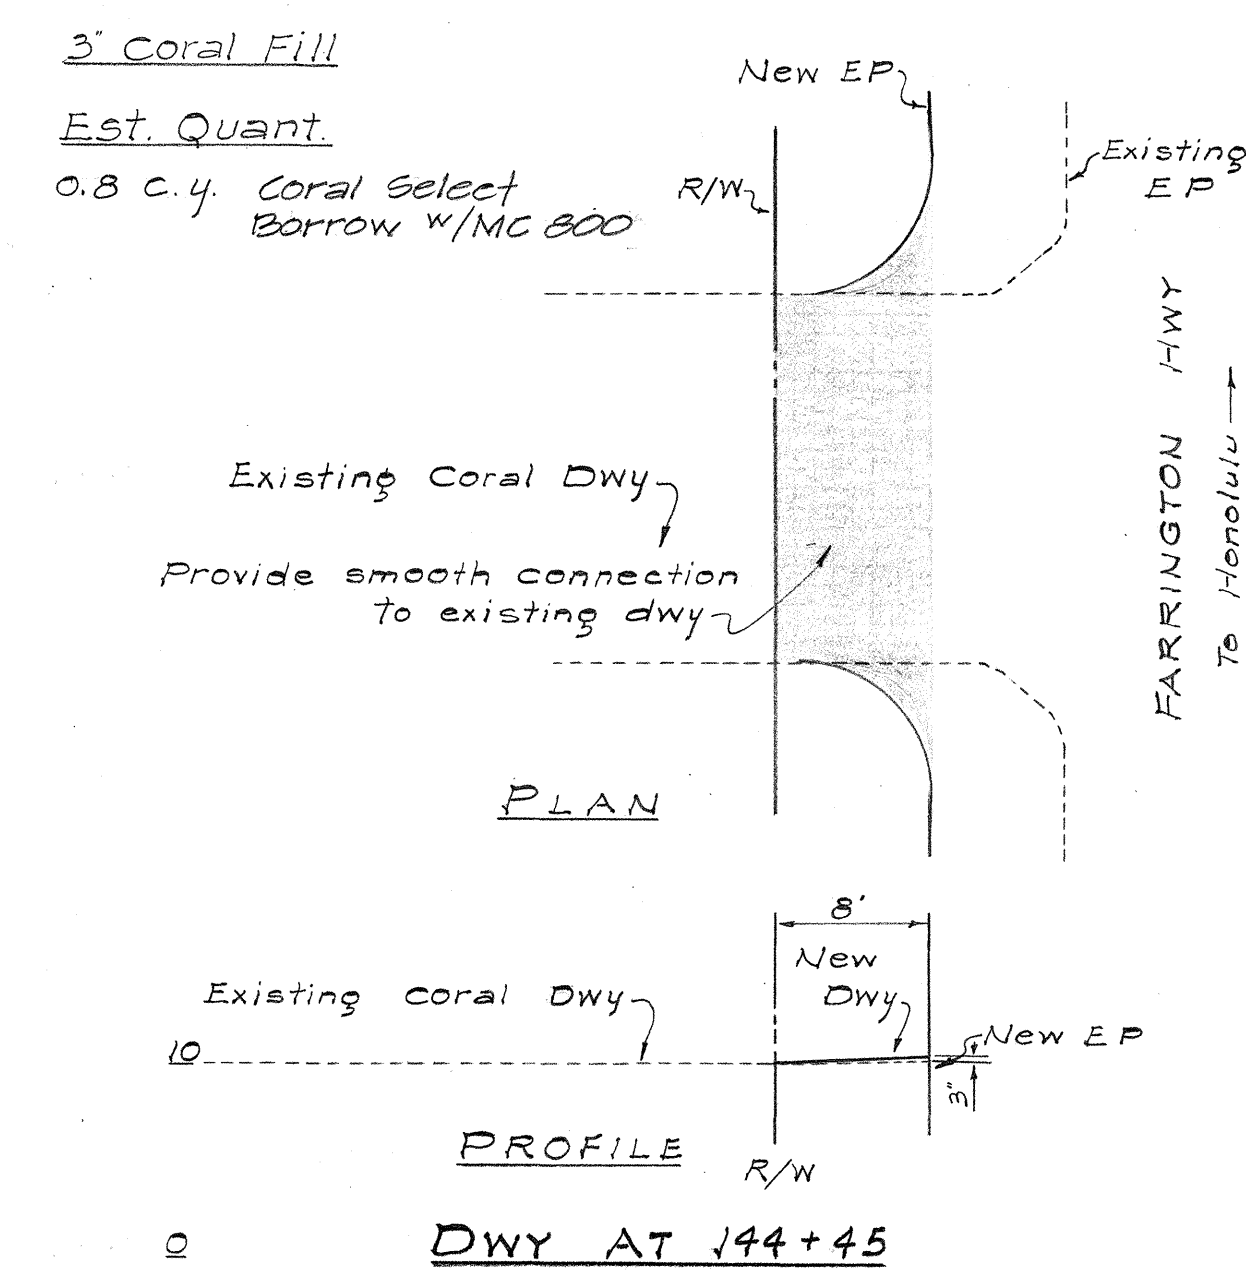

- NOTE:**
1. Driveway connections to be of same material as existing.
 2. A.C. pavement, untreated base course, prime coat, tack coat, coral select borrow w/MC 800 & excavation for driveways will be paid for under respective roadway items.
 3. MC 800 shall be bituminous seal coat for shoulders with crushed rock.

STATE OF HAWAII
 DEPARTMENT OF TRANSPORTATION
 HIGHWAYS DIVISION














DRIVEWAY DETAILS

FARRINGTON HIGHWAY WIDENING
 PROJECT B-900-01-64

SCALE: Hor: 1"=10'
 Vert: 1"=10'

UNIT II

SHEET No. 3 OF 5 SHEETS

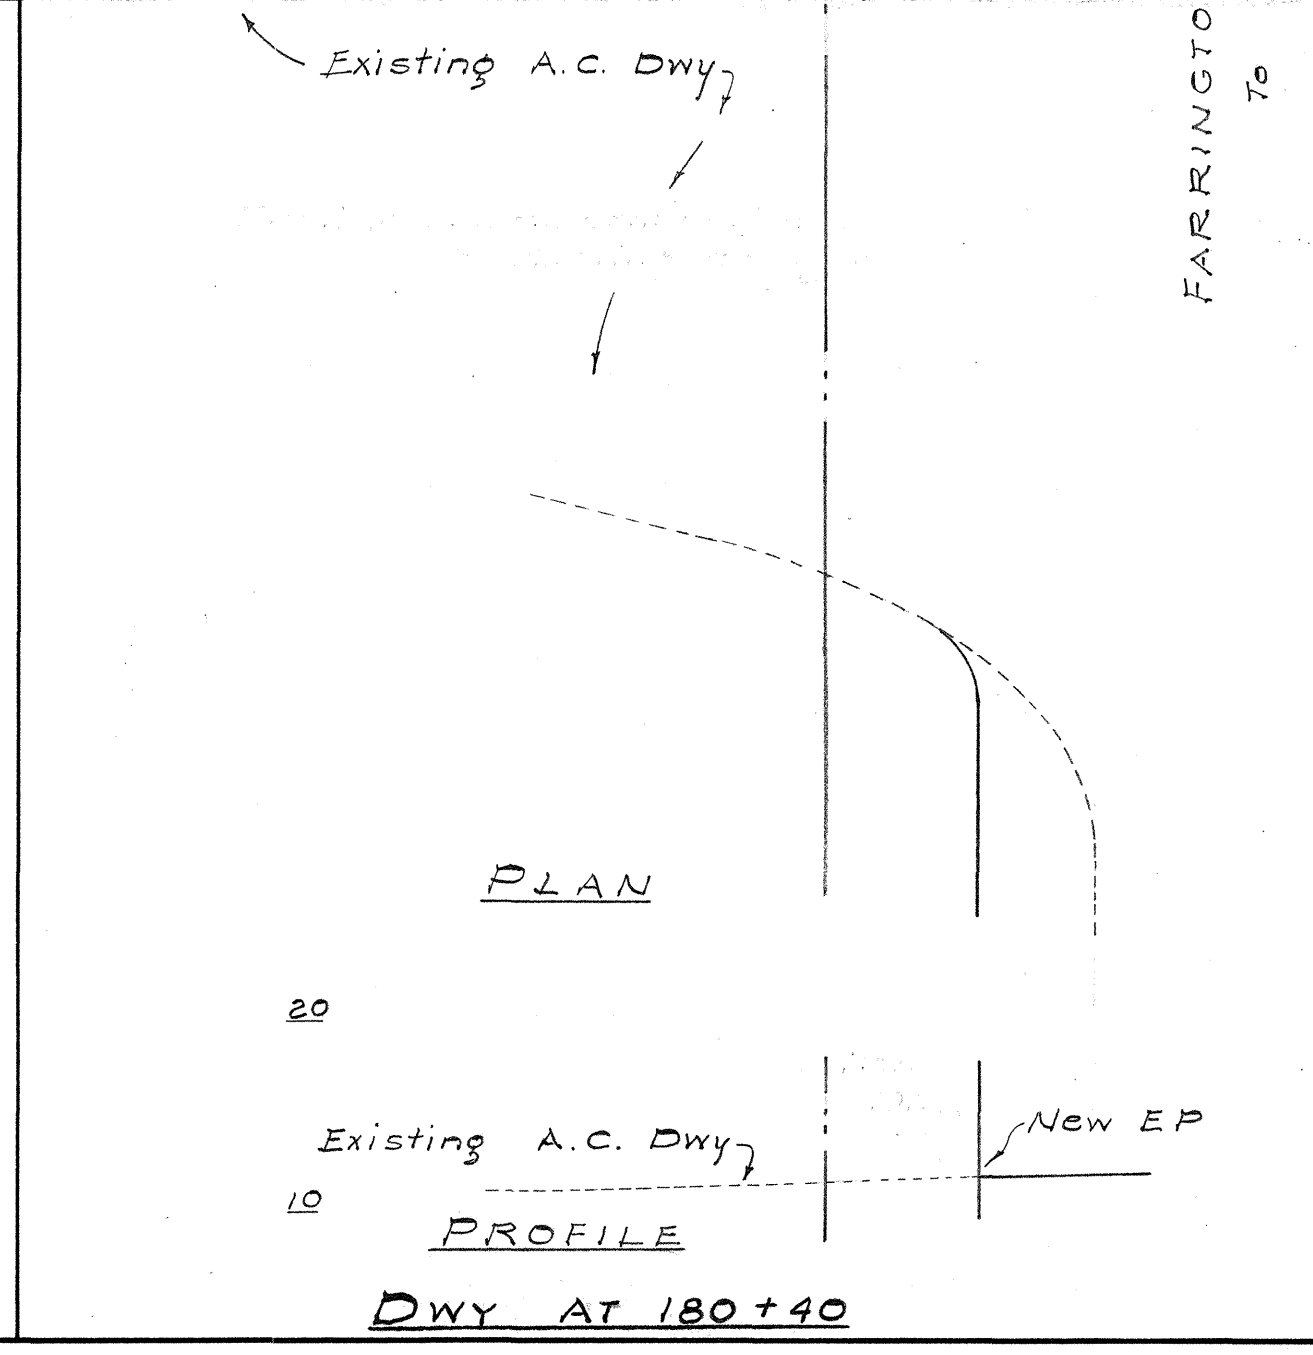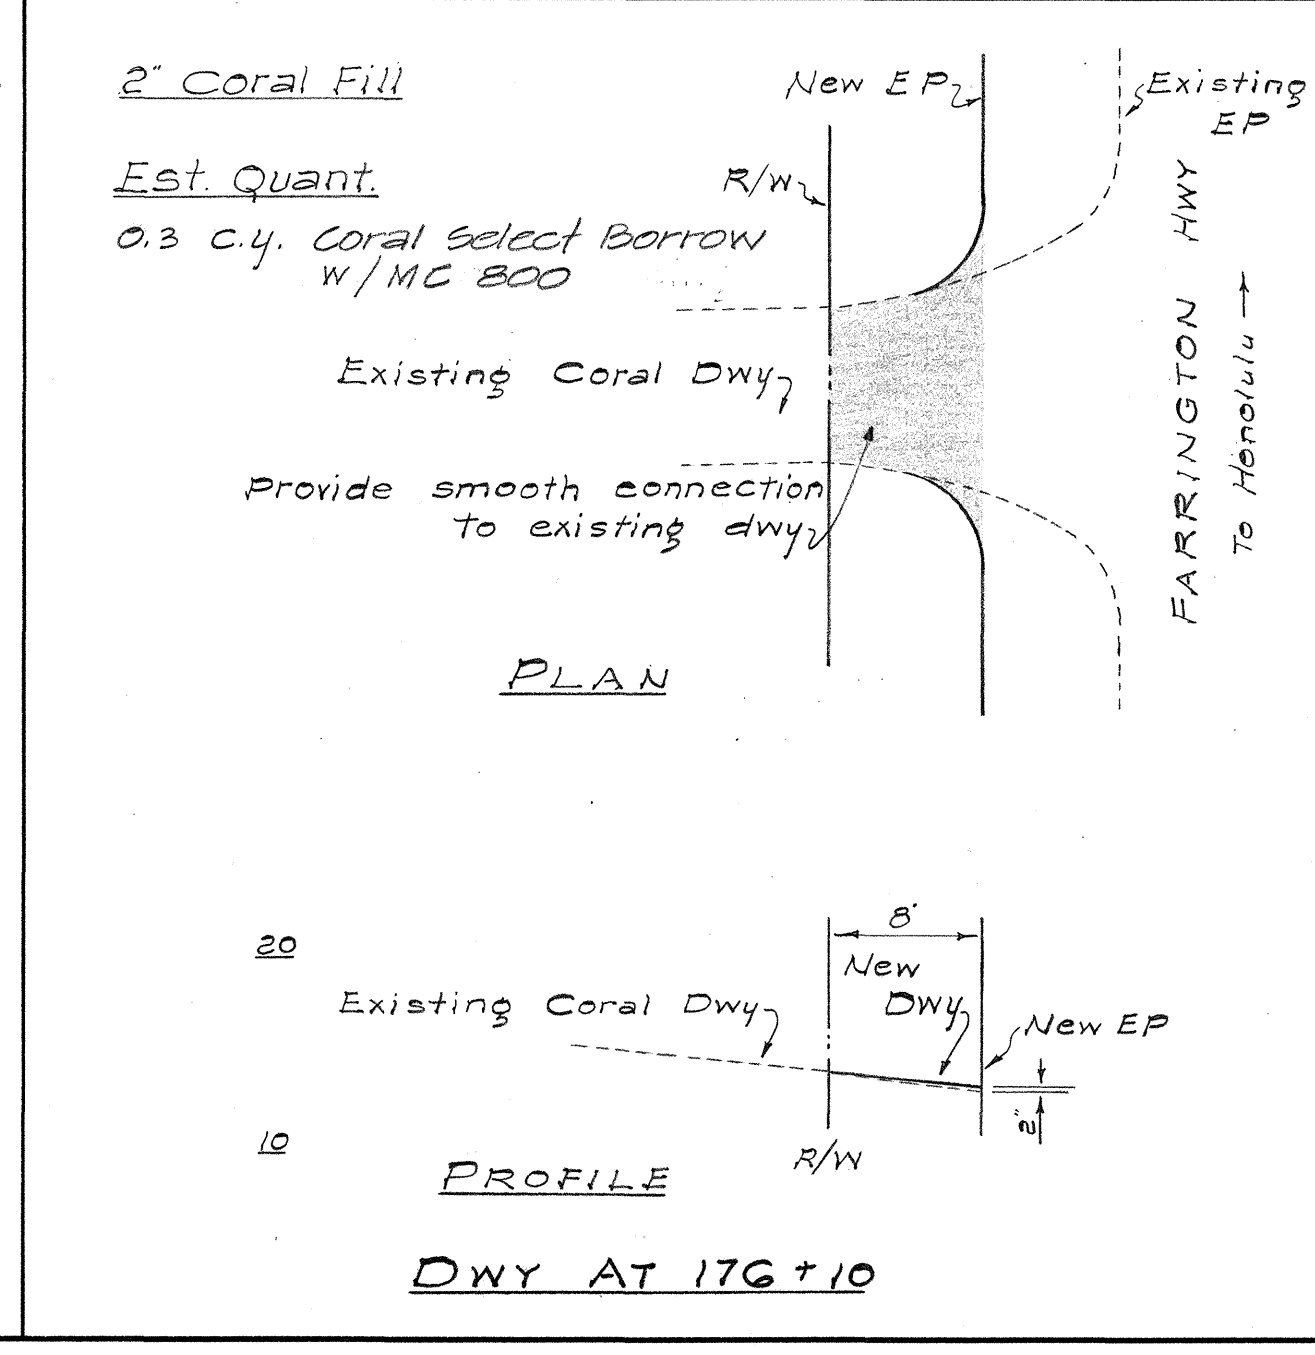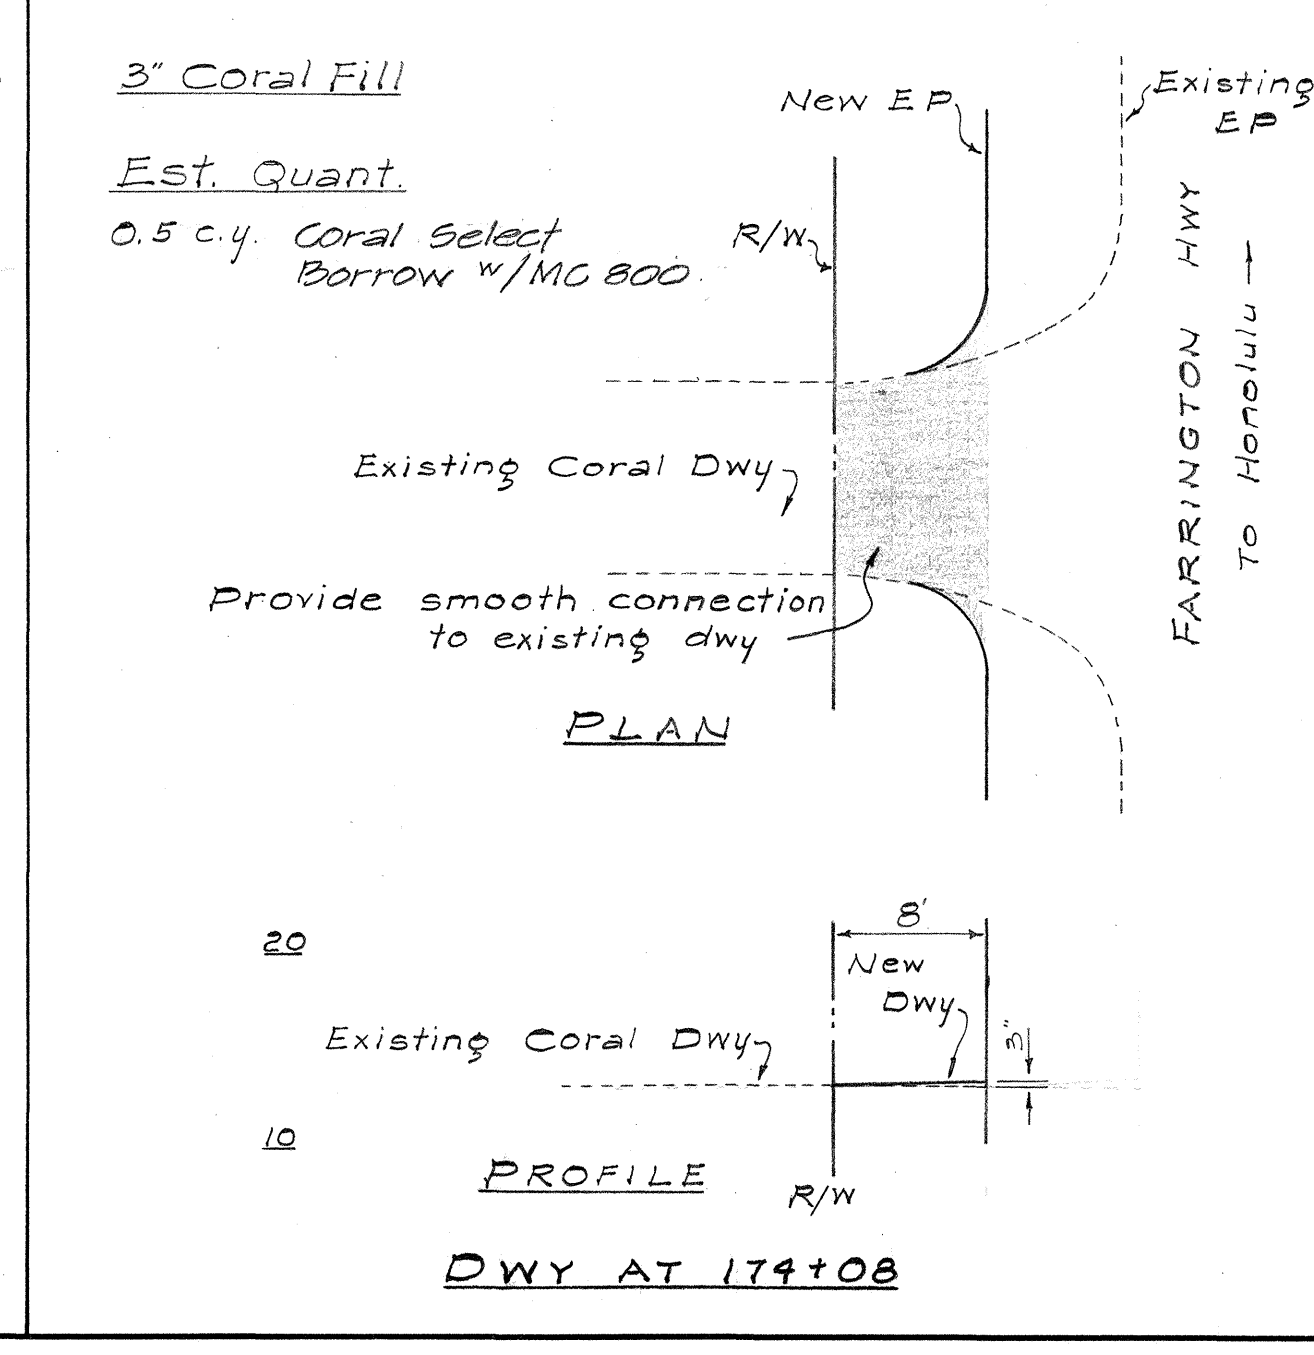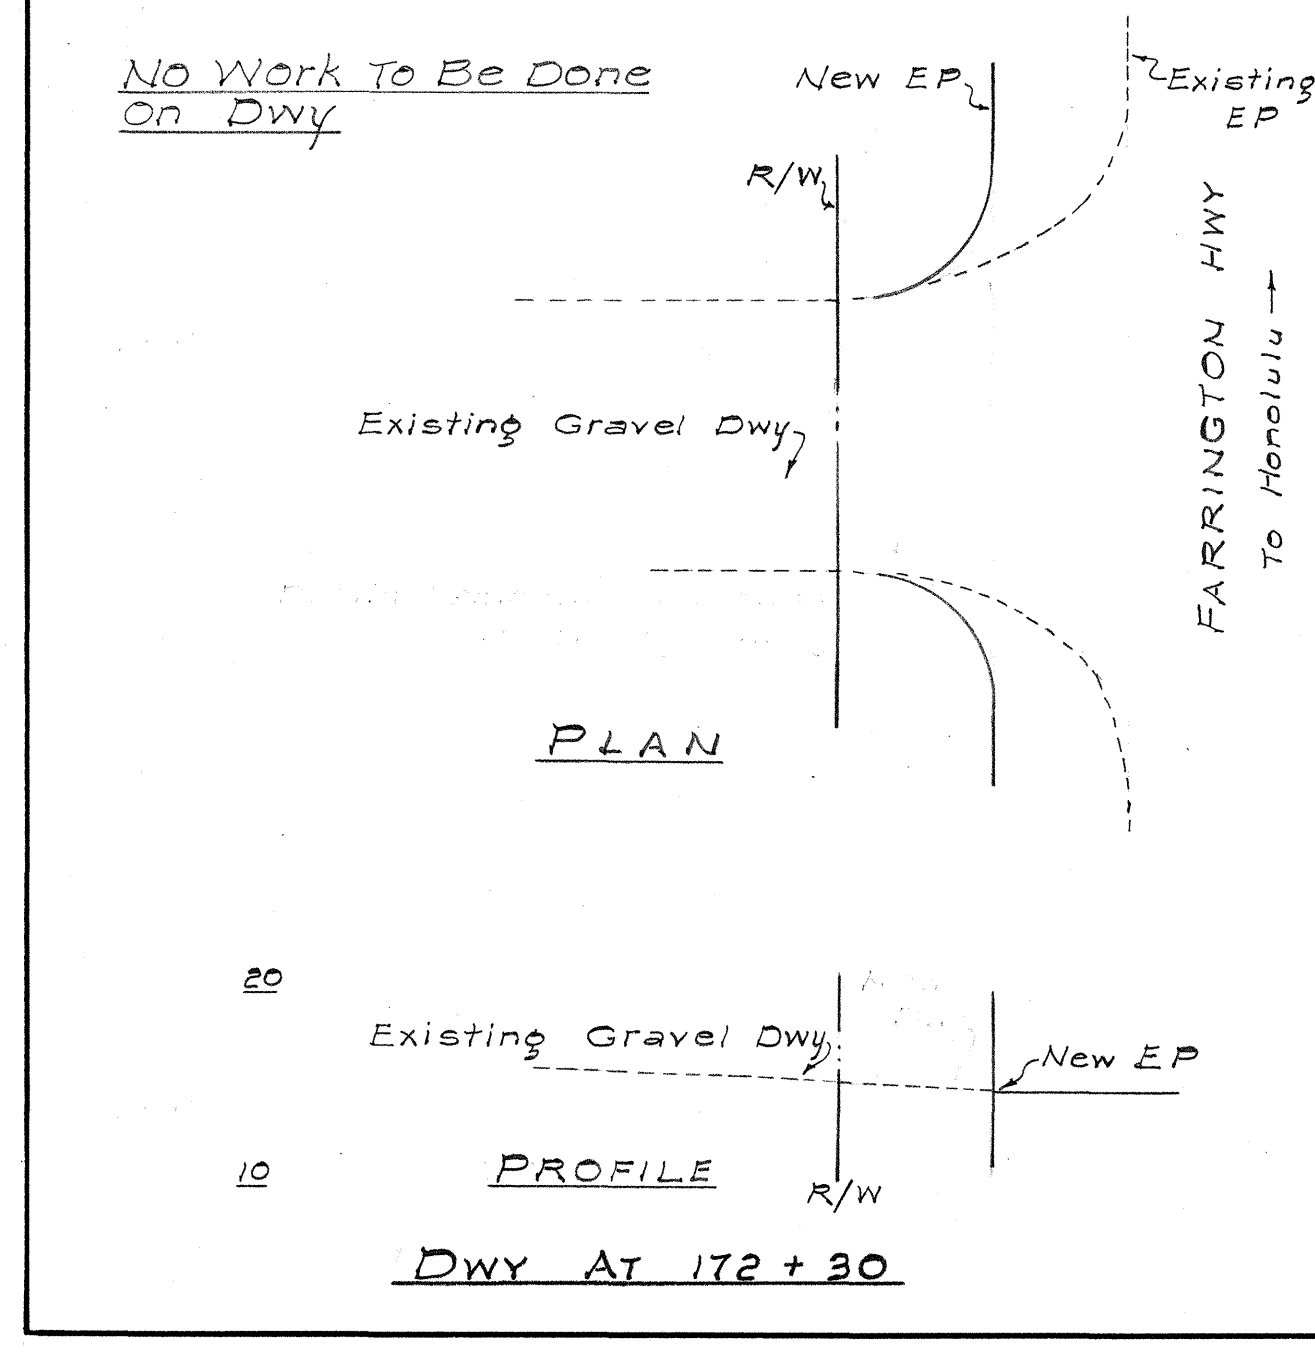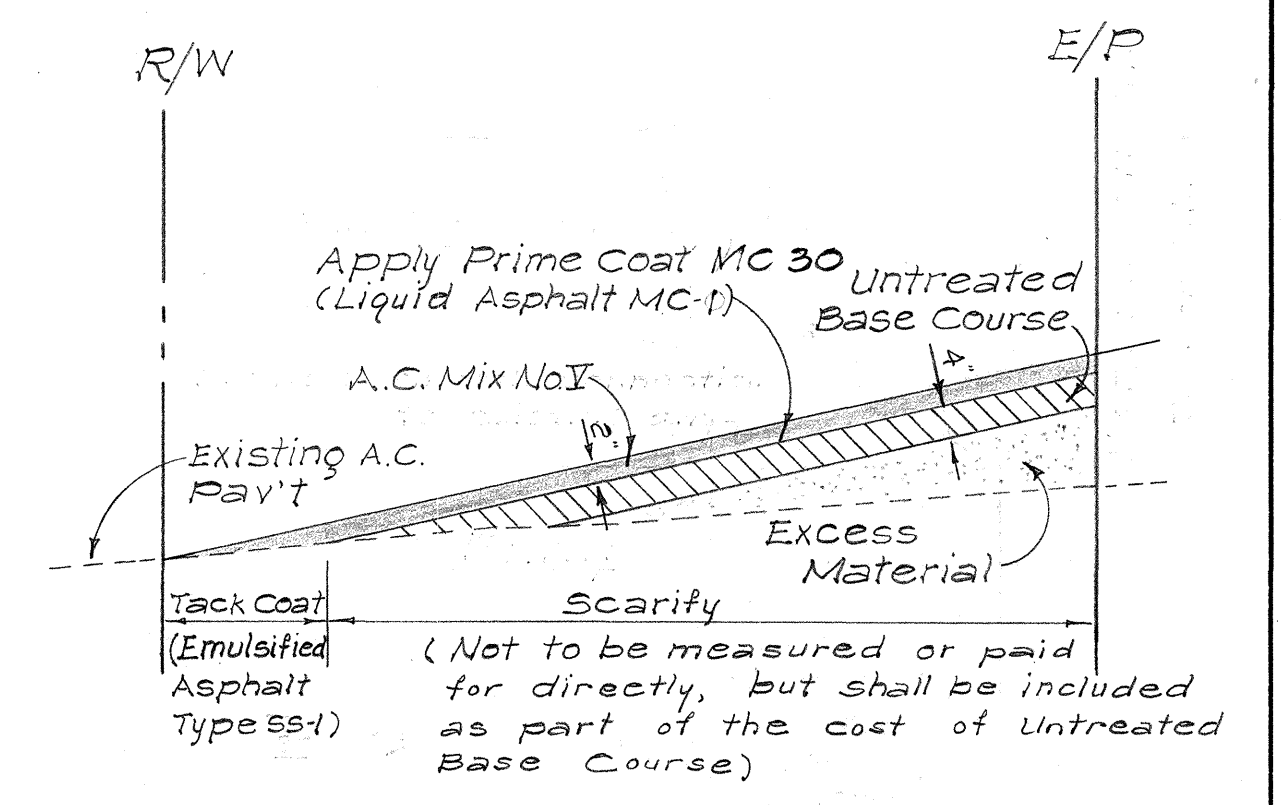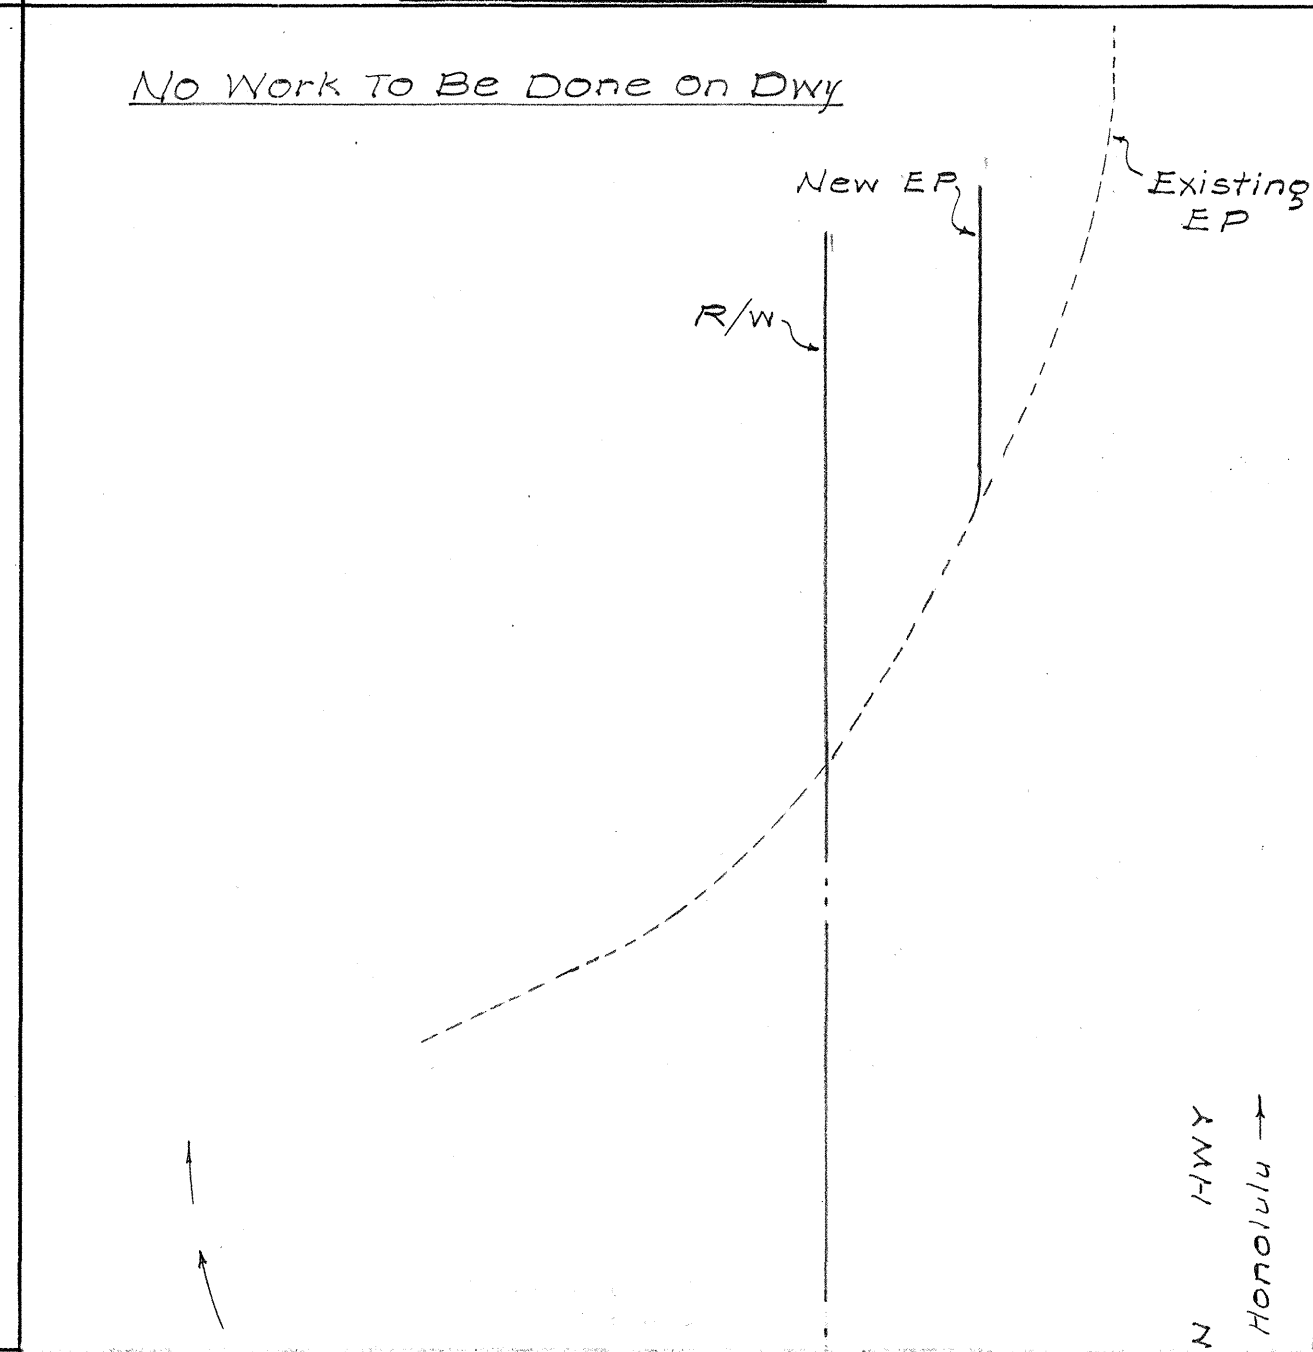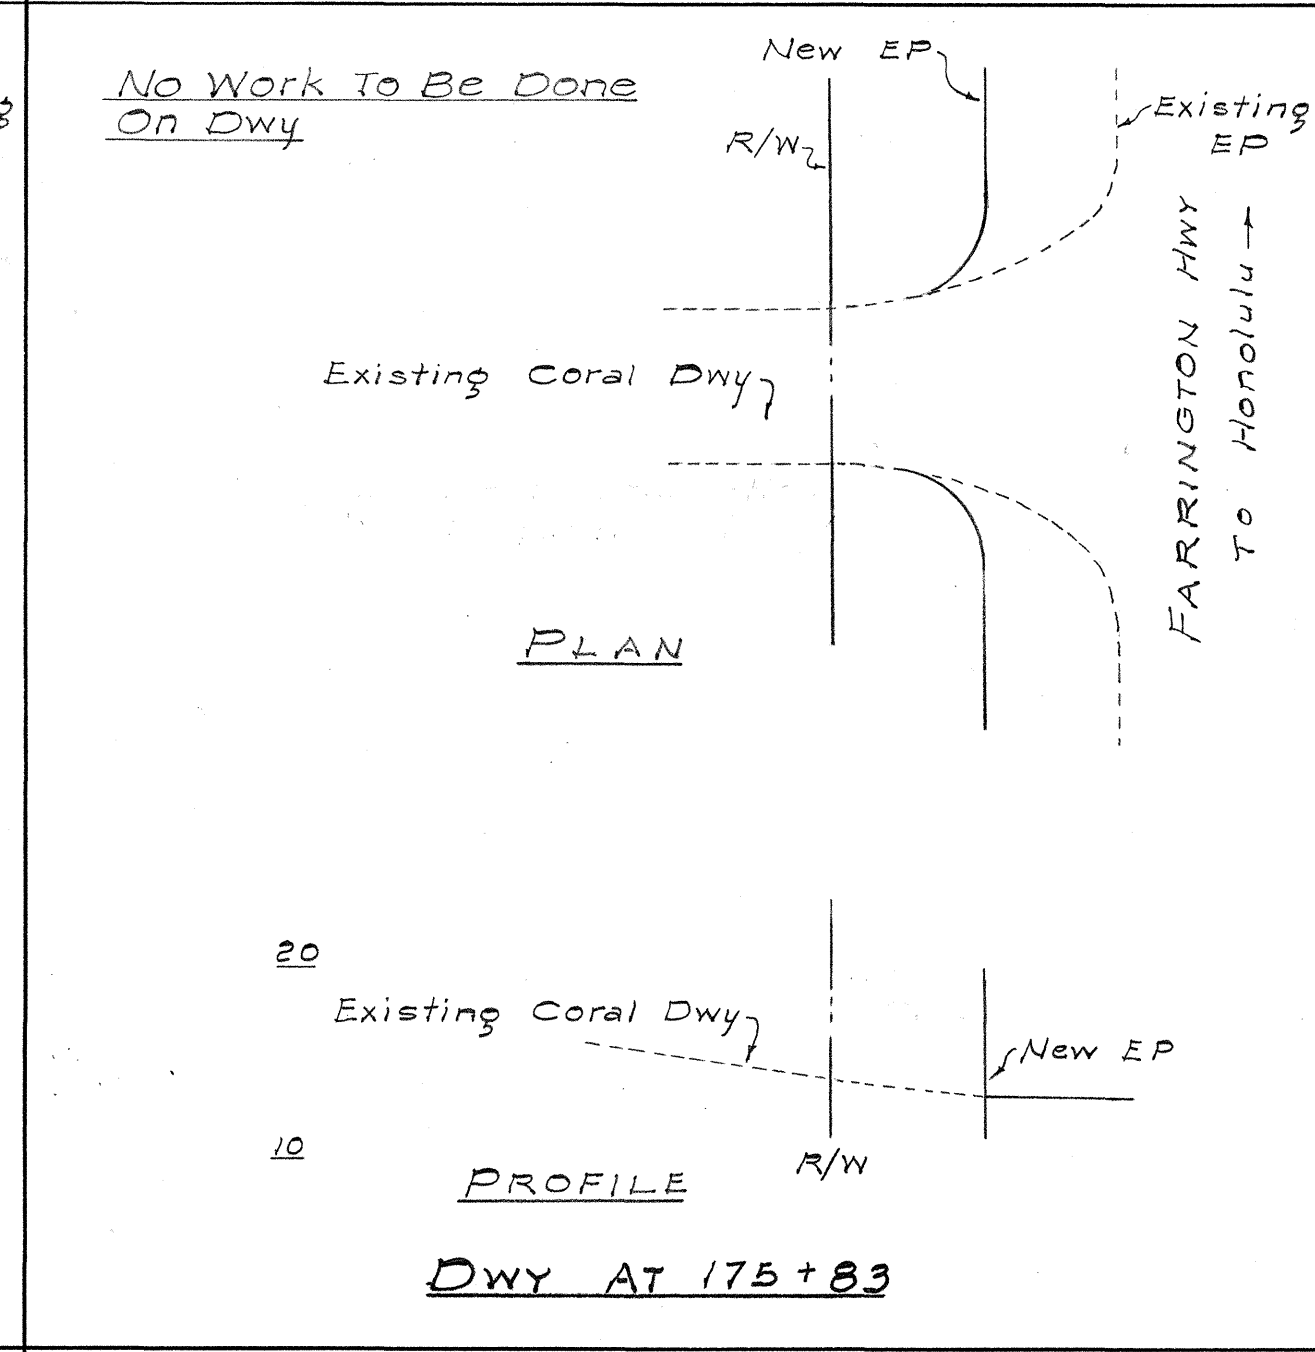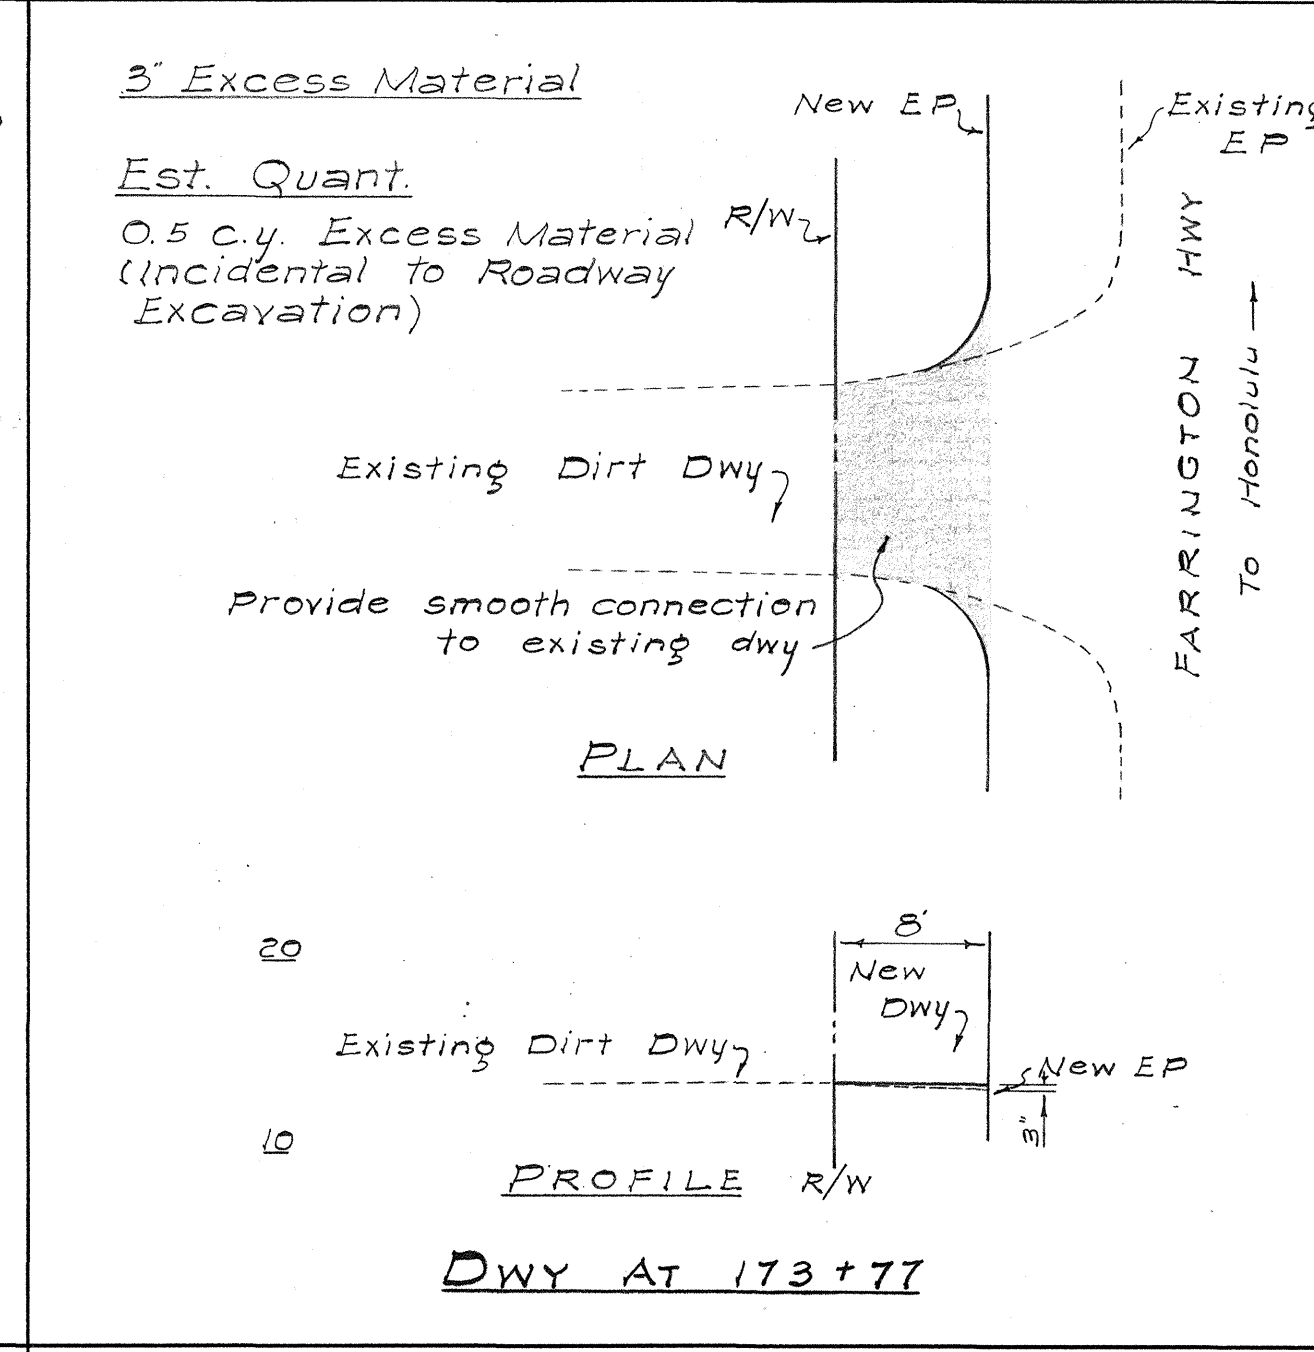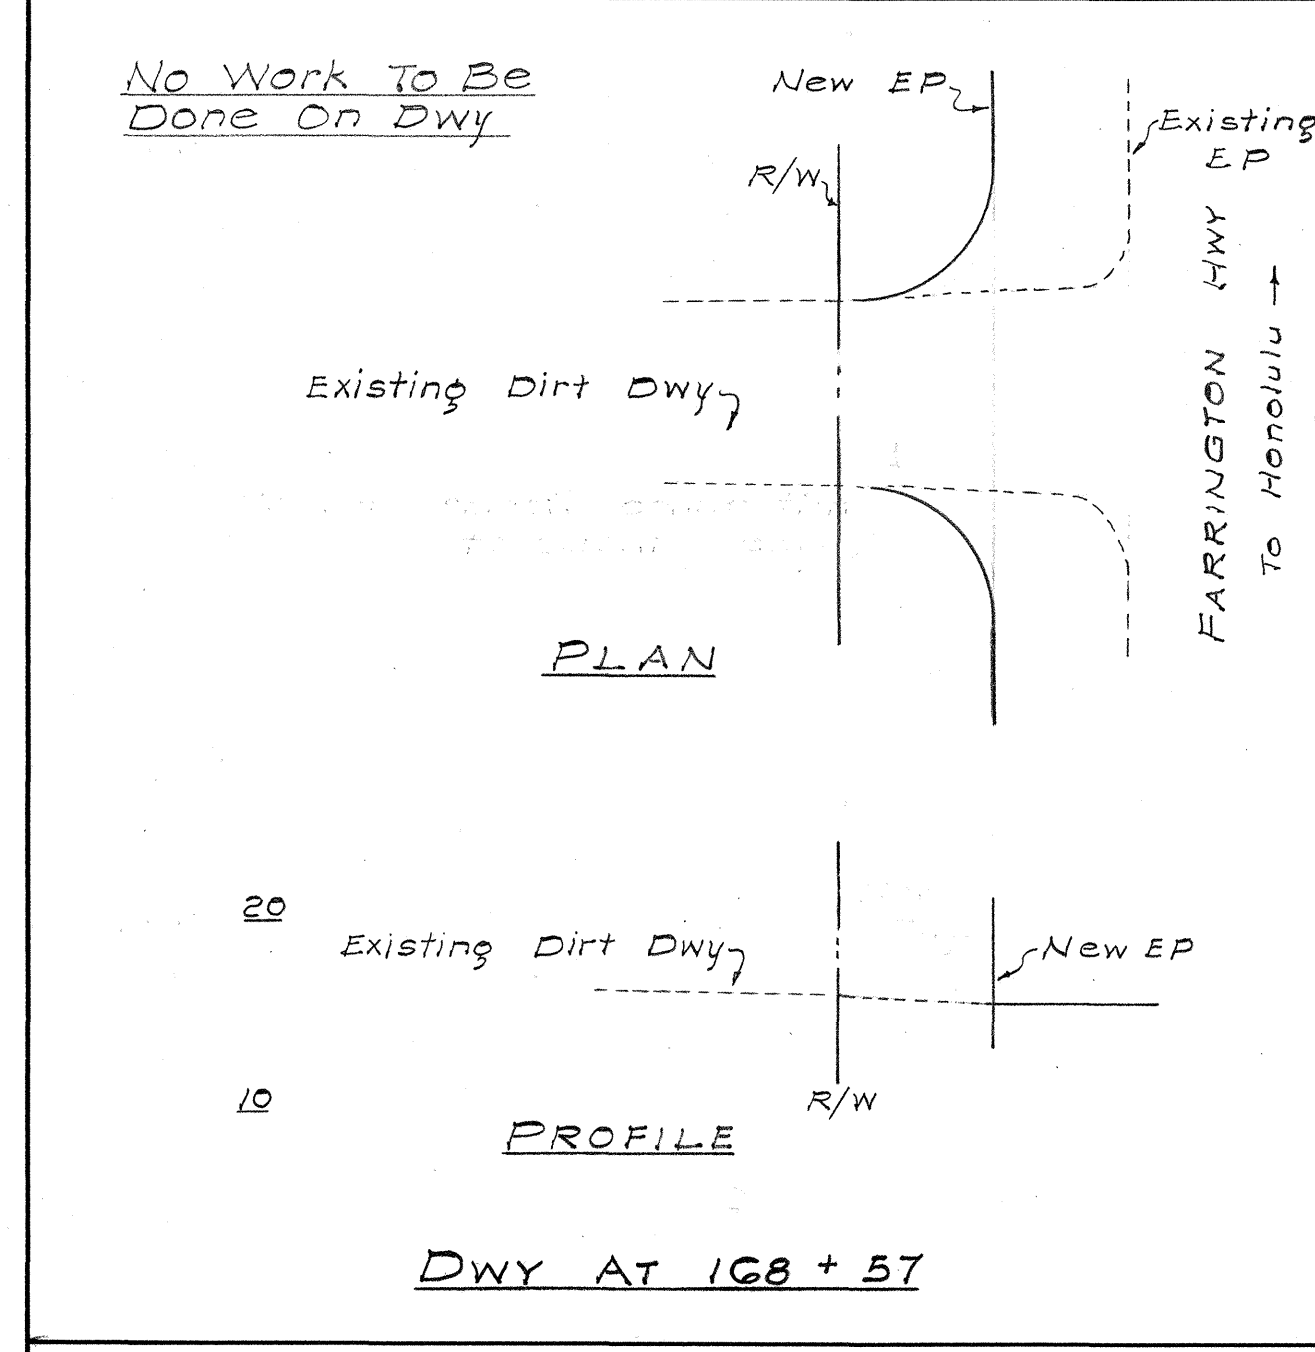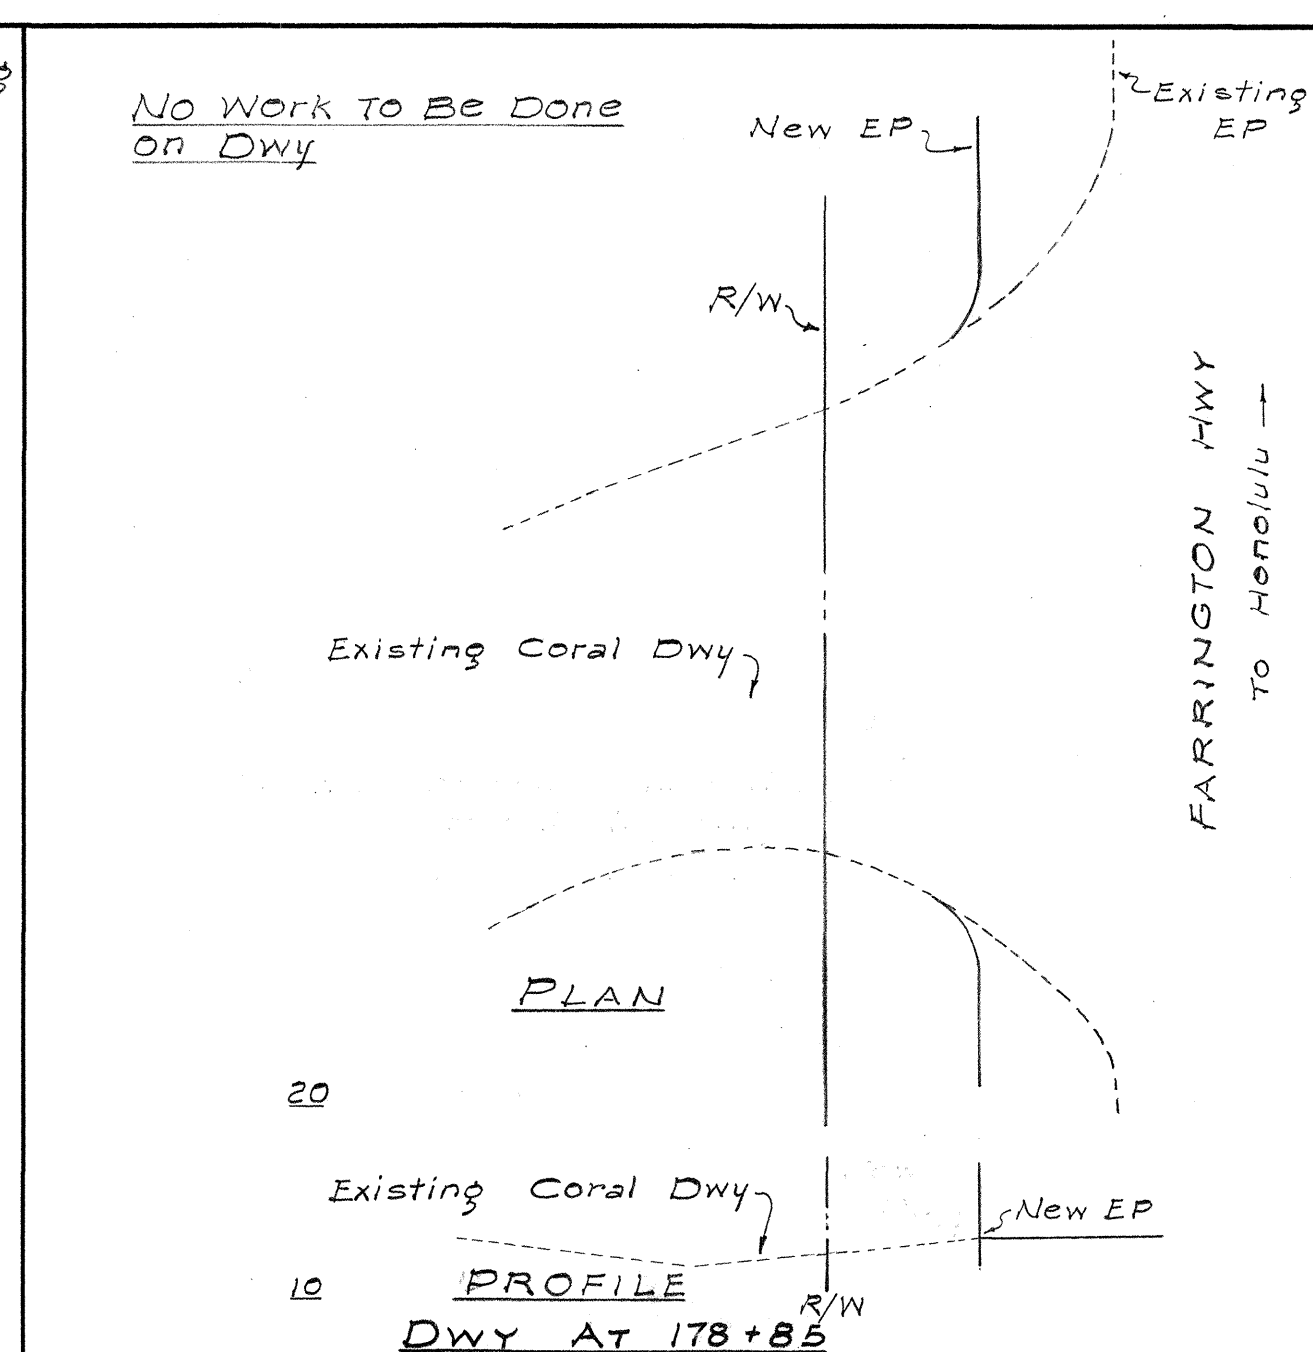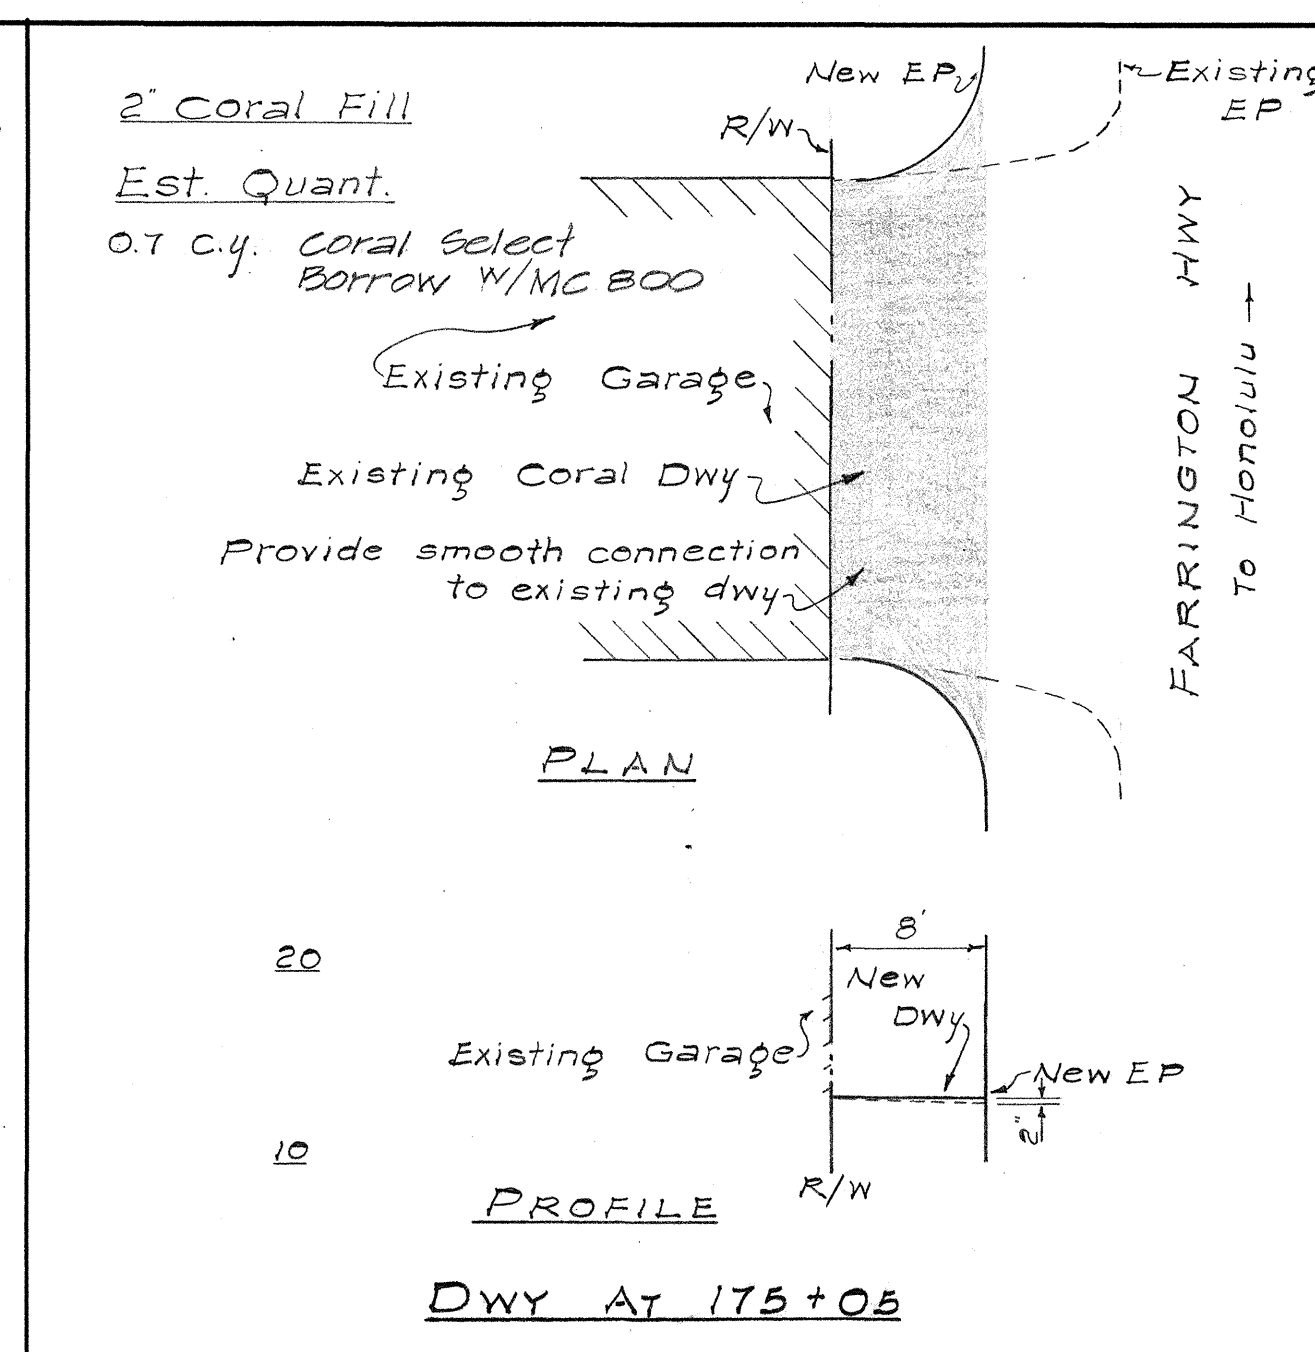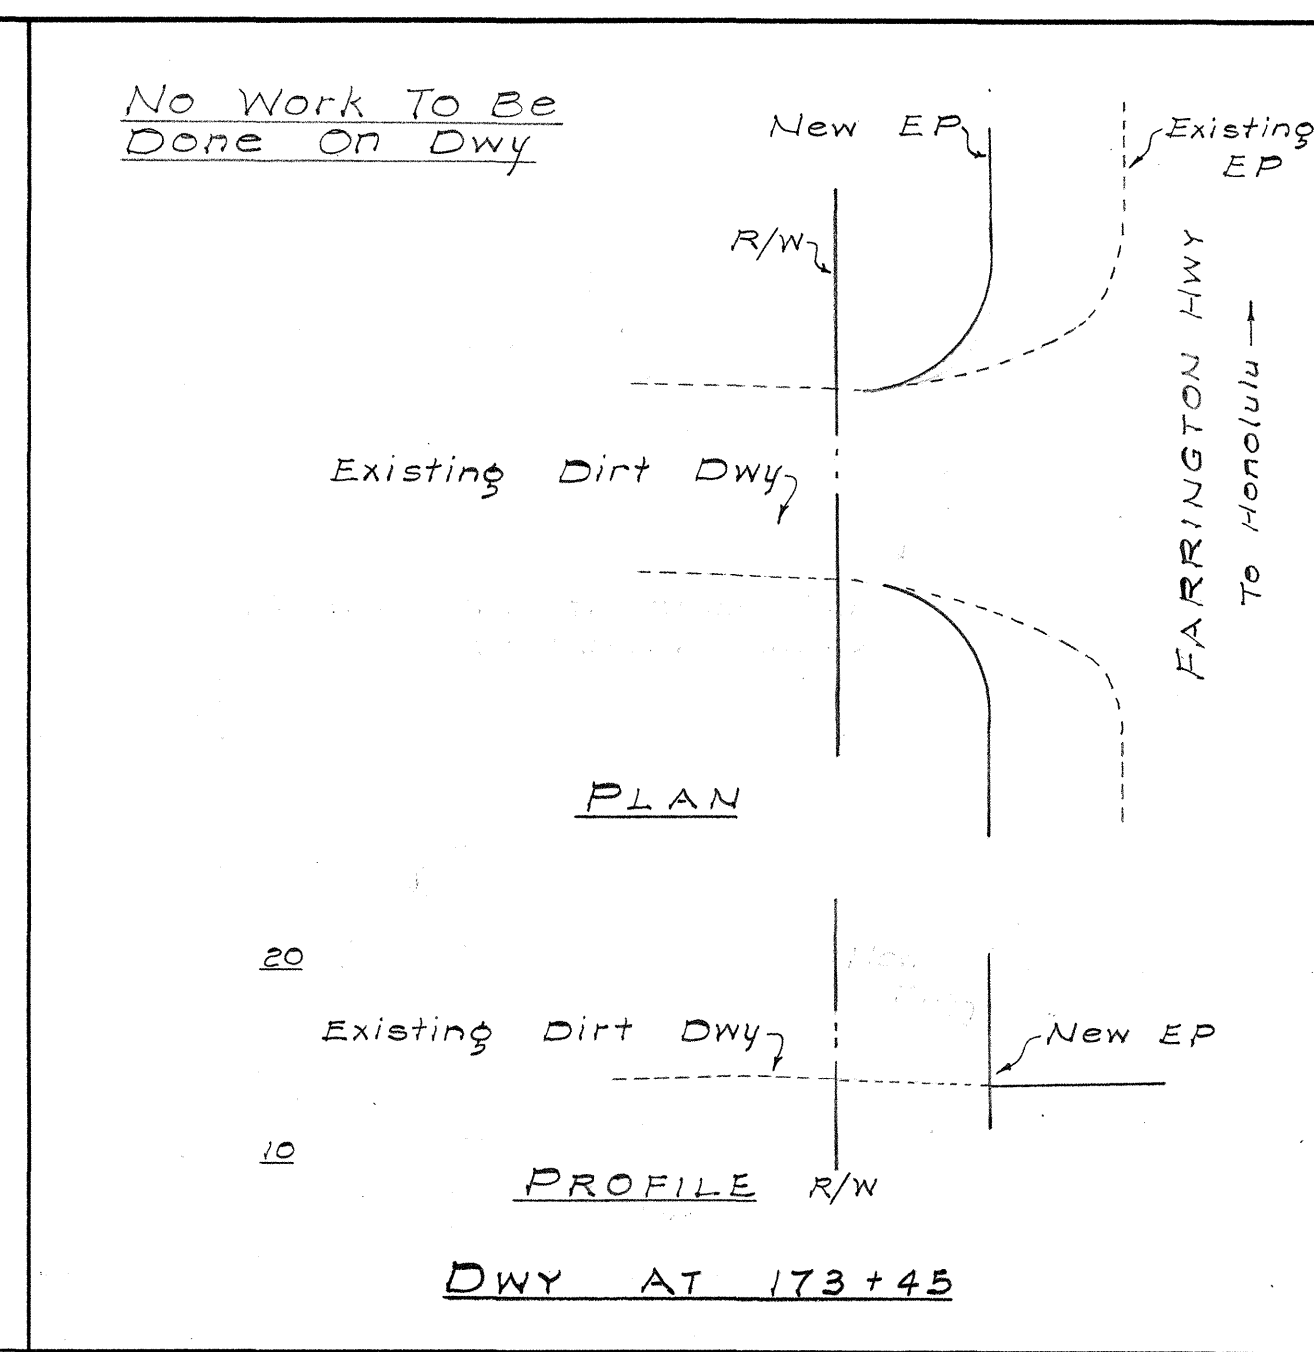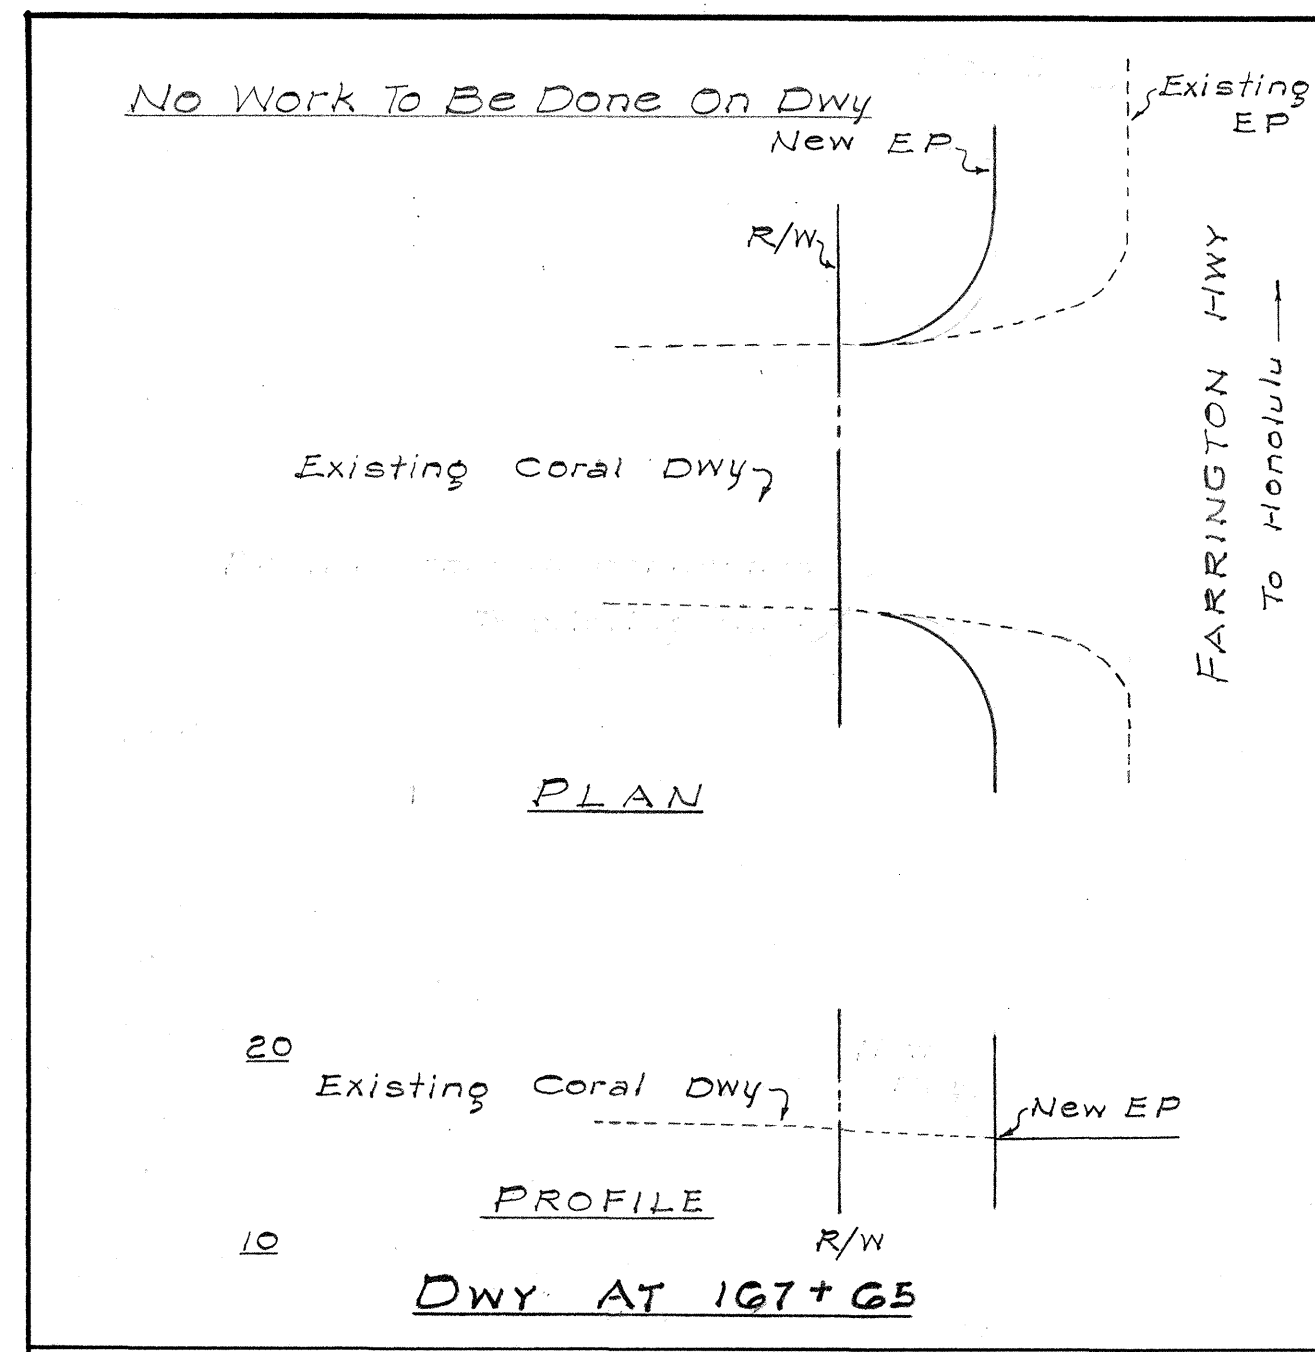

- NOTE:
1. Driveway connections to be of same material as existing.
 2. A.C. Pavement, untreated base course, prime coat, tack coat, coral select borrow w/MC 800 excavation for driveways will be paid for under respective roadway items.
 3. MC 800 shall be bituminous seal coat for shoulders with crushed rock.

STATE OF HAWAII
DEPARTMENT OF TRANSPORTATION
HIGHWAYS DIVISION

DRIVEWAY DETAILS




FARRINGTON HIGHWAY WIDENING
PROJECT B-900-01-64
UNIT II

SCALE: Hor: 1"=10'
Vert: 1"=10'

SHEET No. 4 OF 5 SHEETS

STATE	FISCAL YEAR	SHEET NO.	TOTAL SHTS
HAWAII	1968	21	95

PROJECT NO. B-900-01-64 UNIT II

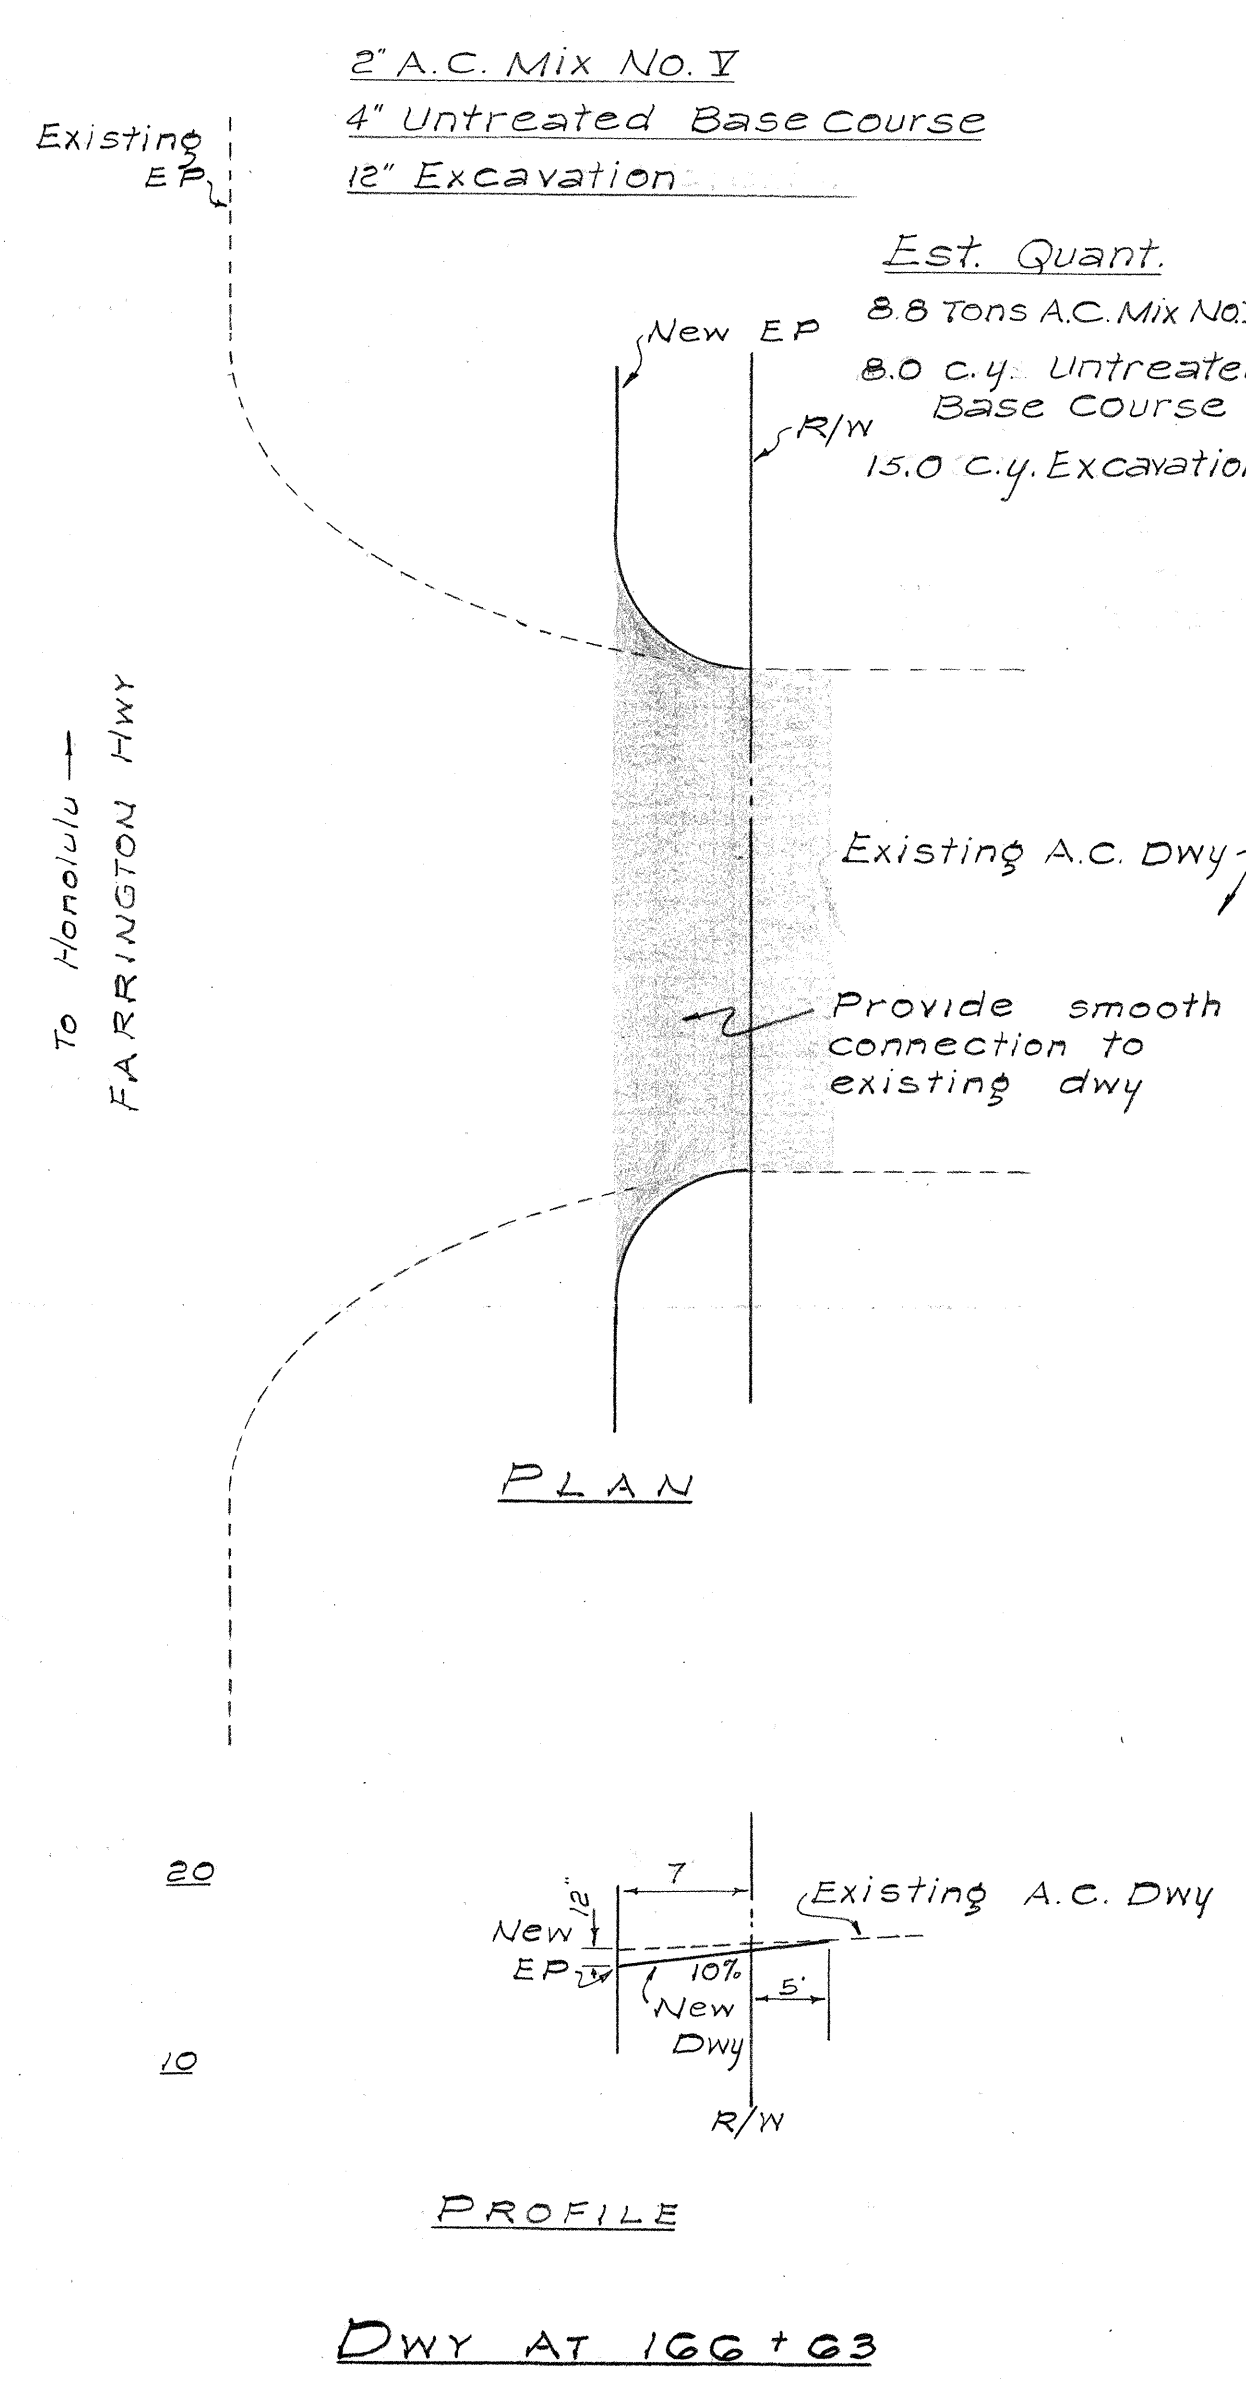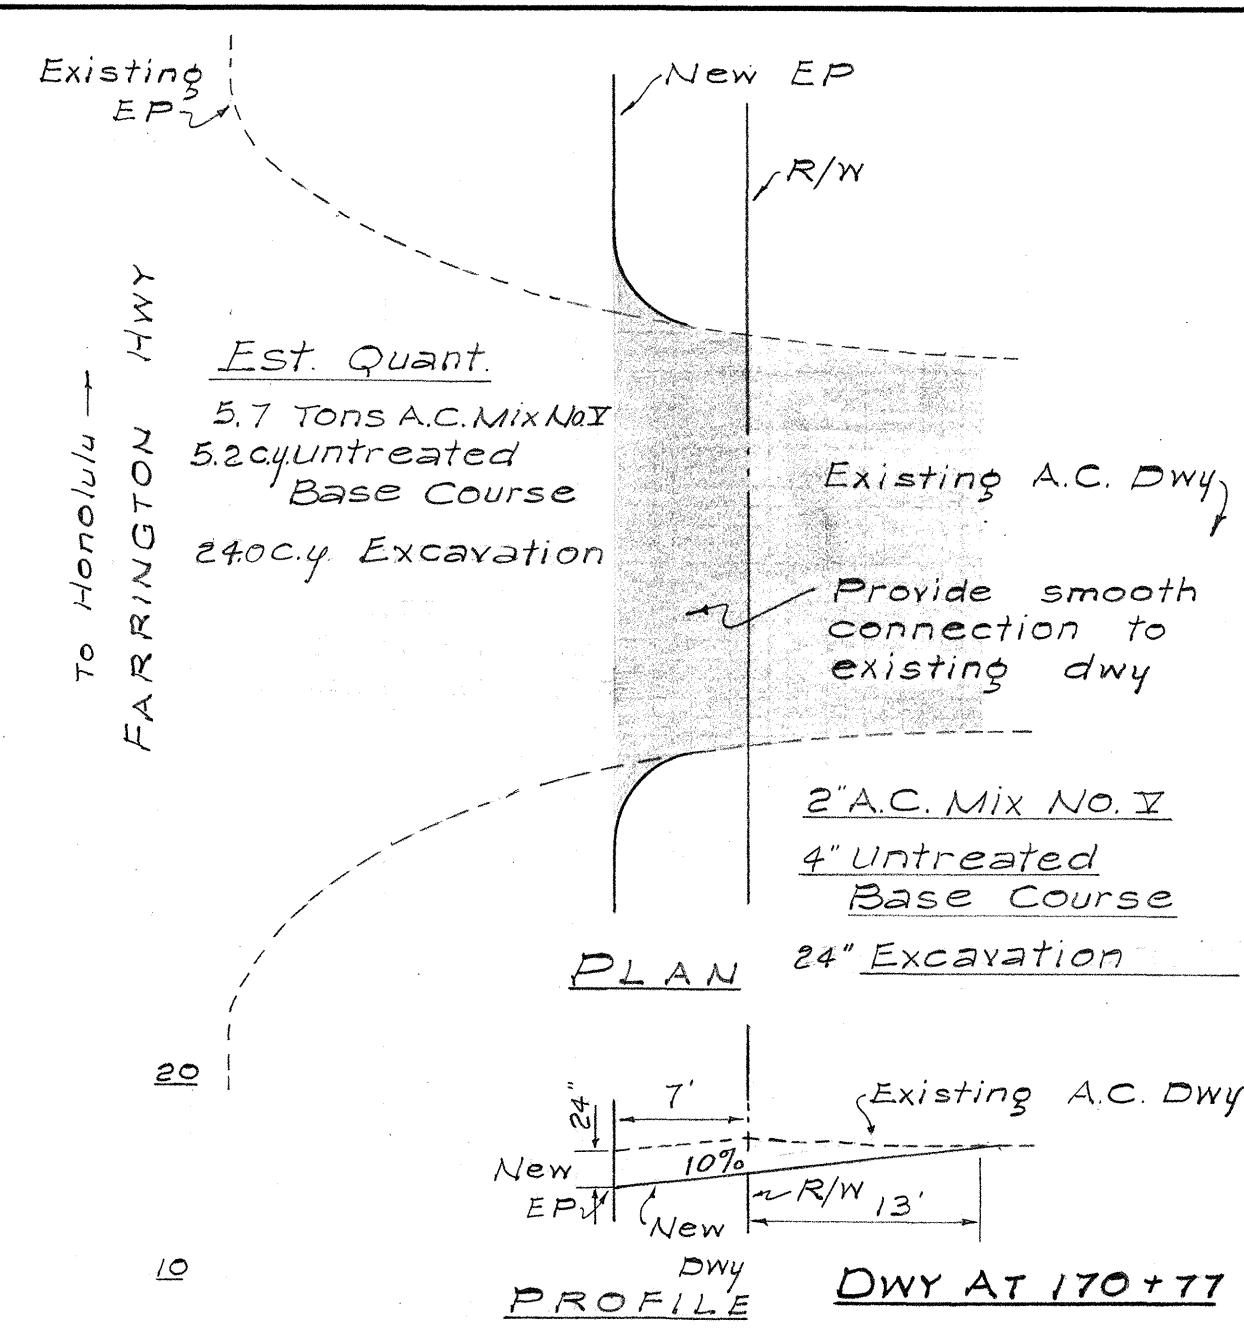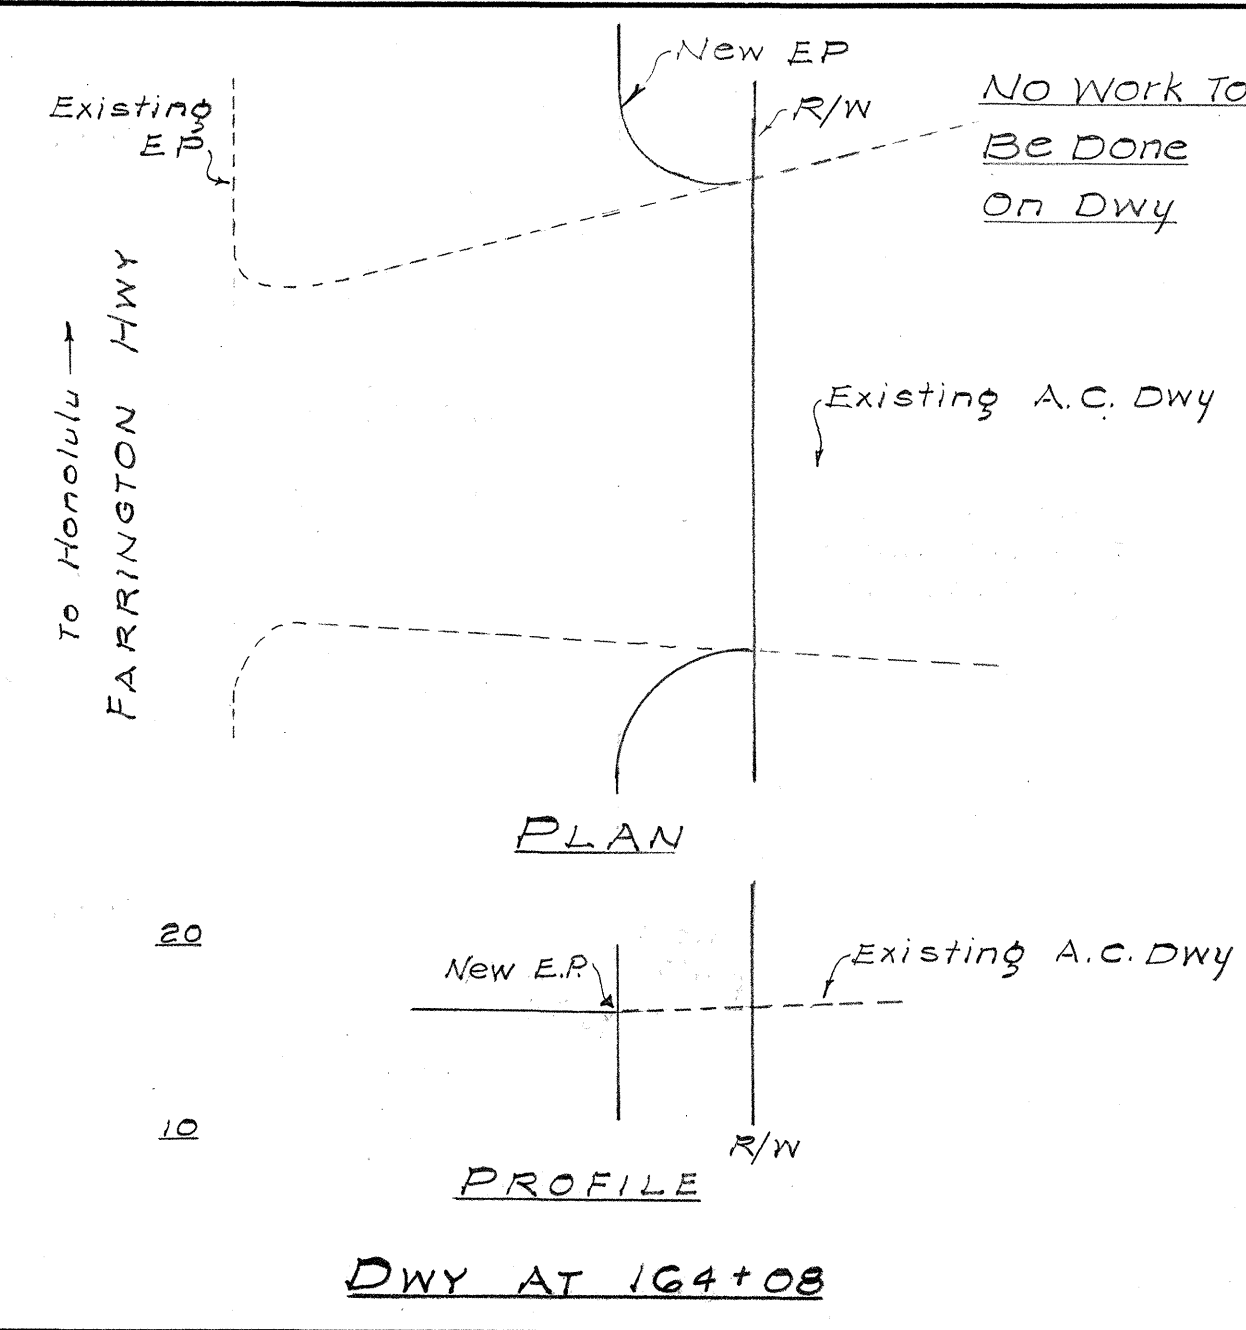

NOTE:

1. Driveway connections to be of same material as existing.
2. A.C. pavements, untreated base course, prime coat, tack coat, coral select borrow w/ MC 800 and excavation for driveways will be paid for under respective roadway items.
3. MC800 shall be bituminous seal coat for shoulders with crushed rock.

STATE OF HAWAII
DEPARTMENT OF TRANSPORTATION
HIGHWAYS DIVISION

DRIVEWAY DETAILS

FARRINGTON HIGHWAY WIDENING
PROJECT B-900-01-64

Hor: 1"=10'
Scale: Vert: 1"=10'

UNIT II

SHEET No. 5 OF 5 SHEETS