


INDEX TO DRAWINGS		
SHEET NO.	DESCRIPTIONS	COMPOSITE NO.
1	TITLE SHEET	89
2-5	LOCATION PLAN	90-93
6-7	TYPICAL DETAILS	94-95

STATE OF HAWAII
DEPARTMENT OF TRANSPORTATION
HIGHWAYS DIVISION
HONOLULU, HAWAII

"AS BUILT"
PLANS FOR
INSTALLATION OF HIGHWAY LIGHTS
ON
FARRINGTON HIGHWAY
ON
NANAKULI AVENUE
TO
HAKIMO ROAD


PROJECT NO.
B-900-01-65

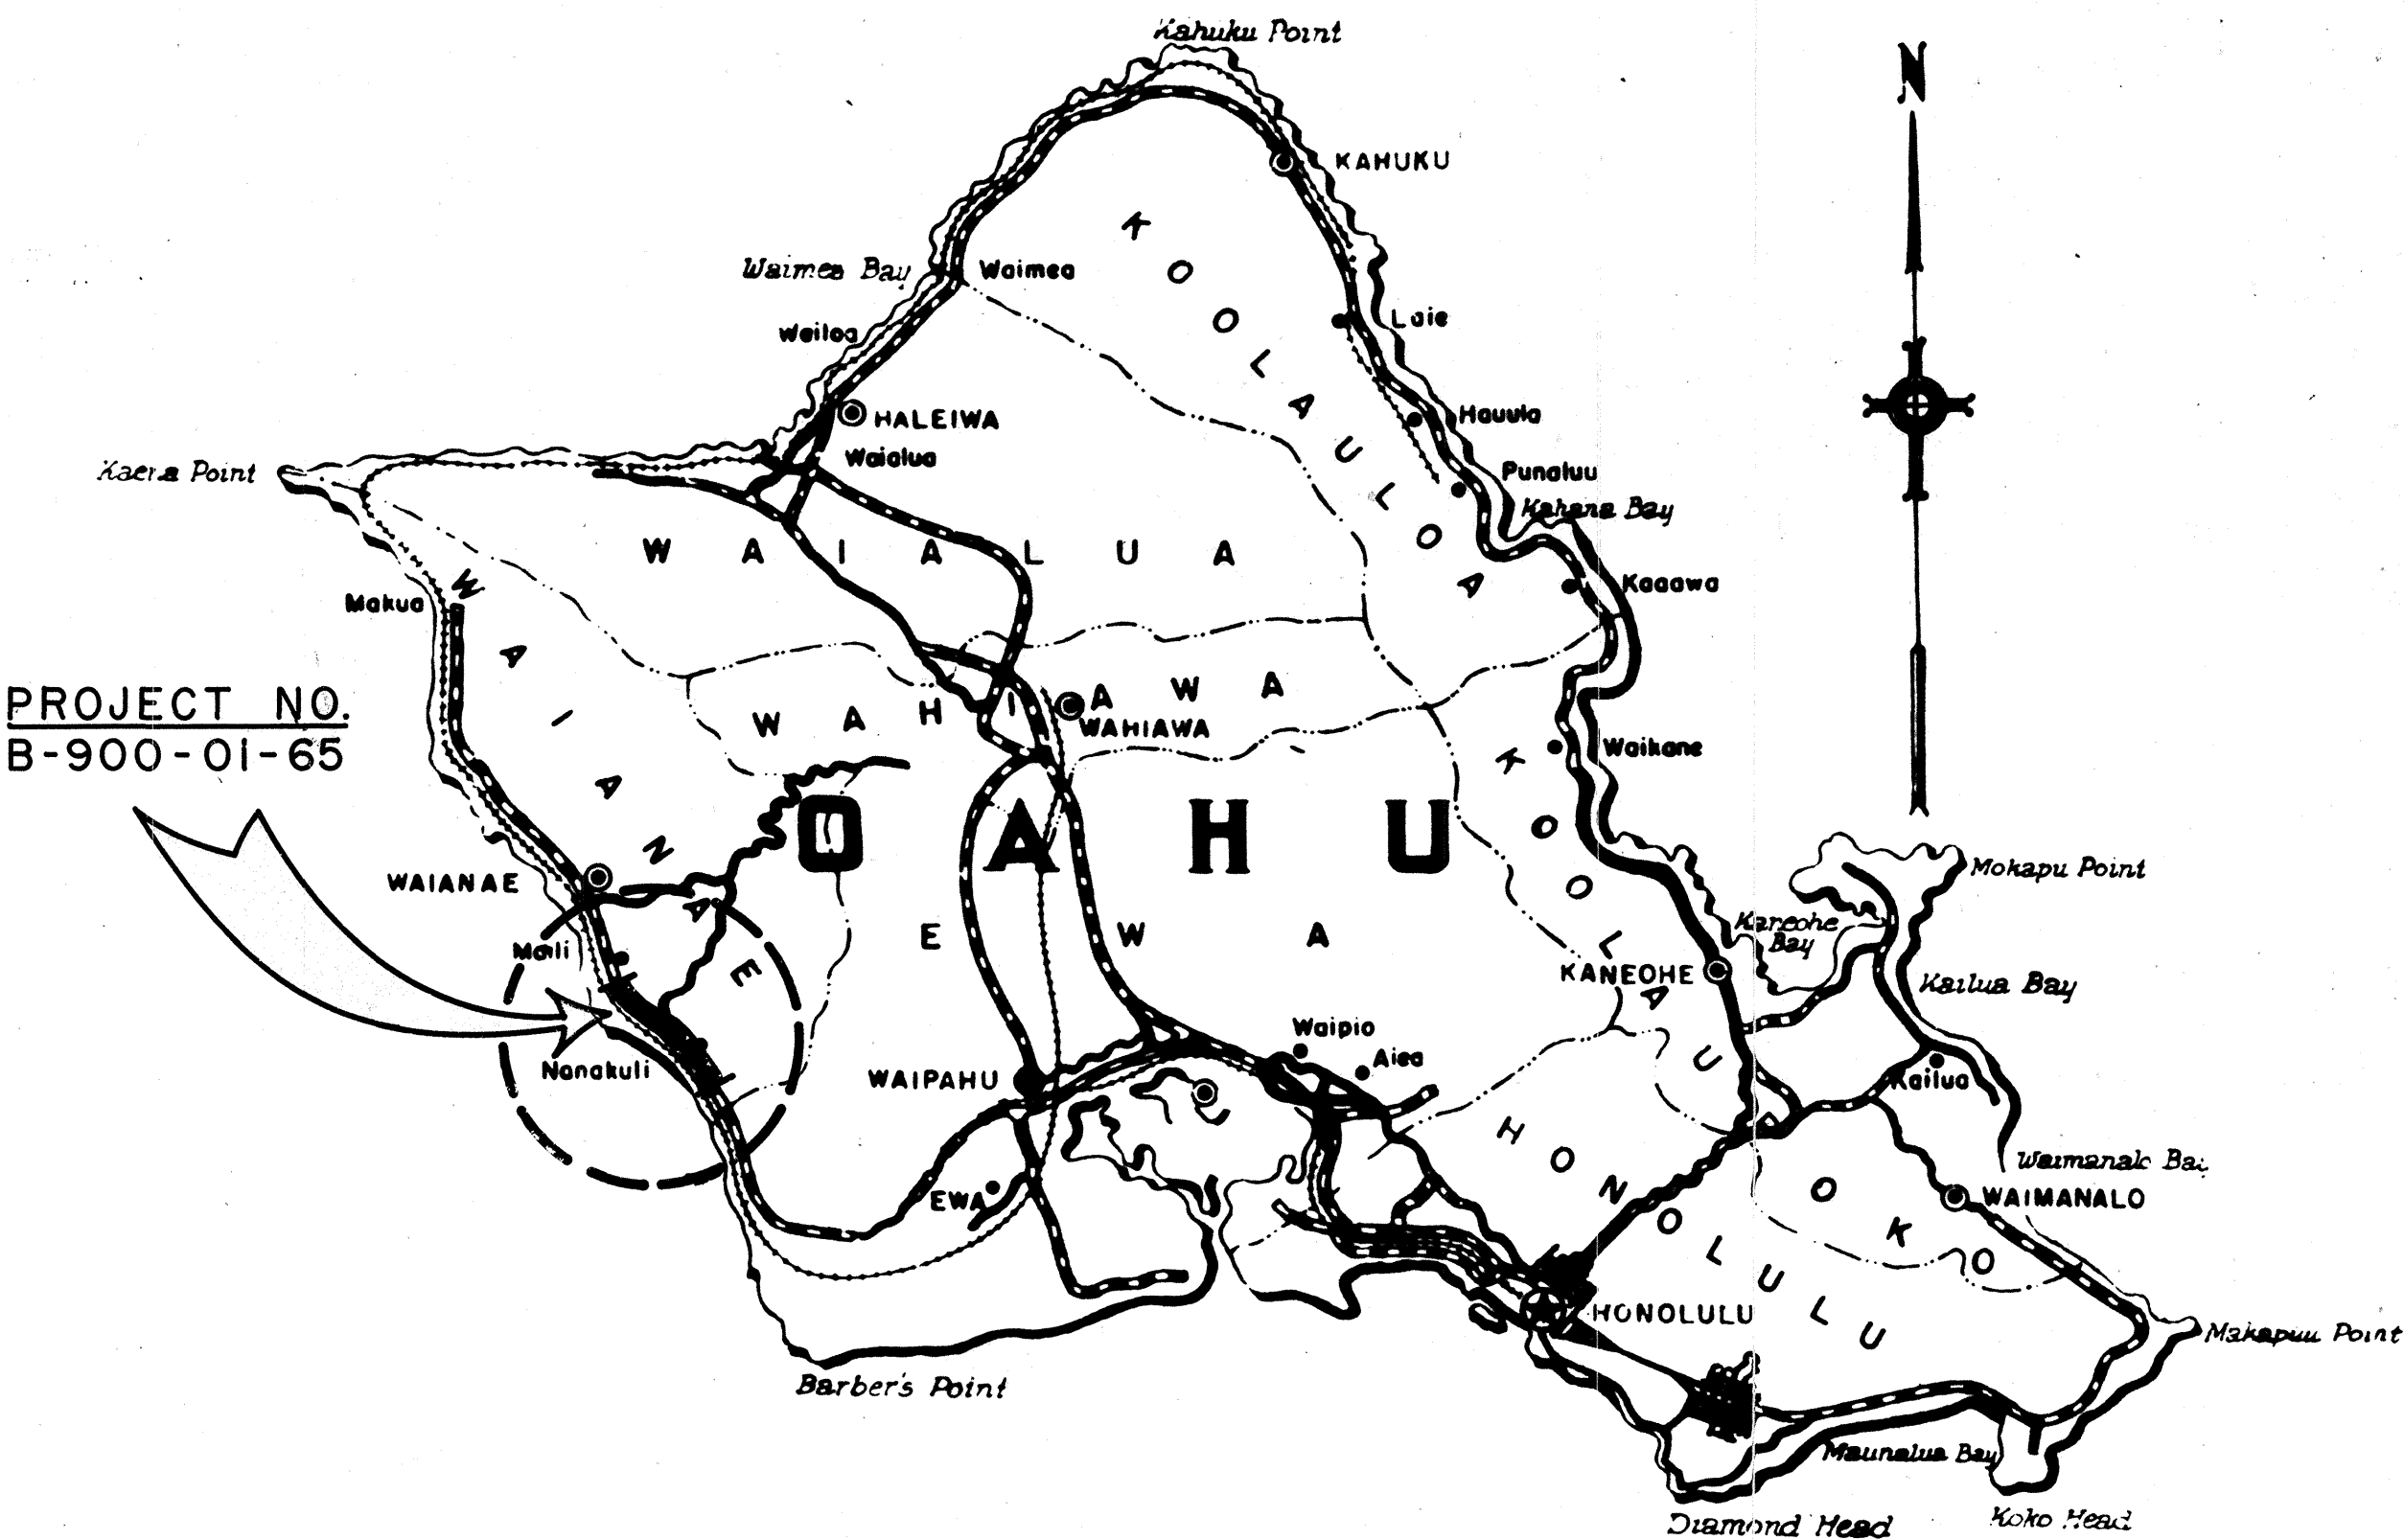

Federal Aid Projects Previously Constructed Or Under Construction

NOTE:
ALL CHANGES MADE DURING CONSTRUCTION HAVE
BEEN NOTED IN RED ON THESE TRACINGS AND
CHECKED BY

PROJECT ENGINEER _____ DATE _____


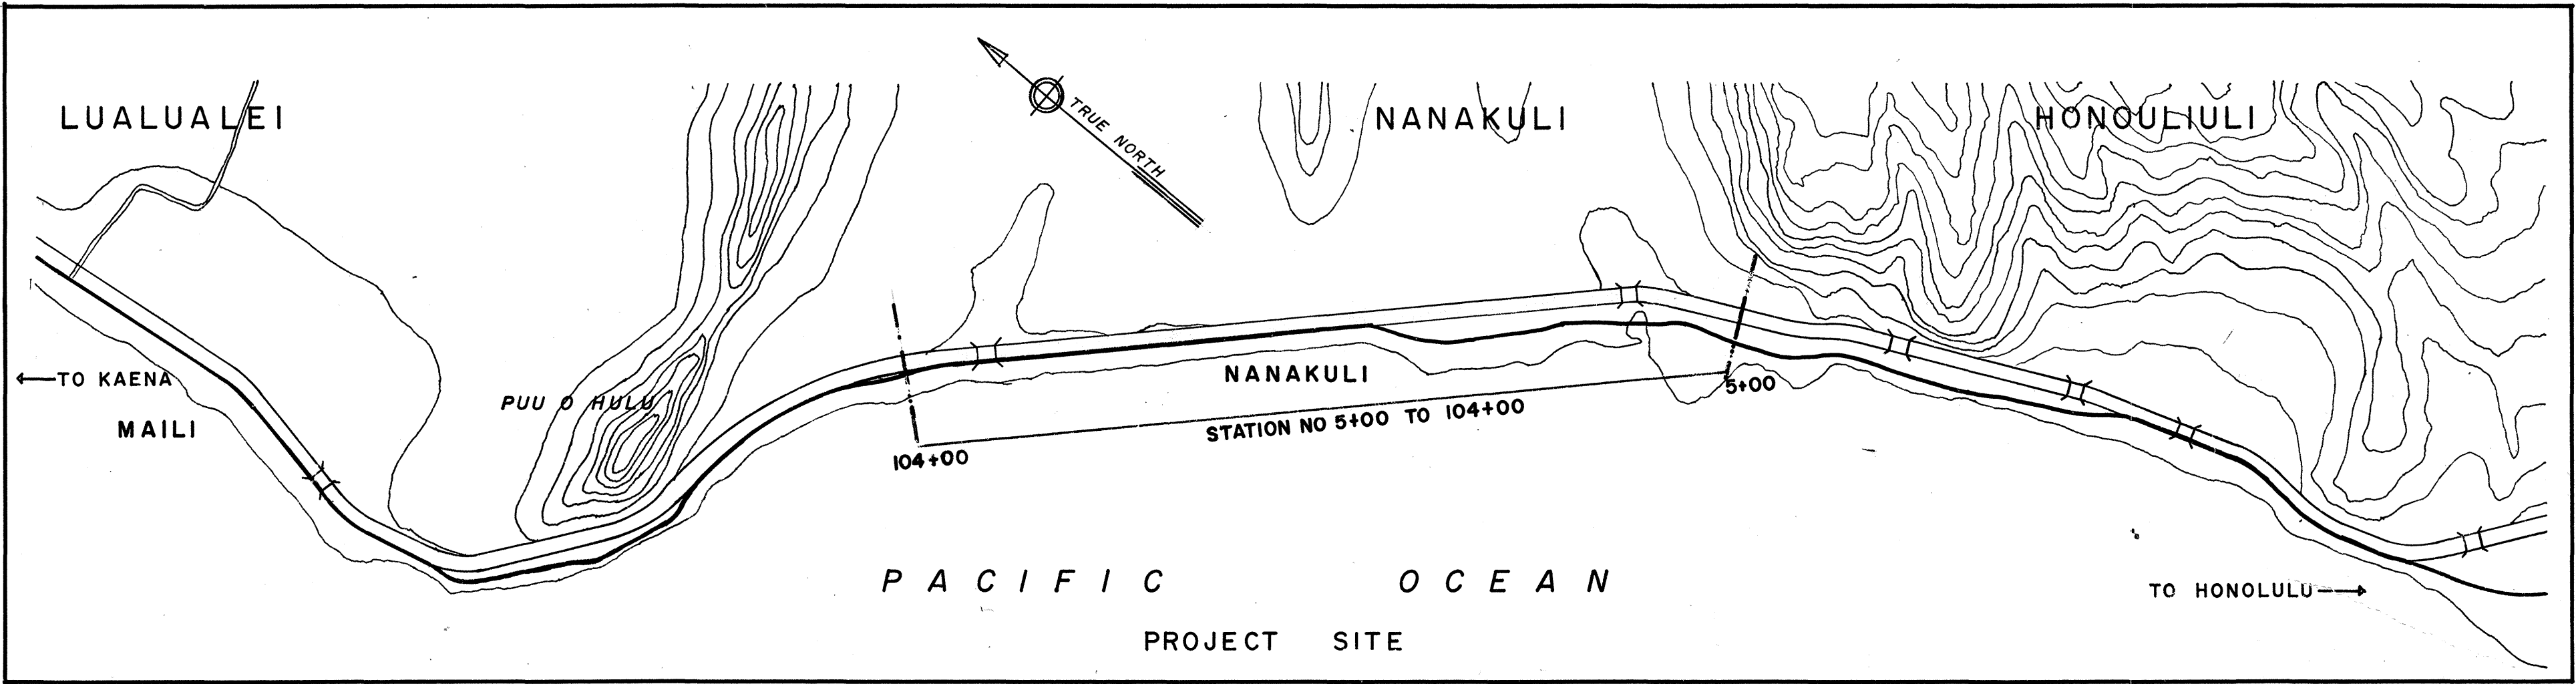


LAYOUT PLAN



APPROVED: _____ DATE 6/18/68

For DIRECTOR OF TRANSPORTATION

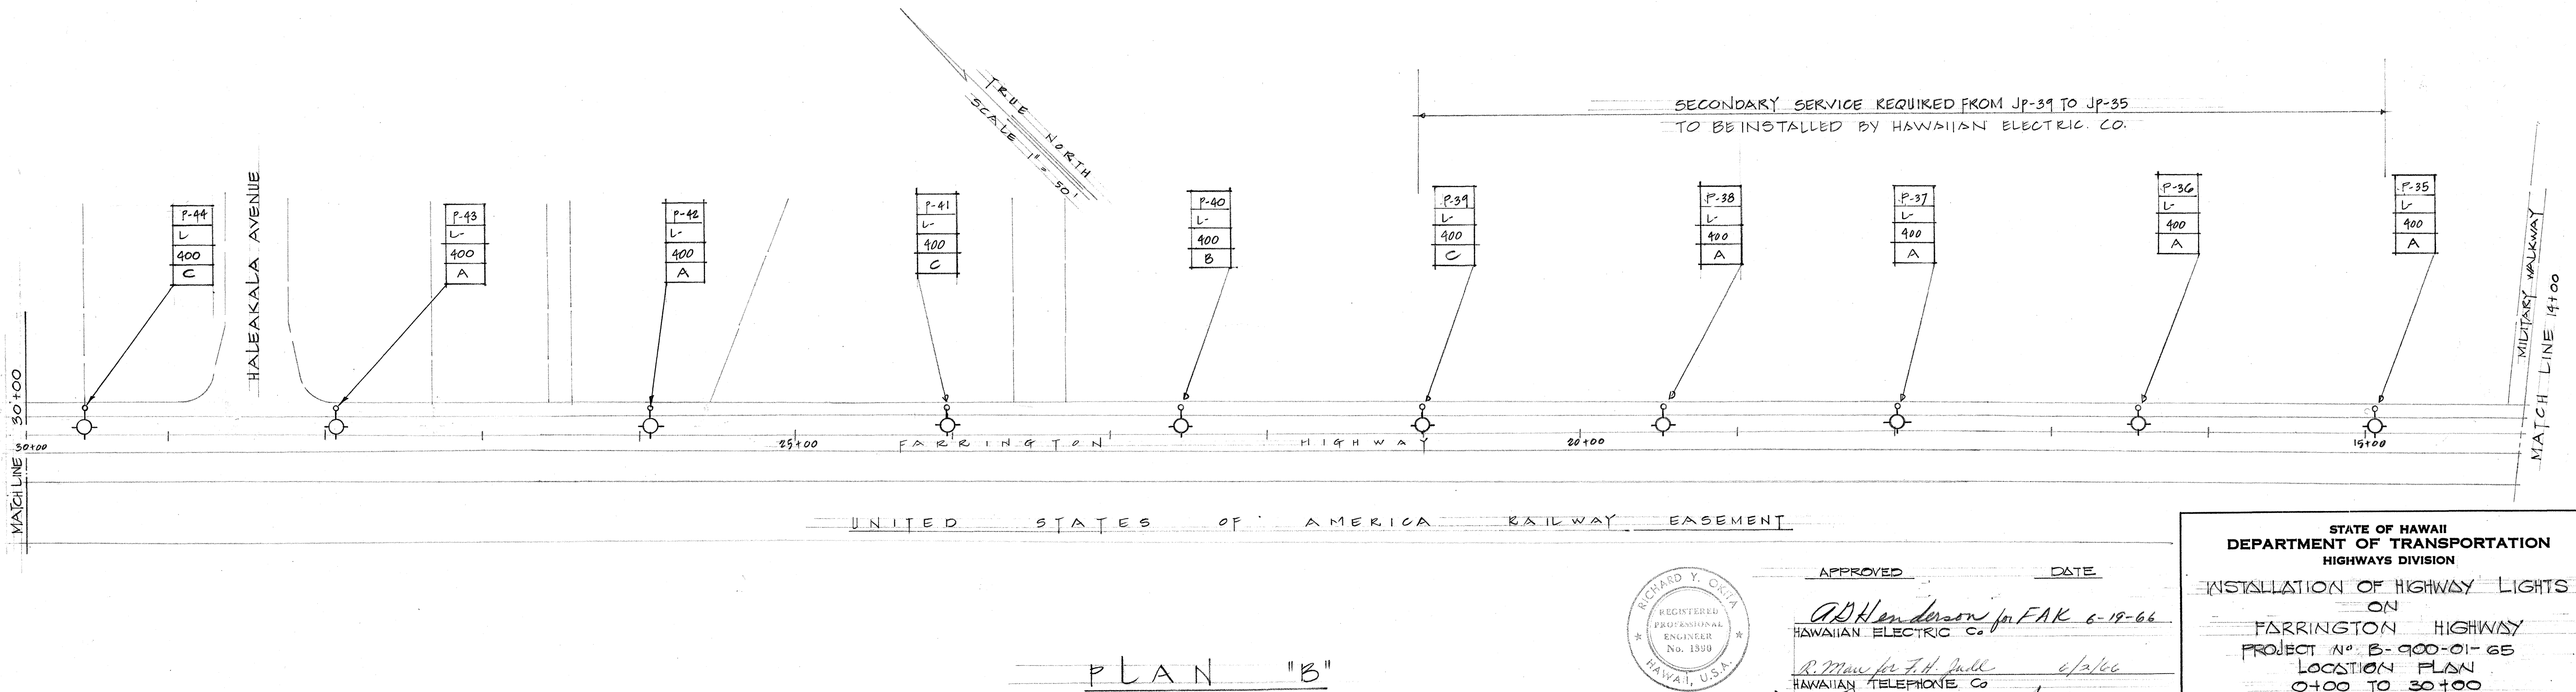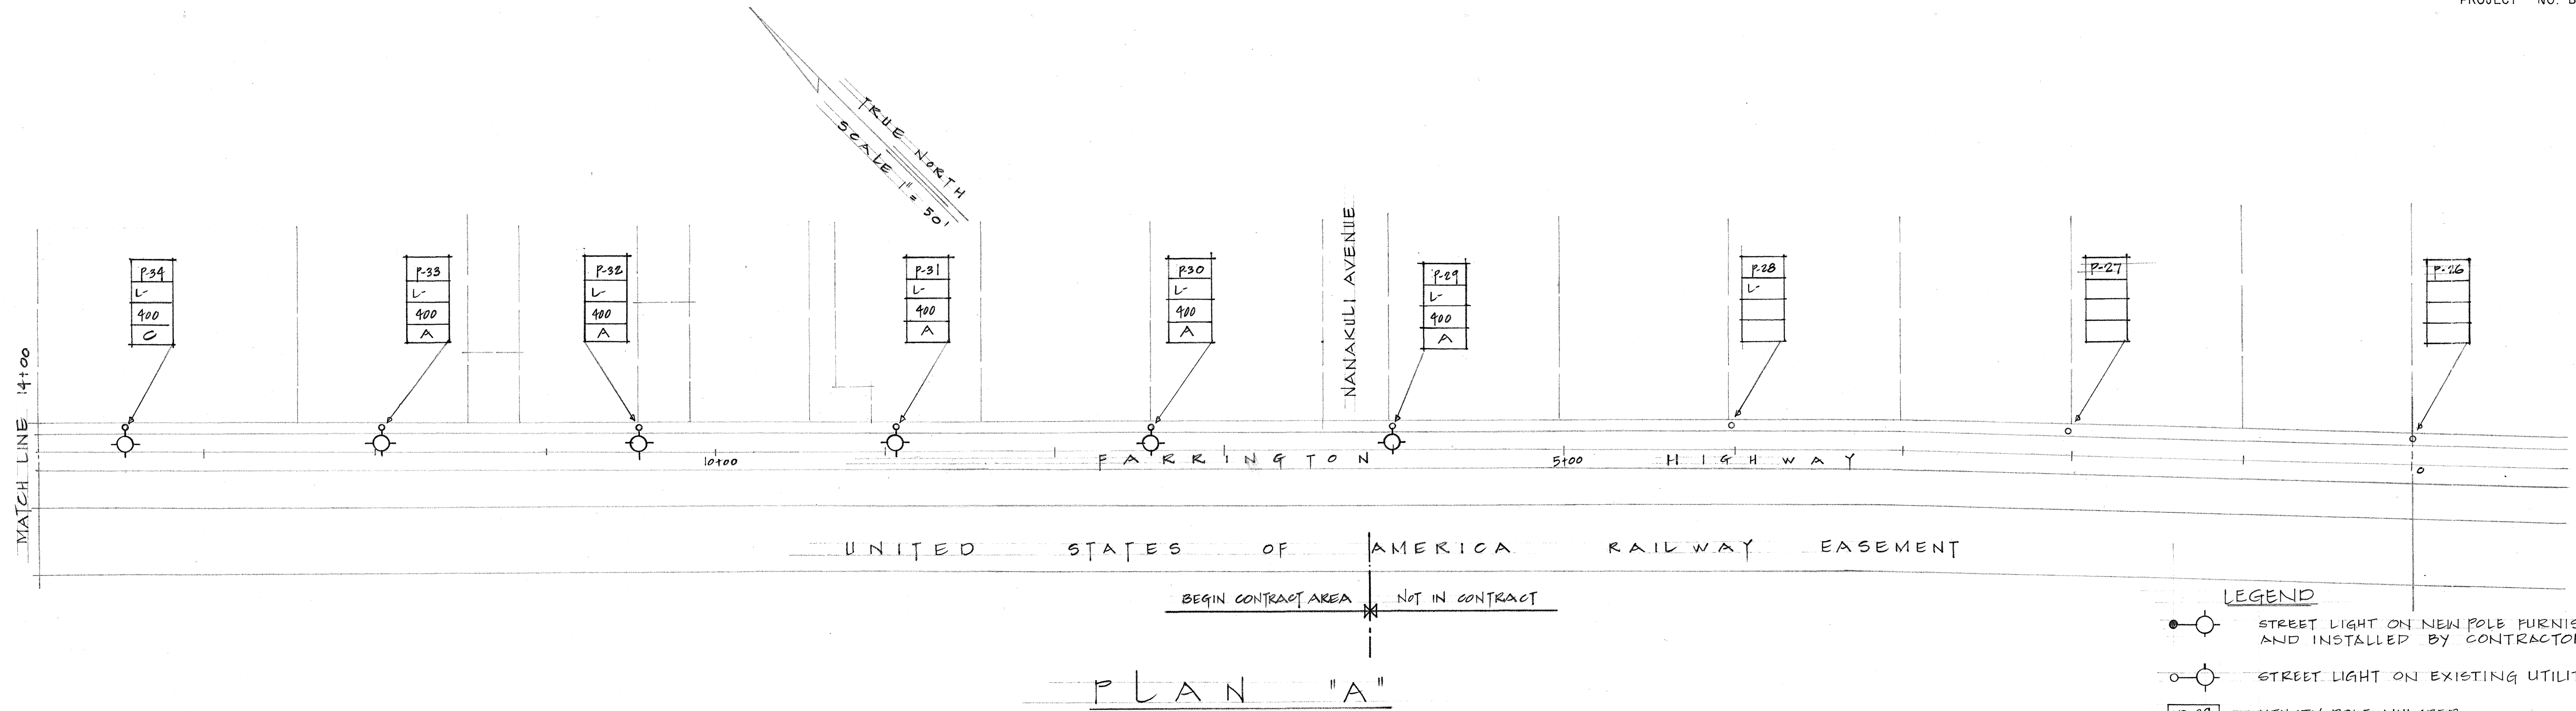


SURVEY PLOTTED BY	DATE
DRAWN BY	
TRACED BY	
QUANTITIES BY	
CHECKED BY	
ORIGINAL PLAN	
NOTE BOOK	
No.	




Richard Y. Ota
DEPUTY TRAFFIC ENGINEER
TRAFFIC DEPT., C&C OF HONOLULU

APPROVED DATE
AD Henderson for FAK 6-19-66
HAWAIIAN ELECTRIC CO.
R. Mau for F.H. Hall 6/2/66
HAWAIIAN TELEPHONE CO.
William C. Hong 6/2/66
DEPUTY TRAFFIC ENGINEER
TRAFFIC DEPT., C&C OF HONOLULU

STATE OF HAWAII
DEPARTMENT OF TRANSPORTATION
HIGHWAYS DIVISION
INSTALLATION OF HIGHWAY LIGHTS
ON
FARRINGTON HIGHWAY
PROJECT NO. B-900-01-65
LOCATION PLAN
0+00 TO 30+00

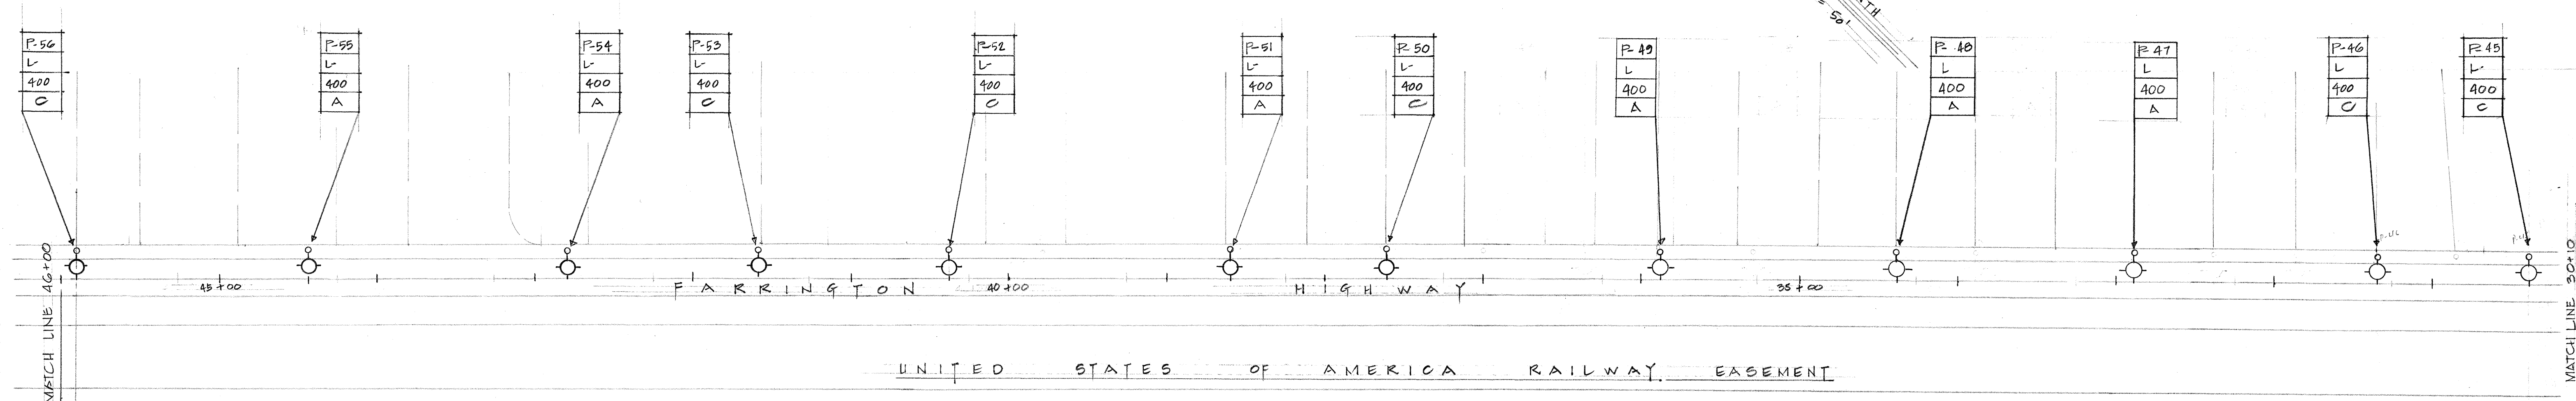


PLAN "C"

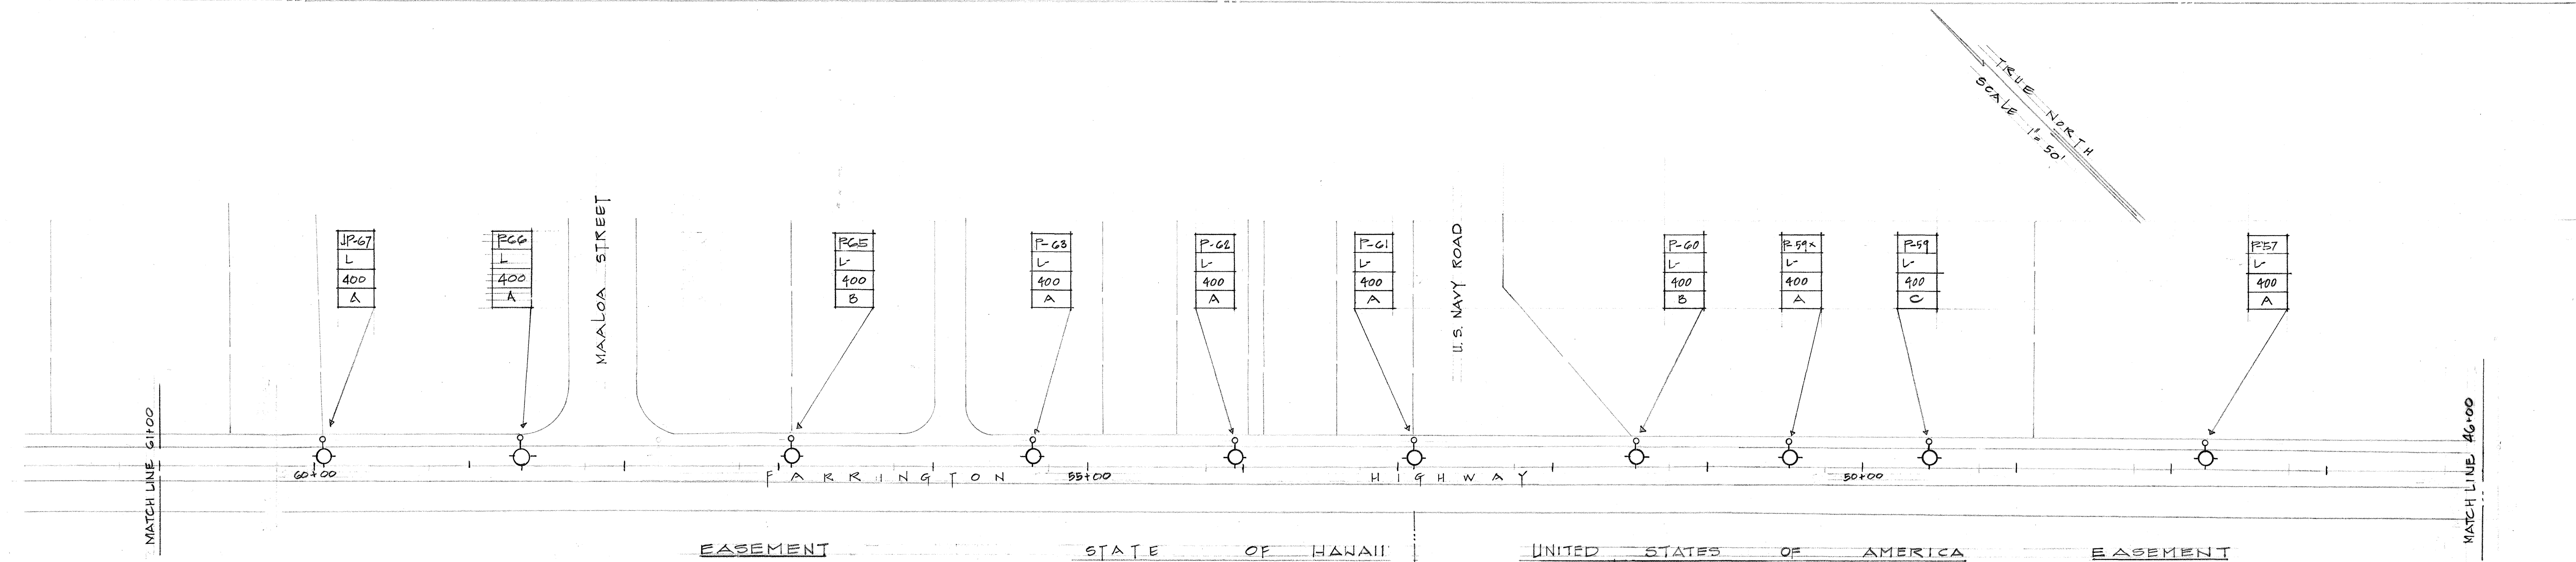


PLAN "D"

SURVEY PLOTTED BY _____ DATE _____
 DRAWN BY _____
 CHECKED BY _____
 NOTE BOOK _____
 No. _____

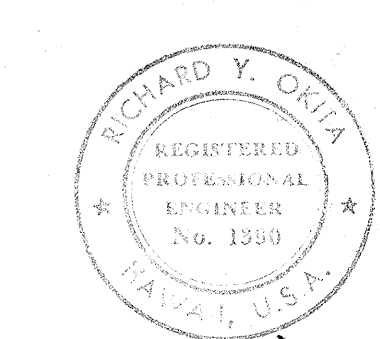


APPROVED _____ DATE _____
 W. Henderson for FAK 6-19-66
 HAWAIIAN ELECTRIC CO.
 R. Maw for F.H. Judd 6/2/66
 HAWAIIAN TELEPHONE CO.
 R. Ohta
 DEPUTY TRAFFIC ENGINEER
 TRAFFIC DEPT., C.C. OF HONOLULU

STATE OF HAWAII
 DEPARTMENT OF TRANSPORTATION
 HIGHWAYS DIVISION
 INSTALLATION OF HIGHWAY LIGHTS
 ON
 FARRINGTON HIGHWAY
 PROJECT NO. B-900-01-65
 LOCATION PLAN
 30+00 TO 61+00
 SHEET No. 3 OF 7 SHEETS

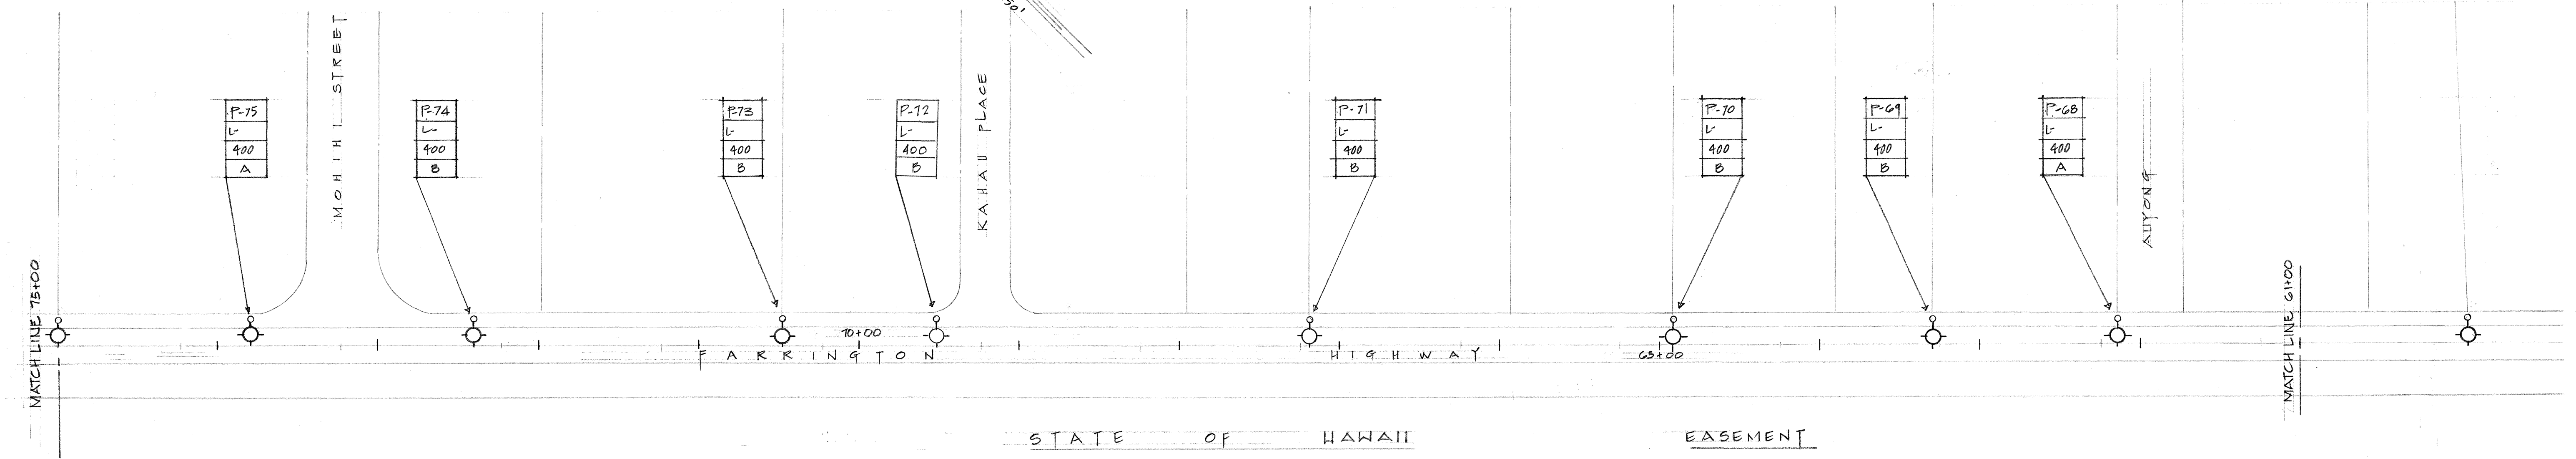


PLAN "E"

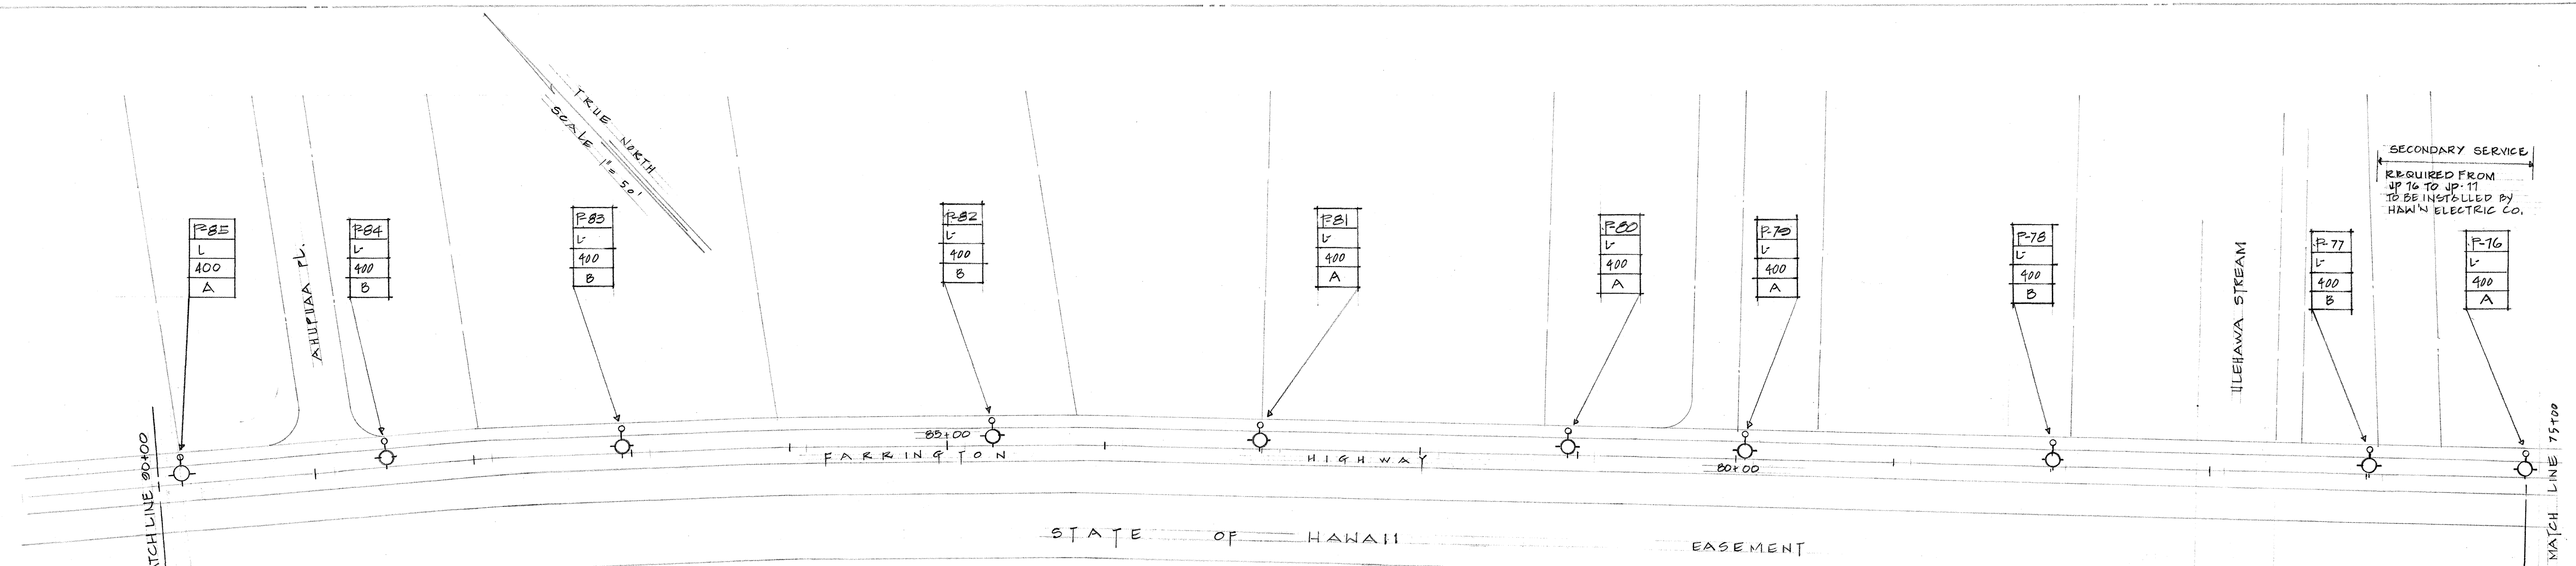

PLAN "F"

SURVEY PLANNED BY	DATE
DRAWN BY	
TRACED BY	
QUANTITIES BY	
CHECKED BY	
ORIGINAL PLAN	
NOTE BOOK	
No.	

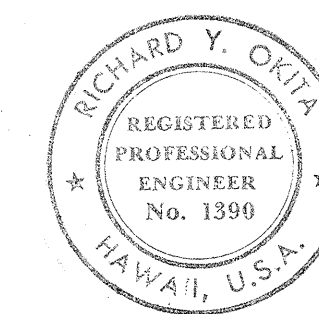


THIS WORK WAS PREPARED BY B. Ohta DEPUTY TRAFFIC ENGINEER
 ME OR UNDER MY SUPERVISION. HAWAIIAN TELEPHONE CO. TRAFFIC DEPT, CTO OF HONOLULU

APPROVED AD Henderson for FAR 6-19-66
HAWAIIAN ELECTRIC CO.
R. M. Maw for F. H. Mulla 6/2/66
HAWAIIAN TELEPHONE CO.
William C. Hony 6/2/66


STATE OF HAWAII DEPARTMENT OF TRANSPORTATION HIGHWAYS DIVISION
INSTALLATION OF HIGHWAY LIGHTS ON FARRINGTON HIGHWAY PROJECT No. B-900-01-65 LOCATION PLAN 81+00 TO 85+00
SHEET No. 4 OF 7 SHEETS

FED. ROAD DIST. NO.	STATE	FED. AID PROJ. NO.	FISCAL YEAR	SHEET NO.	TOTAL SHEETS
HAWAII	HAW.		1968	93	95

PROJECT NO. B-900-01-65

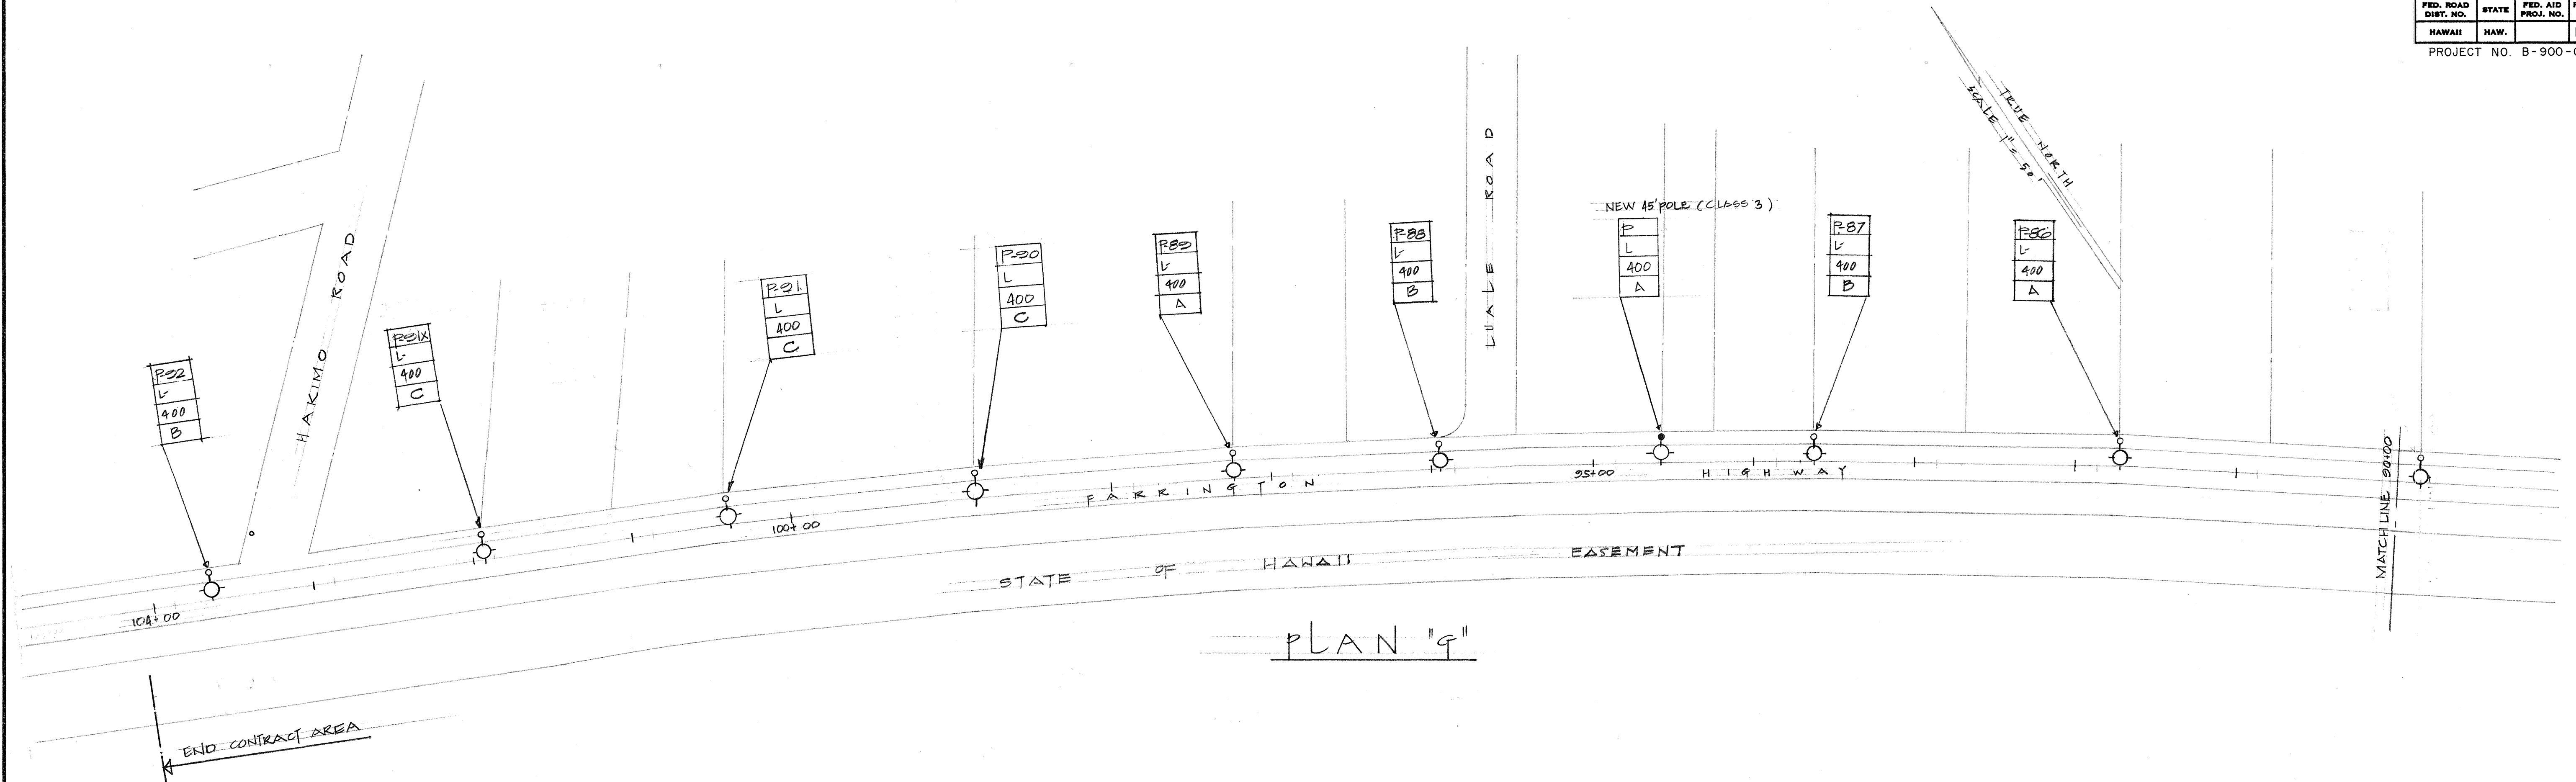

ORIGINAL PLAN	SURVEY PLOTTED BY	DATE
TRACED BY		
DESIGNED BY		
CHECKED BY		
NOTE BOOK		
No.		

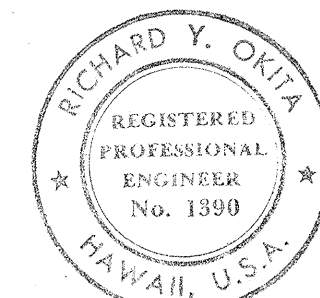


THIS WORK WAS PREPARED BY
ME OR UNDER MY SUPERVISION.

APPROVED _____ DATE _____
R. Henderson 6-19-66
 HAWAIIAN ELECTRIC CO.
R. Maw for F. H. Ruddle 6/2/66
 HAWAIIAN TELEPHONE CO.
William C. Heng 6/28/66
 DEPUTY TRAFFIC ENGINEER
 TRAFFIC DEPT. 3000 OF HONOLULU


STATE OF HAWAII
 DEPARTMENT OF TRANSPORTATION
 HIGHWAYS DIVISION
 INSTALLATION OF HIGHWAY LIGHTS
 ON
 FARRINGTON HIGHWAY
 PROJECT NO. B-900-01-65
 LOCATION PLAN
 90+00 TO 104+00
 SHEET No. 5 OF 7 SHEETS

FED. ROAD DIST. NO.	STATE	FED. AID PROJ. NO.	FISCAL YEAR	SHEET NO.	TOTAL SHEETS
HAWAII	HAW.		1968	94	95


PROJECT NO. B-900-01-65

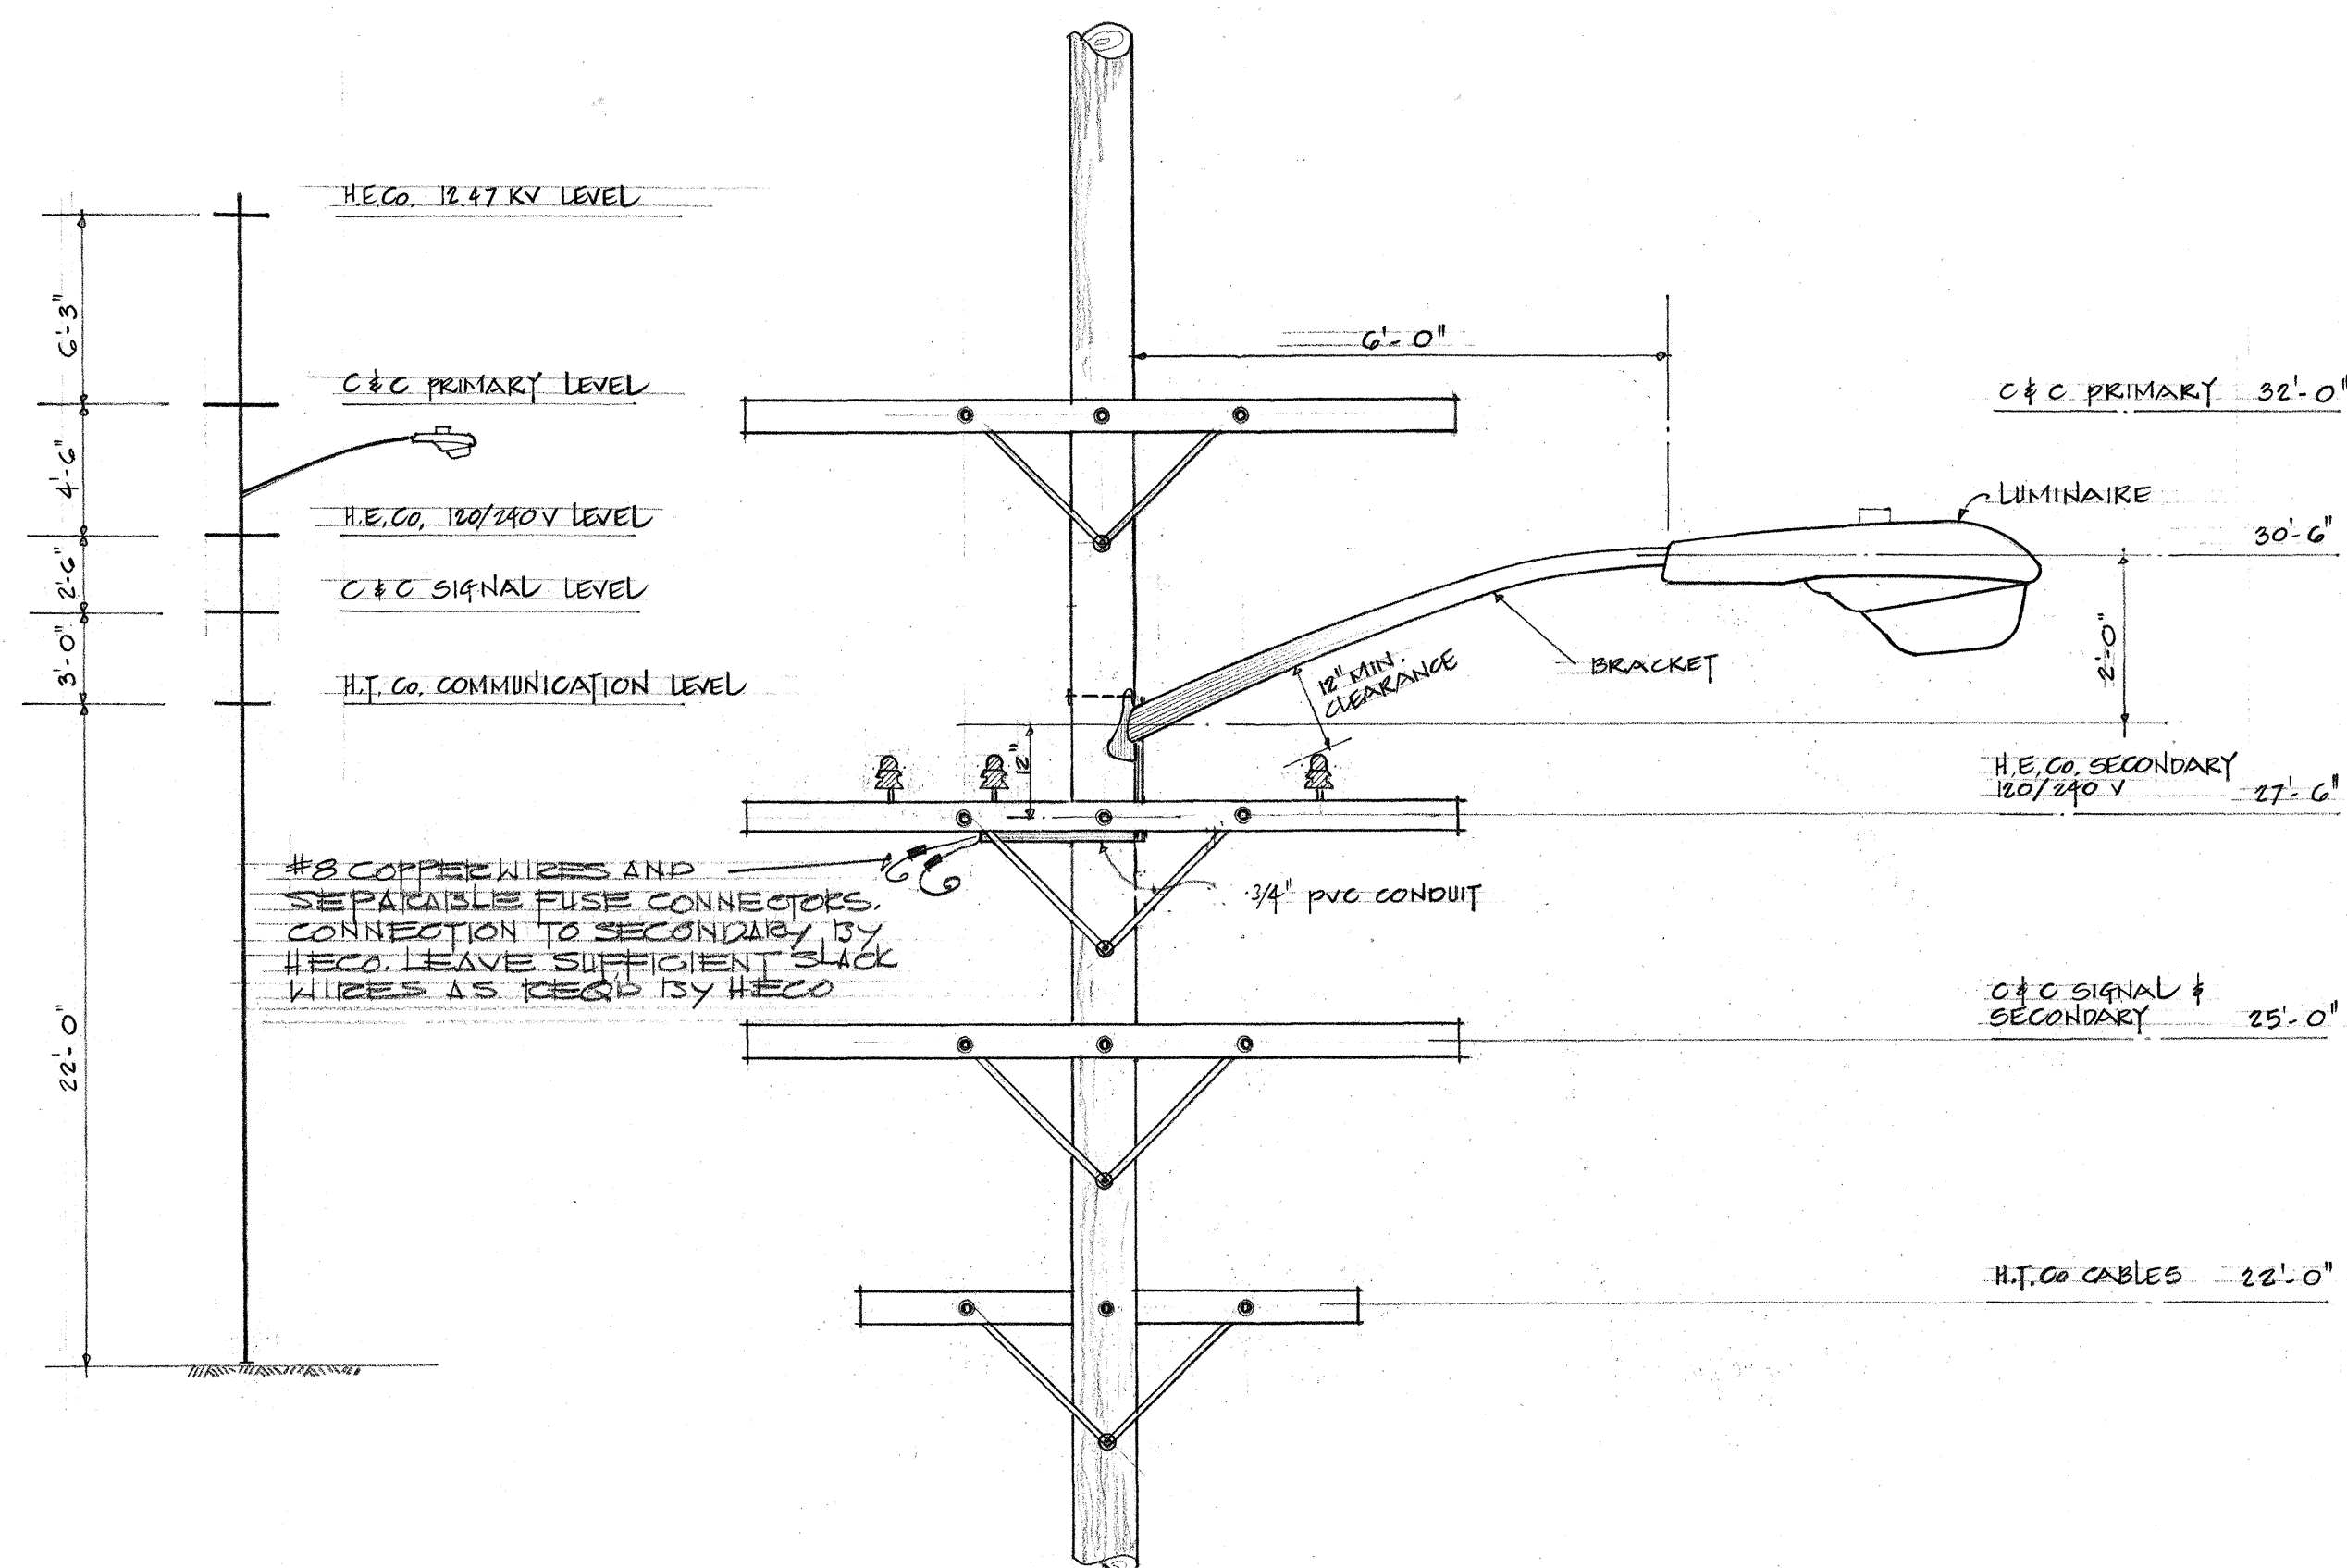

TYPE "A" 45' POLE & HIGHER

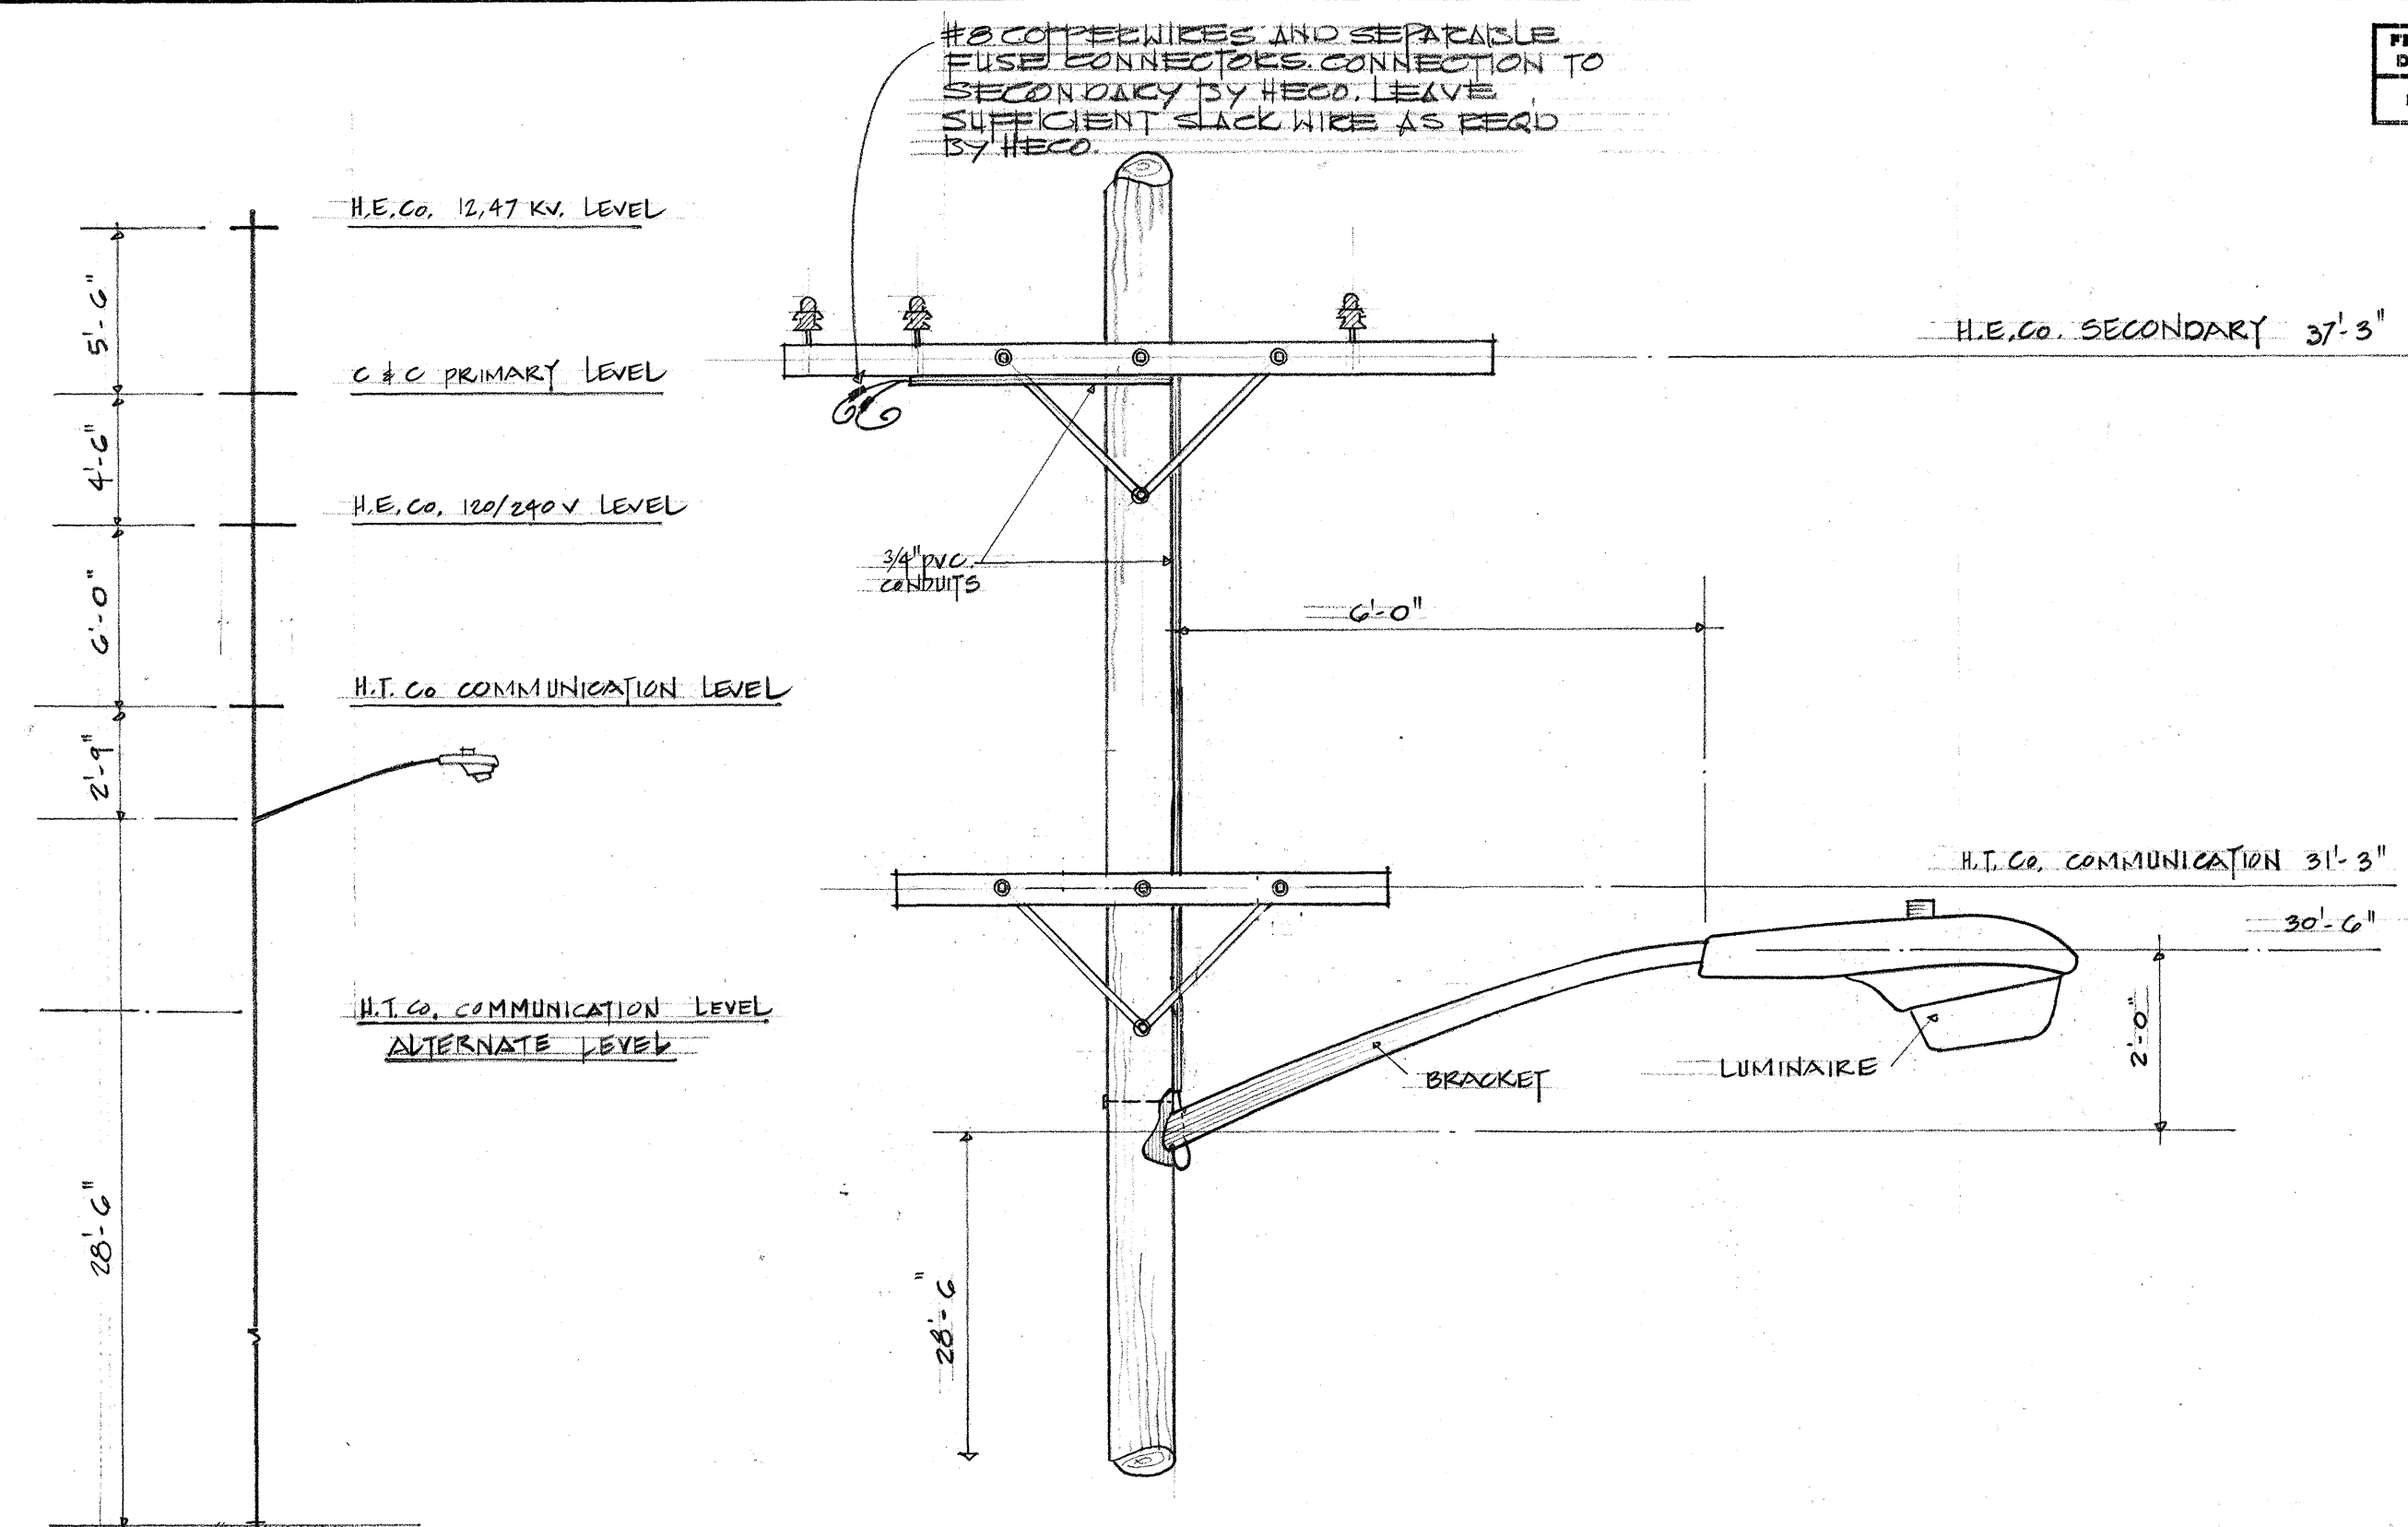


TYPE "C" 55' POLES (JP-44 & 45)

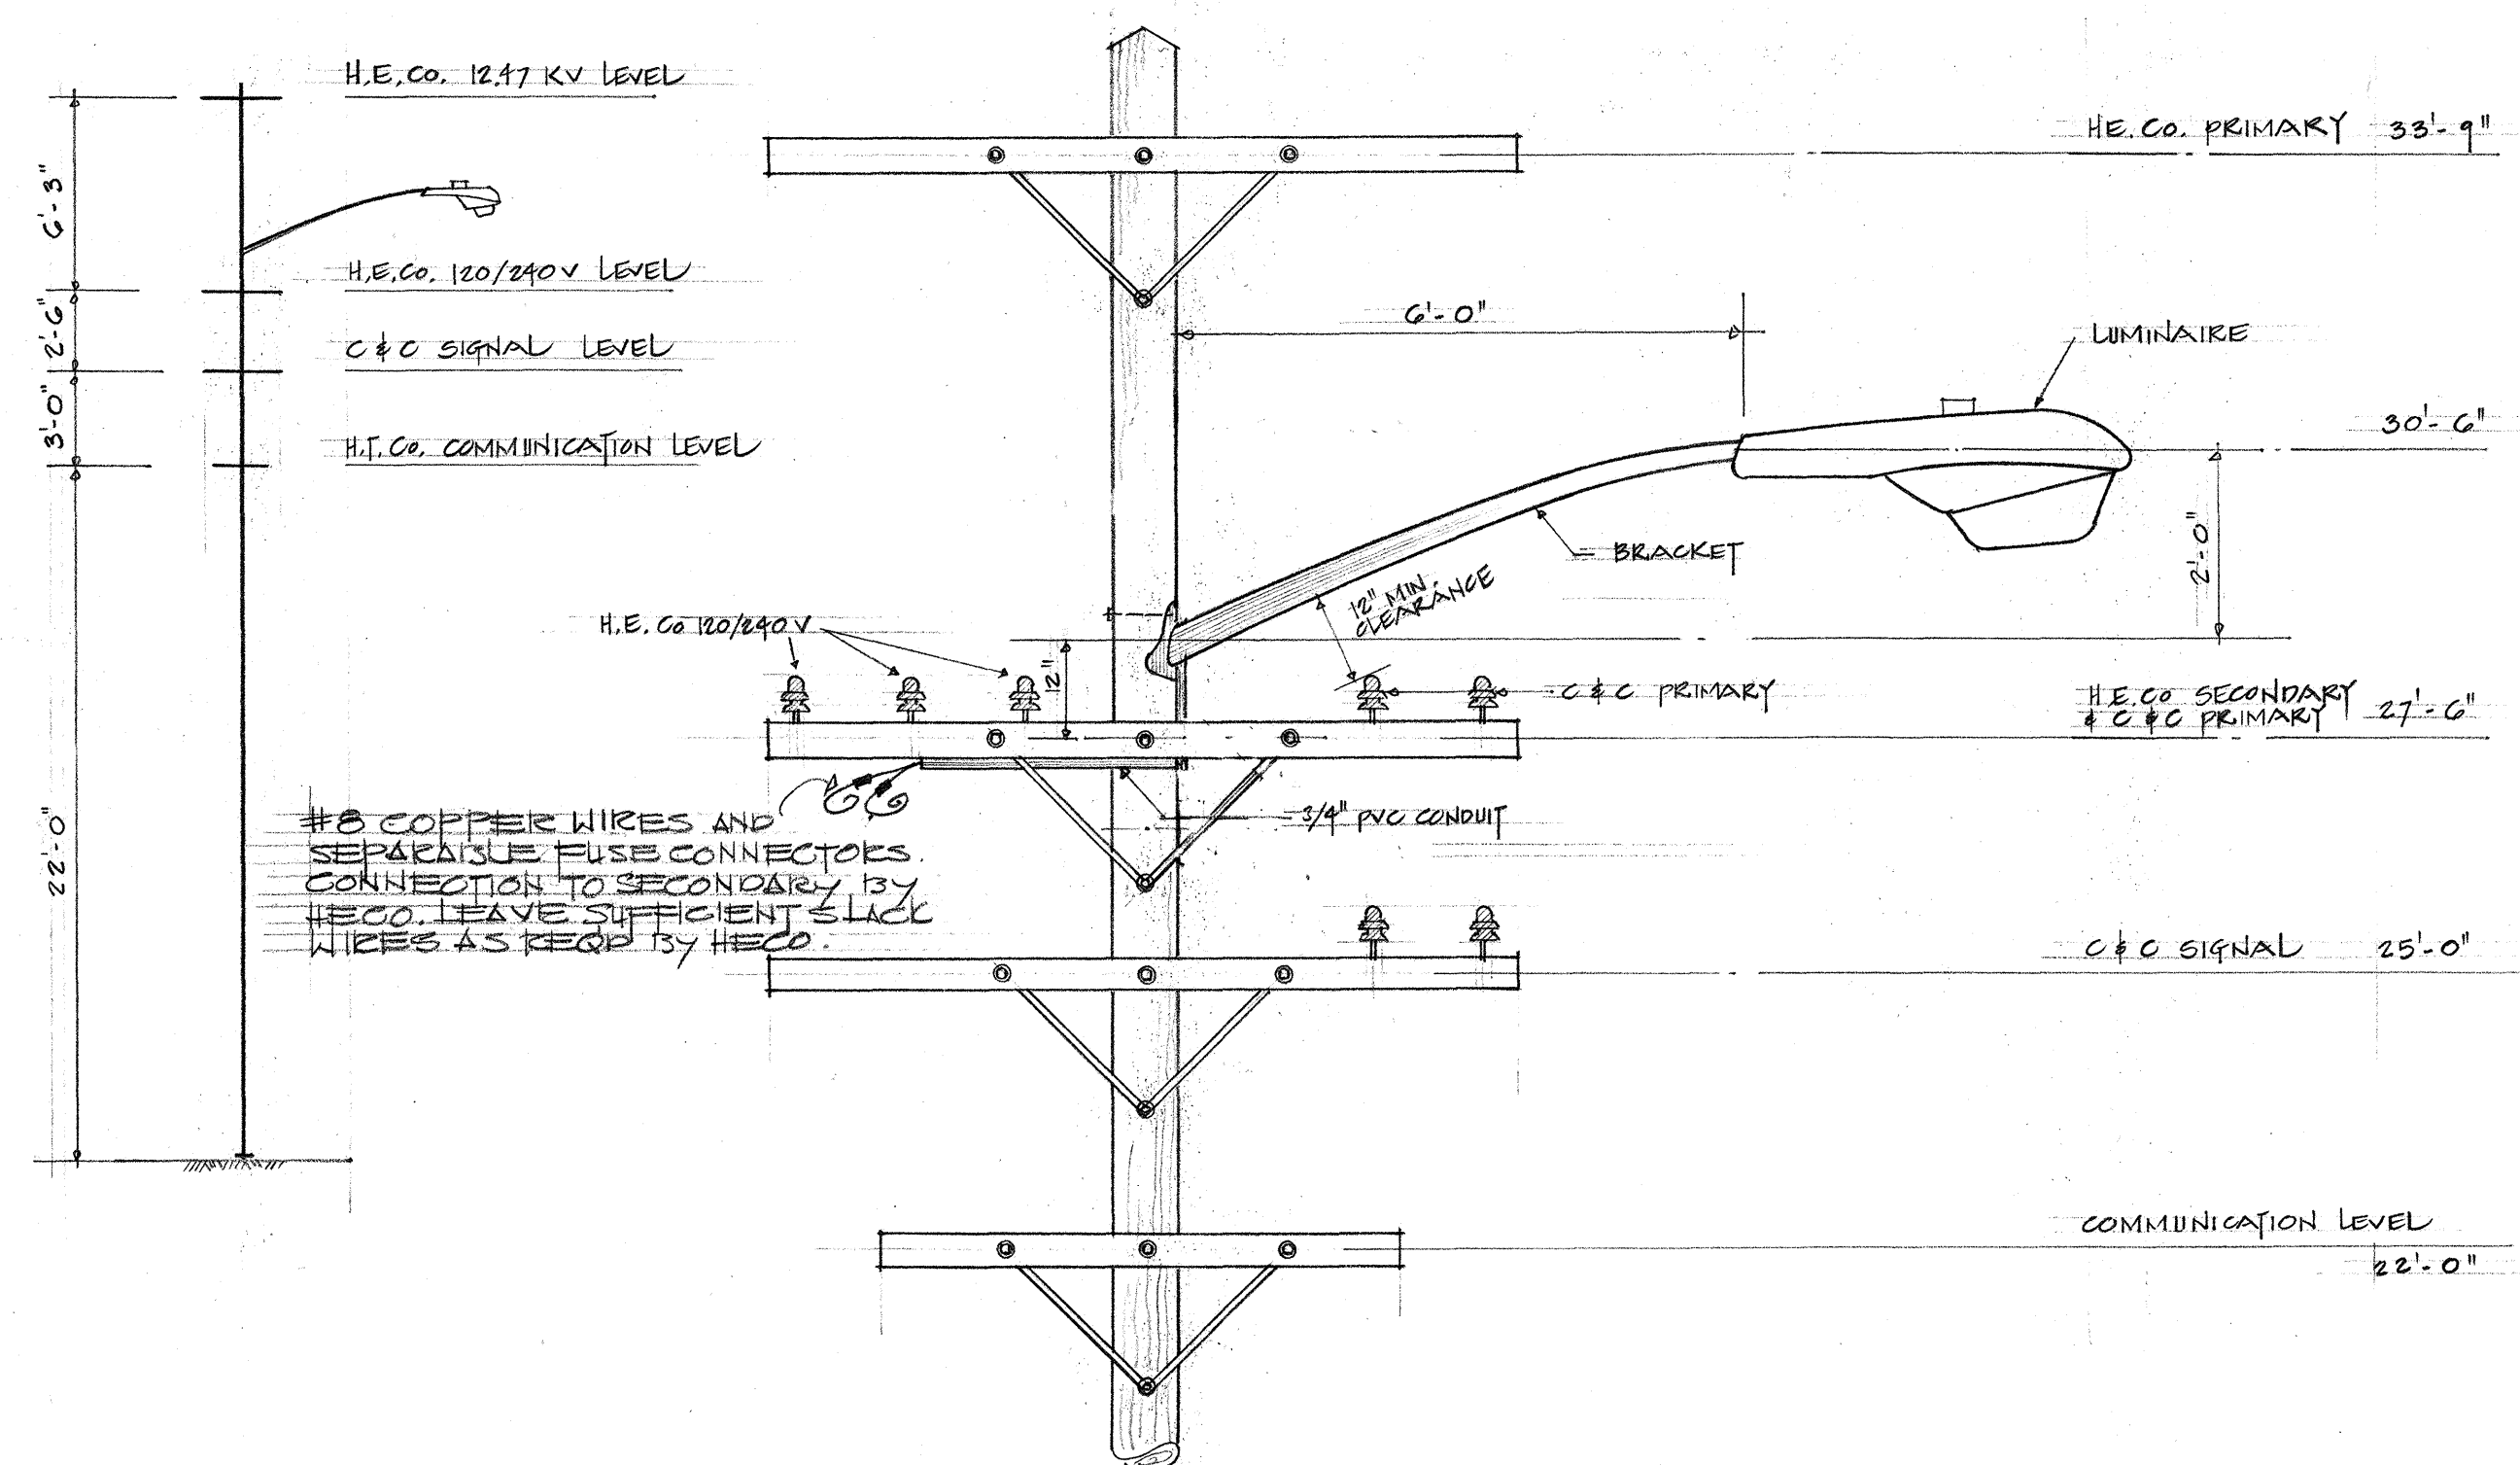

TYPE "B" 40' POLE

TYPICAL DETAILS

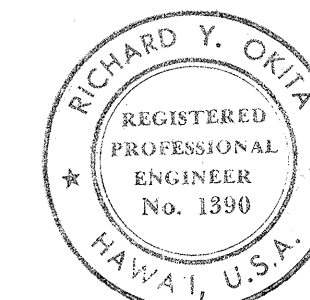

R. Ohta
THIS WORK WAS PREPARED BY
ME OR UNDER MY SUPERVISION.

APPROVED DATE
C. Henderson for FAR 6-18-66
HAWAIIAN ELECTRIC CO.
R. Man for F.H. Judd 6/2/66
HAWAIIAN TELEPHONE CO.
R. Ohta
DEPUTY TRAFFIC ENGINEER
TRAFFIC DEPT, C&C OF HONOLULU

STATE OF HAWAII
DEPARTMENT OF TRANSPORTATION
HIGHWAYS DIVISION
INSTALLATION OF HIGHWAY LIGHTS
ON
FAIRINGTON HIGHWAY
PROJECT NO. B-900-01-65
TYPICAL DETAILS

SHEET NO. 6 OF 7 SHEETS




(5) 941

DATE	
SURVEY PLOTTED BY	
PLAN	
DESIGNED BY	
NOTED BY	
CHECKED BY	
ORIGINAL	
PLAN	
DESIGNED BY	
NOTED BY	
CHECKED BY	
ORIGINAL	



NOTES

- ## TYPICAL DETAILS

SHEET No. 7 OF 7 SHEETS

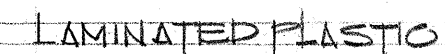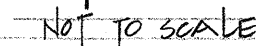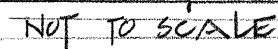

NOT TO SCALE

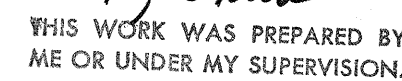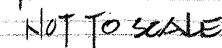

DATE

Hyman William C. Hargy 6/28/66
DEPUTY TRAFFIC ENGINEER

DEPUTY TRAFFIC ENGINEER
TRAFFIC DEPT, C&D OF HONOLULU