




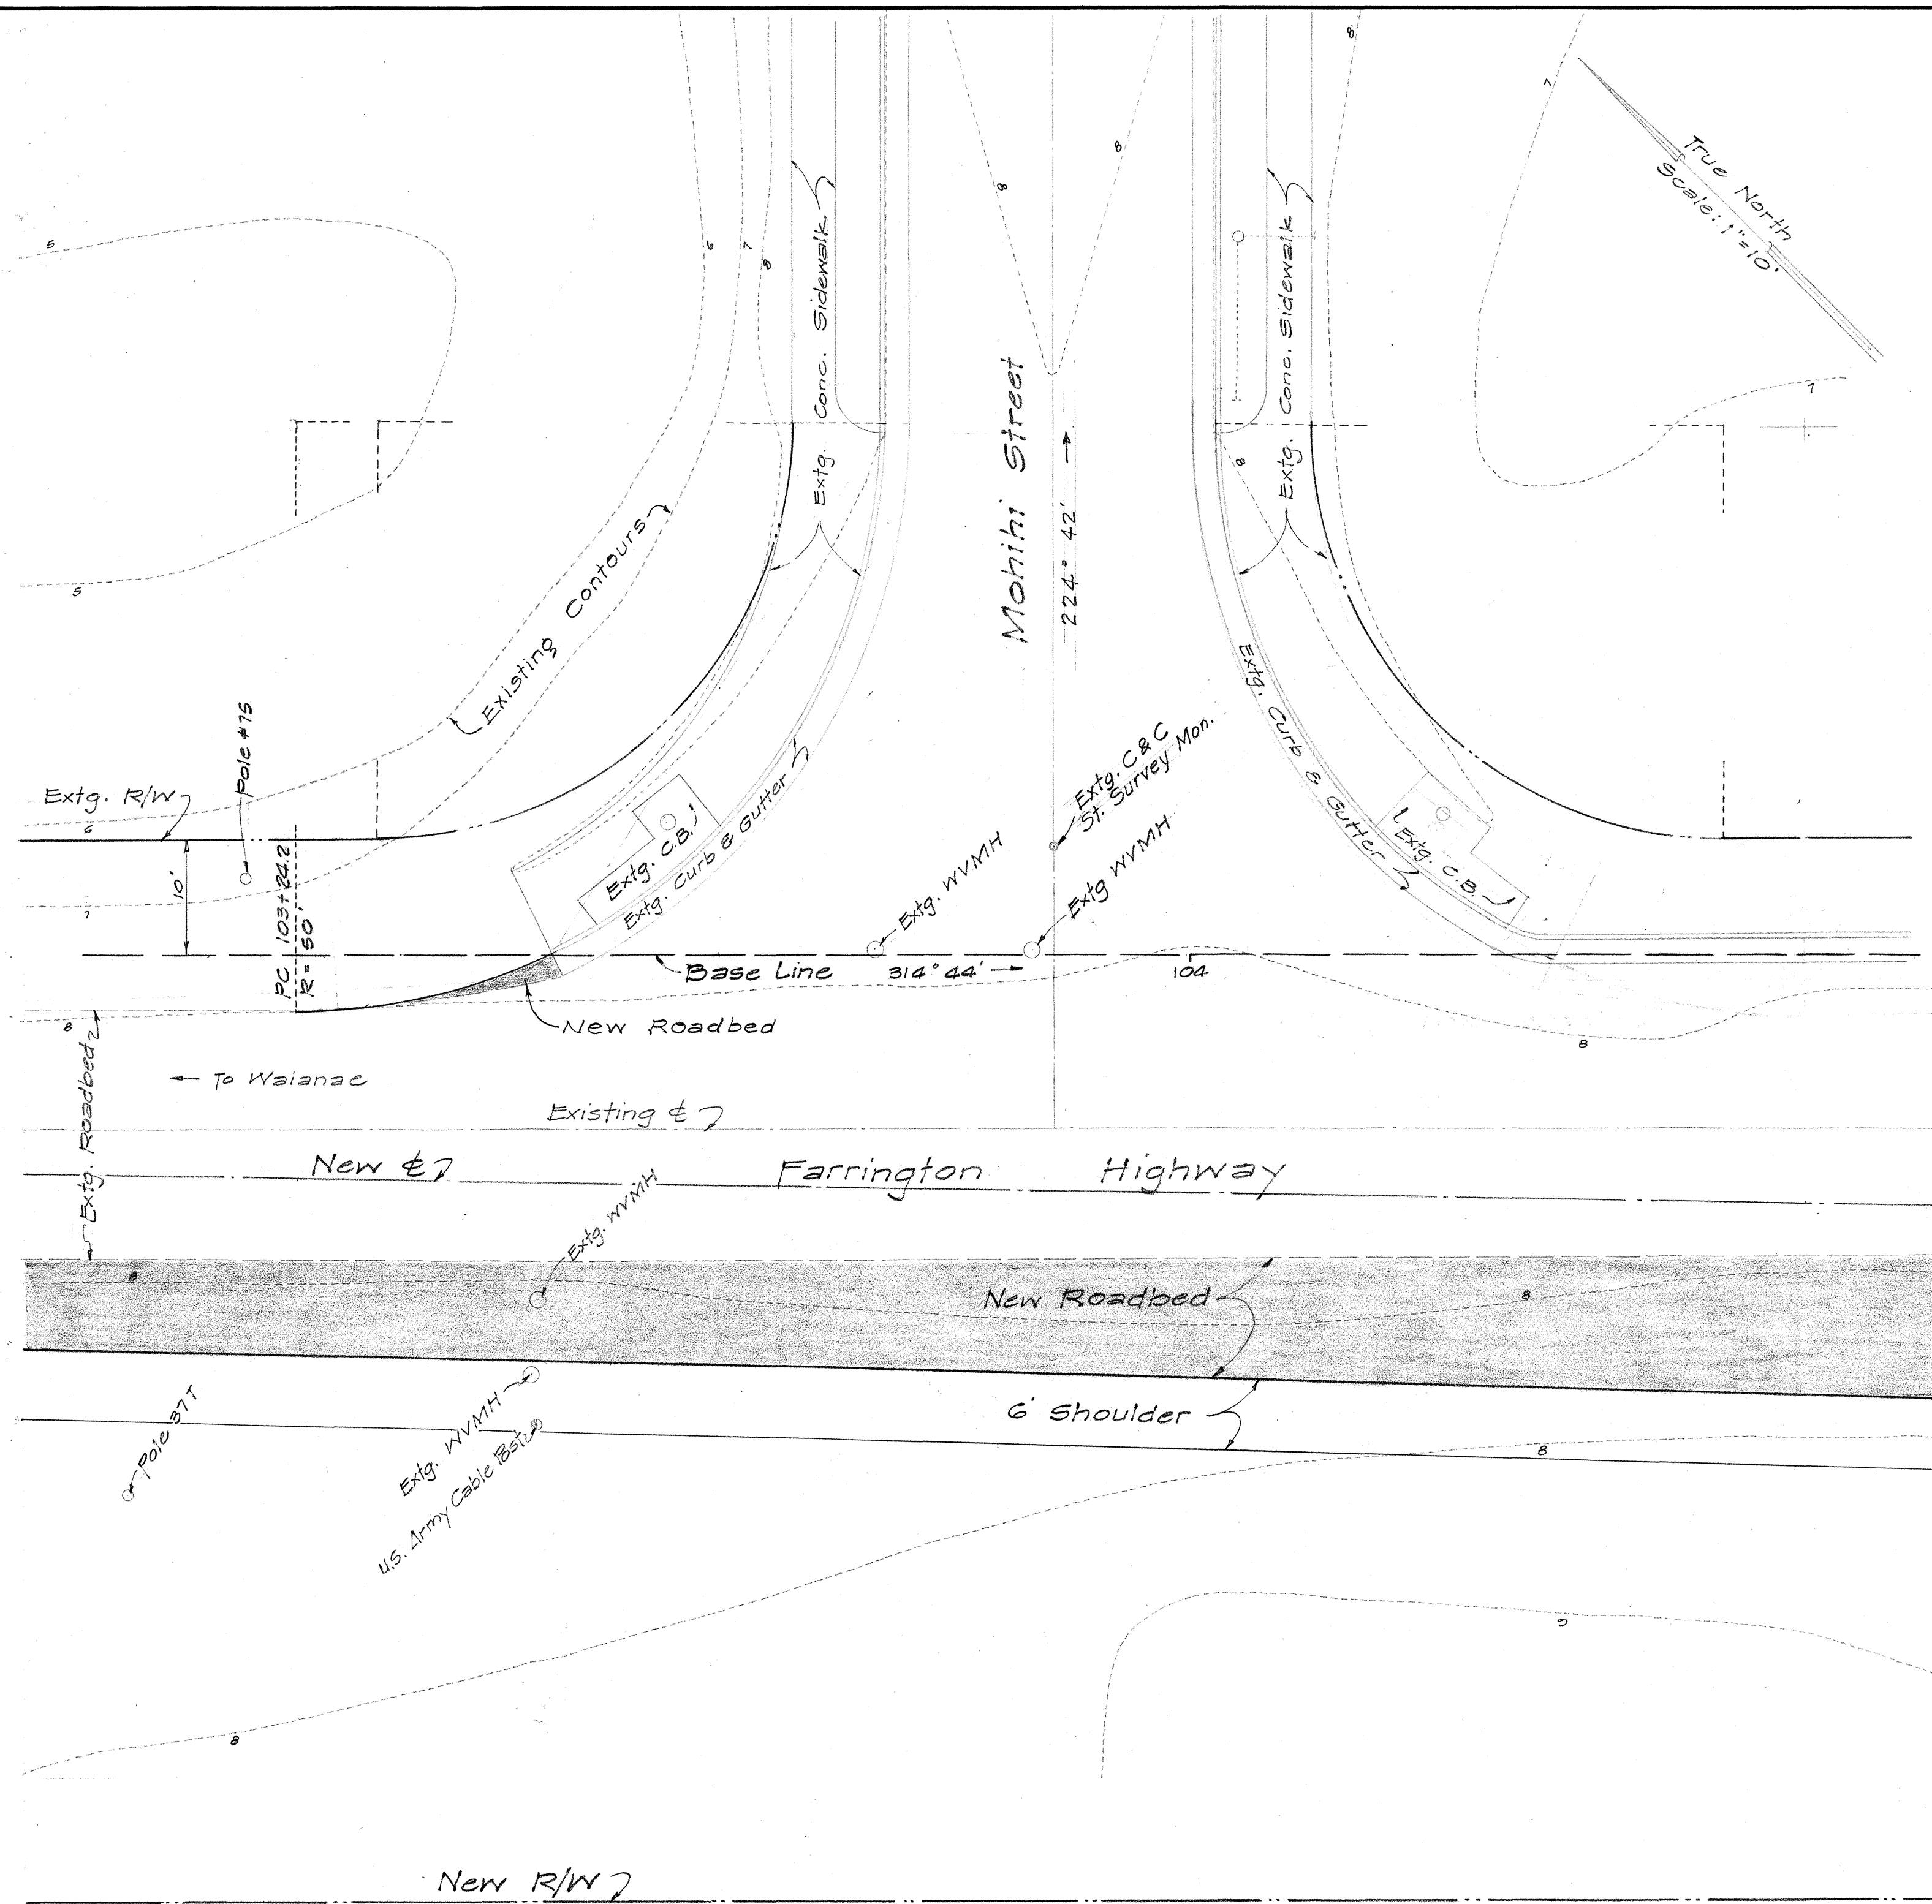

MOHIHI STREET

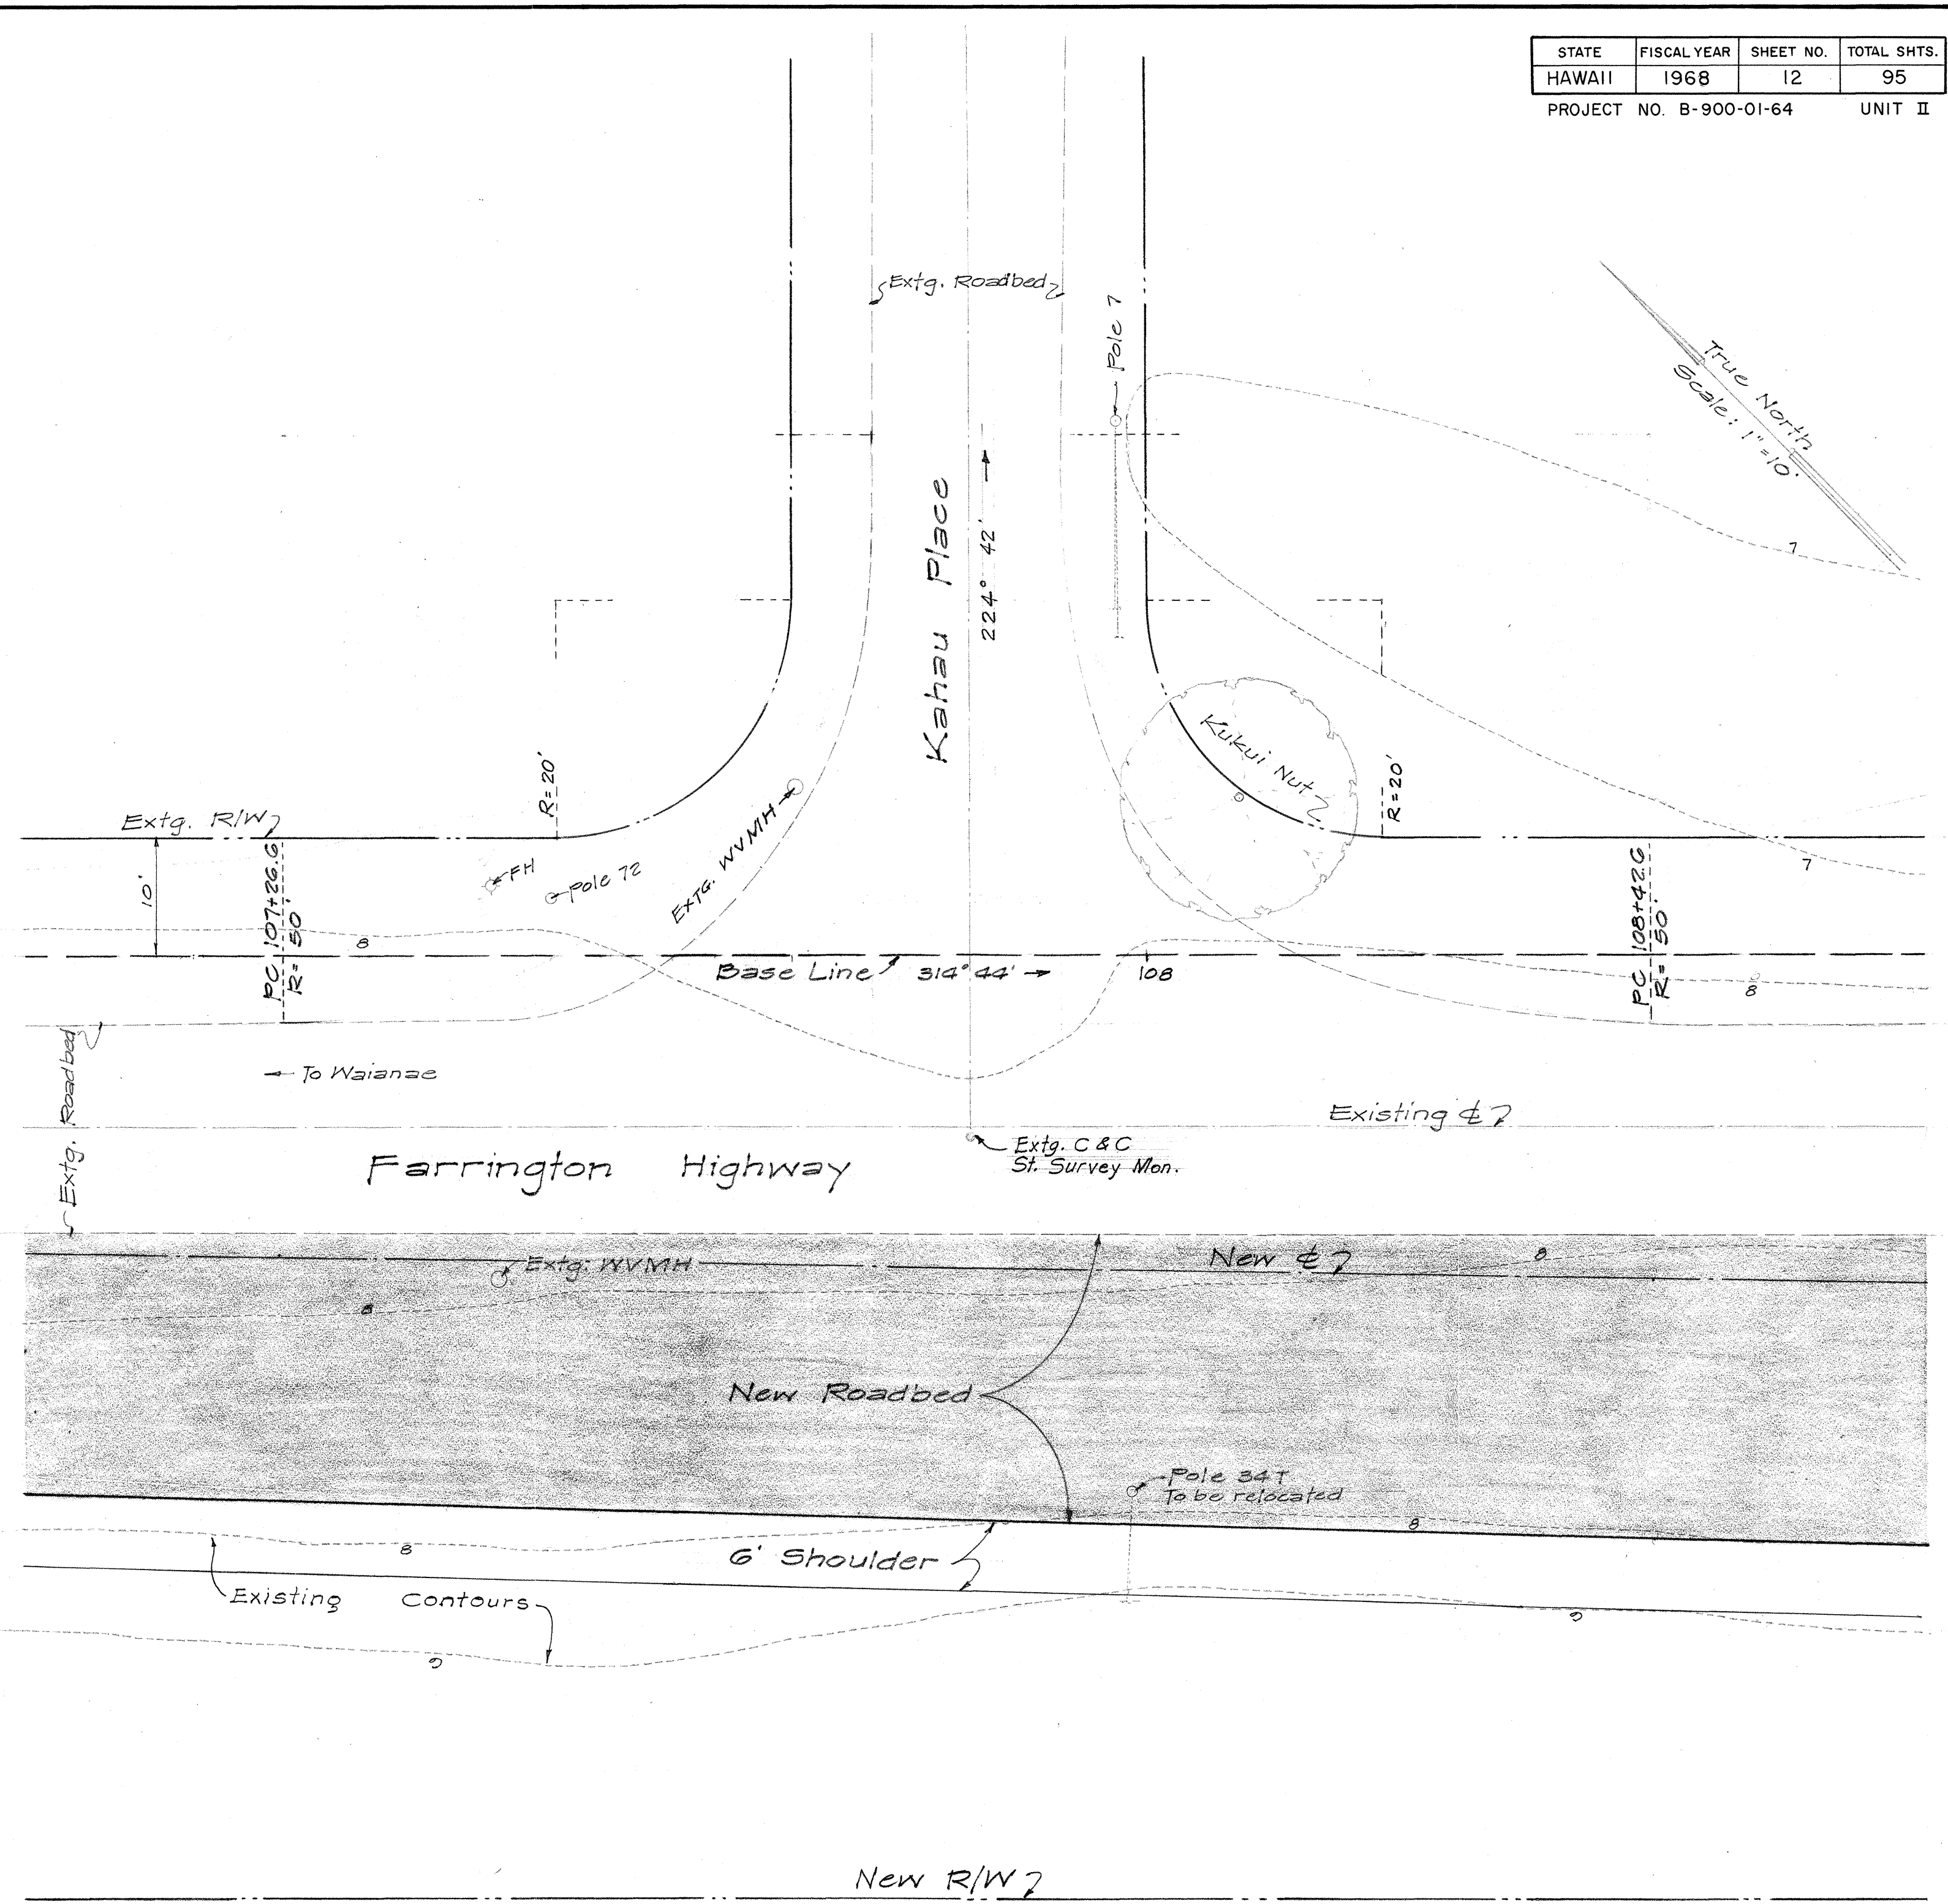

KAHAU PLACE

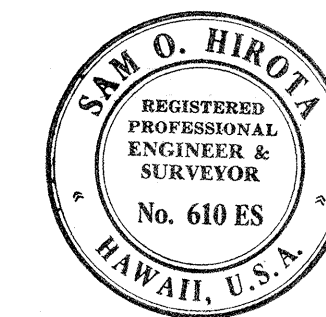


THIS WORK WAS PREPARED BY
ME OR UNDER MY SUPERVISION,
Sam O. Hirota, P.E.


SAM O. HIROTA, P. E. - CIVIL ENGINEERS & SURVEYORS
547 HALEKAUWILA ST. • ROOM 204 • HONOLULU, HAWAII 96813

STATE OF HAWAII
DEPARTMENT OF TRANSPORTATION
HIGHWAYS DIVISION
INTERSECTION DETAILS
FARRINGTON HIGHWAY WIDENING
PROJECT B-900-01-64
UNIT II
SCALE: 1"=10'


SHEET No. 1 OF 5 SHEETS

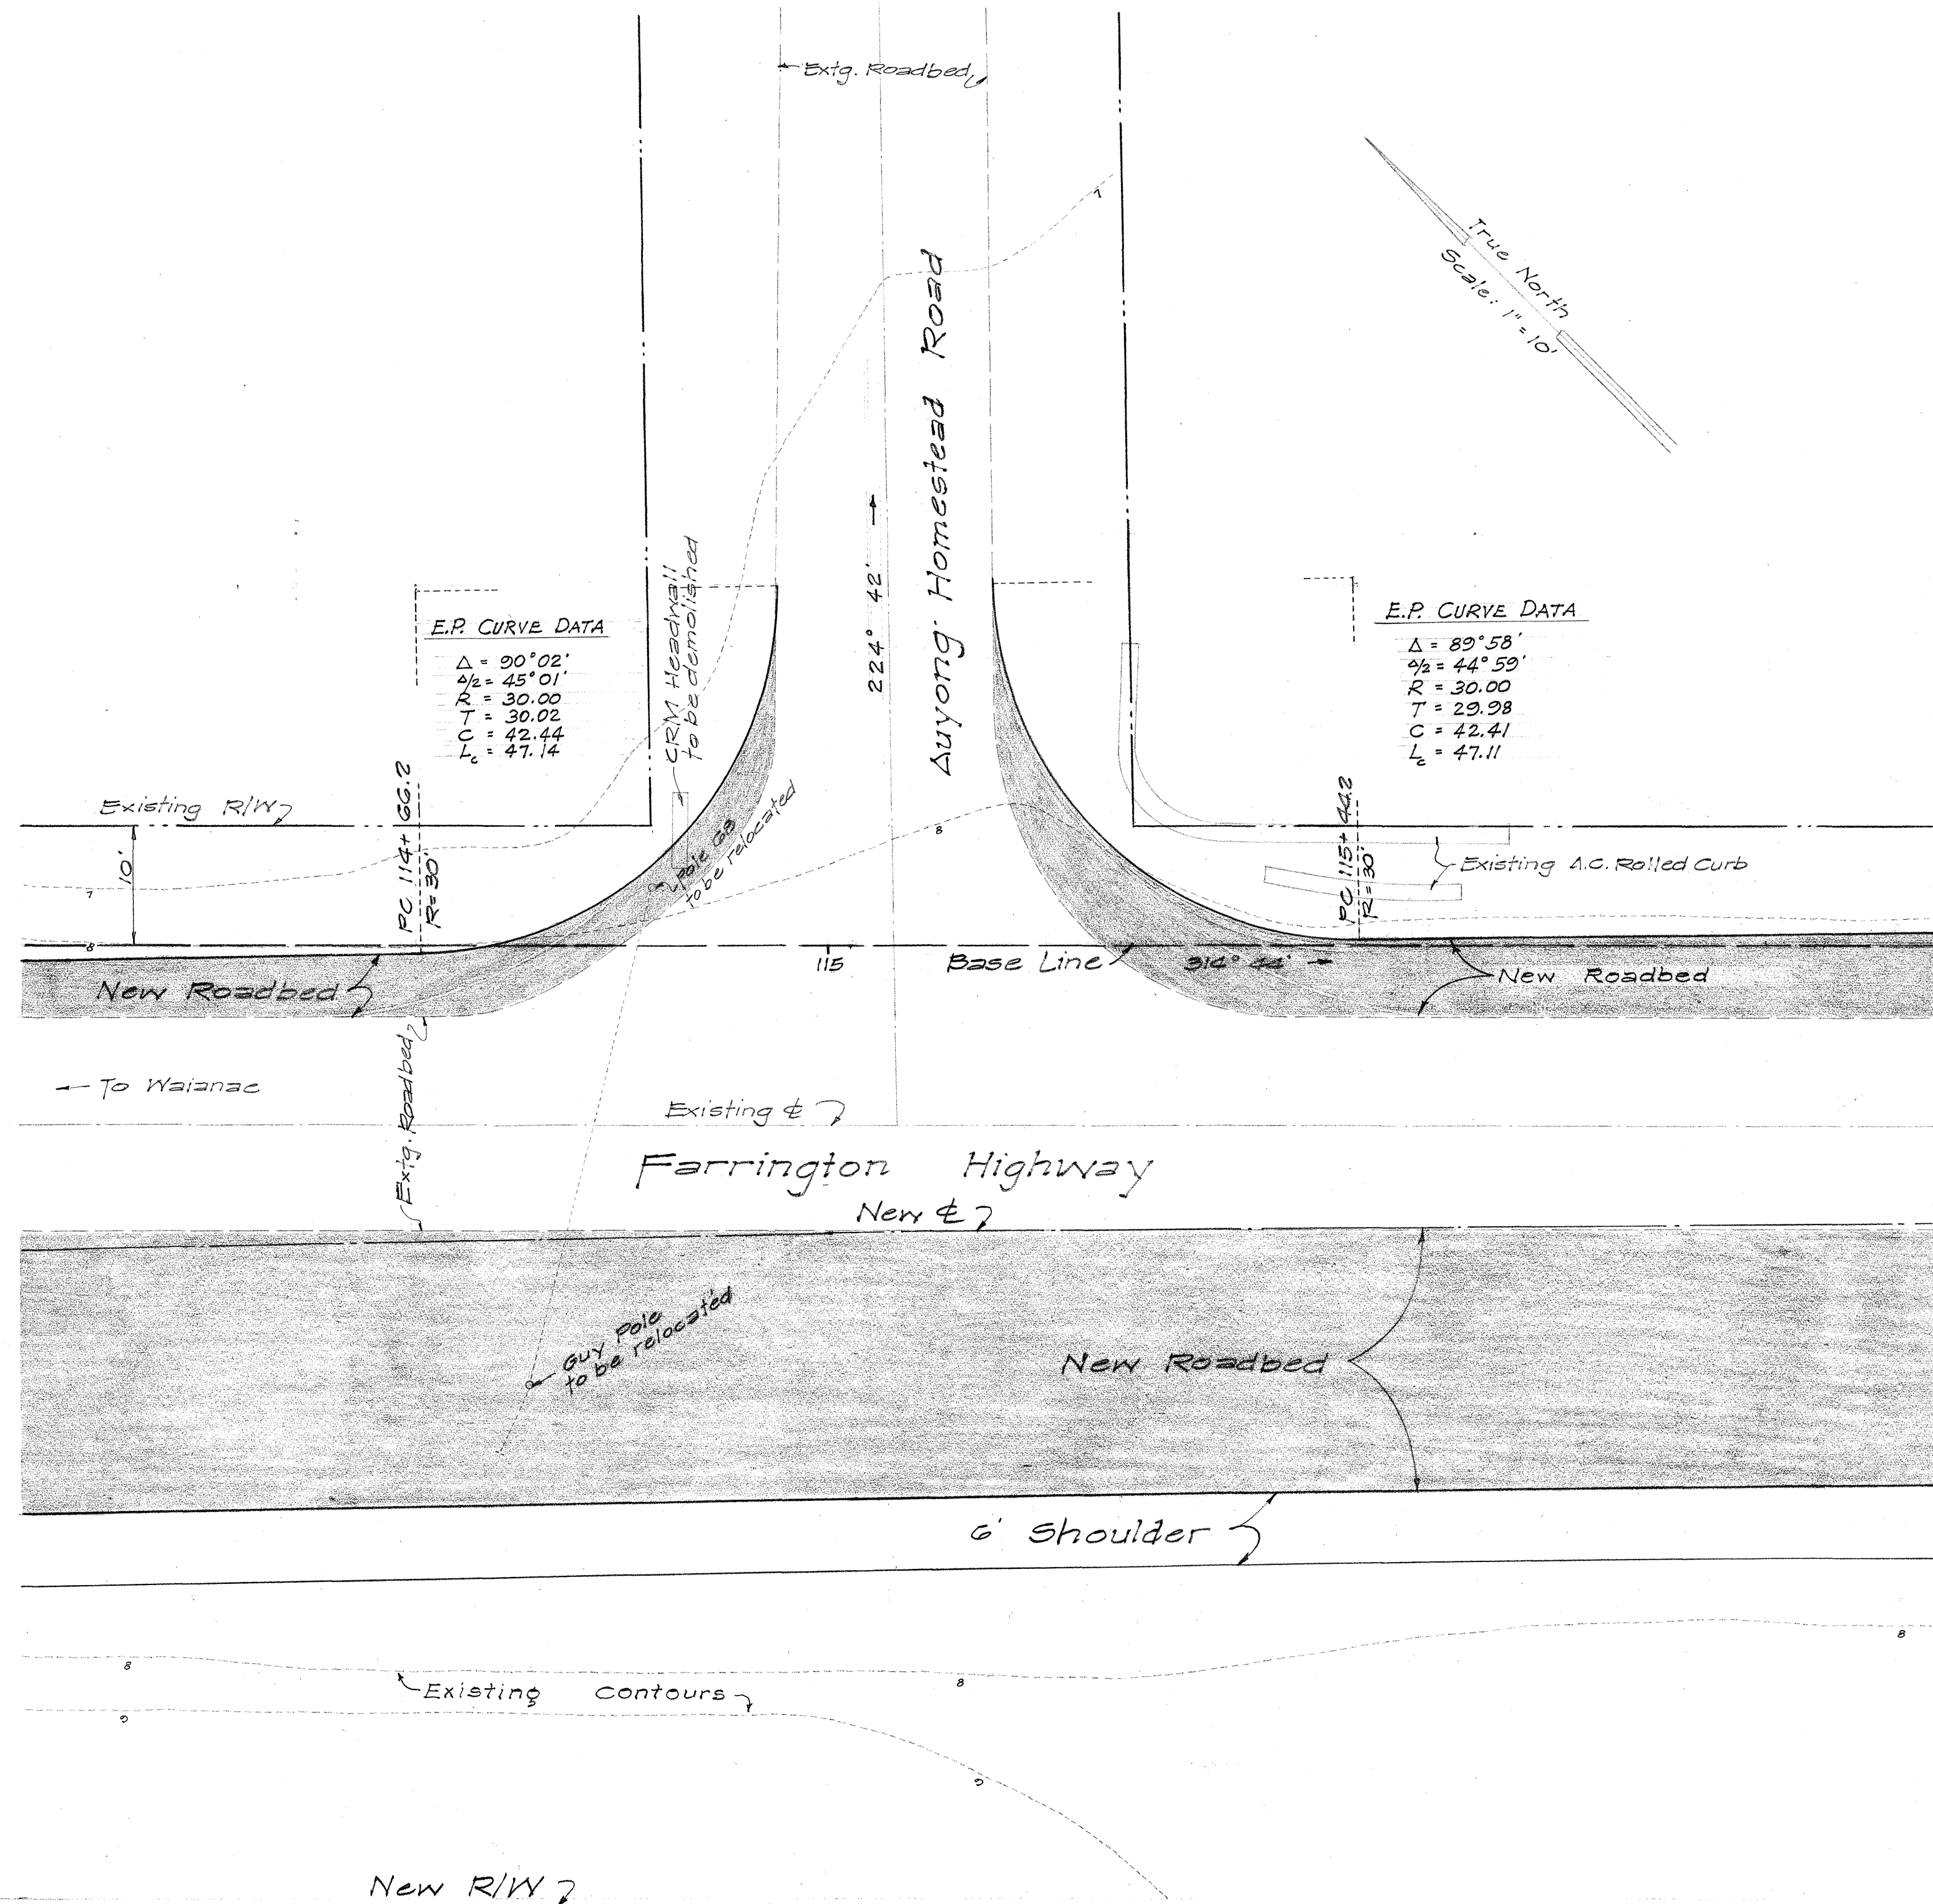

AUYONG HOMESTEAD ROAD

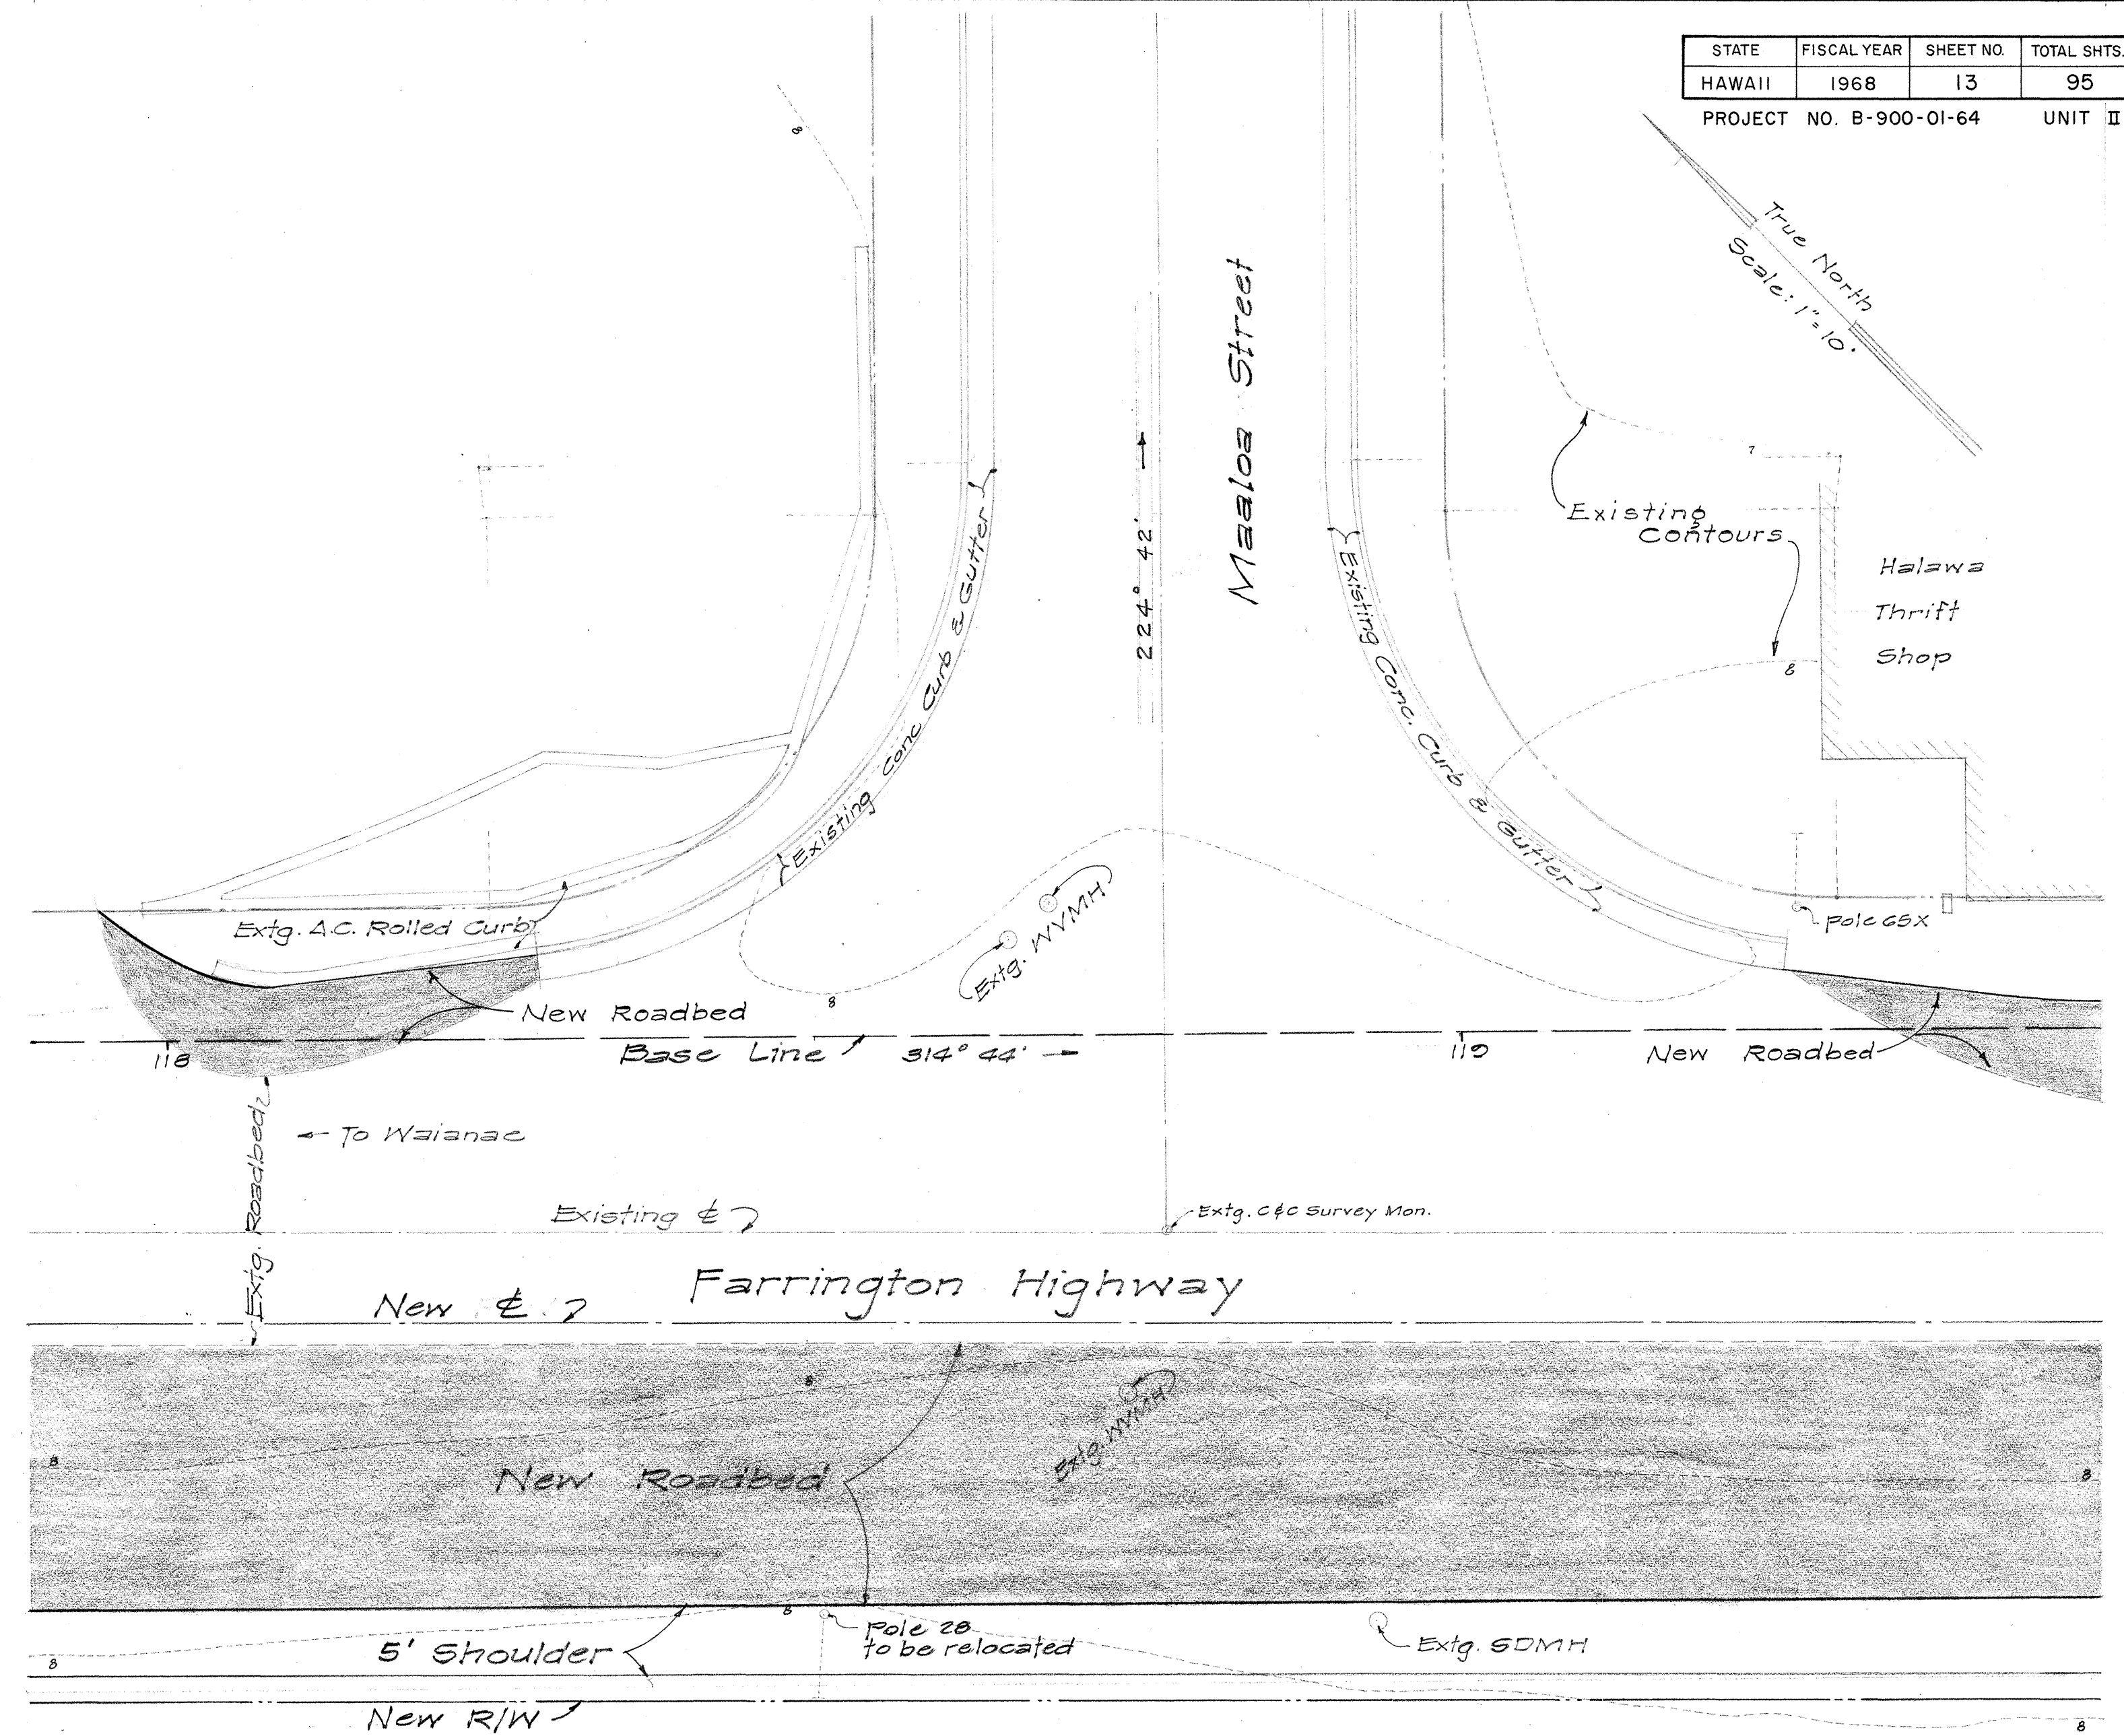

MAALO A STREET

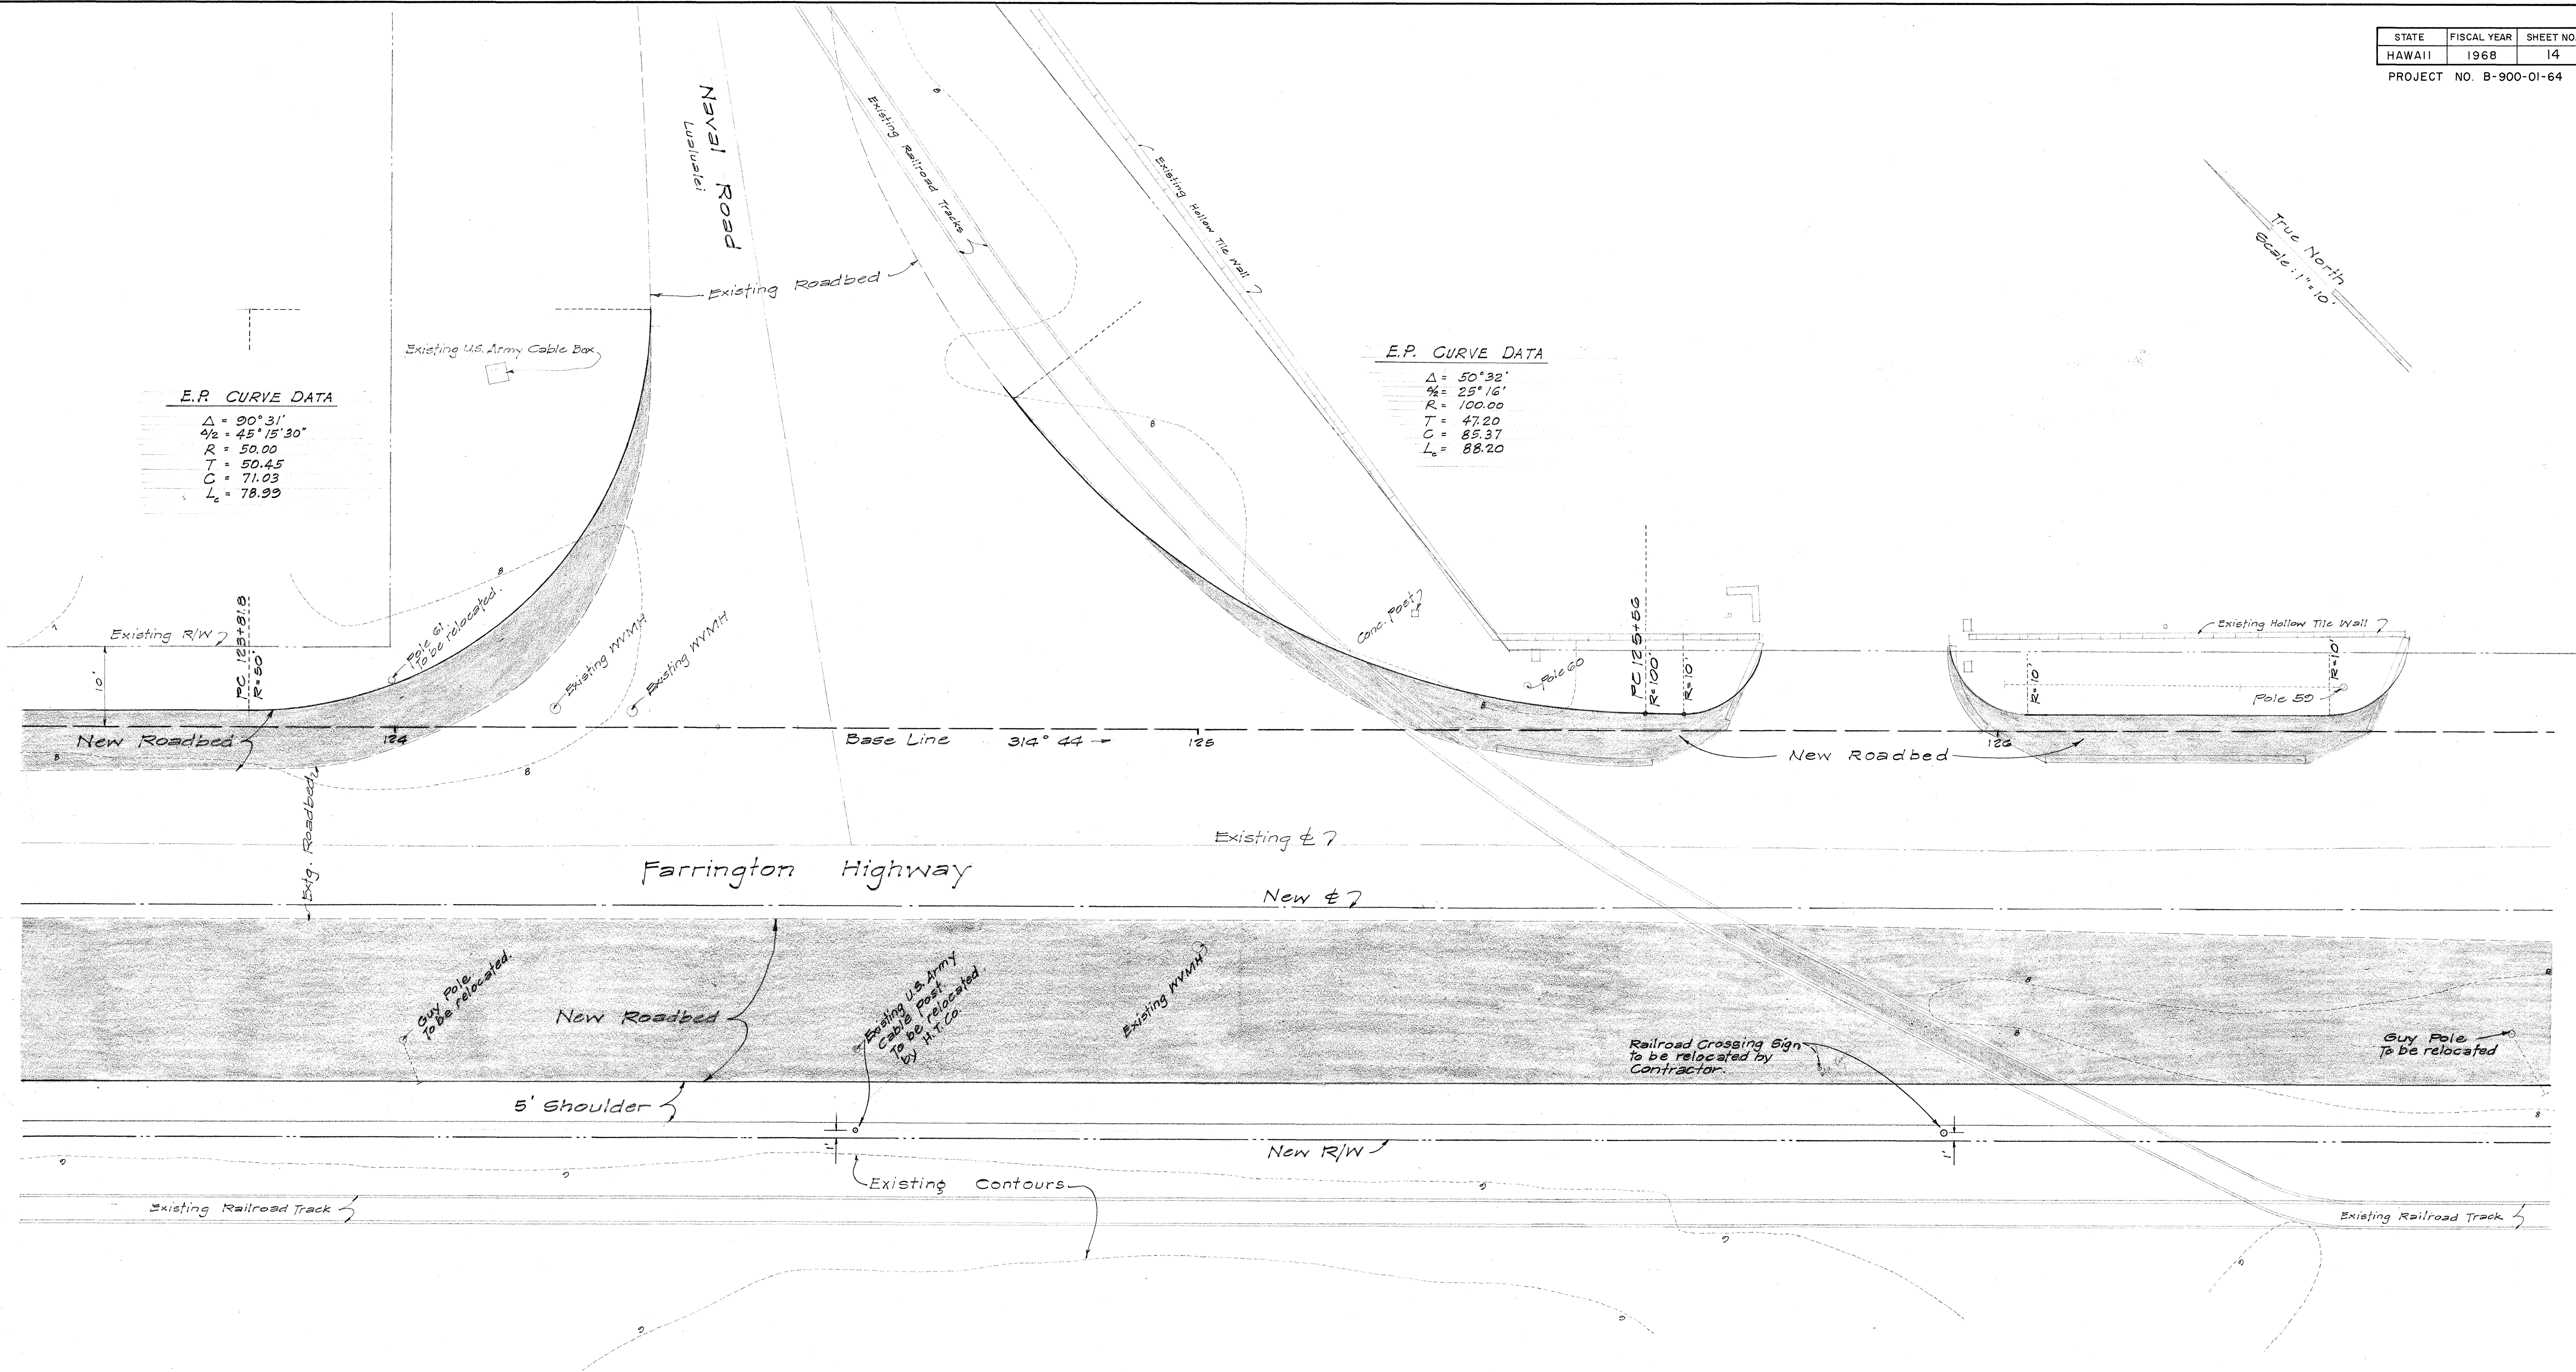

NAVAL ROAD
LUALUALEI

