


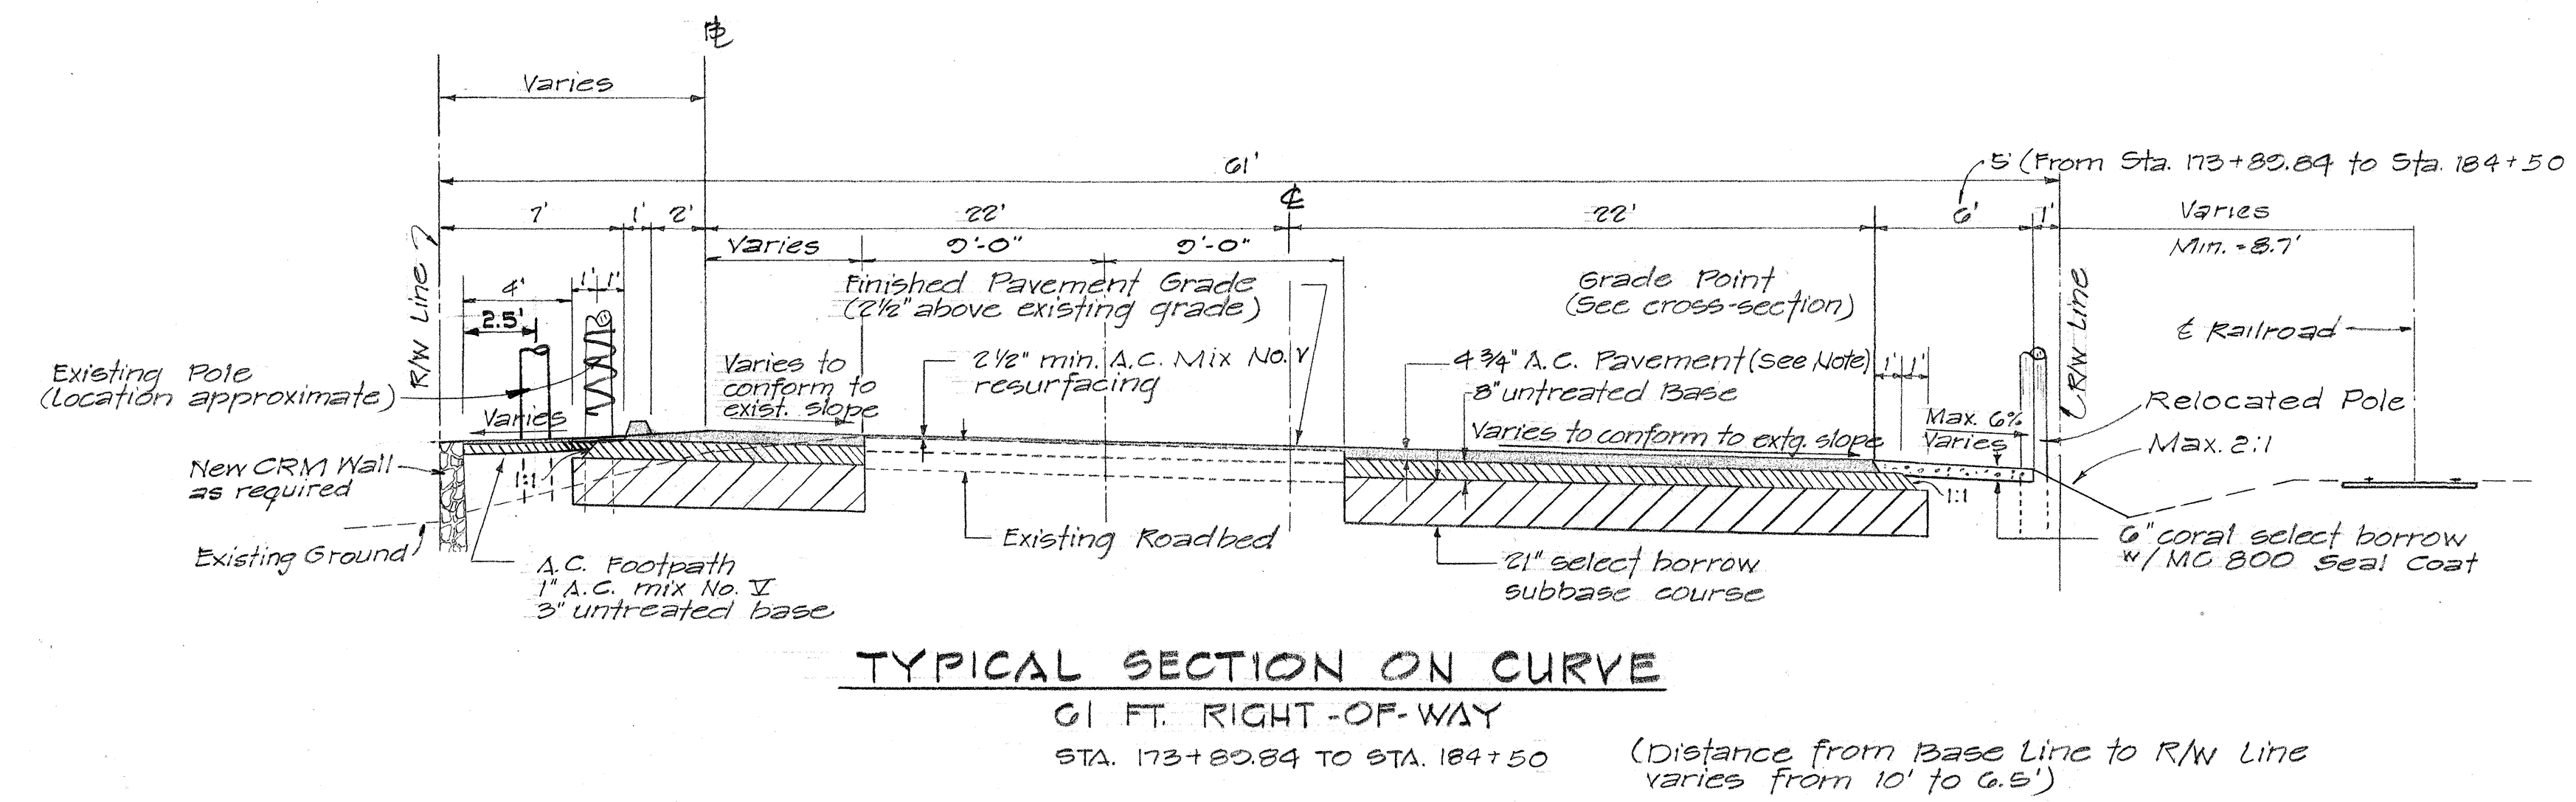

NOTE:
 4 3/4" A.C. Pavement shall consist of
 3/4" Asphalt Concrete Pavement Mix No. I Surface Course
 2-2" Asphalt Concrete Pavement Mix No. III Leveling Course