

INDEX TO DRAWINGS	
SHEET NO.	DESCRIPTION
1	TITLE SHEET
2 - 3	TYPICAL ROADWAY SECTIONS
4 - 7	PLAN & PROFILE
8	TRANSITION DETAILS
9	INTERSECTION DETAILS
10 - 12	DRIVEWAY DETAILS
13 - 18	ORDER OF WORK & DETOURS
19 - 20	ROADWAY SIGNS
21 - 30	STD. ROADWAY SIGNS & GUARDRAILS
31	CONC. DROP INTAKE DETAILS
32	SPECIAL SDMH DETAIL
33	CONC. DITCH & BOULDER RIP - RAP
34 - 35	TYPE 6121 GRATED CDI
36 - 38	STD. DRAINAGE DETAILS
39 - 45	ULEHAWA BRIDGE
46 - 50	MISC. BRIDGE DETAILS
51 - 57	MISC. STD. DETAILS
58 - 67	CROSS SECTIONS
68 - 71	UTILITIES
72 - 73	UTILITY DETAILS

STATE OF HAWAII
DEPARTMENT OF TRANSPORTATION
HIGHWAYS DIVISION
HONOLULU, HAWAII
"AS BUILT"
PLANS OF
FARRINGTON HIGHWAY WIDENING
MAILIILII STREAM TO NANAKULI
(MAILI POINT TO ULEHAWA BRIDGE)
PROJECT 900 B-02-68
UNIT 1

DISTRICT OF WAIANAE
ISLAND OF OAHU


SCALES:
PLAN & PROFILE HOR. 1" = 50'
 VER. 1" = 10'
CROSS SECTIONS HOR. 1" = 10'
 VER. 1" = 5'

LAYOUT PLAN
GROSS LENGTH OF PROJECT 1.095 MI.
BRIDGES OVER 20'-0" SPAN 0.017 MI.
NET LENGTH OF ROADWAY 1.078 MI.

NOTE:

ALL CHANGES MADE DURING CONSTRUCTION HAVE BEEN INCORPORATED ON THESE PLANS IN RED EXCEPT CHANGES IN THE ORIGINAL THEORETICAL QUANTITIES.

Myron F. Kanemori 16 Aug. 1971
RESIDENT ENGINEER DATE

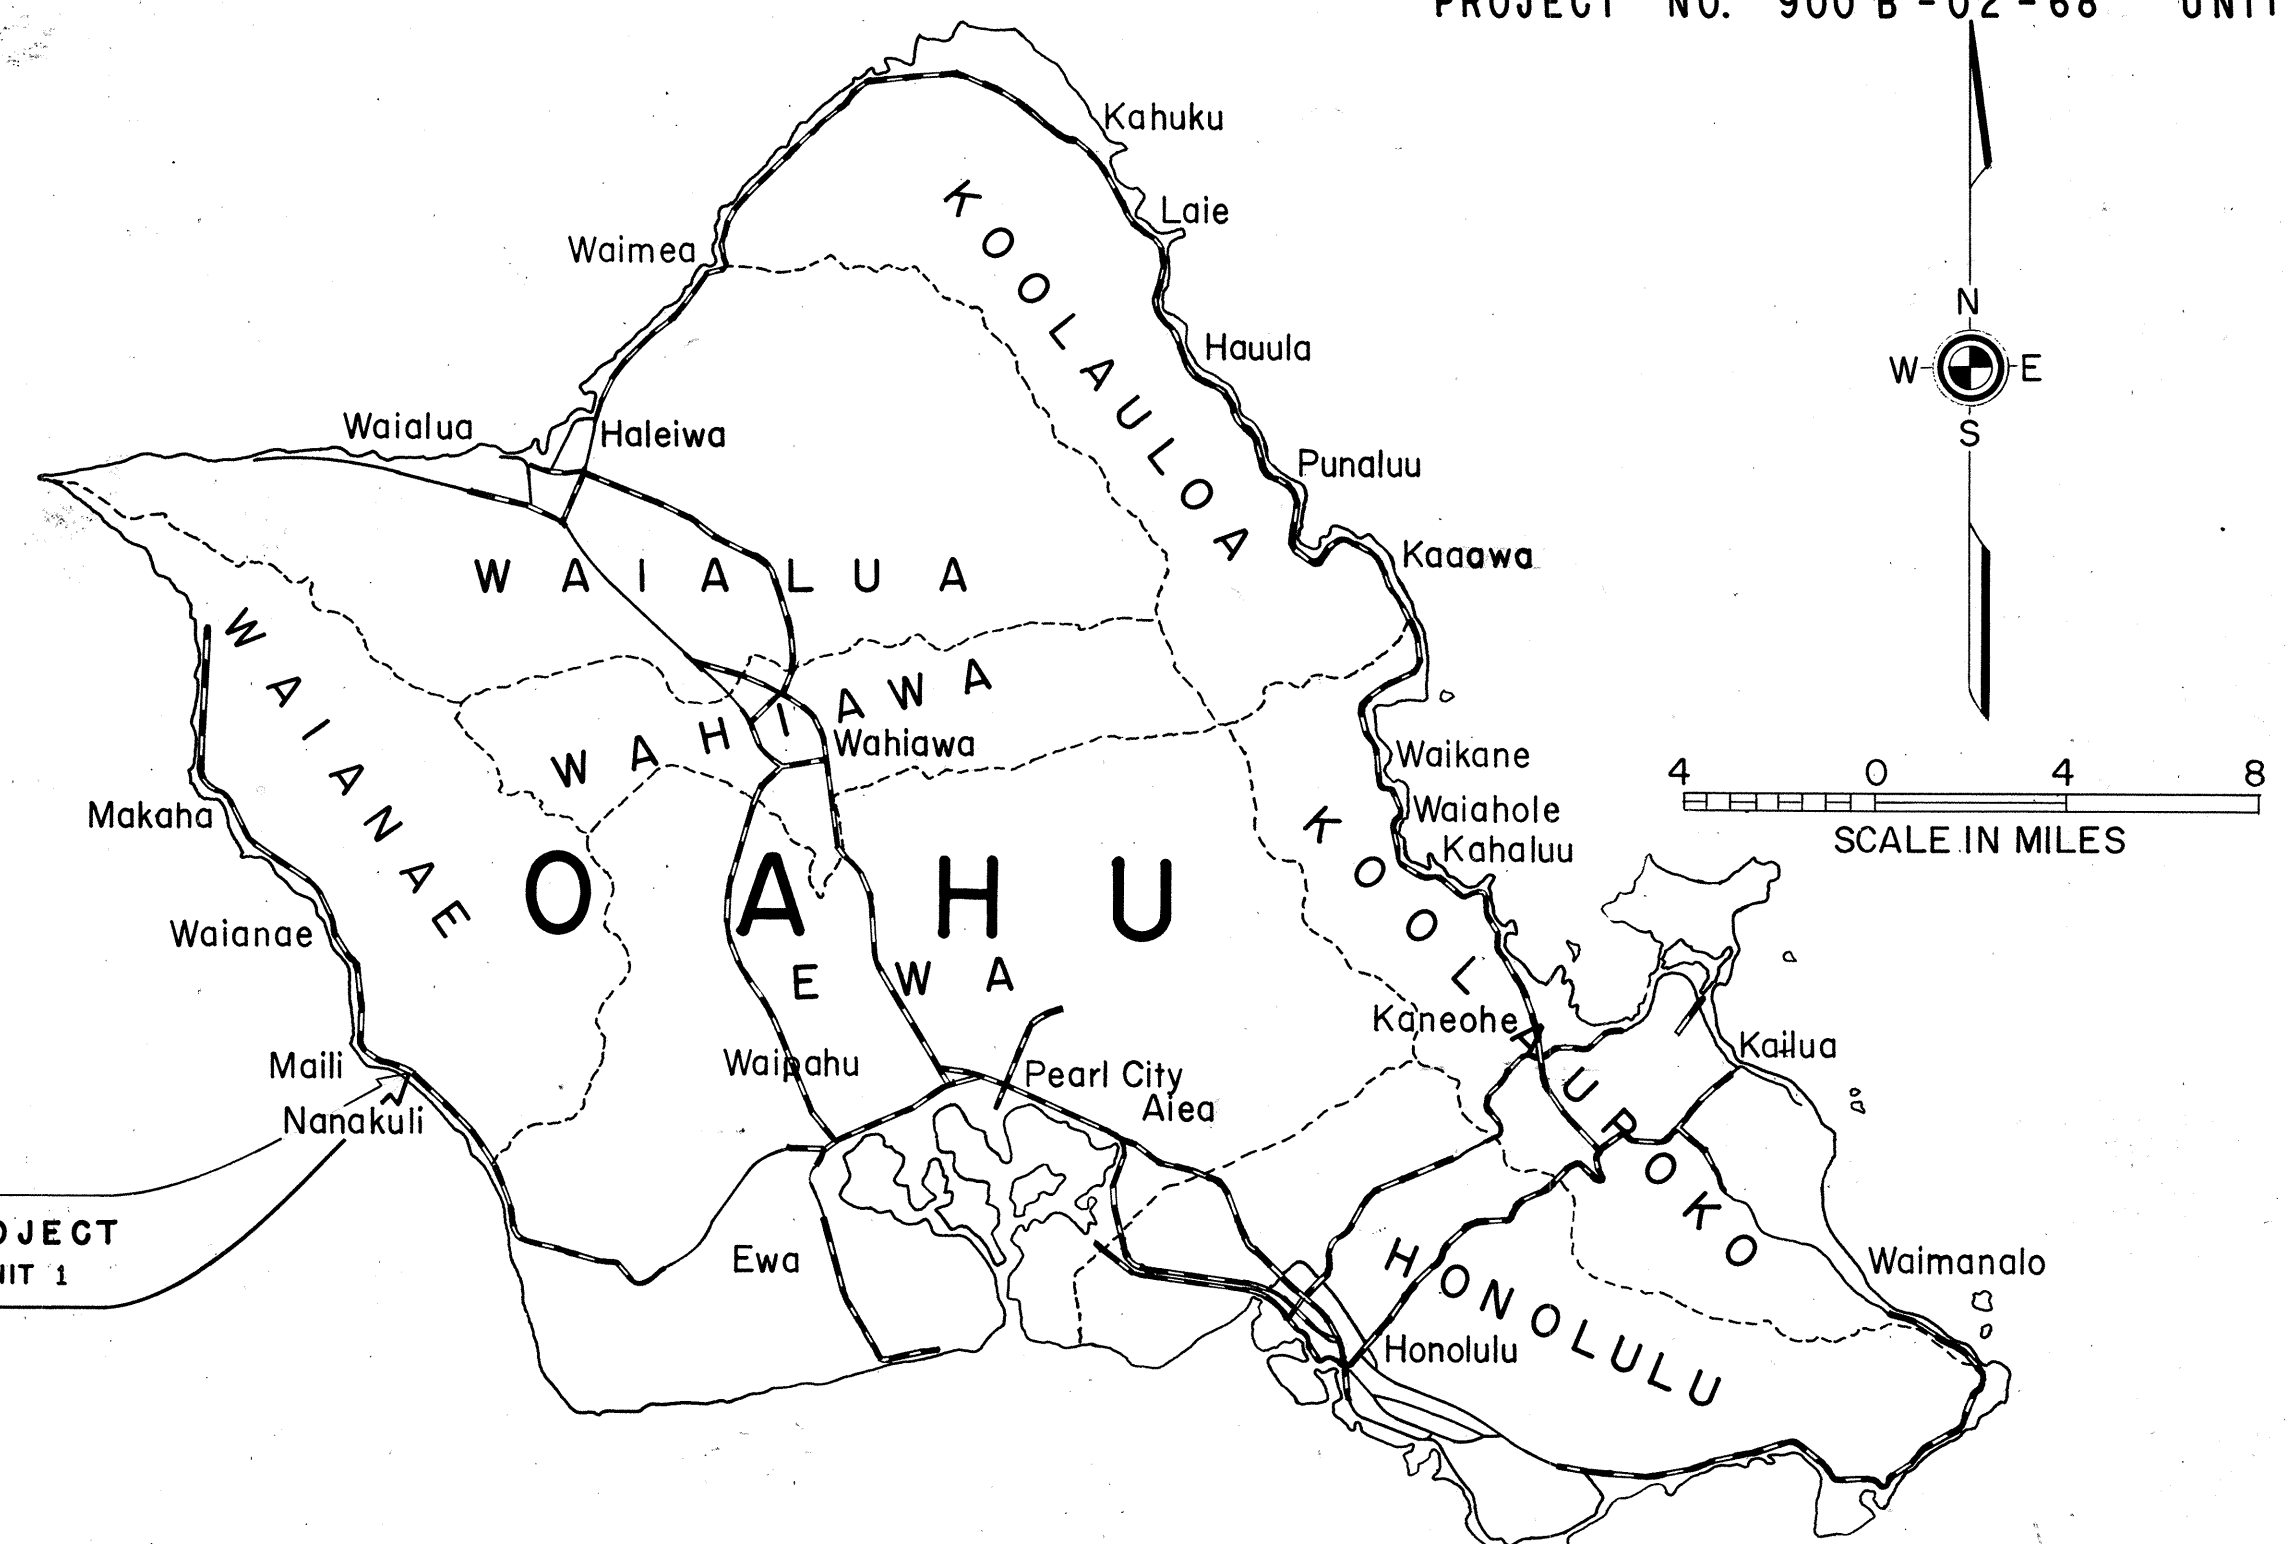

LOCATION OF PROJECT
NO. 900B-02-68 UNIT 1


— Federal Aid Projects Previously Constructed or Under Construction

DESIGN CLASSIFICATION

CURRENT ADT (1970)	13,650
DESIGN ADT (1990)	20,750
DHV	1,870
D	65/35
T	3.0 %
T 24	5.5 %
V	50 MPH

PLANS PREPARED BY:

COMMUNITY PLANNING, INC.
CIVIL ENGINEERS - SURVEYORS - CONSULTANT PLANNERS

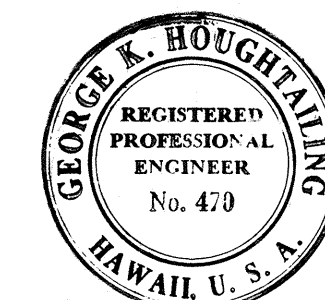

THIS WORK WAS PREPARED BY ME
OR UNDER MY SUPERVISION.
George E. Houghtaling
Signature

DEPARTMENT OF TRANSPORTATION
STATE OF HAWAII

APPROVED:

E. Alvey Knight 8/1/69
for DIR. OF TRANSPORTATION DATE



S.F. YUEN
P.S. & E.B.Y.
548-2211 LOCAL 301
PHONE

COMMUNITY PLANNING, INC.
DESIGNED BY: