

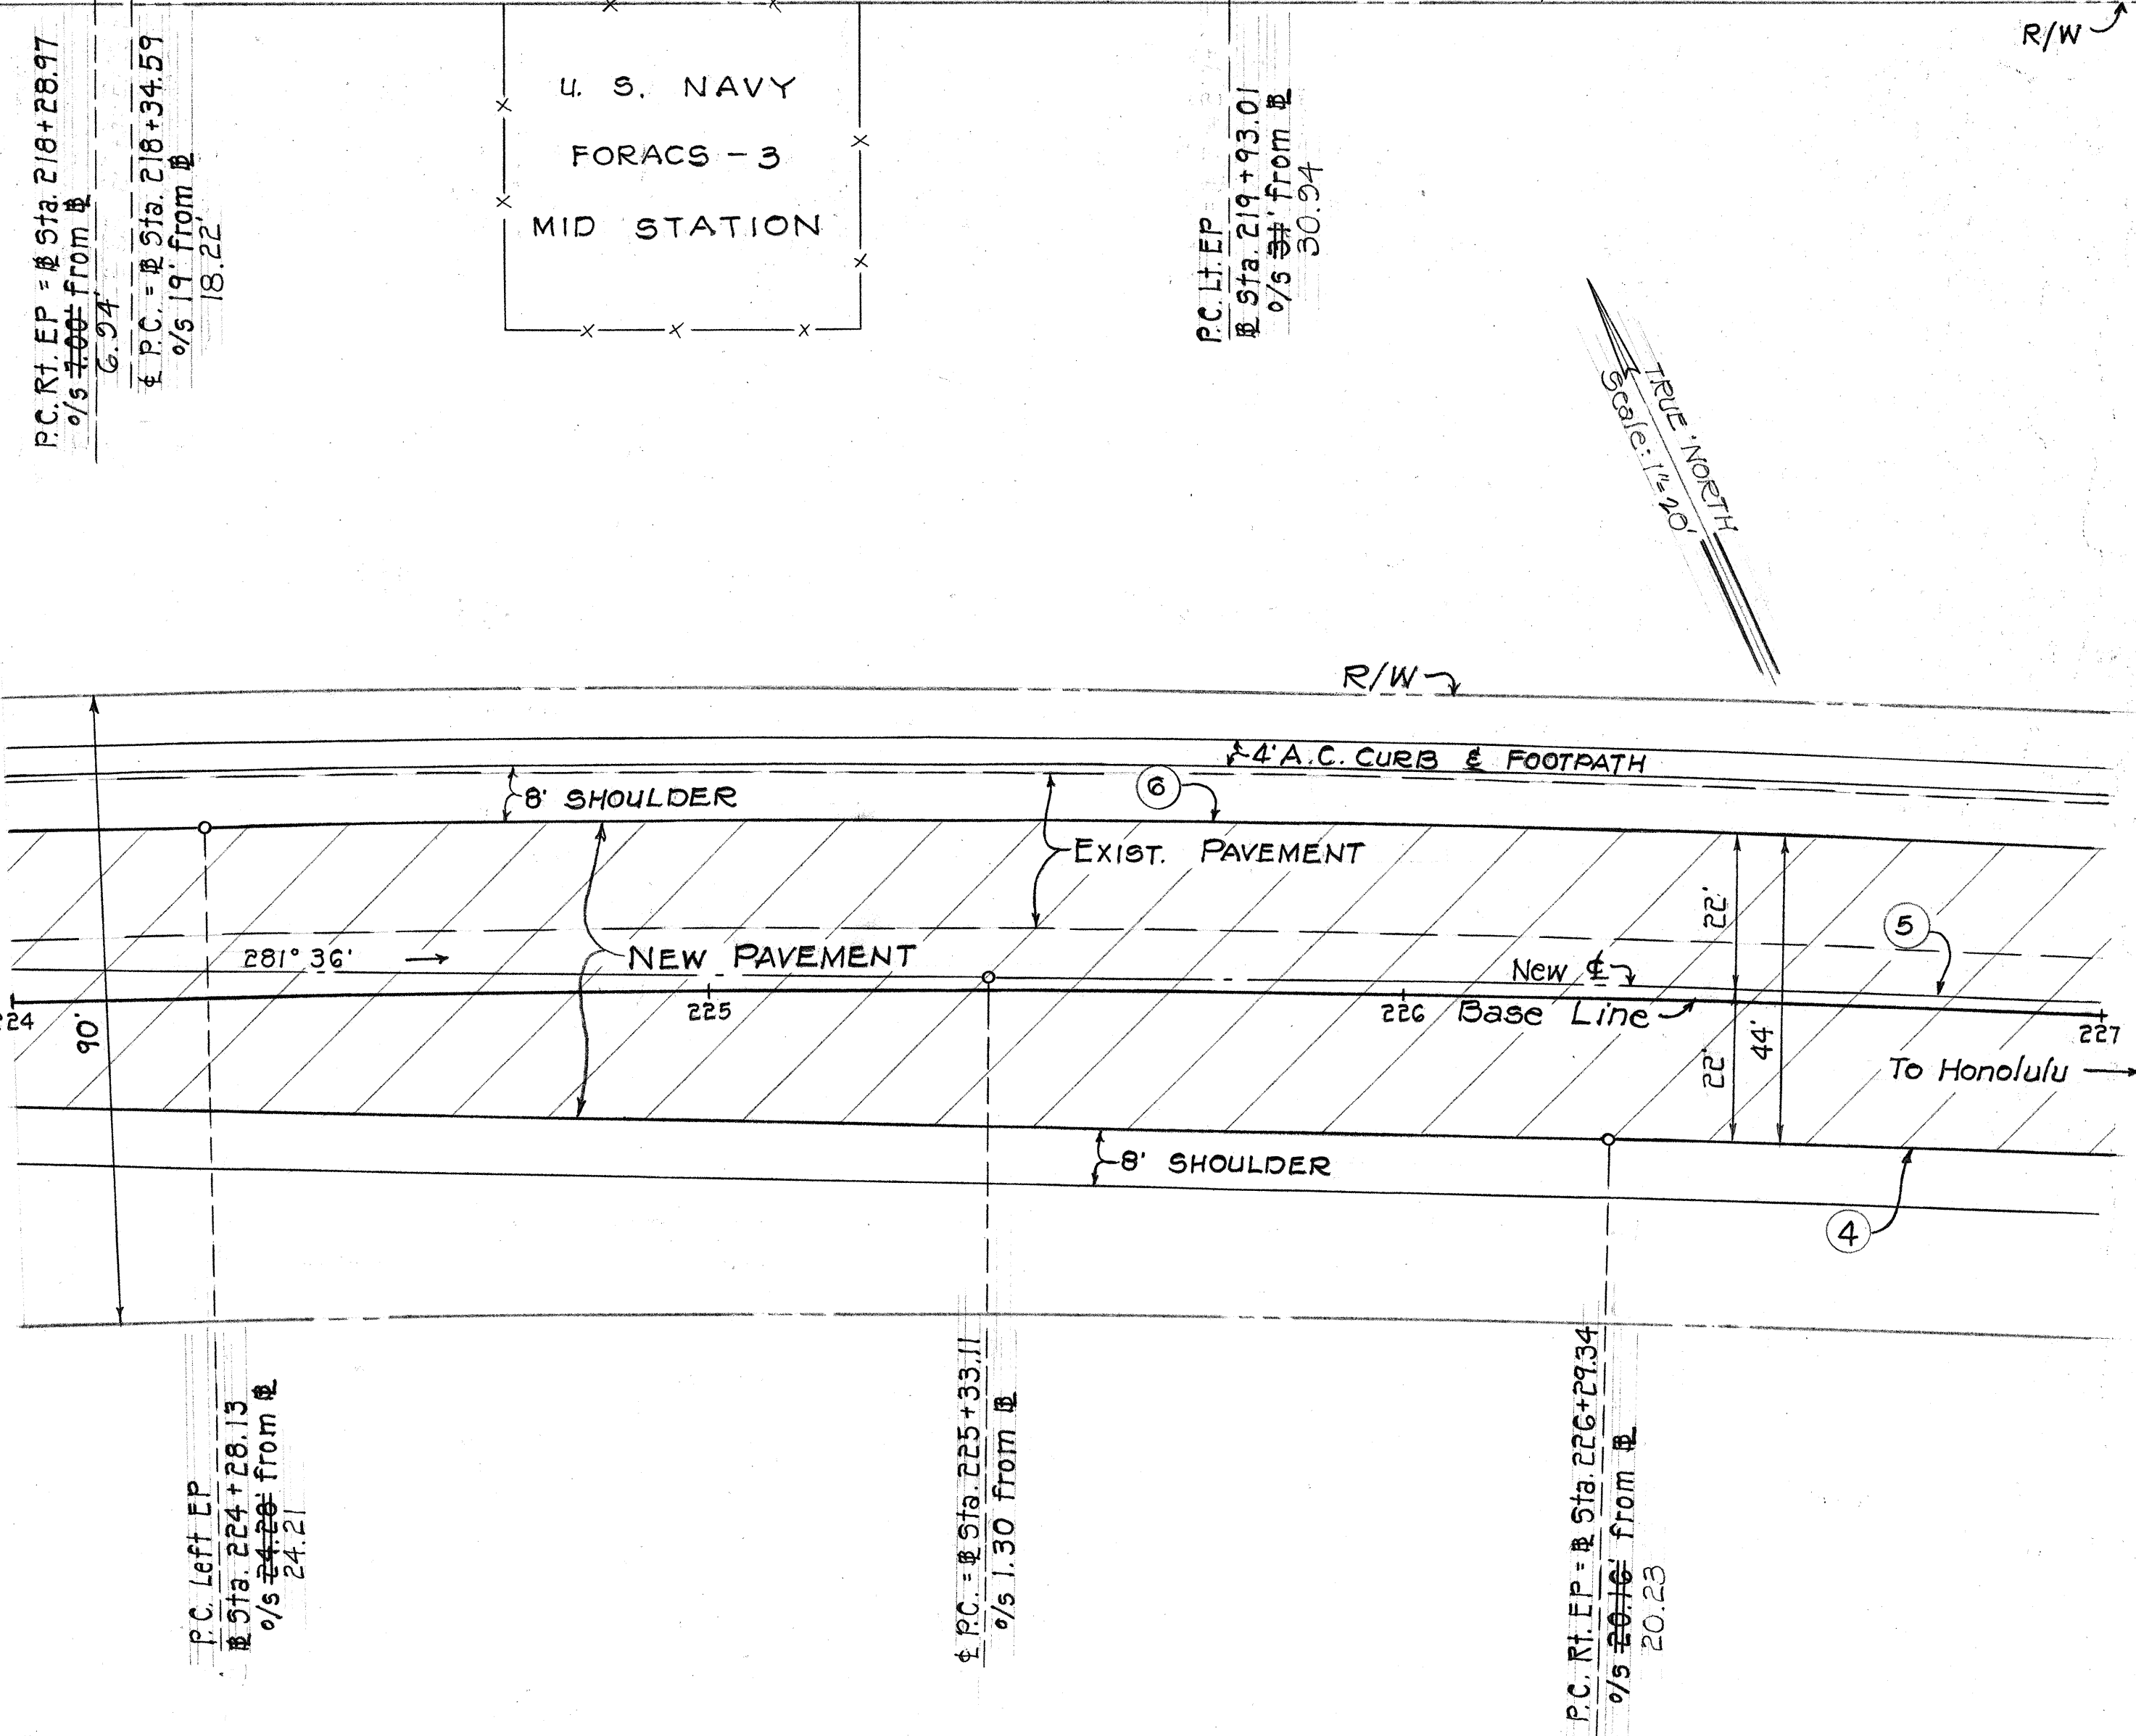


FED. ROAD DIST. NO.	STATE	PROJ. NO.	FISCAL YEAR	SHEET NO.	TOTAL SHEETS
HAWAII	HAW.		1969	8	73

PROJECT NO. 900 B-02-68 UNIT 1

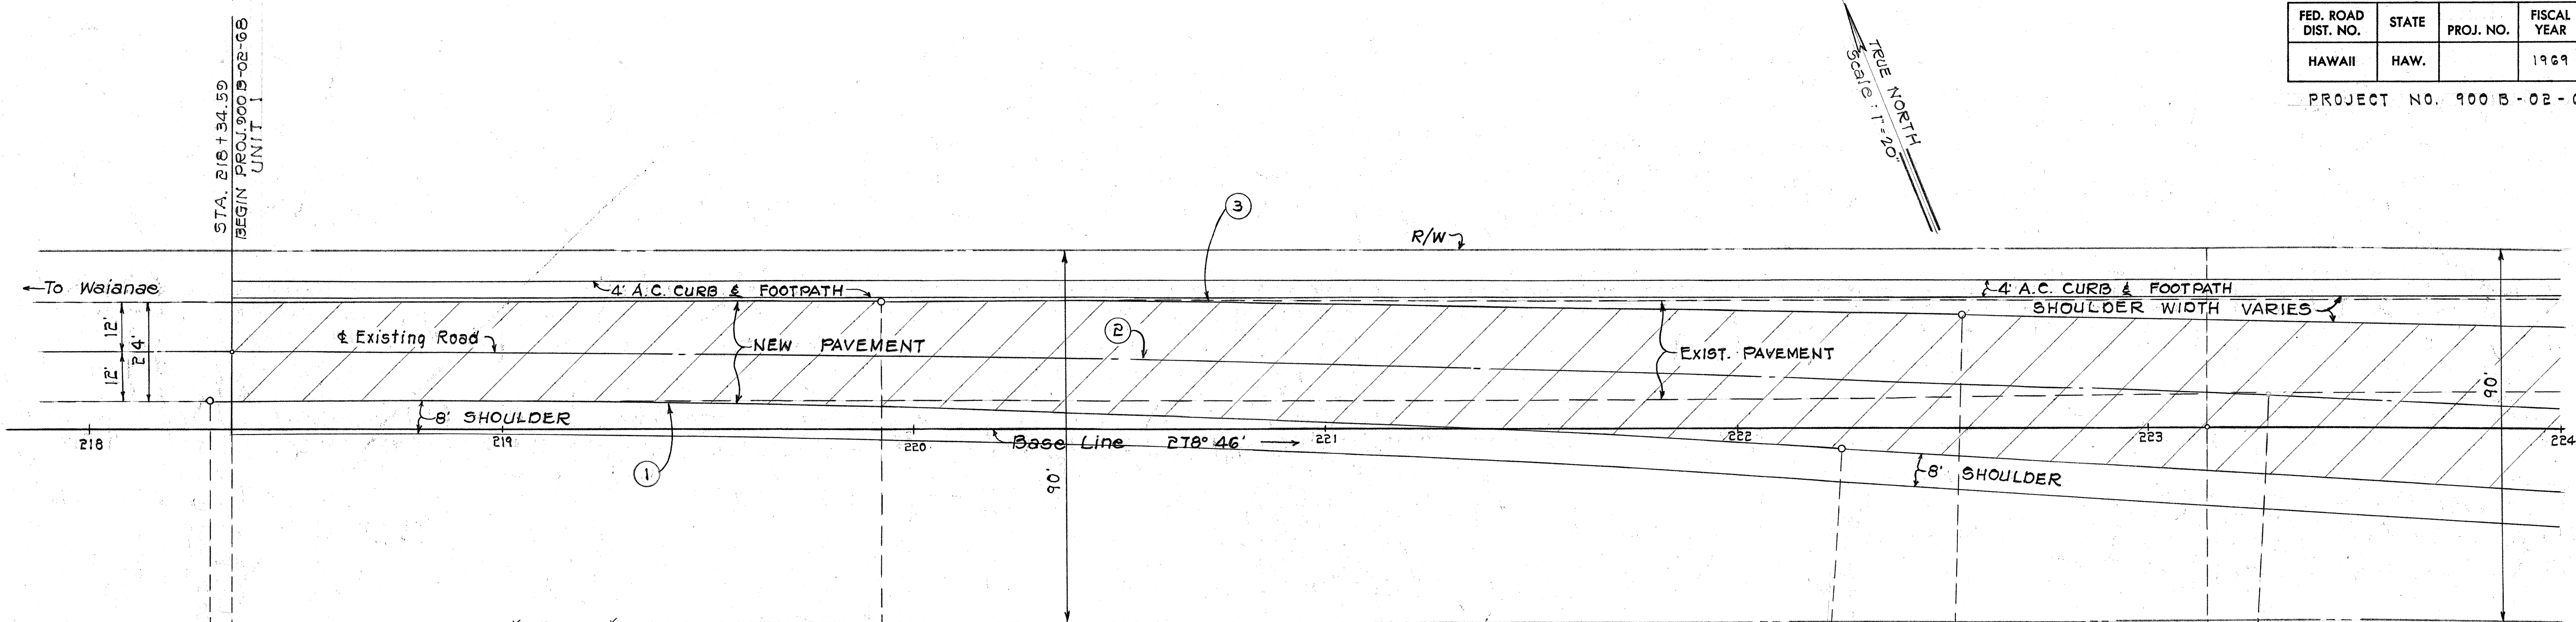

	1	2	3	4	5	6
Δ	3° 30'	2° 50'	1° 30'	32° 26'	33° 06'	34° 26'
Δ/2	1° 45'	1° 25'	0° 45'	16° 13'	16° 33'	17° 13'
R	6,500.00	10,000.00	10,000.00	5747.34	5769.34	5791.34
T	198.59	247.31	130.91	1671.57	1714.43	1794.57
C	397.00	494.46	261.79	3210.13	3286.81	3428.31
LC	397.06	494.51	261.80	3253.39	3332.97	3480.45

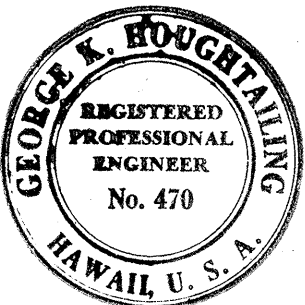

THIS WORK WAS PREPARED BY ME
OR UNDER MY SUPERVISION.
George K. Houghtaling
Signature

STATE OF HAWAII
DEPARTMENT OF TRANSPORTATION
HIGHWAYS DIVISION

TRANSITION DETAILS

FARRINGTON HIGHWAY WIDENING
PROJECT 900B-02-68
UNIT 1

SCALE: 1" = 20'
SHEET No. 1 OF 1 SHEETS

ORIGINAL PLAN	DATE
DRAWN BY	
DESIGNED BY	
CHECKED BY	
NOTE BOOK	
No.	