


FED. ROAD DIST. NO.	STATE	FED. AID PROJ. NO.	FISCAL YEAR	SHEET NO.	TOTAL SHEETS
HAWAII	HAW.		1974	30	100

PROJECT NO. 03A-02-70

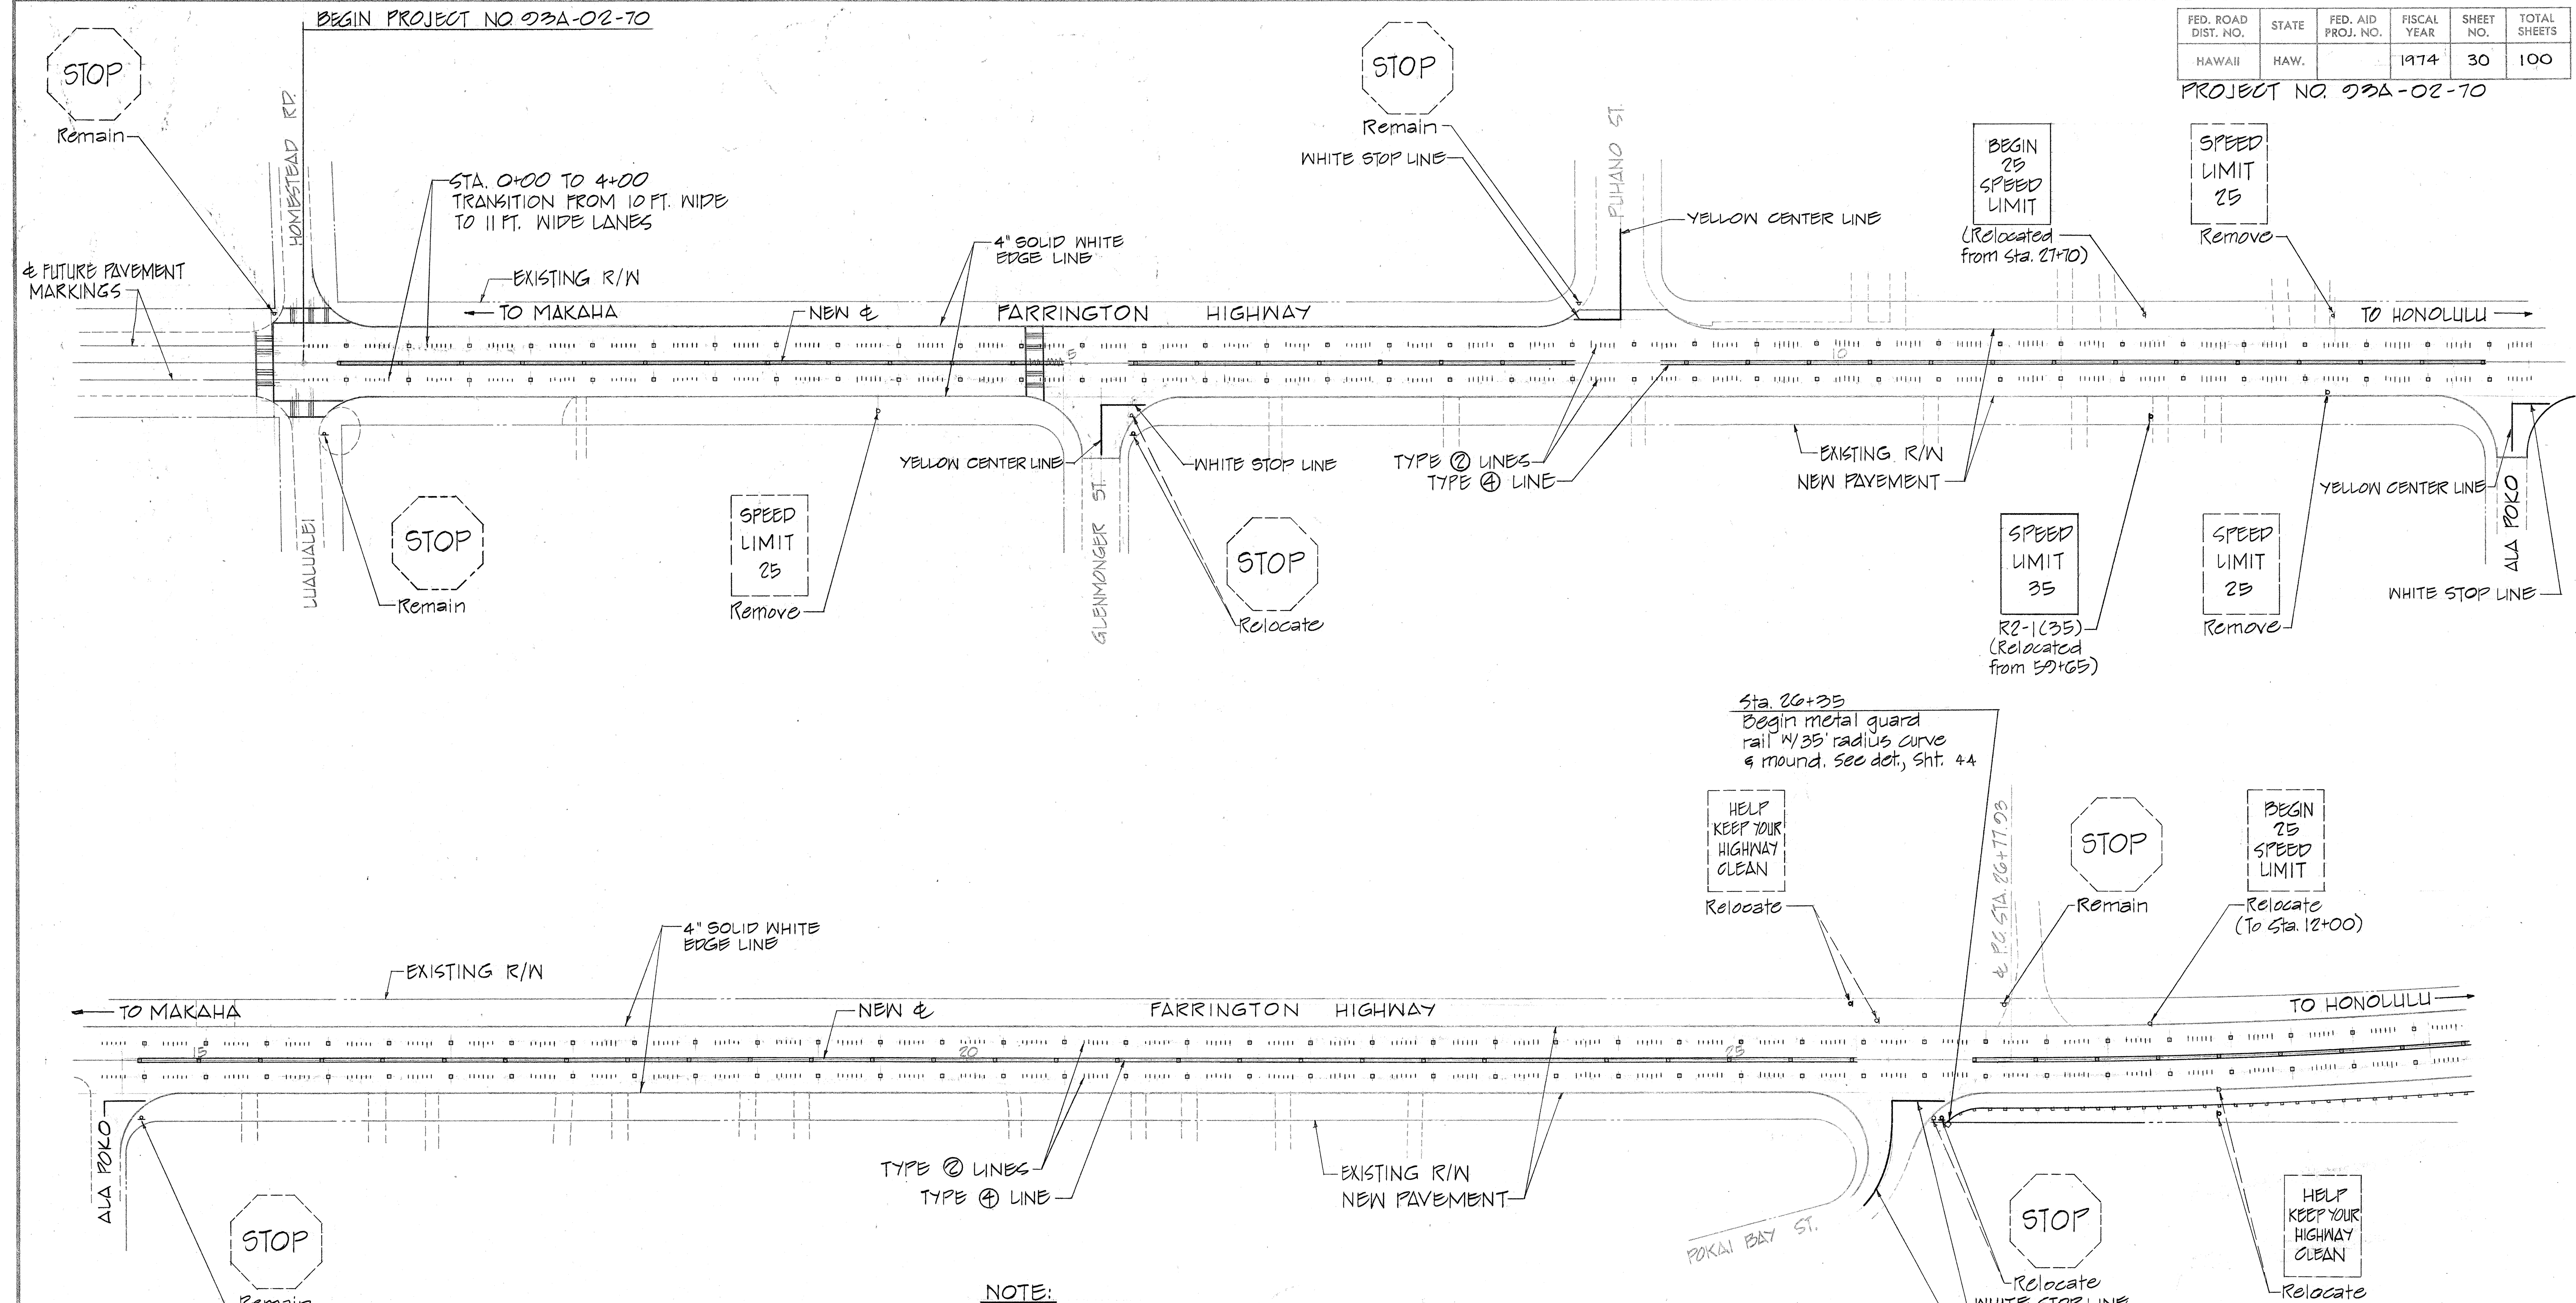

- NOTE:**
1. TYPE ② LINES ARE LANE LINES AS DETAILED ON SHEET 38 FOR MULTI-LANE HIGHWAY.
 2. TYPE ④ LINE IS CENTER LINE AS DETAILED ON SHEET 38 FOR MULTI-LANE HIGHWAY.
 3. CONTRACTOR SHALL BE RESPONSIBLE FOR TRAFFIC STRIPING.

DESIGNED BY	DATE
DRAWN BY	
CHECKED BY	
NOTED BY	

BERNARD P. KEA
REGISTERED PROFESSIONAL ENGINEER
No. 1890
HAWAII, U.S.A.

THIS WORK WAS PREPARED BY ME OR UNDER MY SUPERVISION.
Bernard P. Kea
Signature

STATE OF HAWAII
DEPARTMENT OF TRANSPORTATION
HIGHWAYS DIVISION


ROADWAY SIGNS AND METAL GUARD RAIL LAYOUT
FARRINGTON HIGHWAY WIDENING
PROJECT NO. 03A-02-70

SCALE: 1" = 50'


SHEET No. 1 OF 3 SHEETS

FED. ROAD DIST. NO.	STATE	FED. AID PROJ. NO.	FISCAL YEAR	SHEET NO.	TOTAL SHEETS
HAWAII	HAW.	93A-02-70	1974	31	100

G-15-77	ADD LEFT TURN LANE AT MAILILILI RD.
G-9-75	REVISE GUARD RAIL RIGHT SIDE OF ROADWAY AT MAILILILI STR. BRIDGE. REVISE MAILILILI STR. BRIDGE.
DATE	REVISION

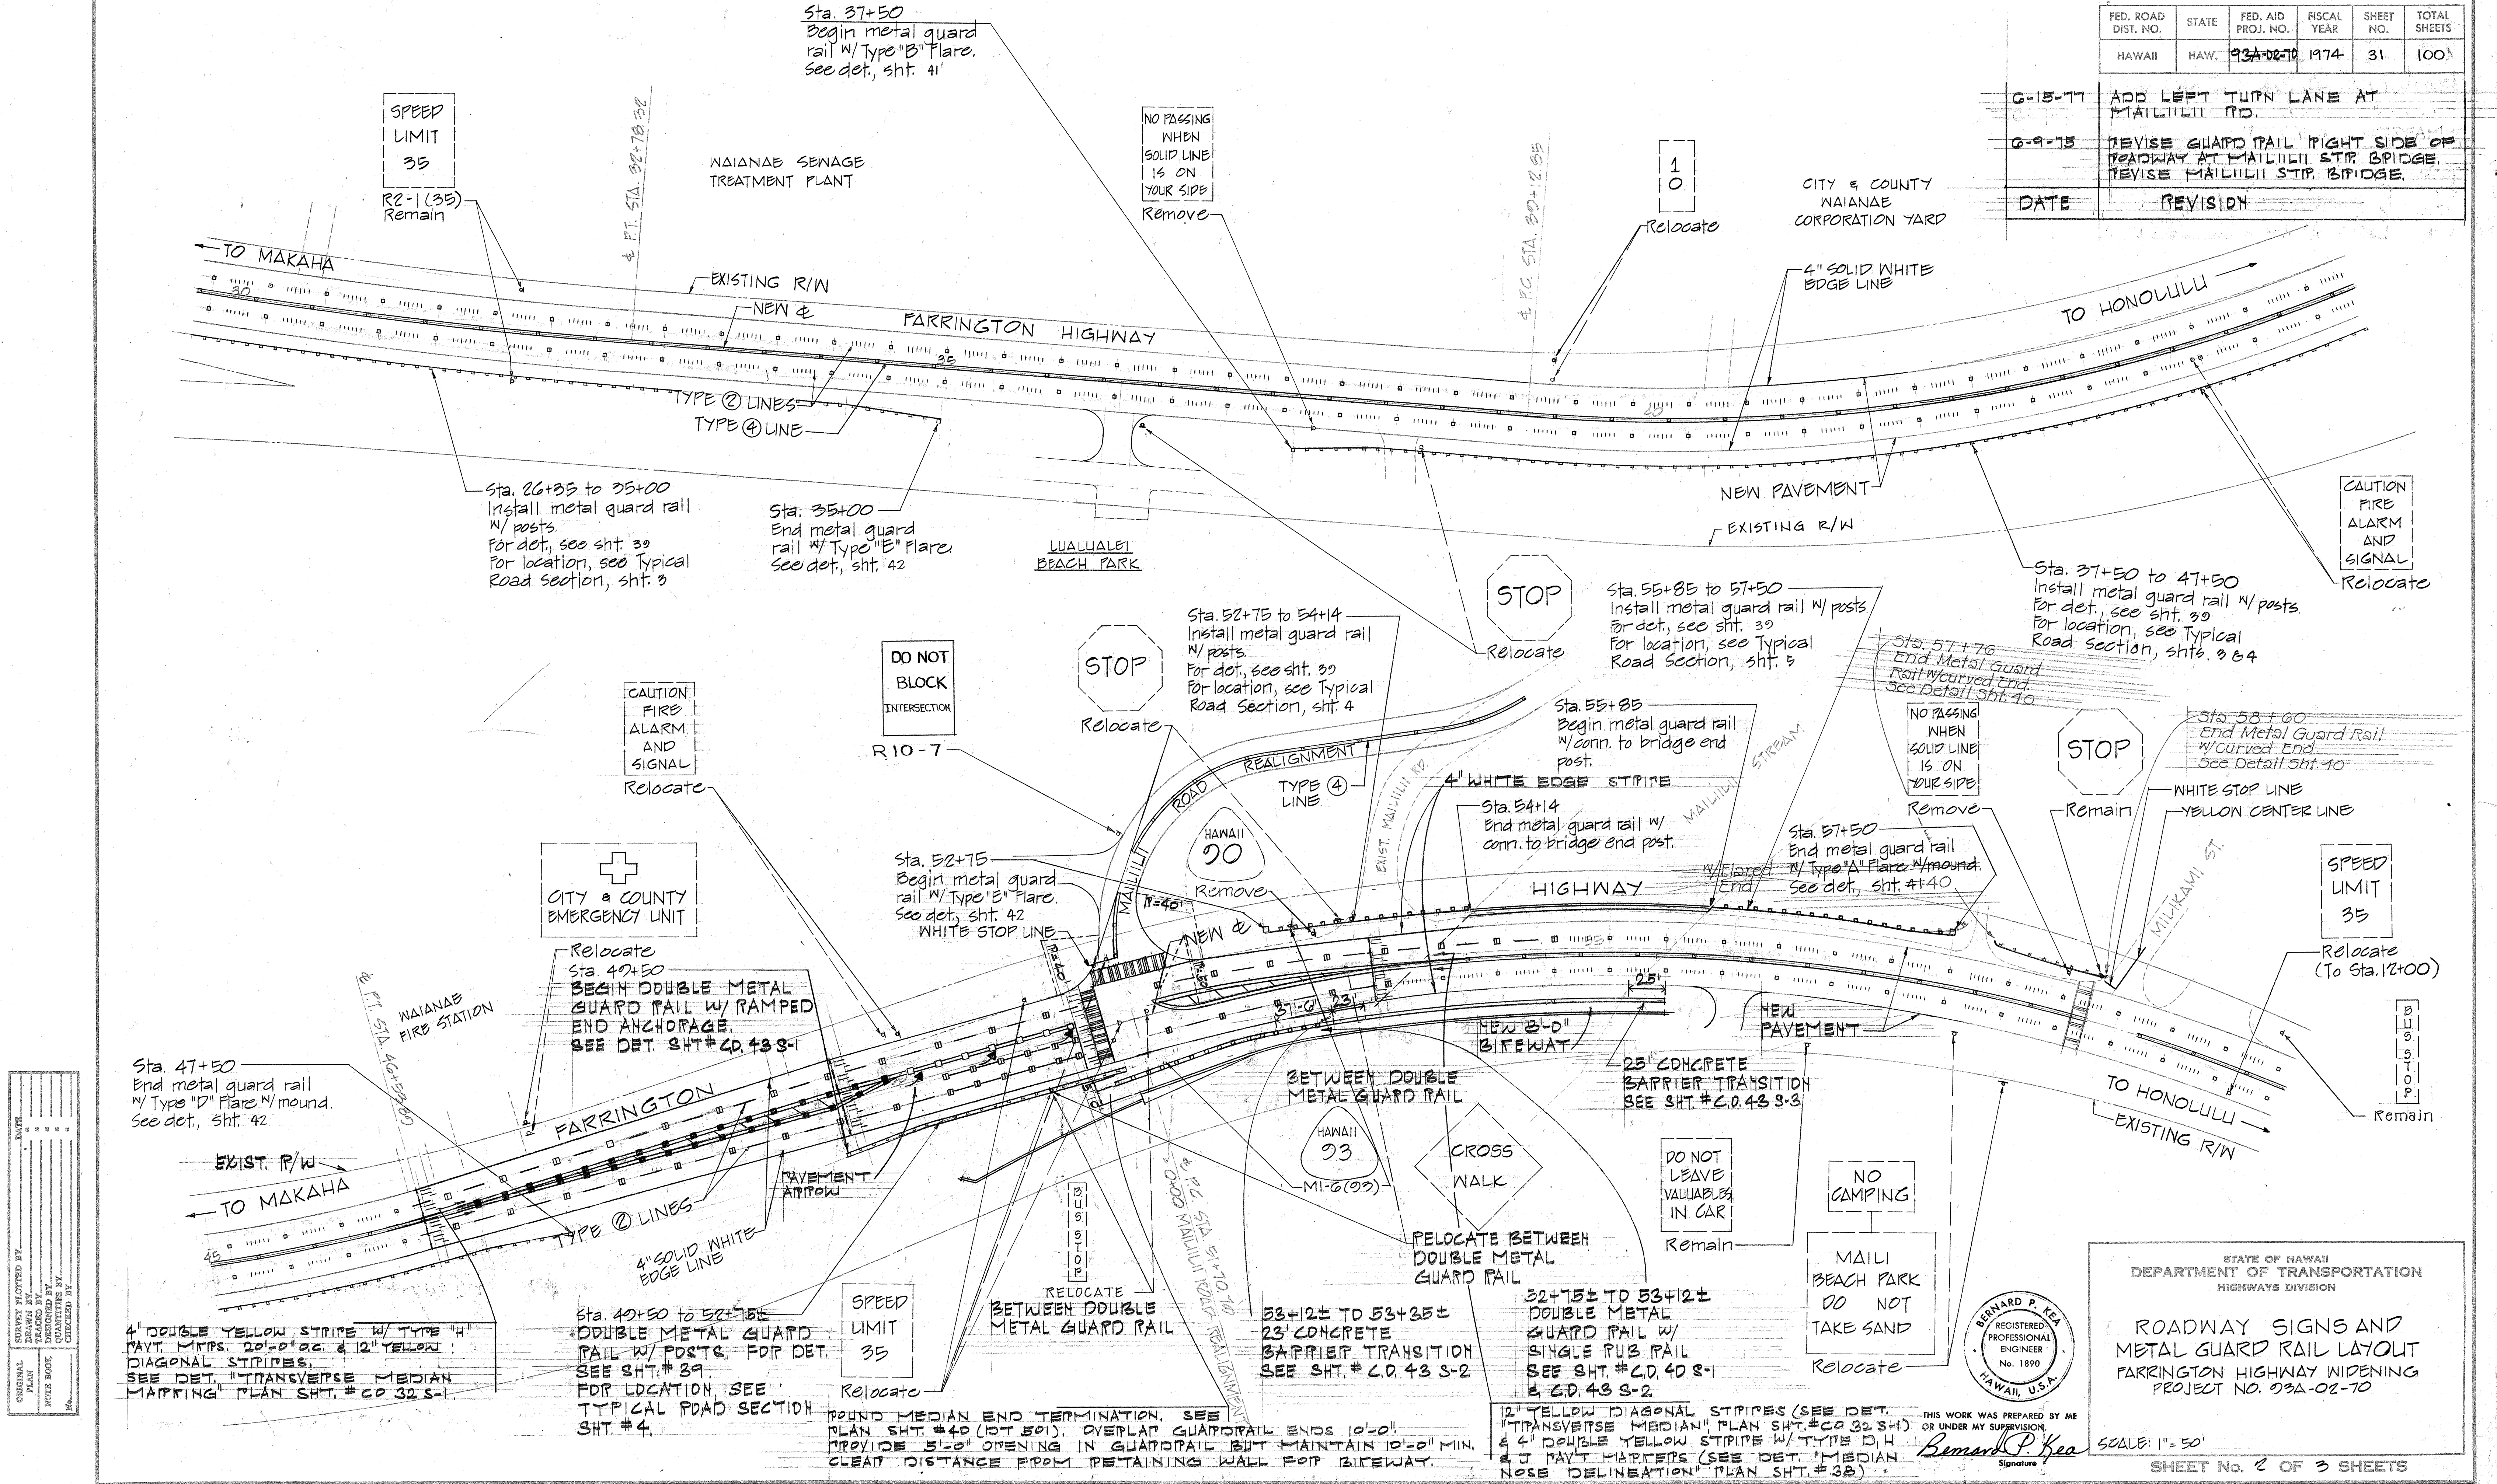

SURVEY PLOTTED BY	DATE
DESIGNED BY	
TRACED BY	
QUANTITIES BY	
CHECKED BY	
ORIGINAL PLAN	
NOTE BOOK	
FILE	

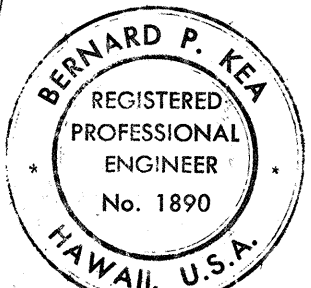


STATE OF HAWAII
DEPARTMENT OF TRANSPORTATION
HIGHWAYS DIVISION

ROADWAY SIGNS AND
METAL GUARD RAIL LAYOUT
FARRINGTON HIGHWAY WIDENING
PROJECT NO. 93A-02-70

THIS WORK WAS PREPARED BY ME
OR UNDER MY SUPERVISION
Bernard P. Kea
Signature

SCALE: 1" = 50'
SHEET No. 2 OF 3 SHEETS

PROJECT NO. 03A-02-70

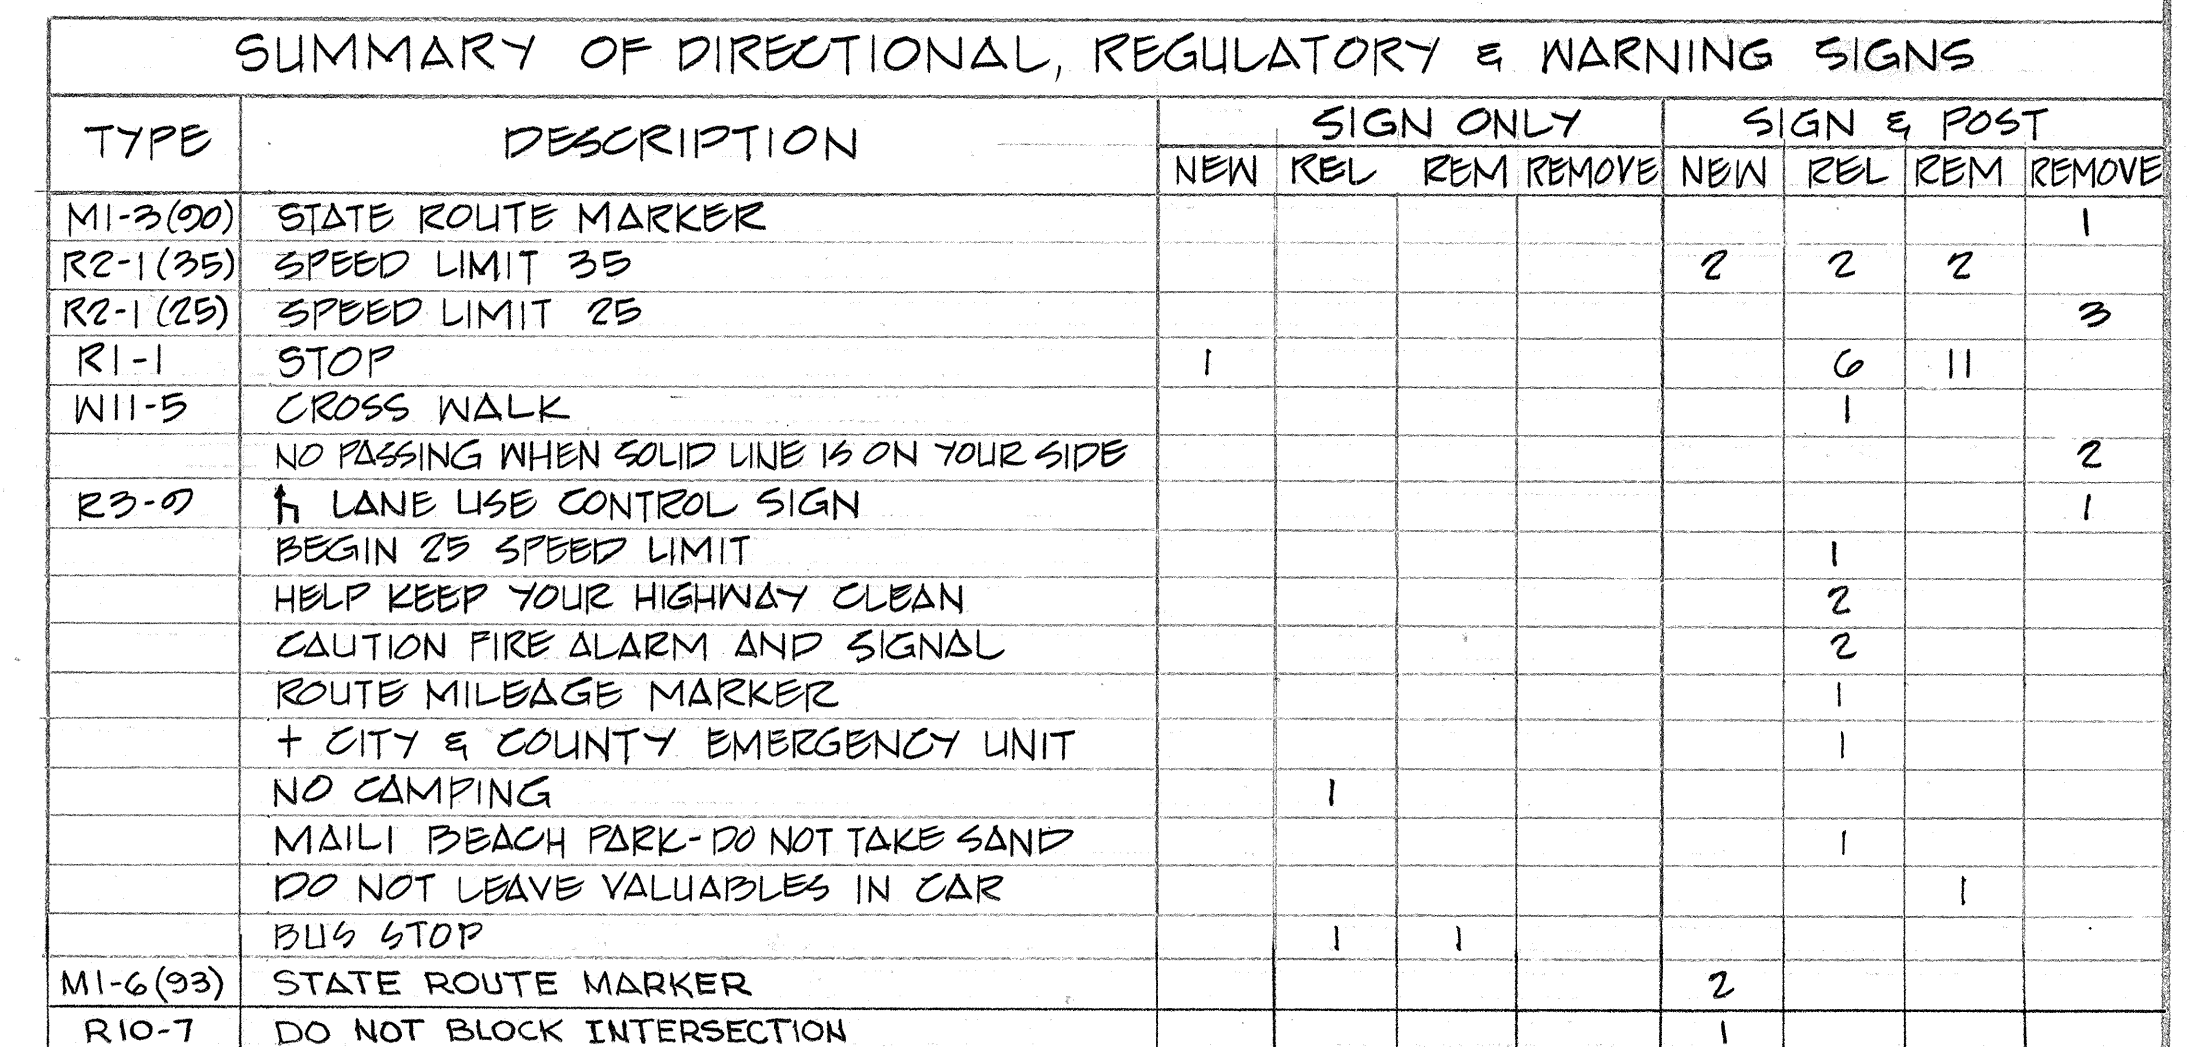











STATE OF HAWAII
DEPARTMENT OF TRANSPORTATION
HIGHWAYS DIVISION

ROADWAY SIGNS AND
METAL GUARD RAIL LAYOUT

FARRINGTON HIGHWAY WIDENING
PROJECT NO. 93A-02-70

SCALE: 1" = 50'

SHEET NO. 3 OF 3 SHEETS

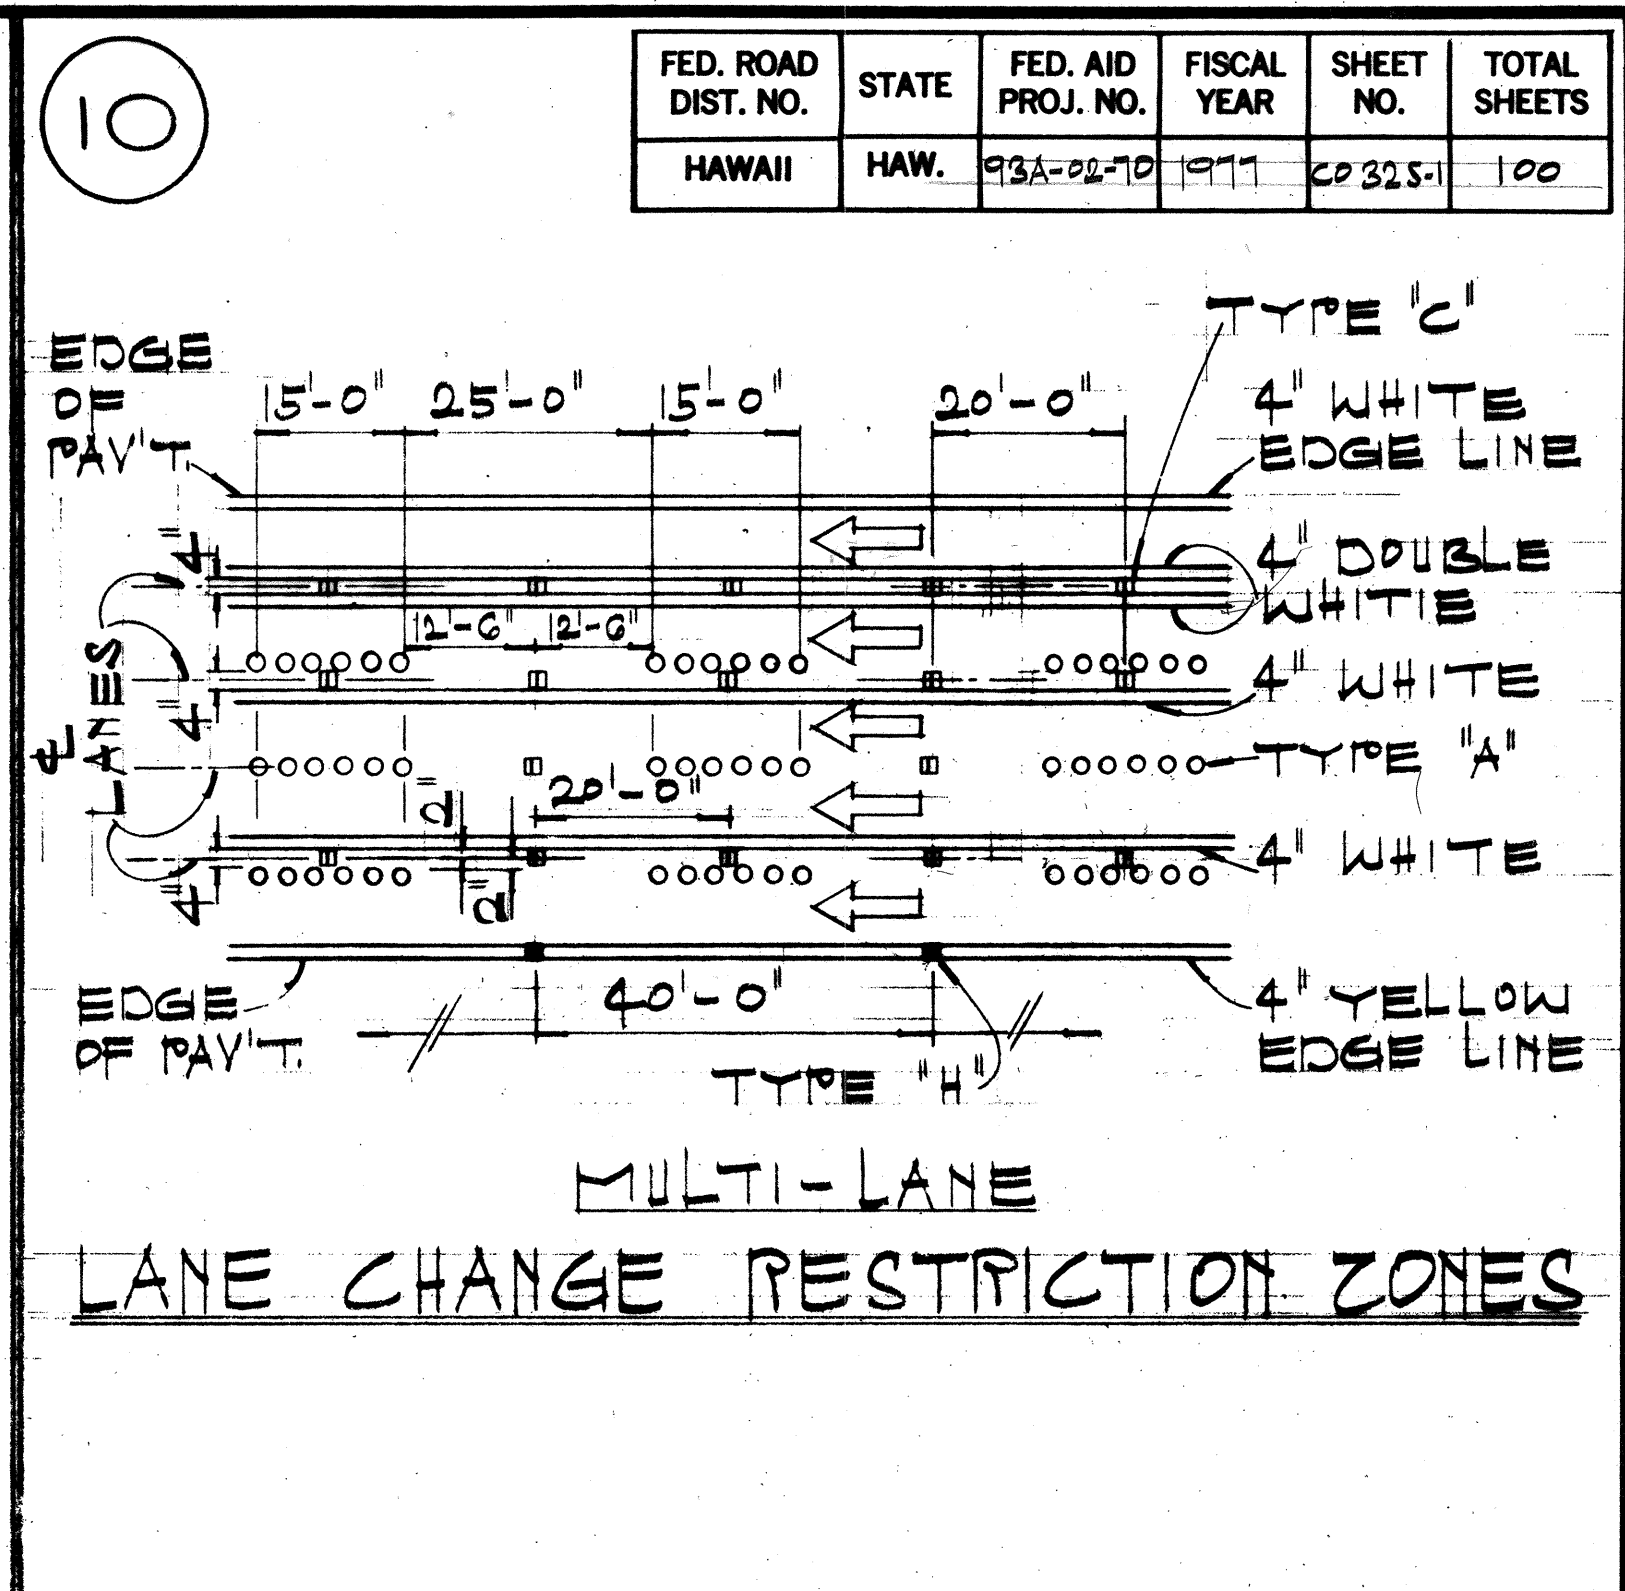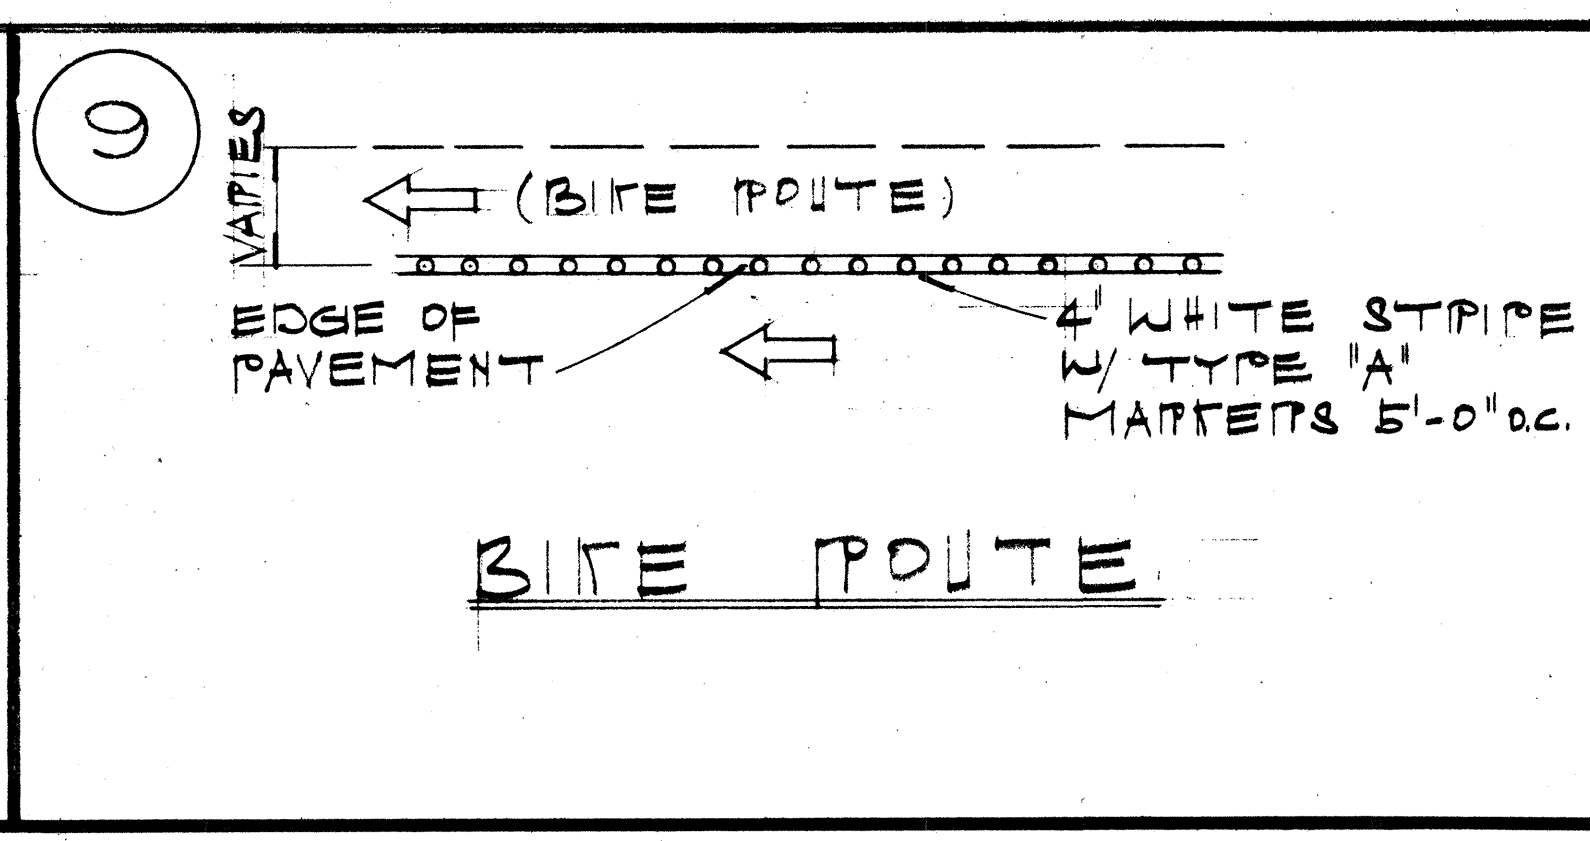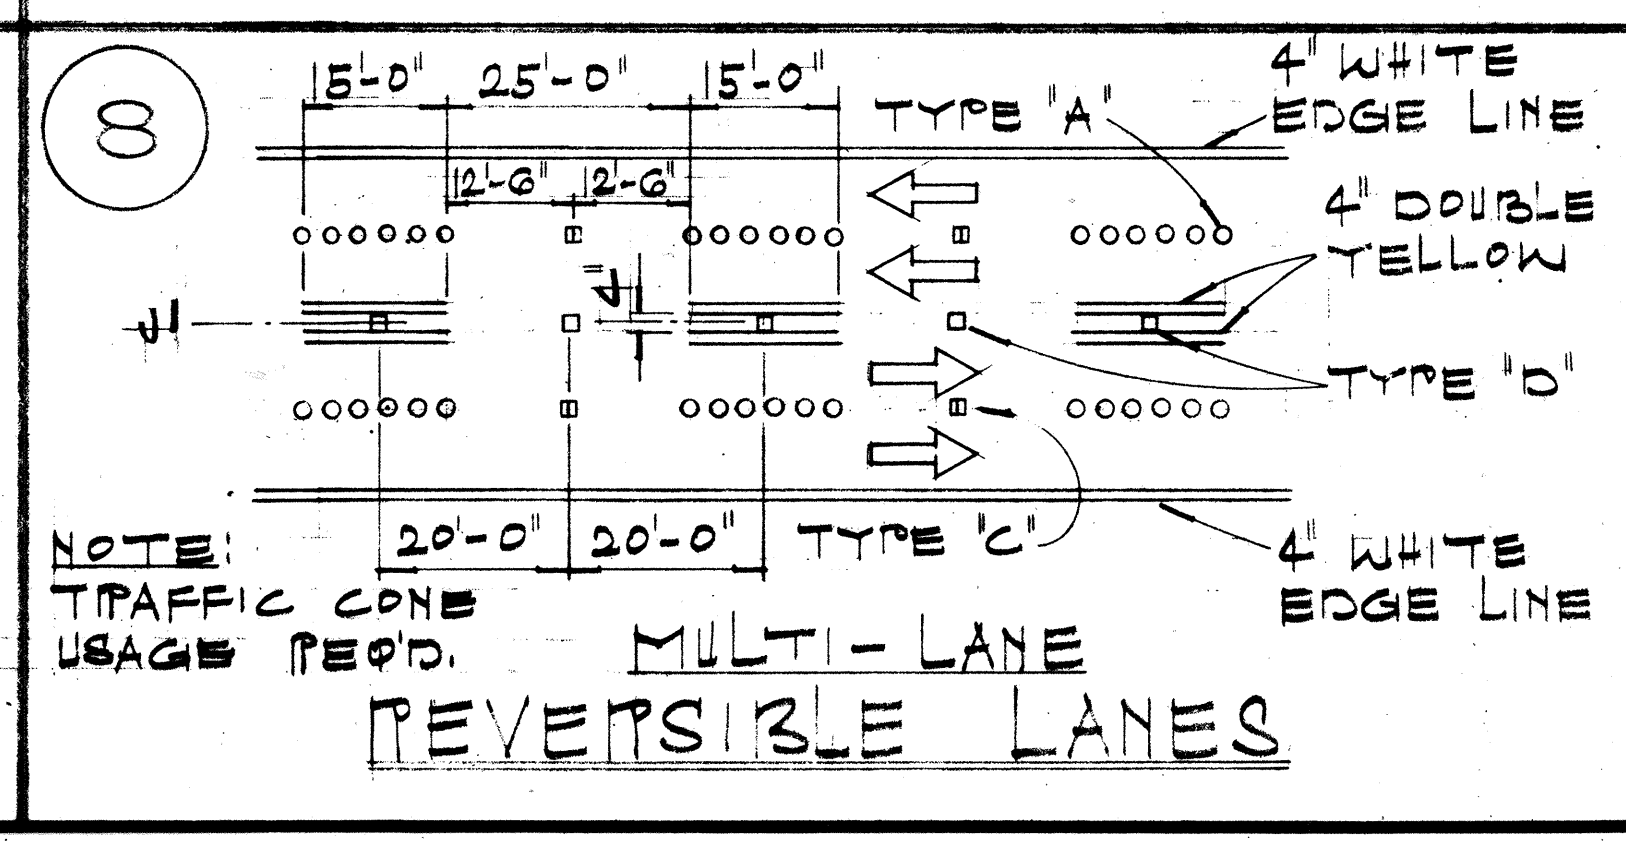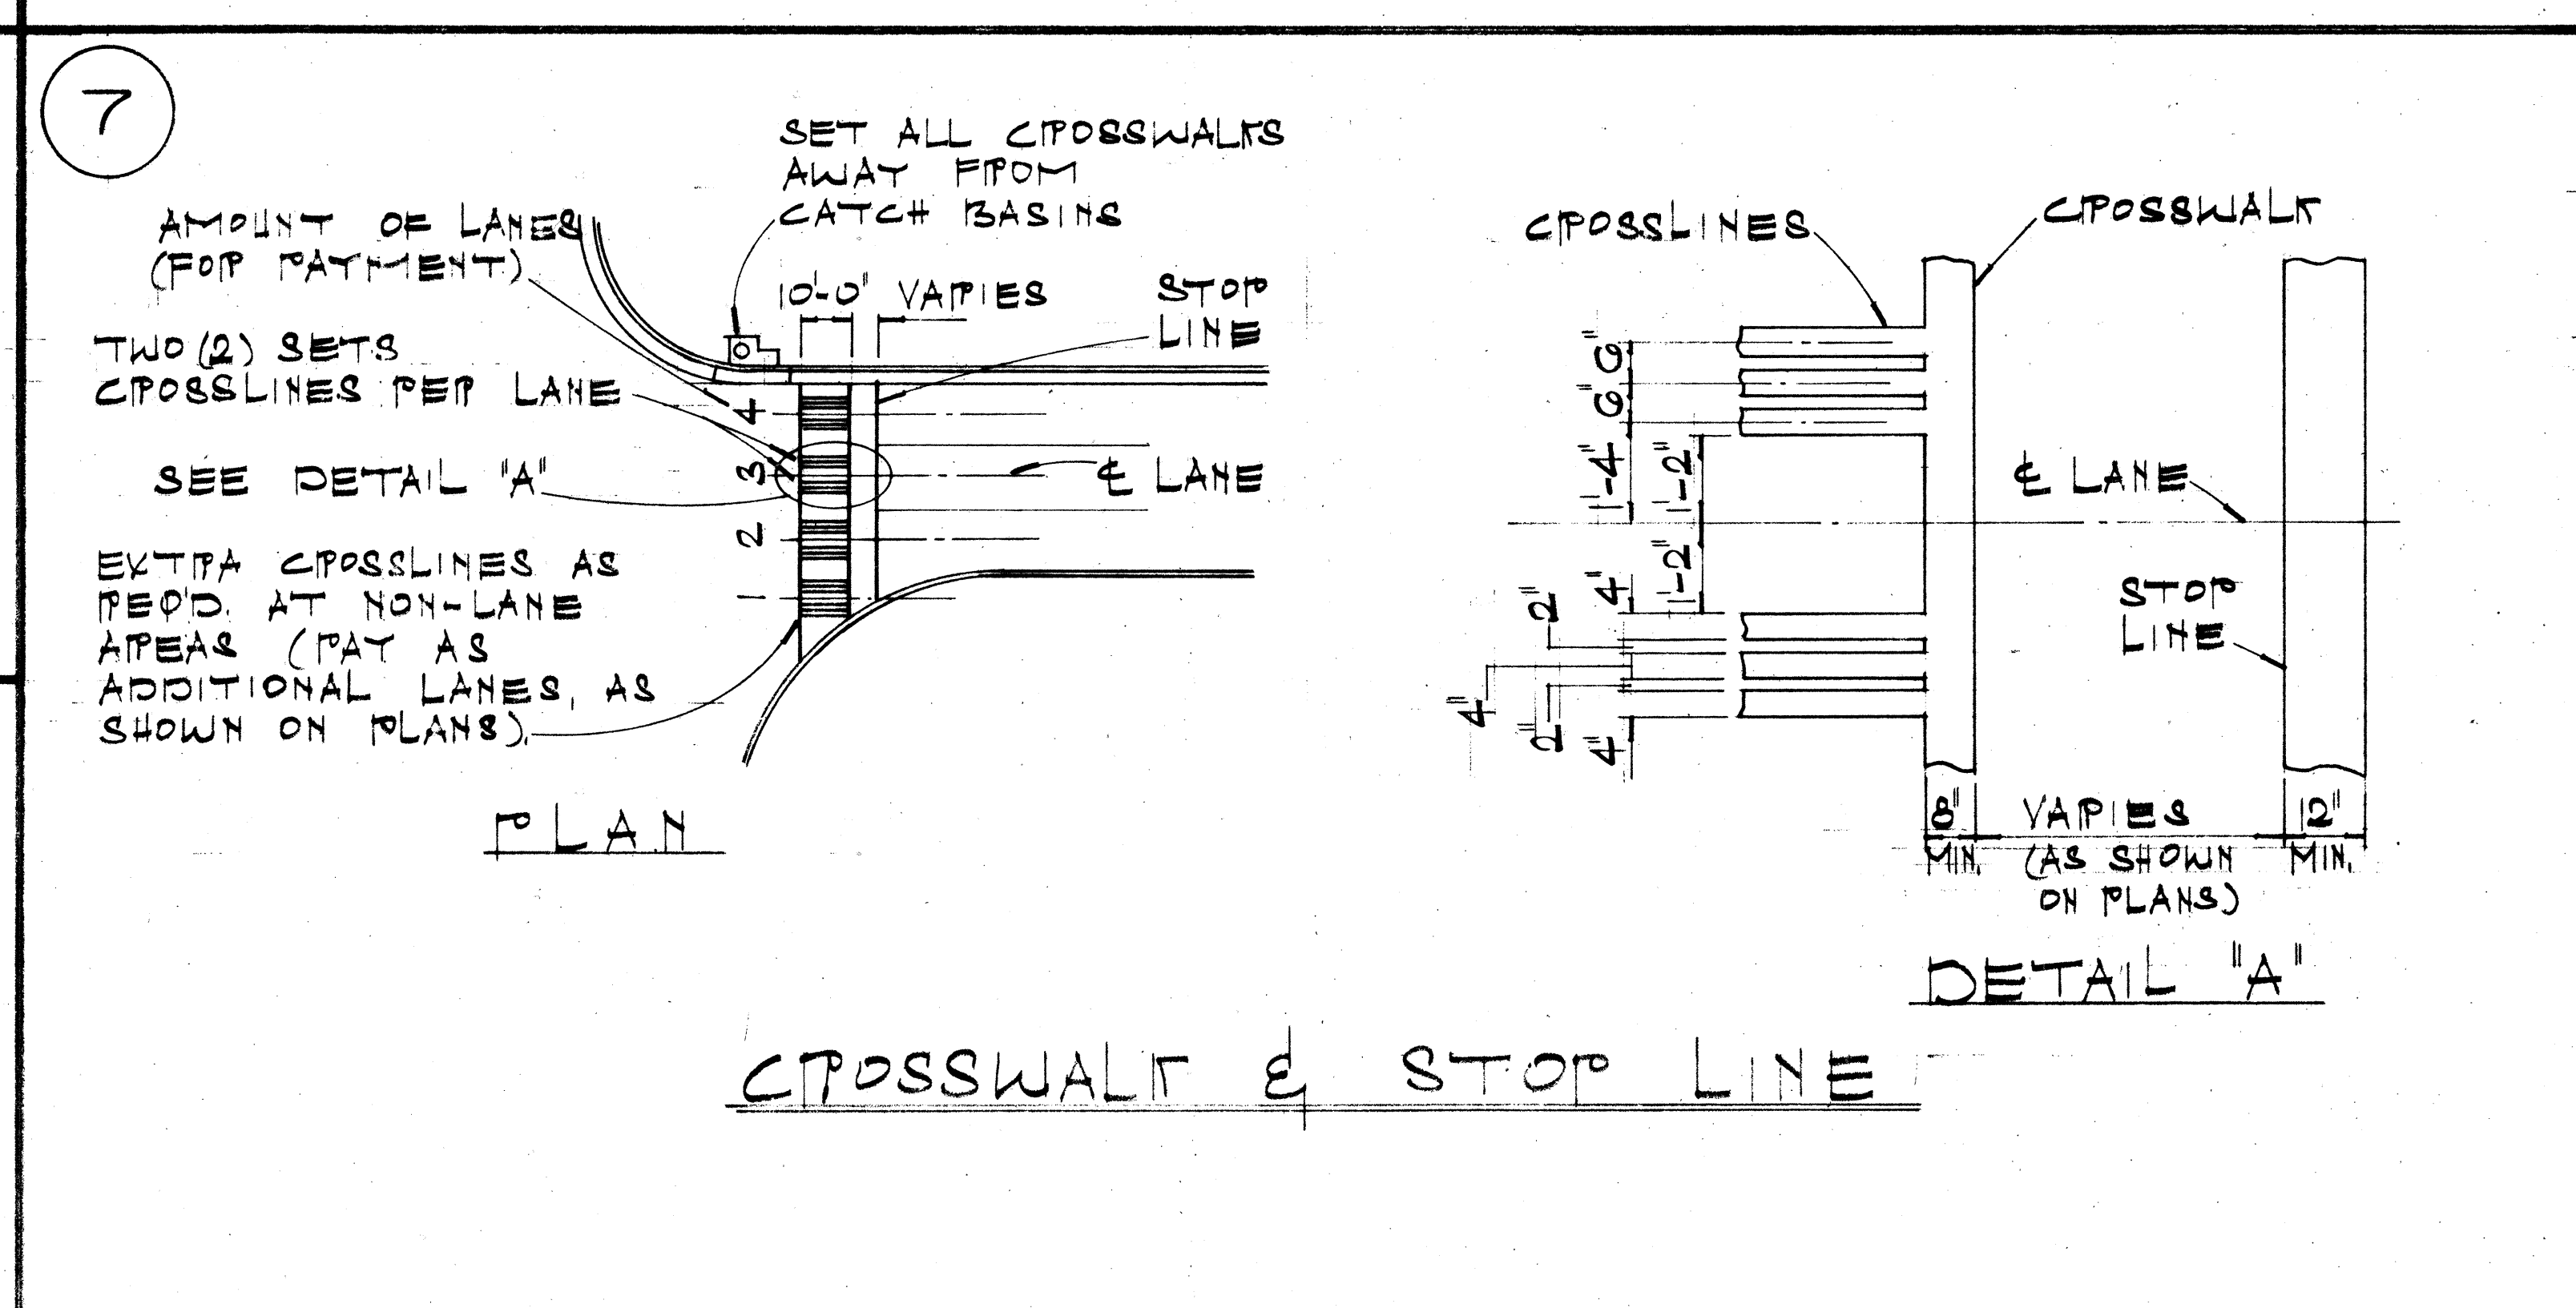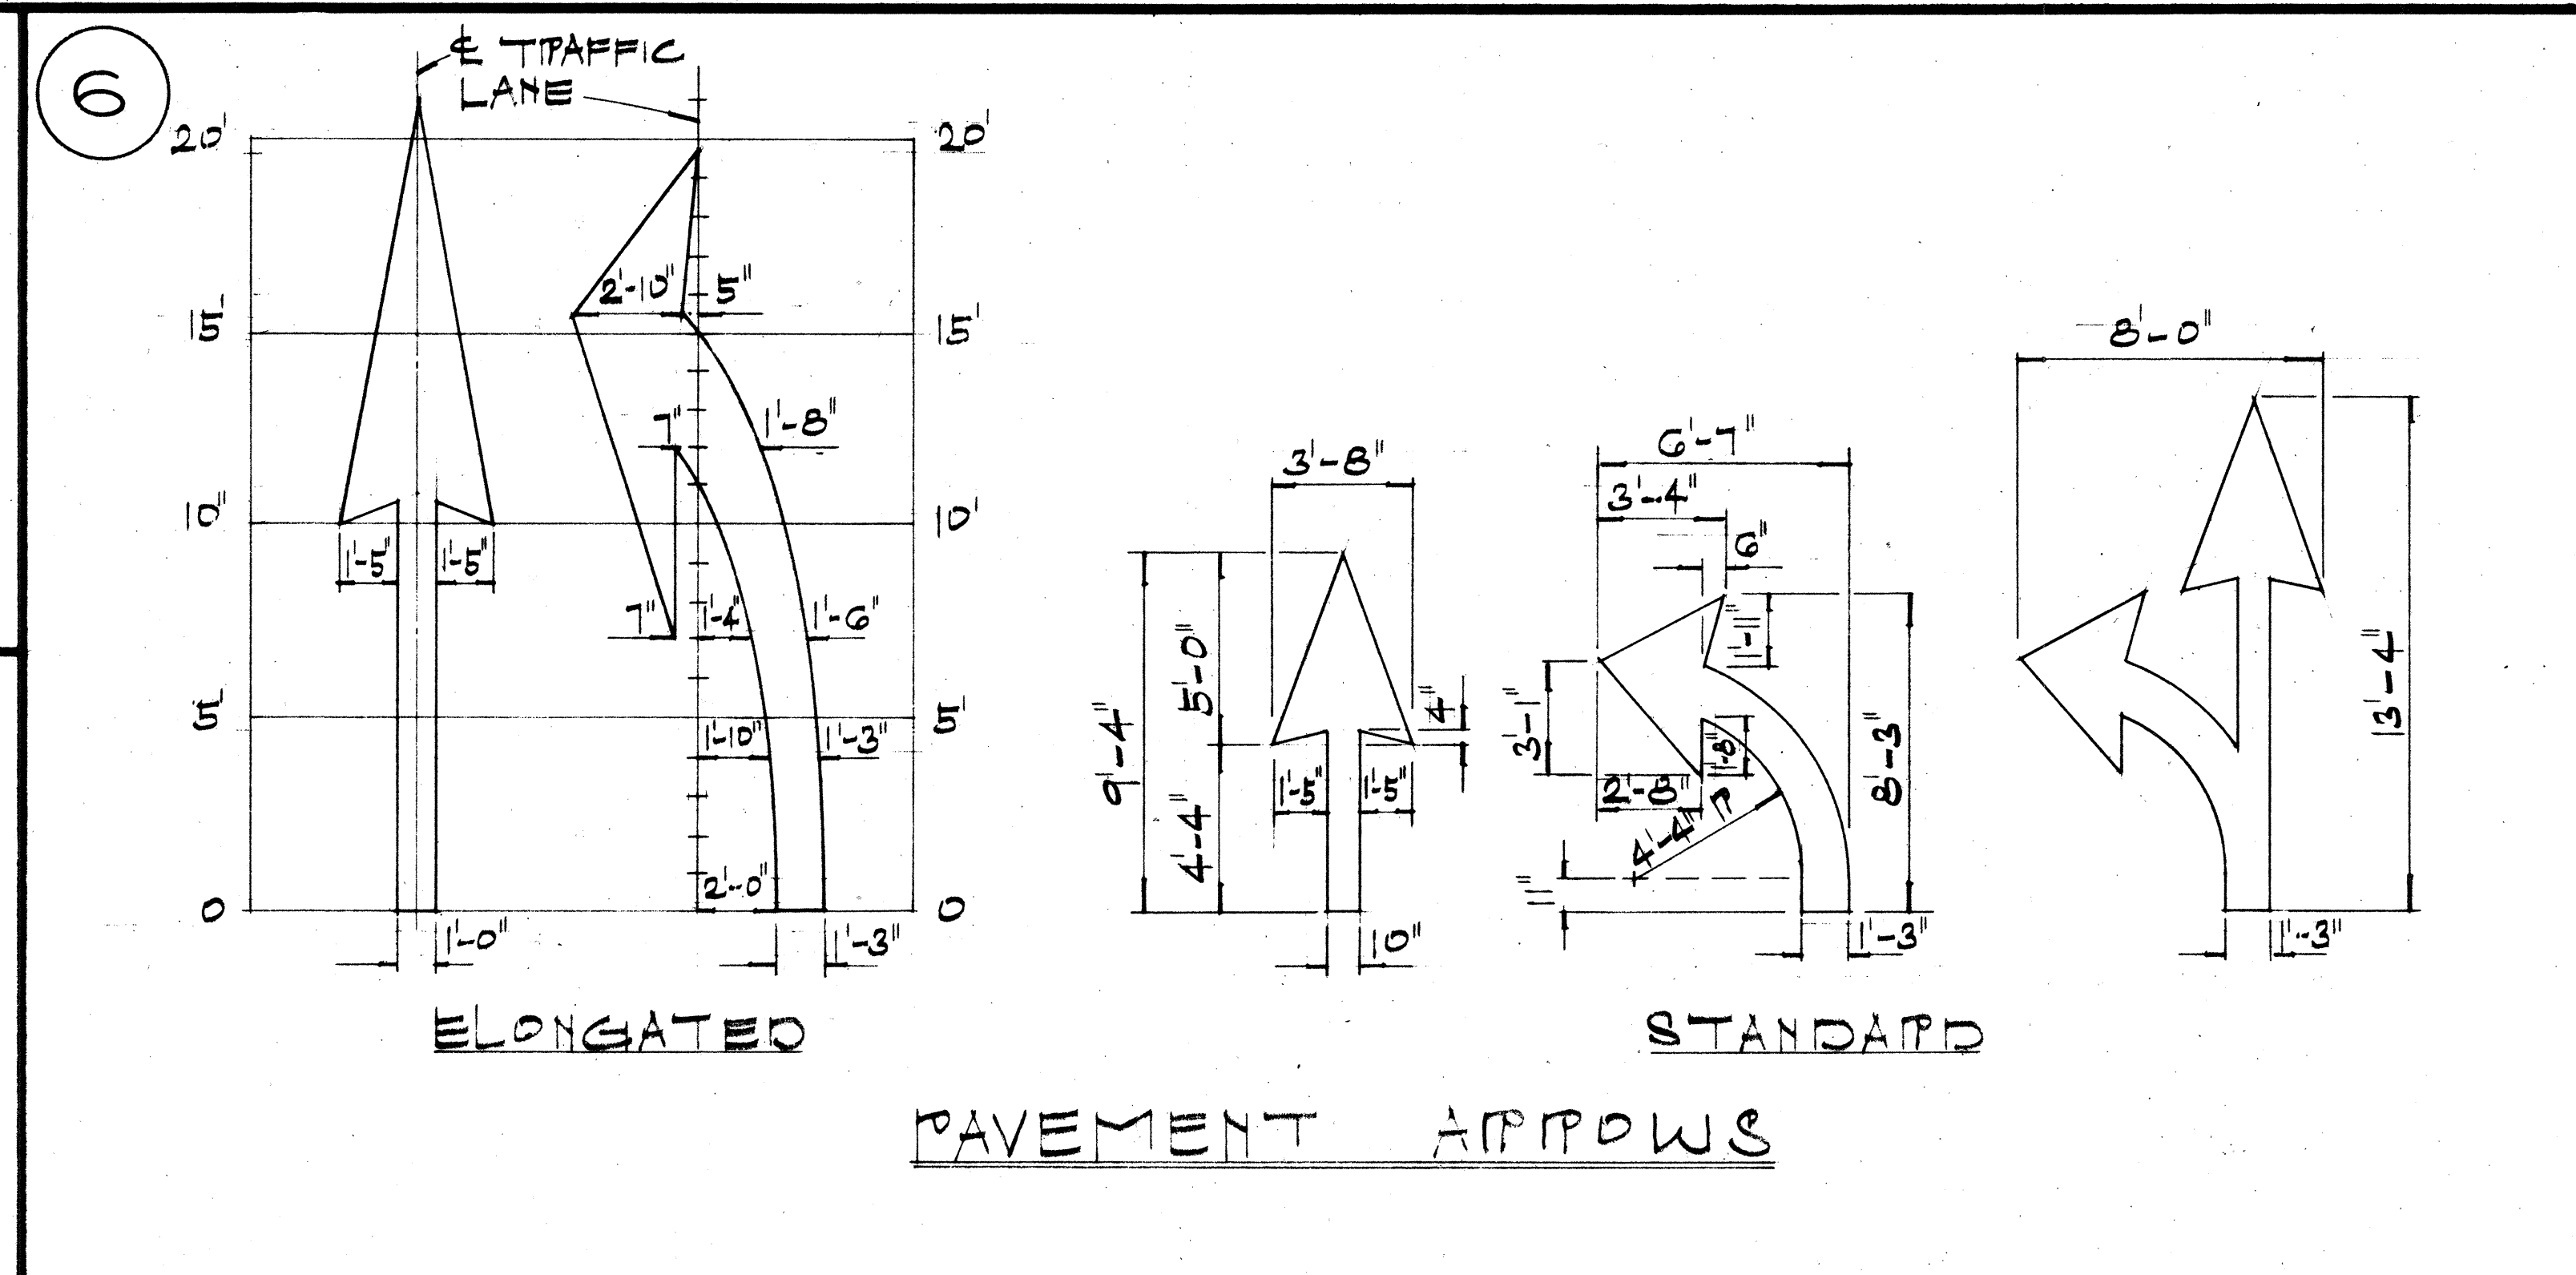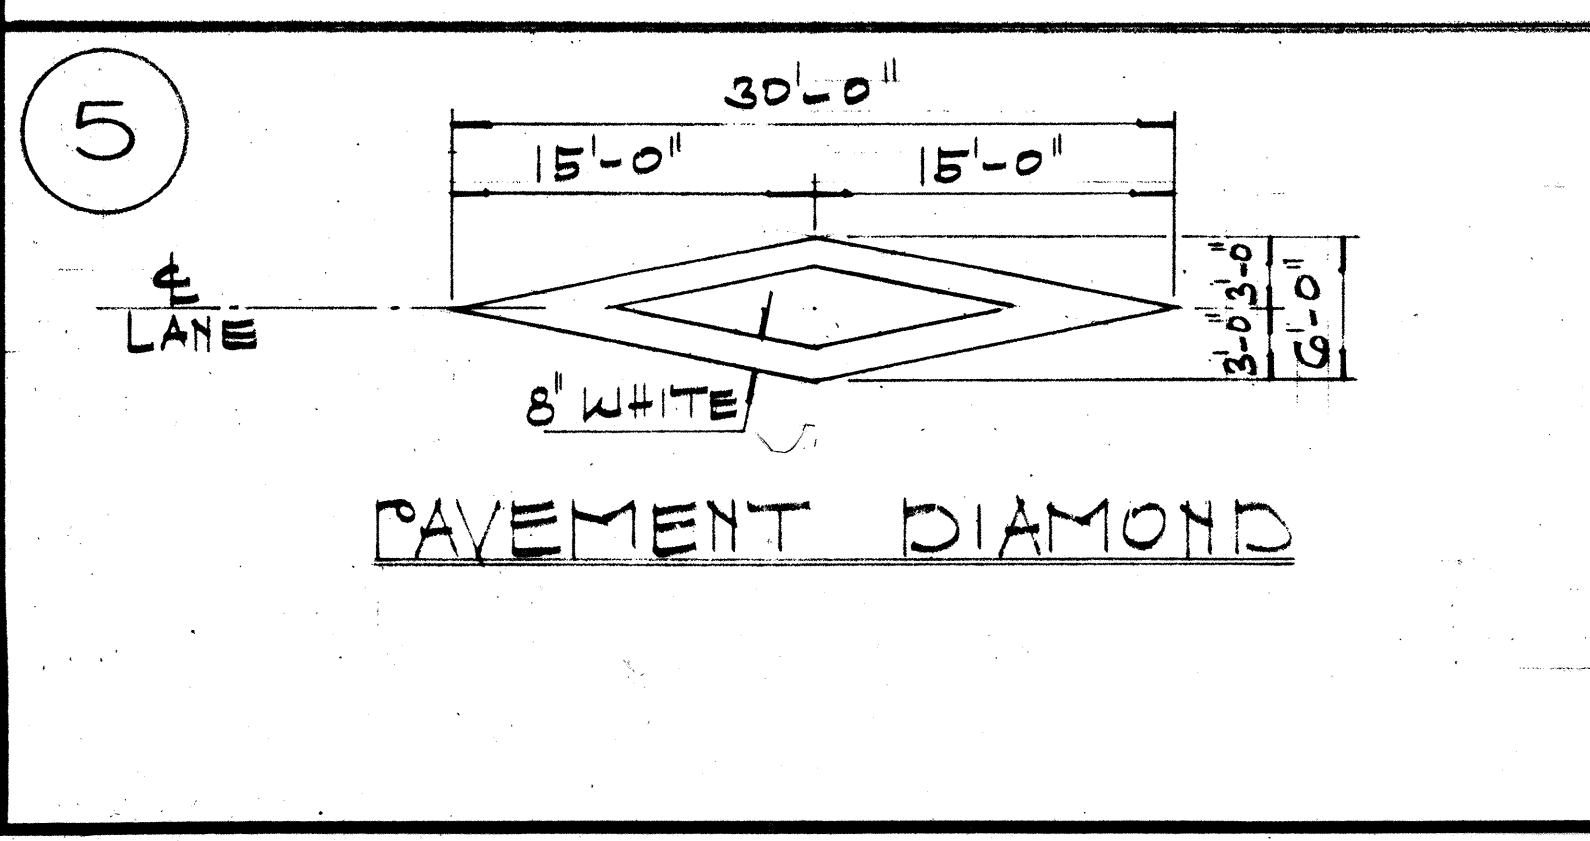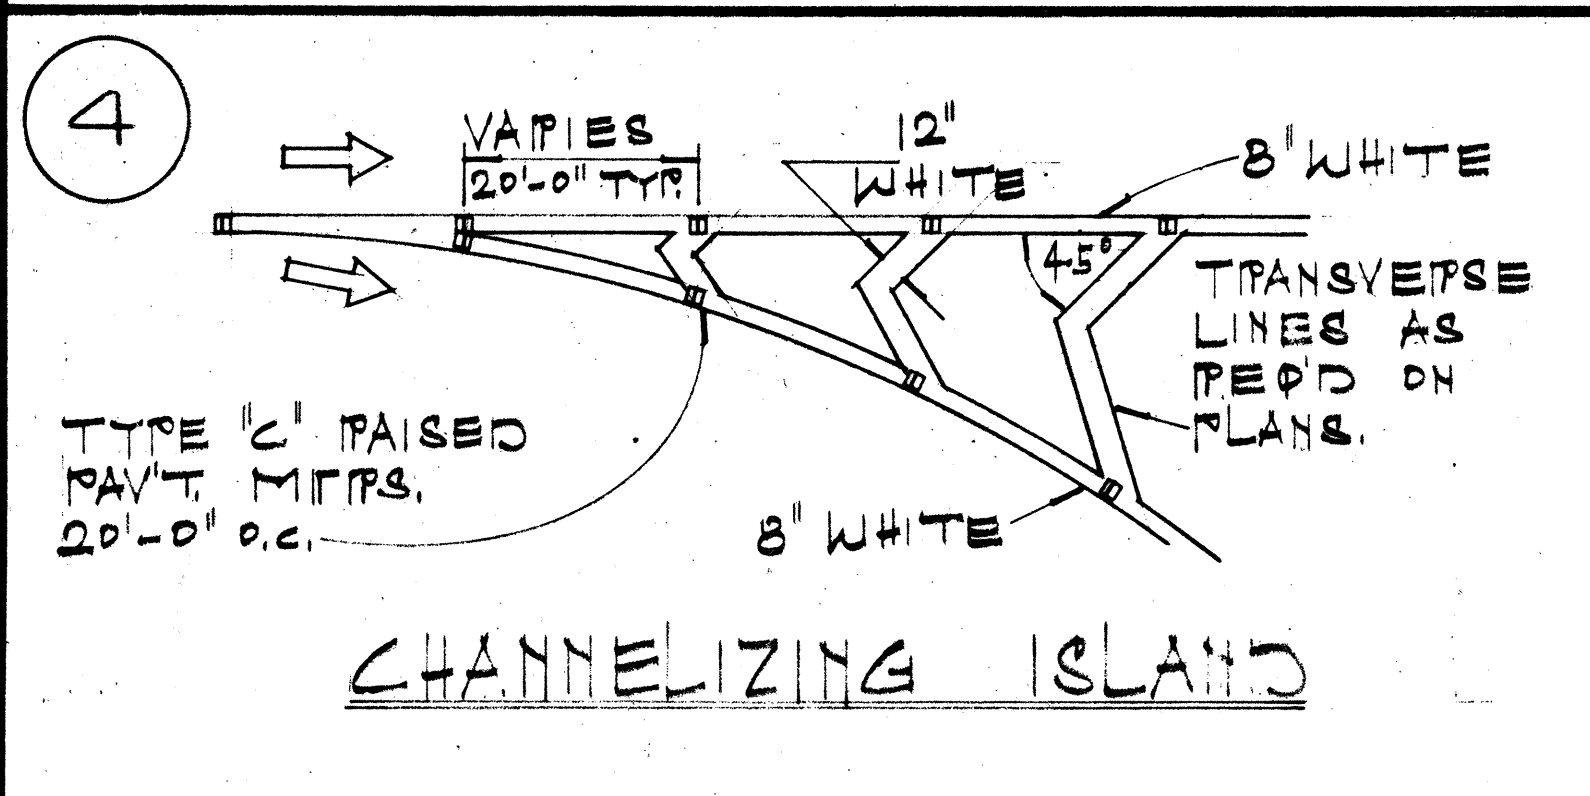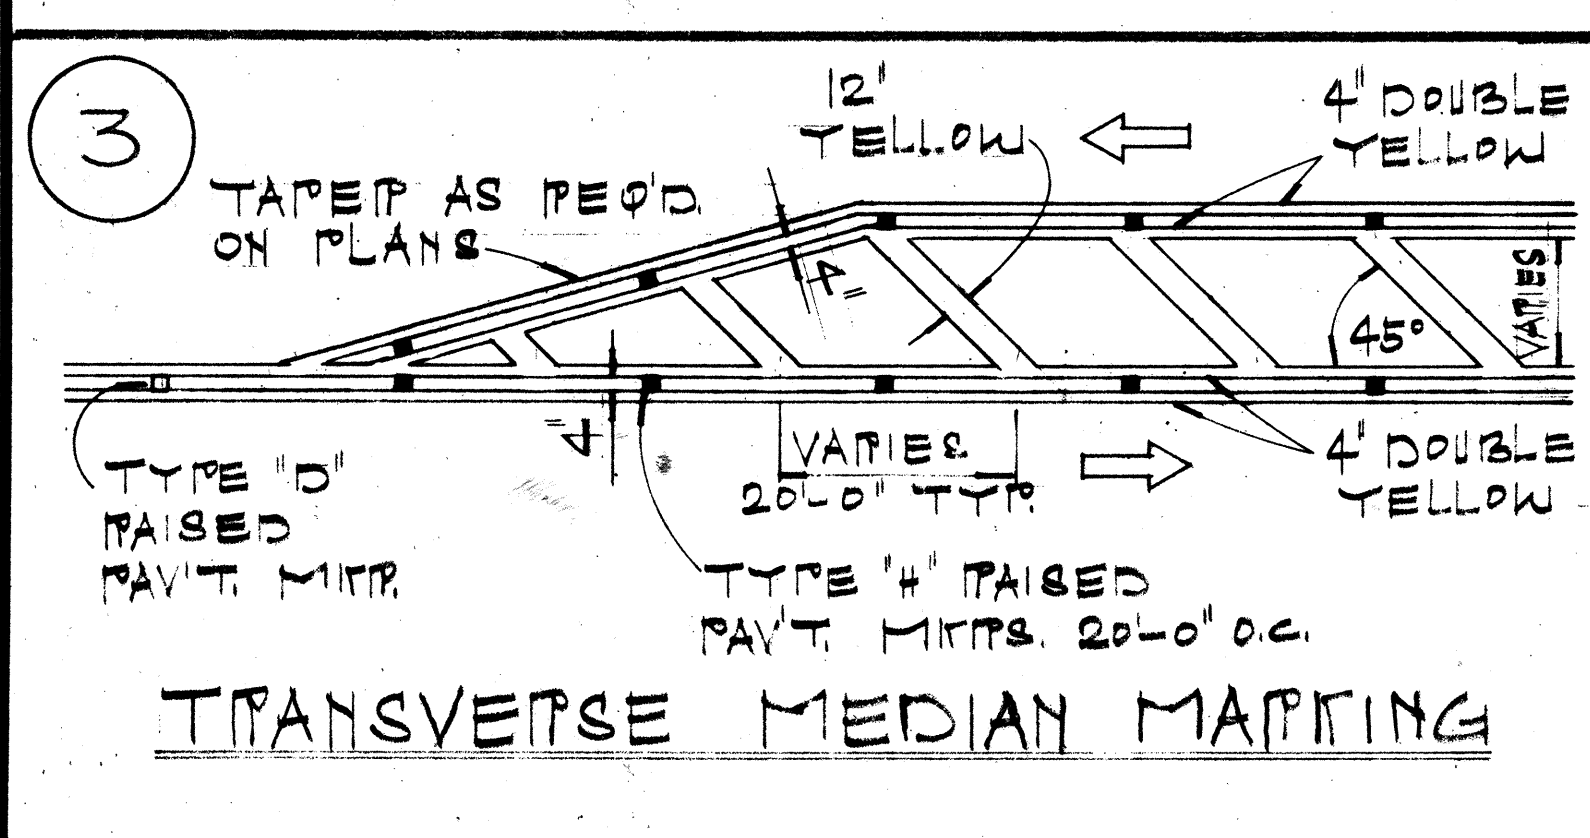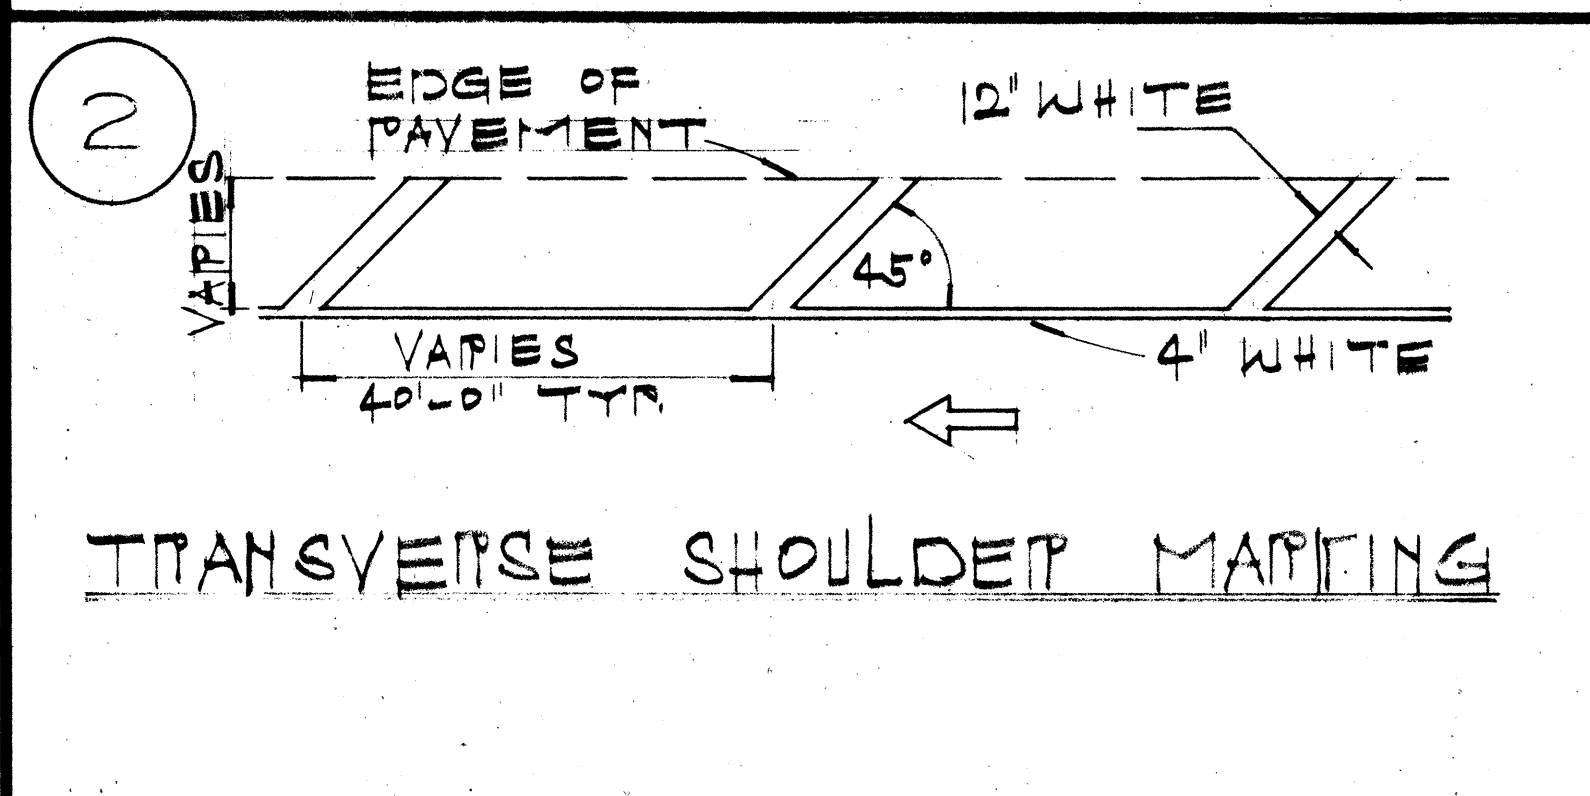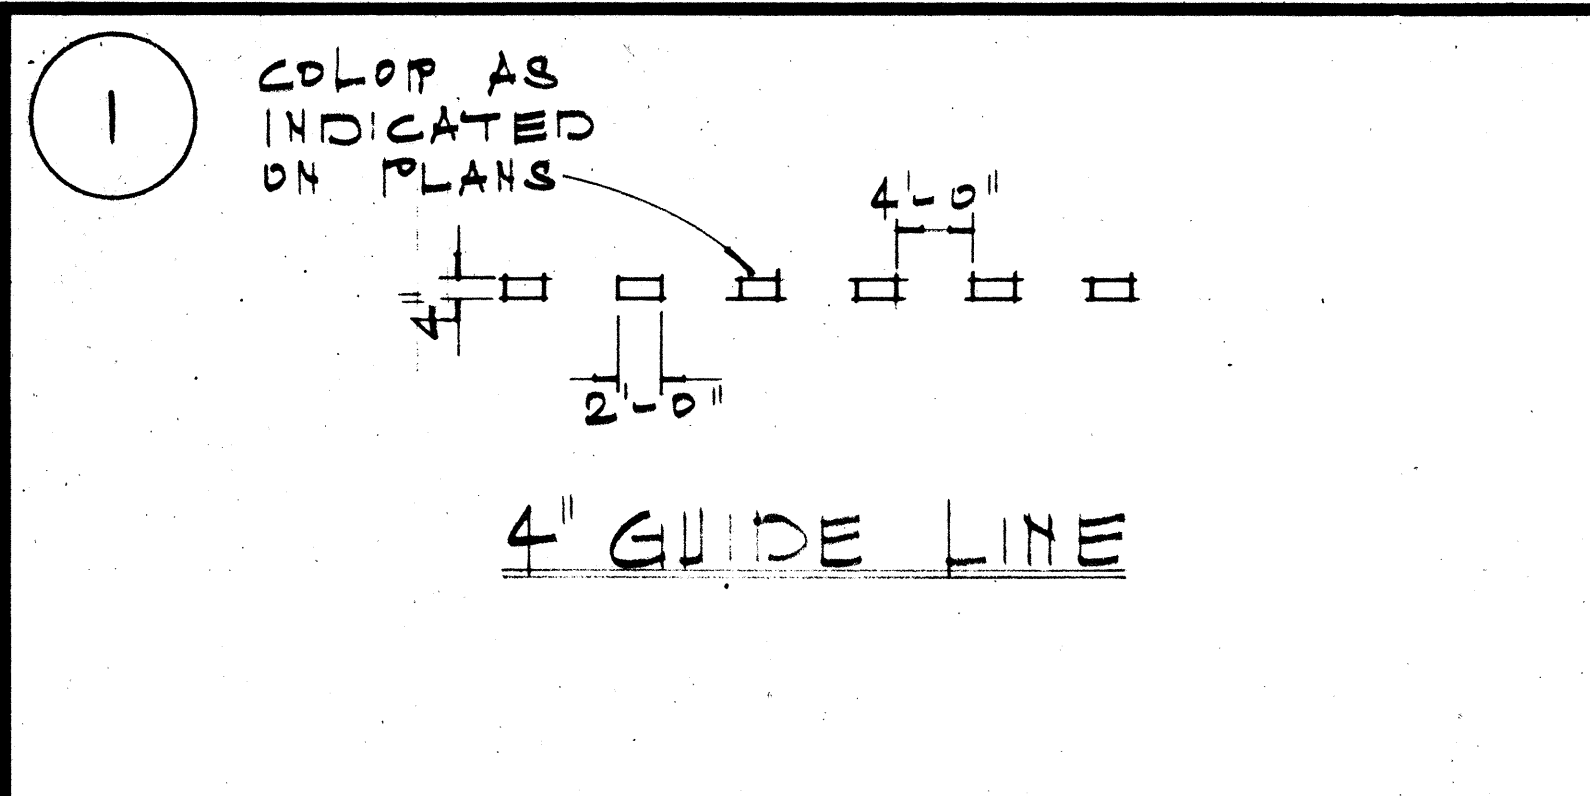

GENERAL NOTES:

- PAVEMENT MARKINGS SHALL CONFORM TO THE "MANUAL ON UNIFORM TRAFFIC CONTROL DEVICES FOR STREETS & HIGHWAYS", 1971, (MUTCD), SUBSEQUENT REVISIONS TO THE MUTCD & AS SHOWN ON THE PLANS.
- LAYOUT OF PAVEMENT MARKINGS & STRIPING SHALL BE DONE BY THE CONTRACTOR. THE CONTRACTOR SHALL CHECK LAYOUT OF MARKERS & STRIPING WITH THE ENGINEER PRIOR TO PERFORMING WORK.
- FOR ADDITIONAL PAVEMENT MARKING DETAILS SEE SHT. # DT-300

STATE OF HAWAII
DEPARTMENT OF TRANSPORTATION
HIGHWAYS DIVISION

**TYPICAL DETAILS
MISCELLANEOUS
PAVEMENT MARKINGS**

PROJ. No. 93A-02-70

NOT TO SCALE JULY 1976

SHEET No. 10 OF 10 SHEETS

FED. ROAD DIST. NO.	STATE	FED. AID PROJ. NO.	FISCAL YEAR	SHEET NO.	TOTAL SHEETS
HAWAII	HAW.	93A-02-70	1977	CP 325-1	100

SURVEY PLOTTED BY	DATE
DRAWN BY	
DESIGNED BY	
QUANTITIES BY	
CHECKED BY	