



FED. ROAD DIST. NO.	STATE	PROJ. NO.	FISCAL YEAR	SHEET NO.	TOTAL SHEETS
HAWAII	HAW.	93A-01-75	1975	2	17

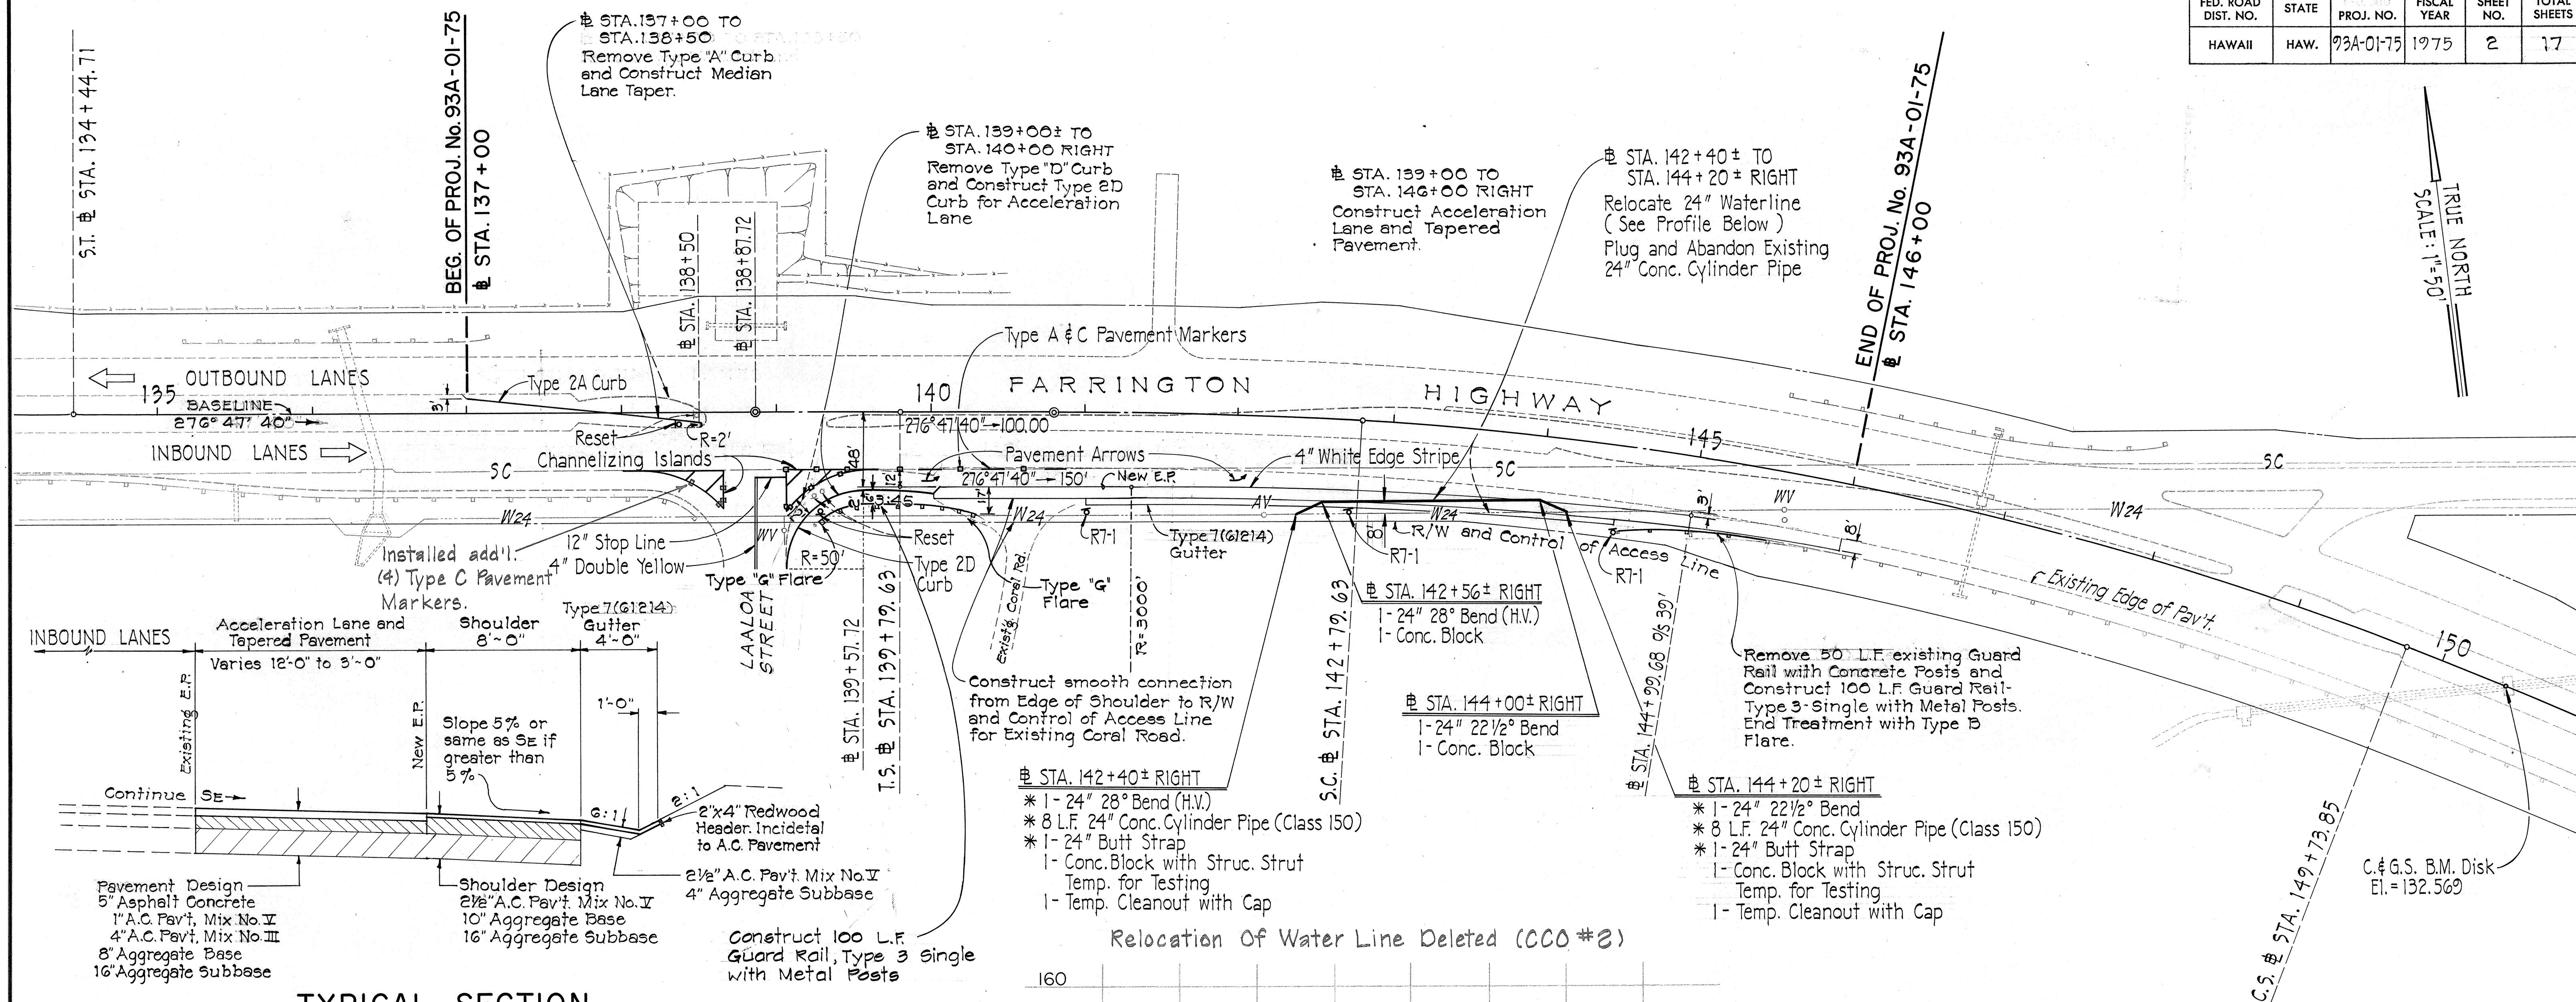

**TYPICAL SECTION
ACCELERATION LANE AND
TAPERED PAVEMENT**

SCALE: 1" = 4' - 0"

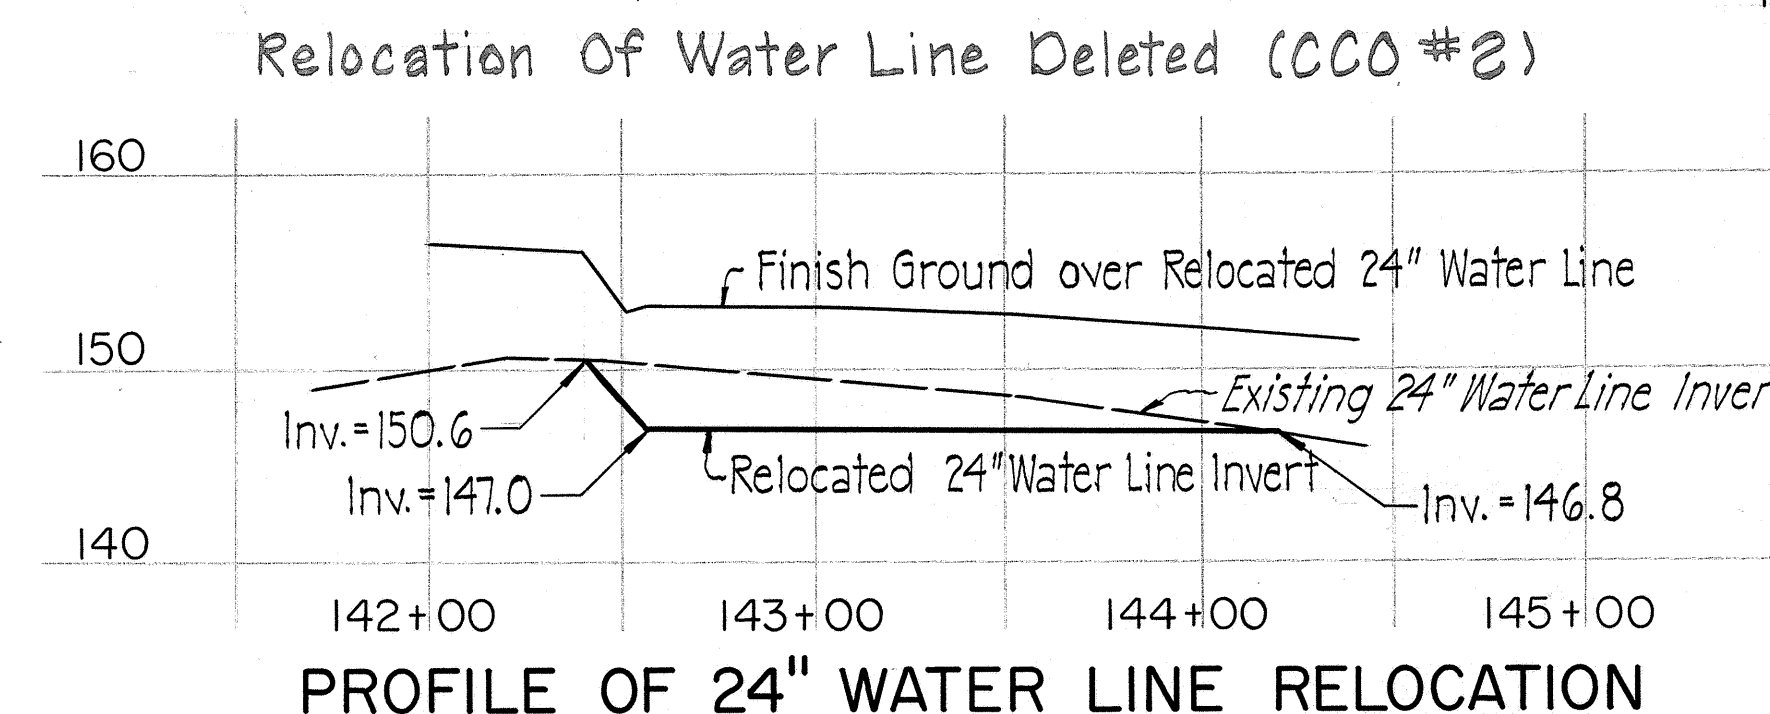

GENERAL WATER NOTES

- Unless otherwise specified, all materials and construction of water system facilities and appurtenances shall be in accordance with the STANDARD SPECIFICATIONS FOR ROAD AND BRIDGE CONSTRUCTION, dated 1969, as amended, of the Hawaii Highways Division, Department of Transportation.
- Prior to excavating for new drain, sewer and other utility lines, the Contractor shall verify in the field the location of existing water mains and appurtenances. Where the installation of new drain, sewer or other utility lines are to cross over or under existing water mains, the Contractor shall expose the existing water mains prior to trenching. Excavation around water mains shall be done by hand.
- Asterisk (*) indicates work to be performed by Board of Water Supply. Materials to be furnished by the Contractor.
- The Contractor shall notify the Board of Water Supply in writing one week prior to commencing work on the main.
- Approval by the Board of Water Supply is based solely on the adequacy of the water supply. Discrepancies, if any, of alignments, grades, fittings, etc. shall be the responsibility of the Engineer who prepared the plans.
- The existence and location of underground utilities and structures as shown on the plans are from the latest available data but is not guaranteed as to the accuracy or the encountering of other obstacles during the course of the work. The Contractor shall be responsible and shall pay for all damages to existing utilities.

NOTE:
For Traffic Pavement Striping and Marking and
Sign Installation Summaries See Sheet 3

10/9/75	Added Additional Guardrail
Date	Revision

APPROVED:
[Signature] 10/17/75
ASS'T. CHIEF ENGINEER, BWS DATE

STATE OF HAWAII
DEPARTMENT OF TRANSPORTATION
HIGHWAYS DIVISION
PLAN AND DETAILS
FARRINGTON HWY. IMPROVEMENTS
AT LAALOA STREET
PROJECT NO. 93A-01-75
Scale: As Noted October 1974
SHEET No. 1 OF 1 SHEETS

TYPICAL MEDIAN LANE TAPER

SCALE: 1" = 4' - 0"

SURVEY PLOTTED BY	DATE
DRAWN BY	
TRACED BY	
QUANTITIES BY	
CHECKED BY	
ORIGINAL PLAN	
NOTE BOOK	
No.	