INDEX TO DRAWINGS	
SHEET NO.	DESCRIPTION
	TITLE SHEET
2	PLAN AND DETAILS
3	TYPICAL DETAILS OF
	PAVEMENT MARKINGS
4 - 12	STANDARD DETAILS
13 - 15	UTILITY STANDARDS
16 - 17	CROSS SECTIONS
* 1 \$1	many.
anna an deireann an gear ann an ann an an ann an an an an an an	
7	
	, j



STATE OF HAWAII

DEPARTMENT OF TRANSPORTATION HIGHWAYS DIVISION

HONOLULU, HAWAII

PLANS FOR


FARRINGTON HIGHWAY IMPROVEMENTS


ACCELERATION LANE AND TAPERED PAVEMENT

AT LAALOA STREET

PROJECT NO. 93A-01-75

DISTRICT OF EWA ISLAND OF OAHU

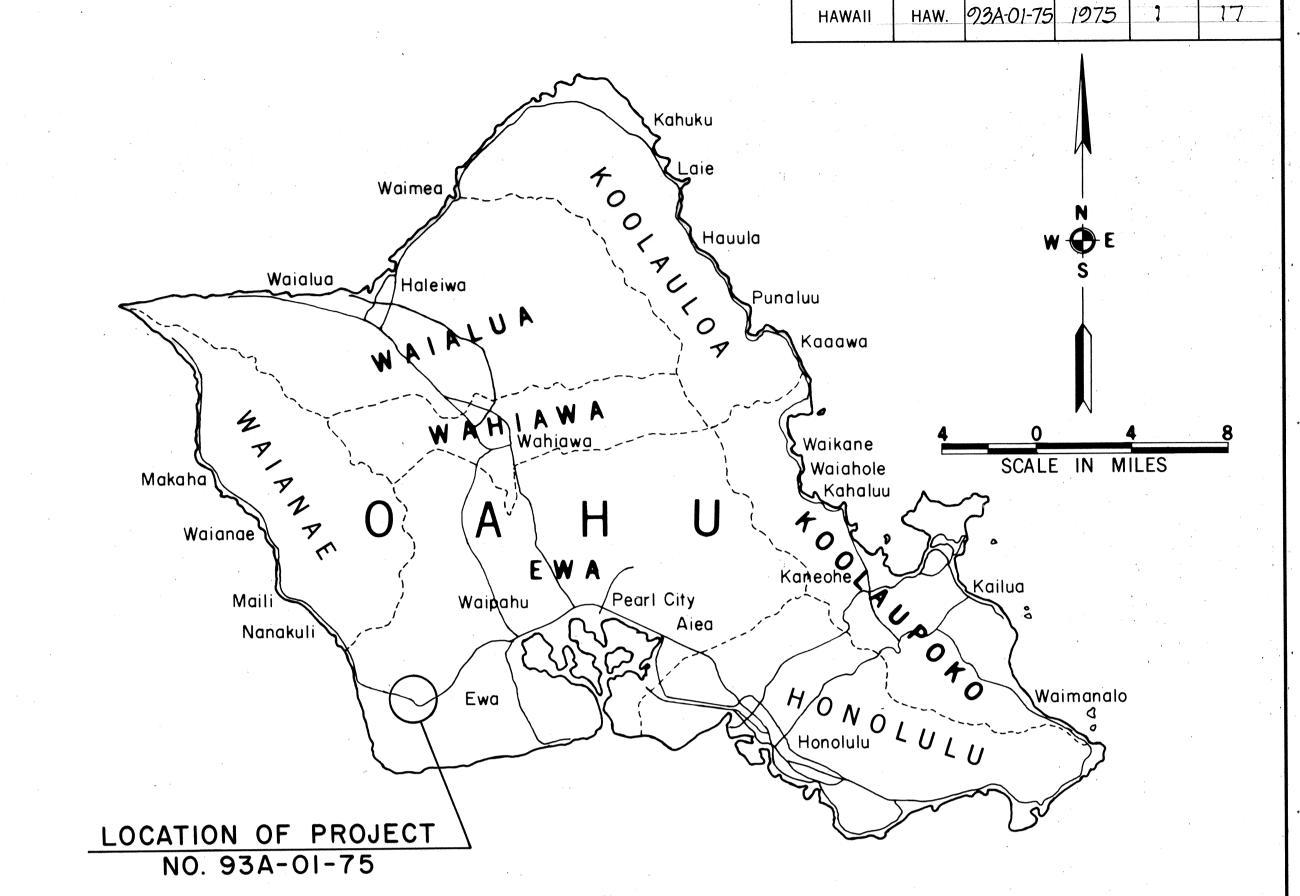

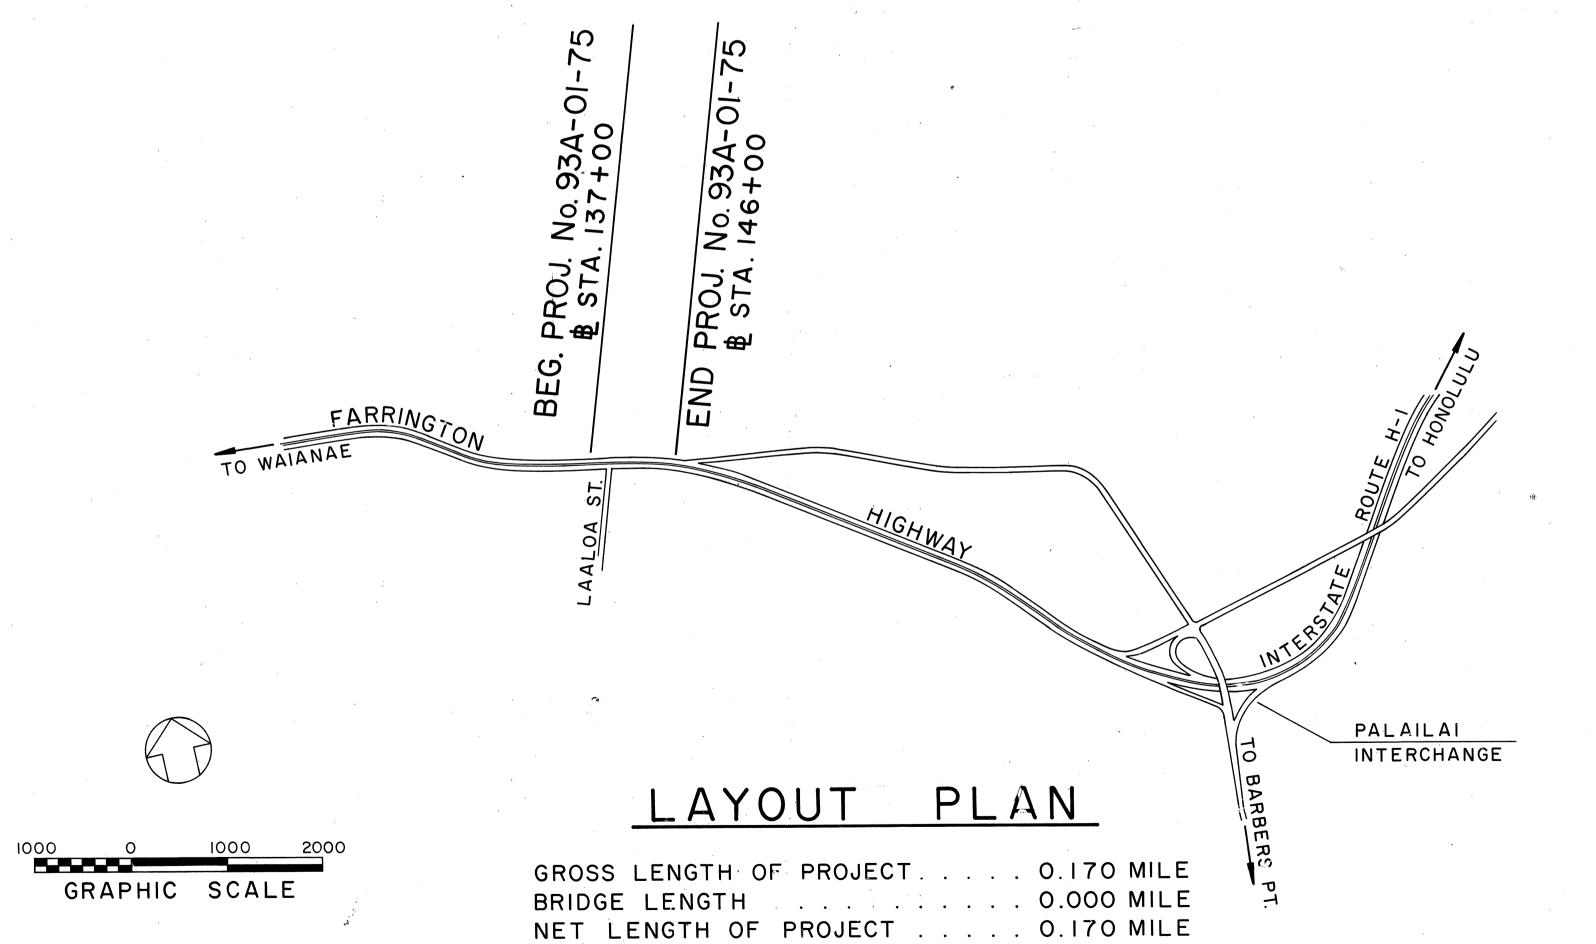

AS BUILT PLANS

ALL CHANGES MADE DURING CONSTRUCTION HAVE BEEN INCORPORATED ON THESE PLANS EXCEPT CHANGES IN THE ORIGINAL THEORETICAL QUANTITIES.

RESIDENT ENGINEER

DEPARTMENT OF TRANSPORTATION
STATE OF HAWAII

APPROVED:

Blue Hawaii

APPROVED:

Blue Hawaii

DIR. OF TRANSPORTATION

DATE