11	NDEX TO DRAWINGS
SHEET NO.	DESCRIPTION
	Title
2	Plan
3	Detail-Fence and Planting
·	





DEPARTMENT OF TRANSPORTATION HIGHWAYS DIVISION

HONOLULU, HAWAII

"AS BUILT"


PLANS FOR


KAMEHAMEHA AND FARRINGTON HIGHWAYS

JUNKYARD SCREENING AT THREE SITES

FEDERAL AID PROJECT NO. CJF-0300(I)

DISTRICTS OF EWA AND WAIANAE ISLAND OF OAHU
1976

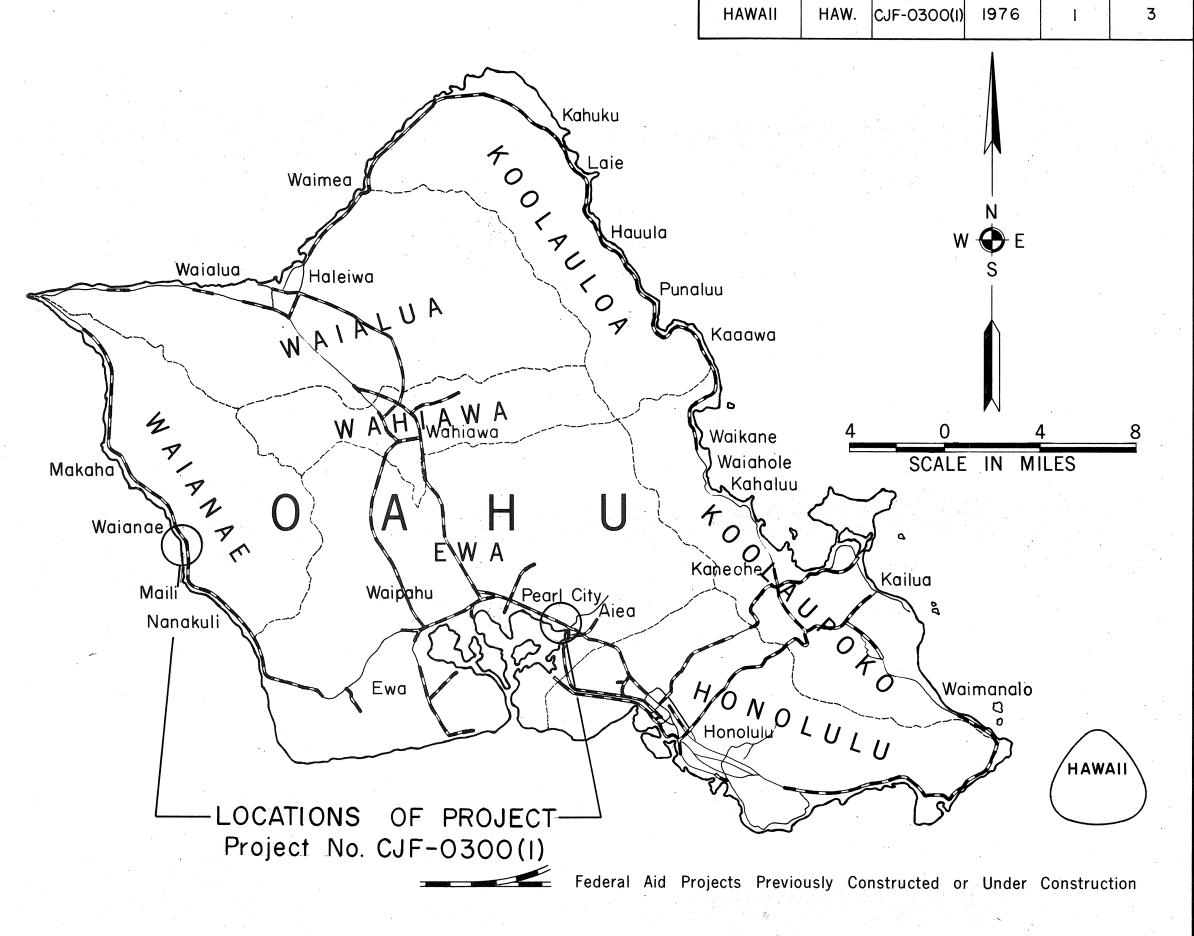

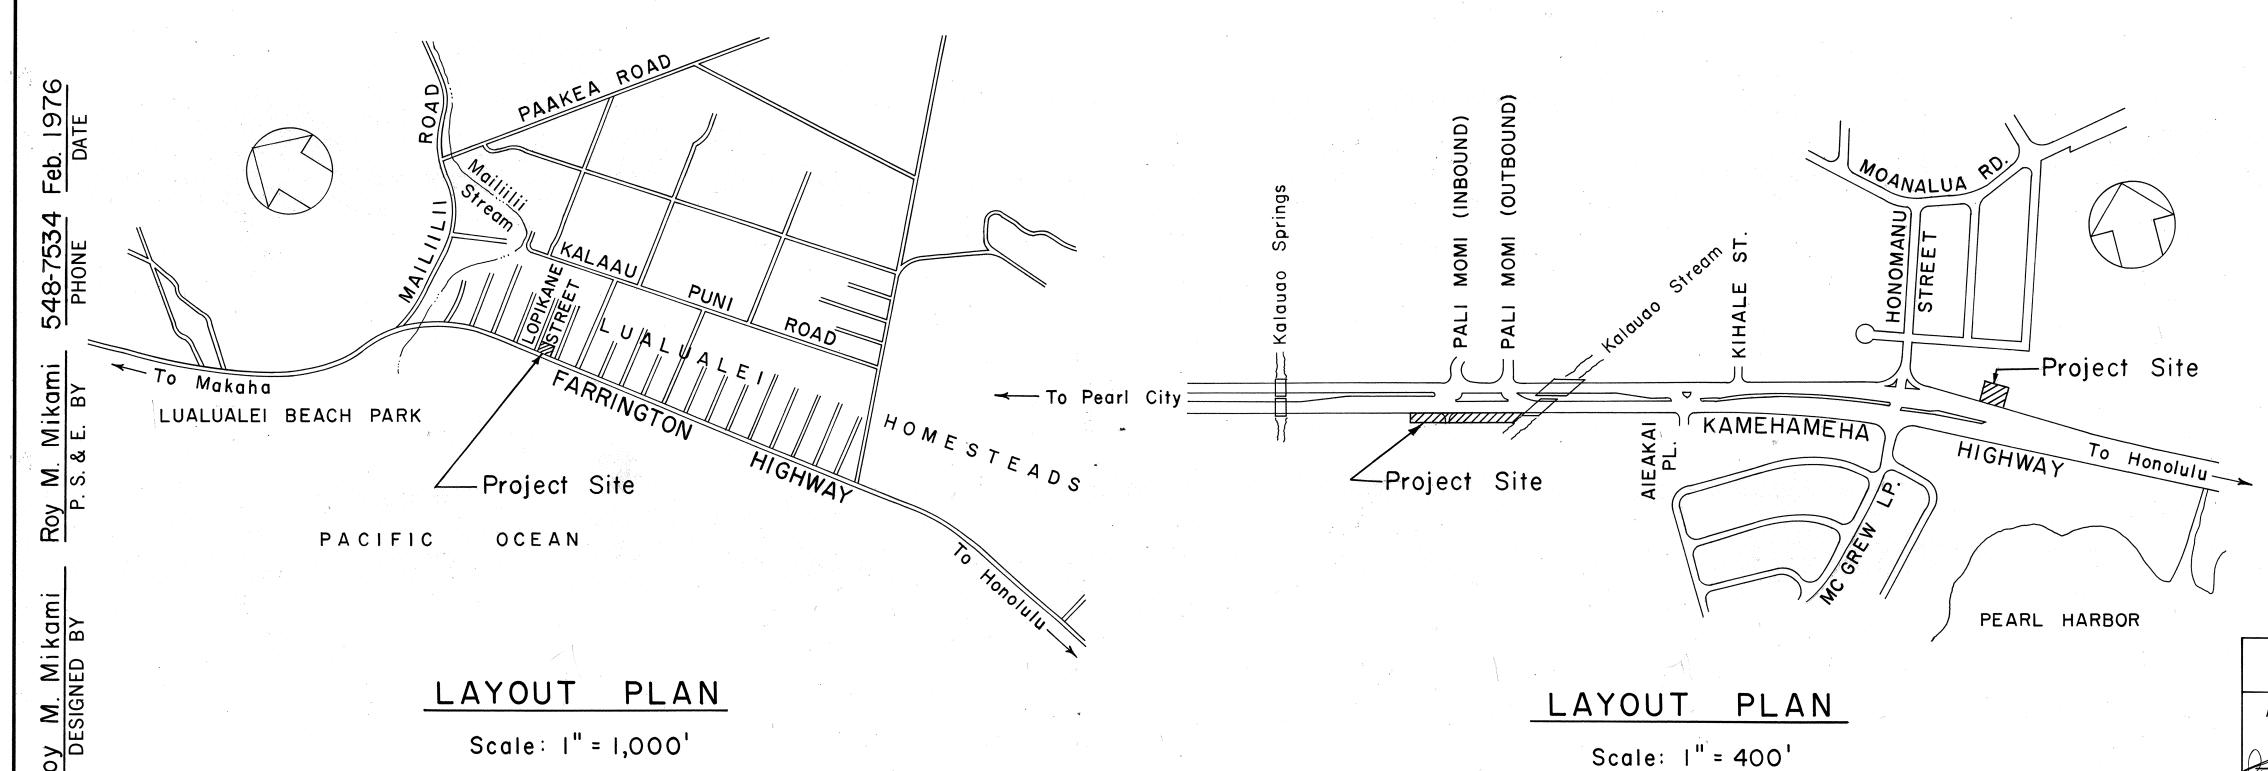

NO "AS-BUILT" CHANGES WERE MADE DURING CONSTRUCTION.

Glenn Matsunolo 10/1/79
PROJECT ENGINEER DATE

DEPARTMENT OF TRANSPORTATION FEDERAL HIGHWAY ADMINISTRATION

APPROVED:

5.3.7/

DEPARTMENT OF TRANSPORTATION
STATE OF HAWAII

APPROVED:

R Higashionna 4/14/76

DIR. OF TRANSPORTATION DATE

STATE FED. AID FISCAL SHEET TOTAL PROJ. NO. YEAR NO. SHEETS

1