
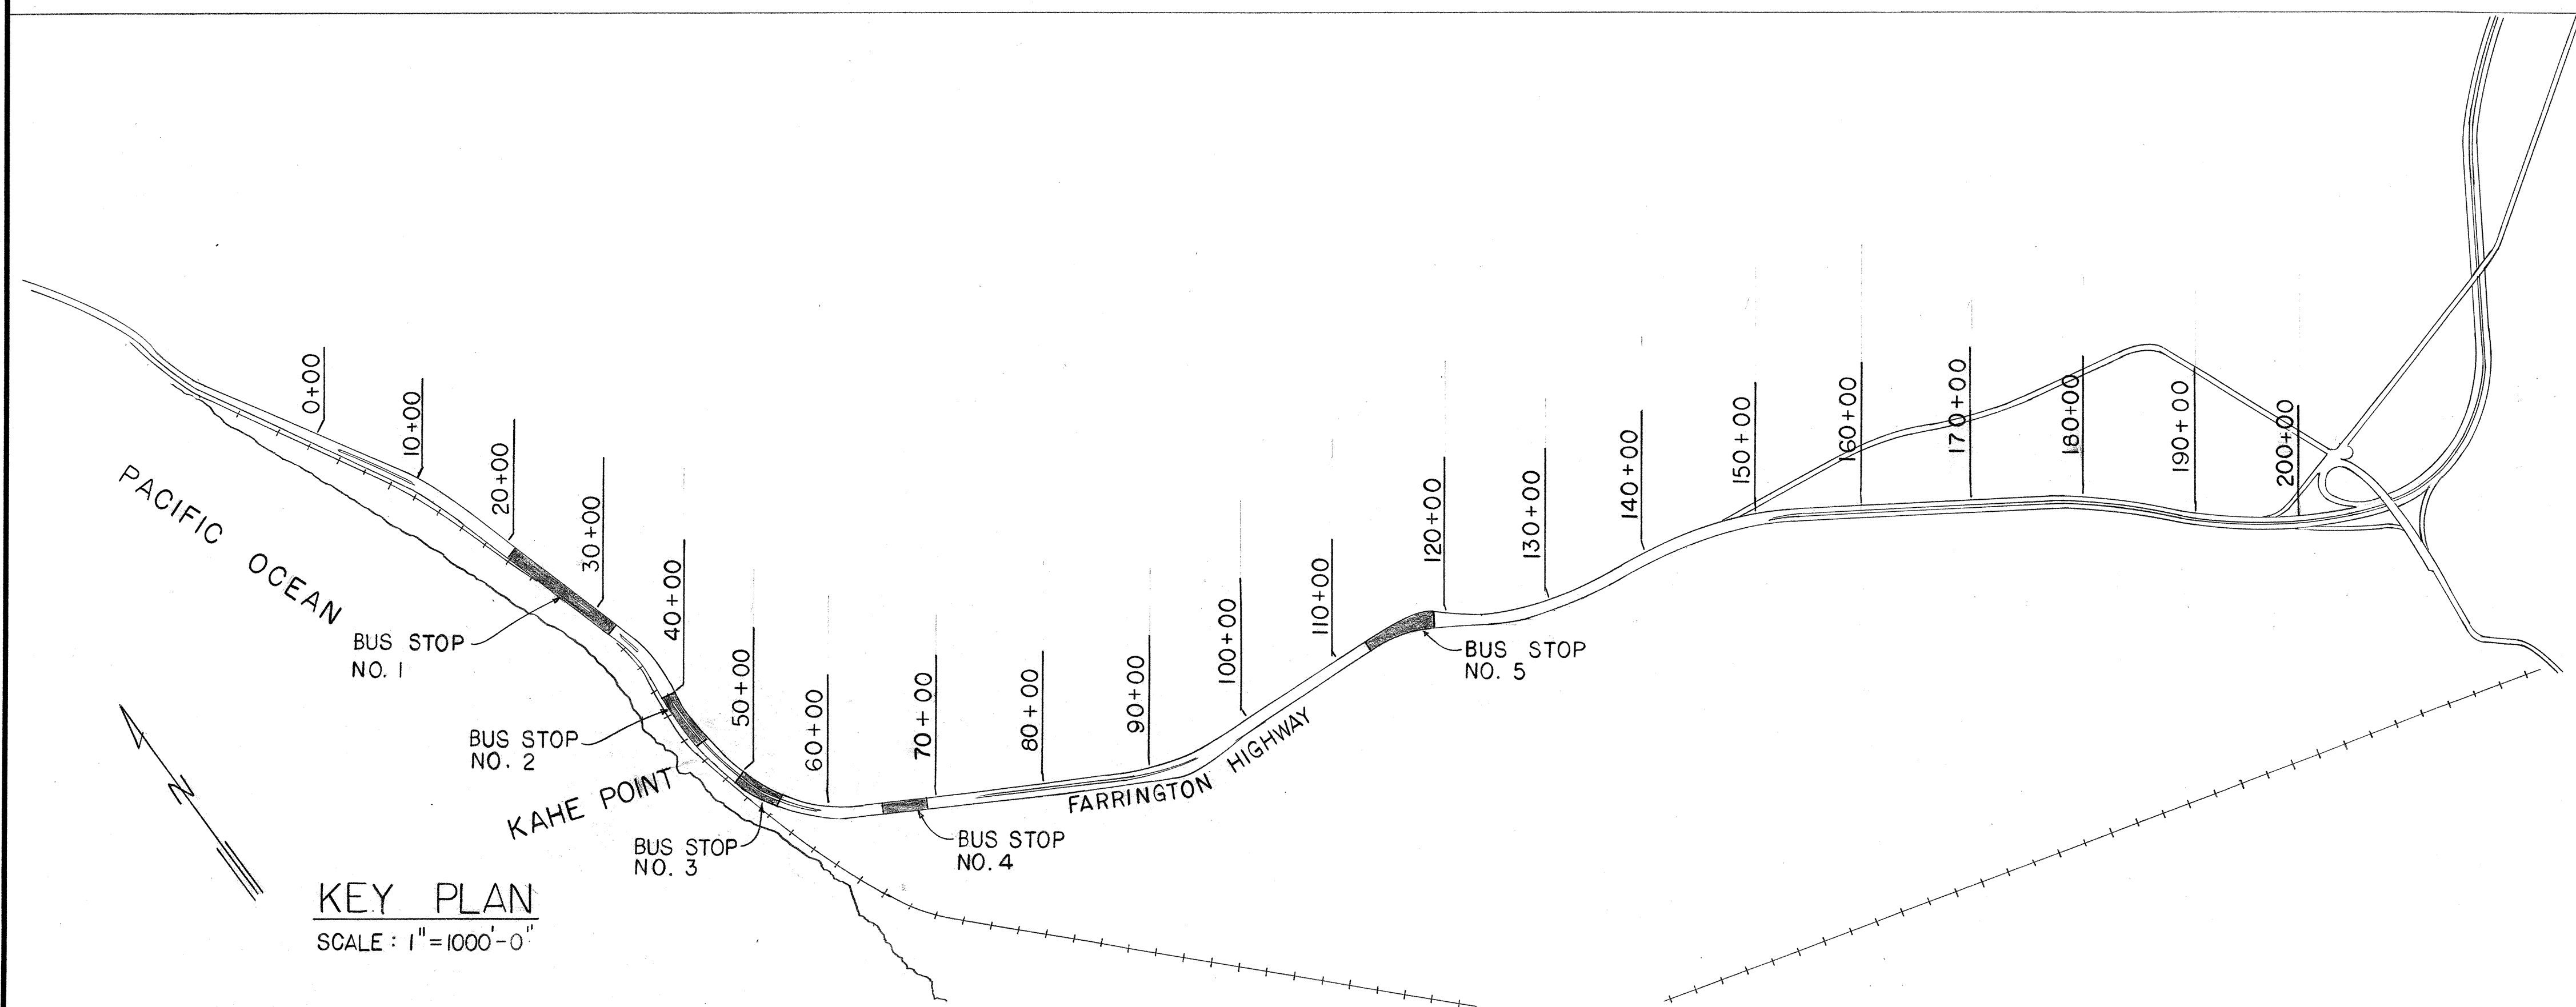


FED. ROAD DIST. NO.	STATE	FED.-AID PROJ. NO.	FISCAL YEAR	SHEET NO.	TOTAL SHEETS
HAWAII	HAW.	93A-01-78	1977	2	4

# LEGEND

- EXISTING WOOD POLE
- NEW WOOD POLE
- REPLACE EXISTING WOOD POLE WITH NEW 35' WOOD POLE
- EXISTING BUS STOP SIGN TO REMAIN
- EXISTING GUY AND ANCHOR
- NEW 100W HPS HIGHWAY LUMINAIRE AND BRACKET ON EXISTING WOOD POLE
- NEW 100W HPS HIGHWAY LUMINAIRE ON NEW WOOD POLE
- EXISTING HIGHWAY LUMINAIRE ON EXISTING METAL STANDARD
- EXISTING BUS STOP SIGN TO BE RELOCATED
- RELOCATED BUS STOP SIGN
- EXISTING GUARD RAIL
- EXISTING RAILROAD TRACKS
- SIDEWALK GUY AND ANCHOR
- GUY AND ANCHOR
- HECO SERVICE LOCATION
- NEW HECO TRANSFORMER
- HECO HAWAIIAN ELECTRIC COMPANY
- HTCO HAWAIIAN TELEPHONE COMPANY
- LI-8 LI = STREET LIGHT NO. 1
- 8 = MAST ARM LENGTH
- NPI-8 NPI = NEW POLE NO. 1
- 8 = SET POLE 8' FROM EDGE OF PAVEMENT
- --- PROPERTY LINE OR RIGHT OF WAY LINE
- SL --- NEW OVERHEAD STREET LIGHT SECONDARY
- ET --- EXISTING OVERHEAD TELEPHONE LINES
- ET & P --- EXISTING OVERHEAD TELEPHONE AND ELECTRIC LINES

- NOTES:
- ALL POLE LOCATIONS TO BE STAKED BY CONTRACTOR AND APPROVED BY ENGINEER PRIOR TO DIGGING OF POLE HOLES.
  - PAYMENT OF RELOCATION OF BUS STOP SIGNS SHALL BE INCIDENTAL TO THE VARIOUS CONTRACT ITEMS.
  - CONTRACTOR TO REPLACE EXISTING HTCO POLES WITH NEW POLES ON EITHER SIDE OF EXISTING POLES. ALL RELOCATION WORK OF EXISTING TELEPHONE LINES, CROSSARMS AND HARDWARE TO BE DONE BY HAWAIIAN TELEPHONE CO.
  - CONTRACTOR TO COORDINATE ALL WORK WITH MR. GEORGE YAMADA OF HTCO, PHONE 842-9120, OR HIS AUTHORIZED REPRESENTATIVE.
  - PAYMENT FOR REPLACEMENT OF THE EXISTING HTCO POLES SHALL BE INCIDENTAL TO THE VARIOUS CONTRACT ITEMS.

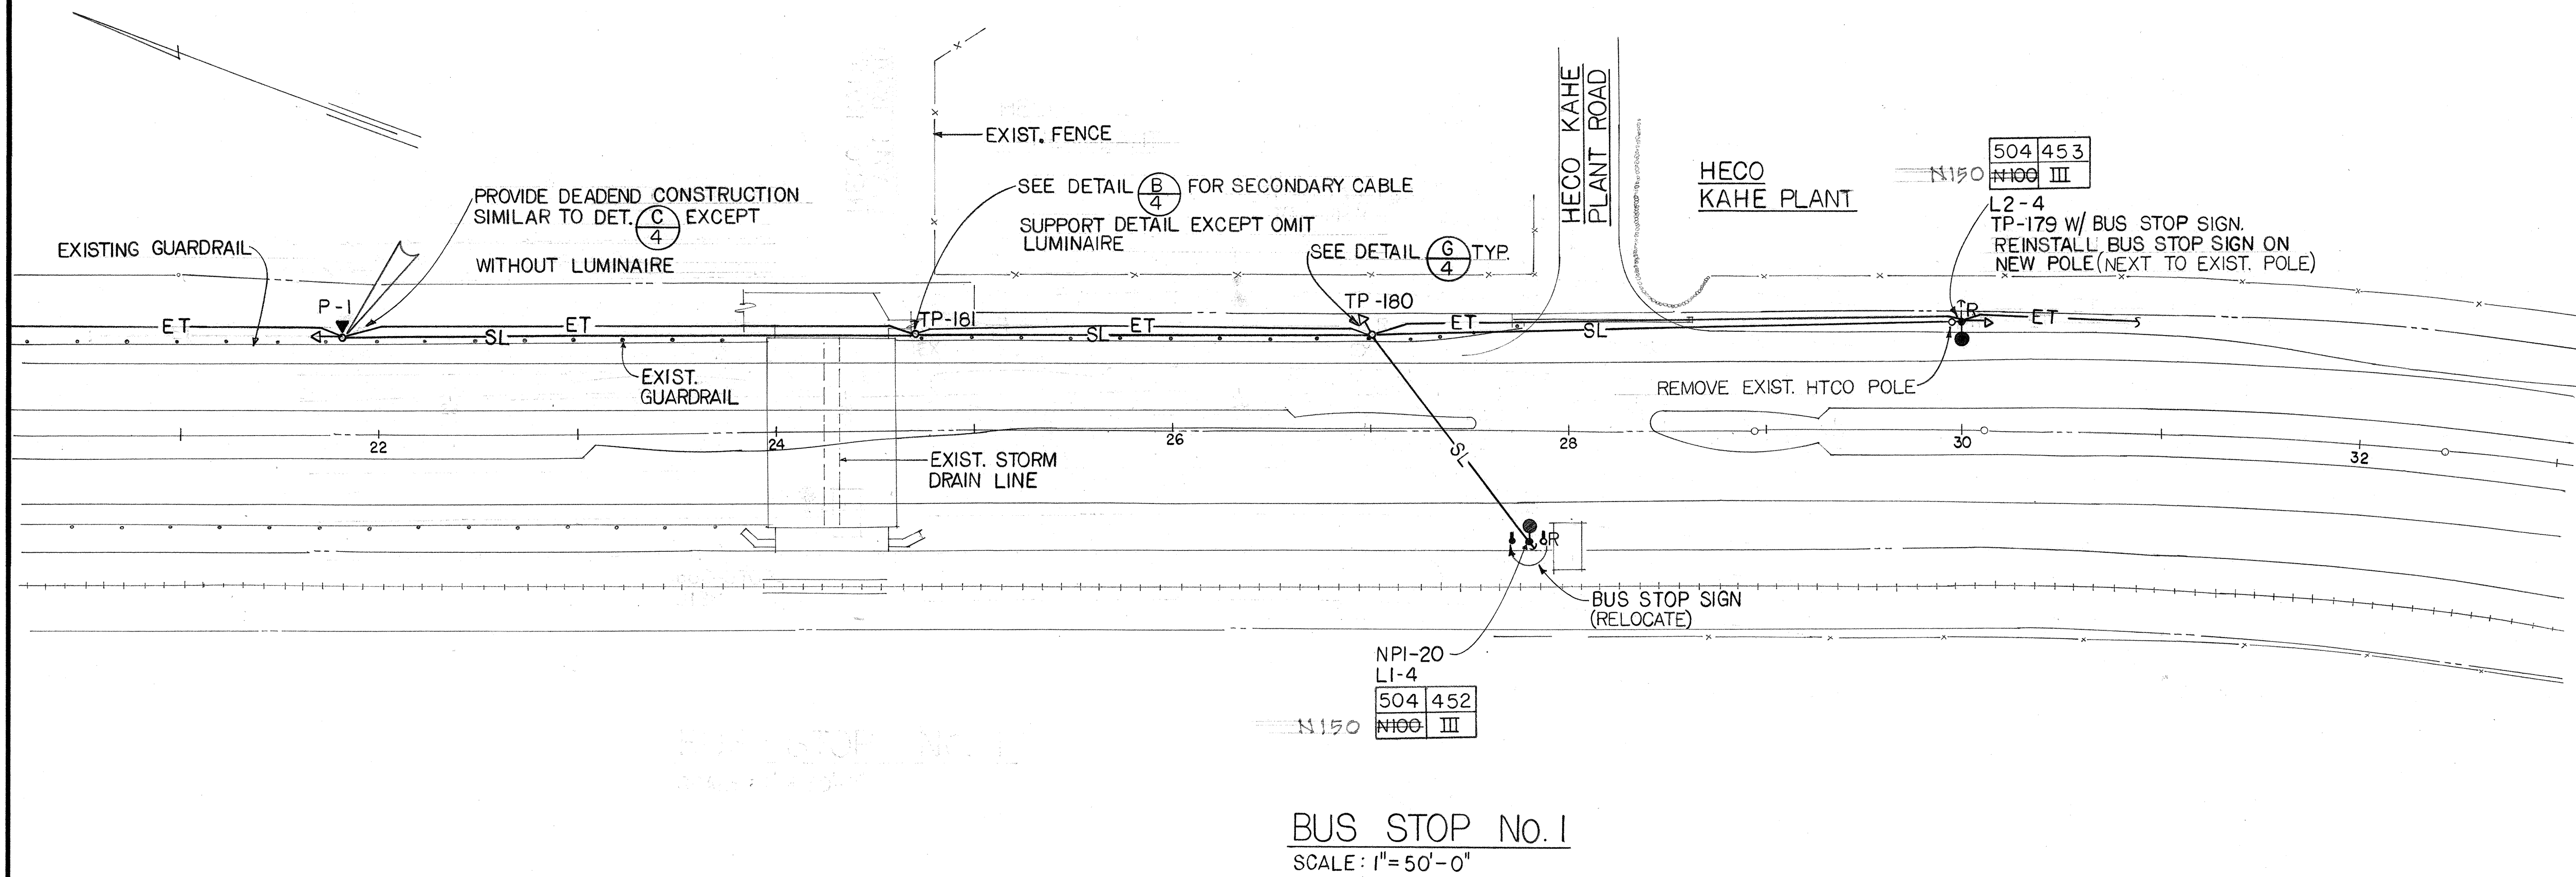





THIS WORK WAS PREPARED BY ME  
OR UNDER MY SUPERVISION  
*Albert S. C. Chong, PE*

STATE OF HAWAII  
DEPARTMENT OF TRANSPORTATION  
HIGHWAYS DIVISION


FARRINGTON HIGHWAY,  
STREET LIGHTS AT BUS STOPS,  
KAHE TO WAIOMEA STREET  
PROJECT NO. 93A-01-78

SHEET No. 2 OF 4 SHEETS

FED. ROAD DIST. NO.	STATE	FED-AID PROJ. NO.	FISCAL YEAR	SHEET NO.	TOTAL SHEETS
HAWAII	HAW.	93A-01-78	1977	3	4

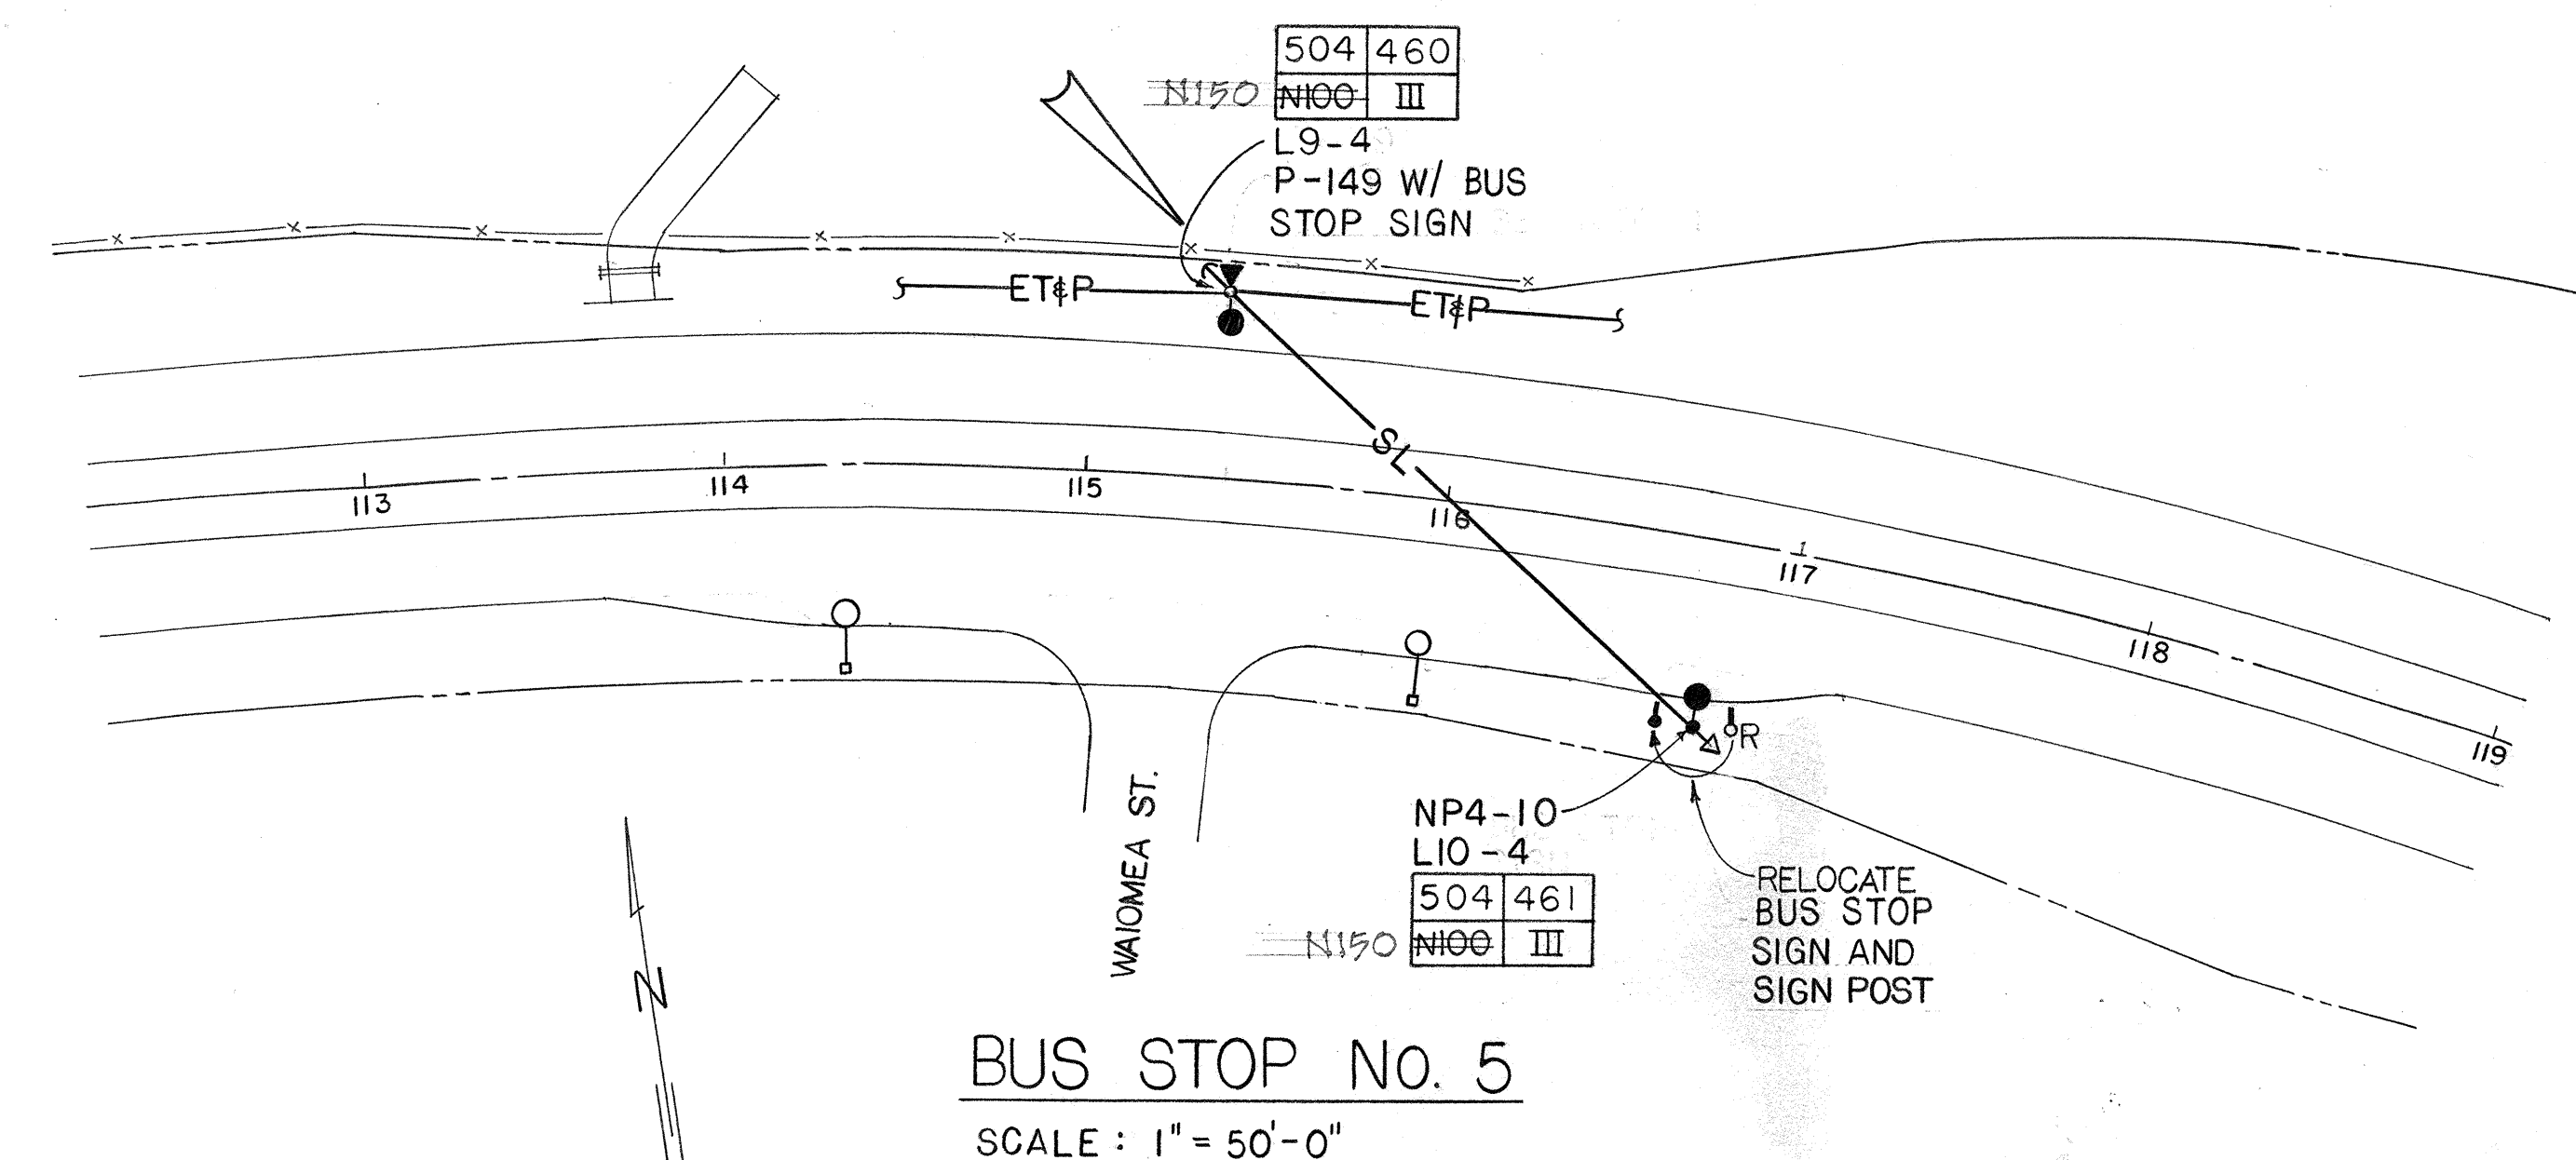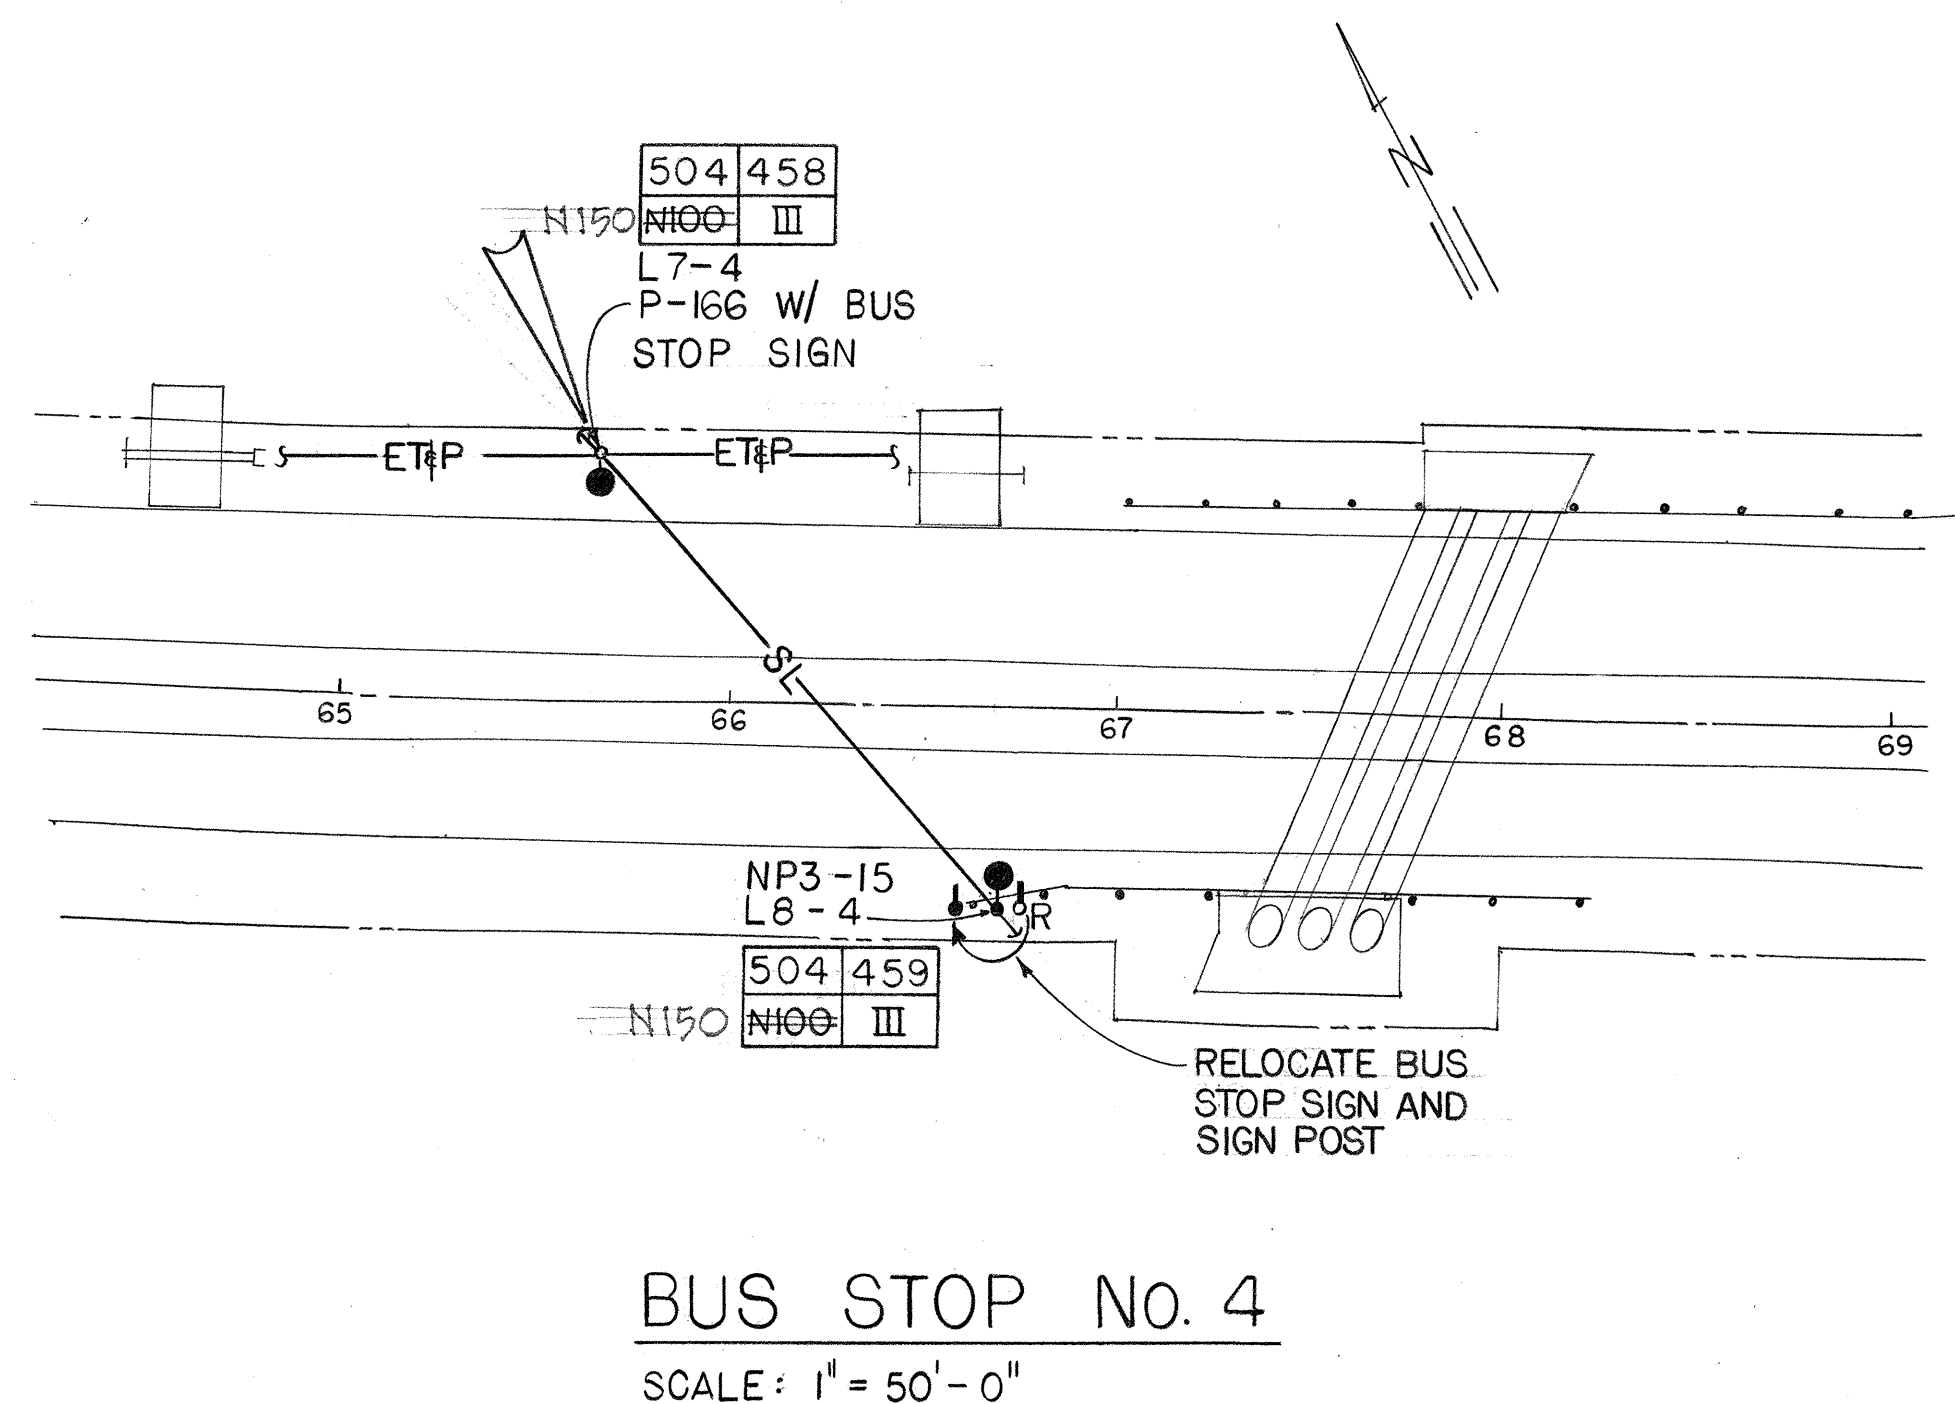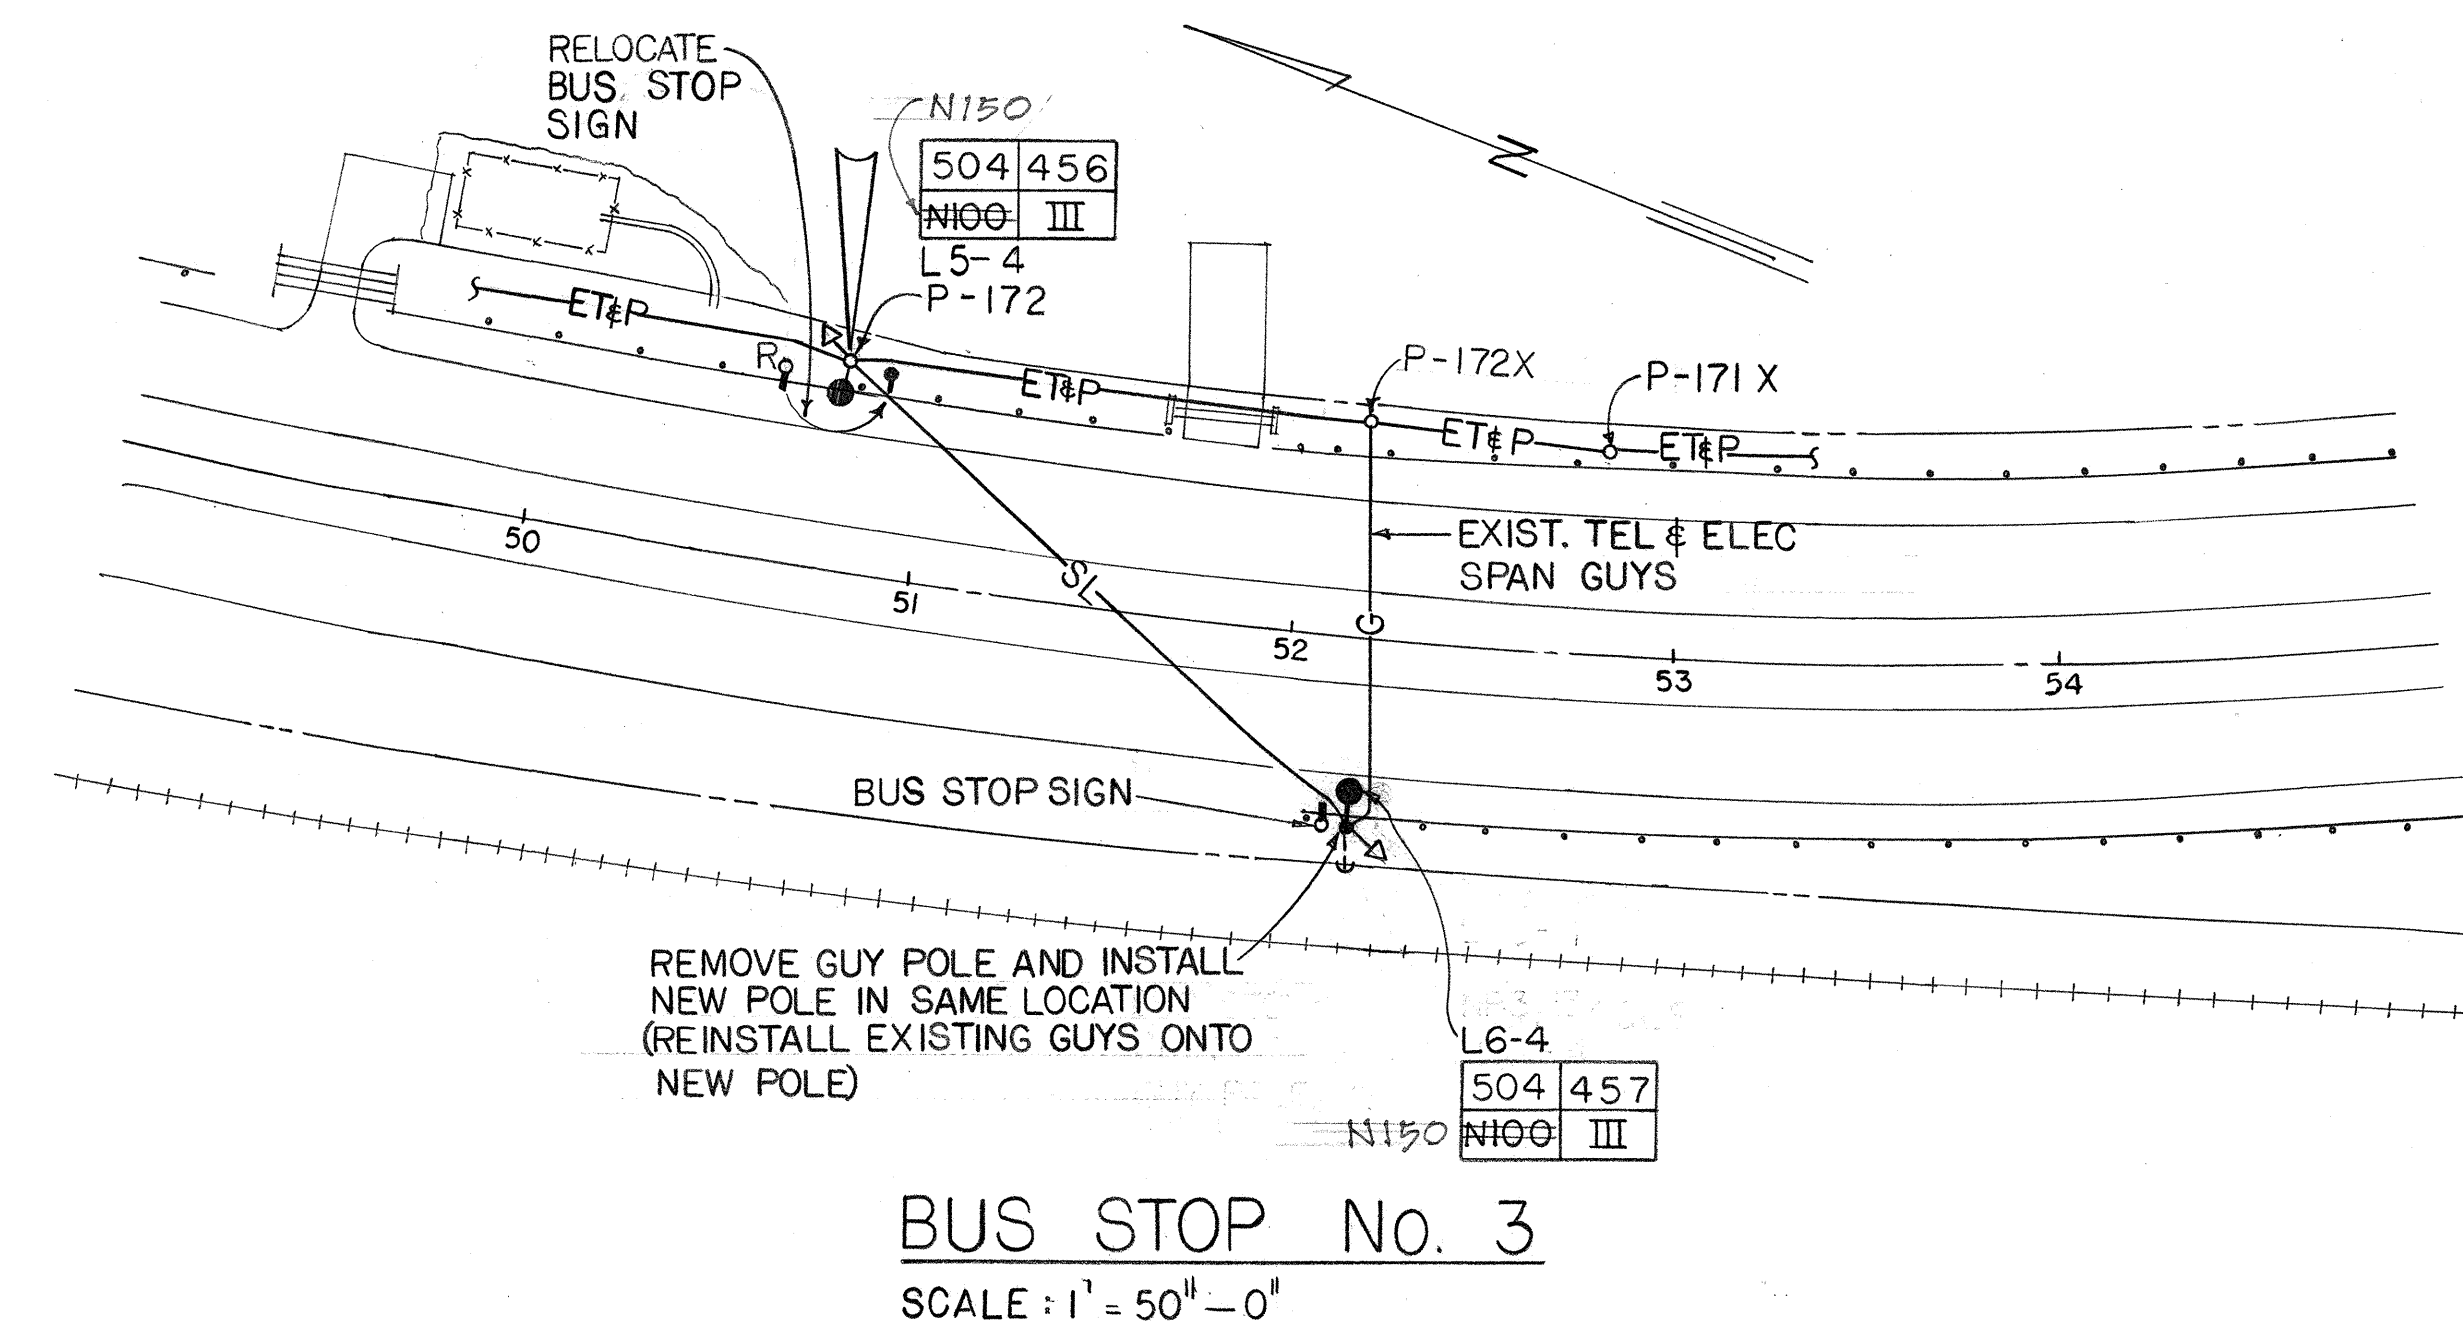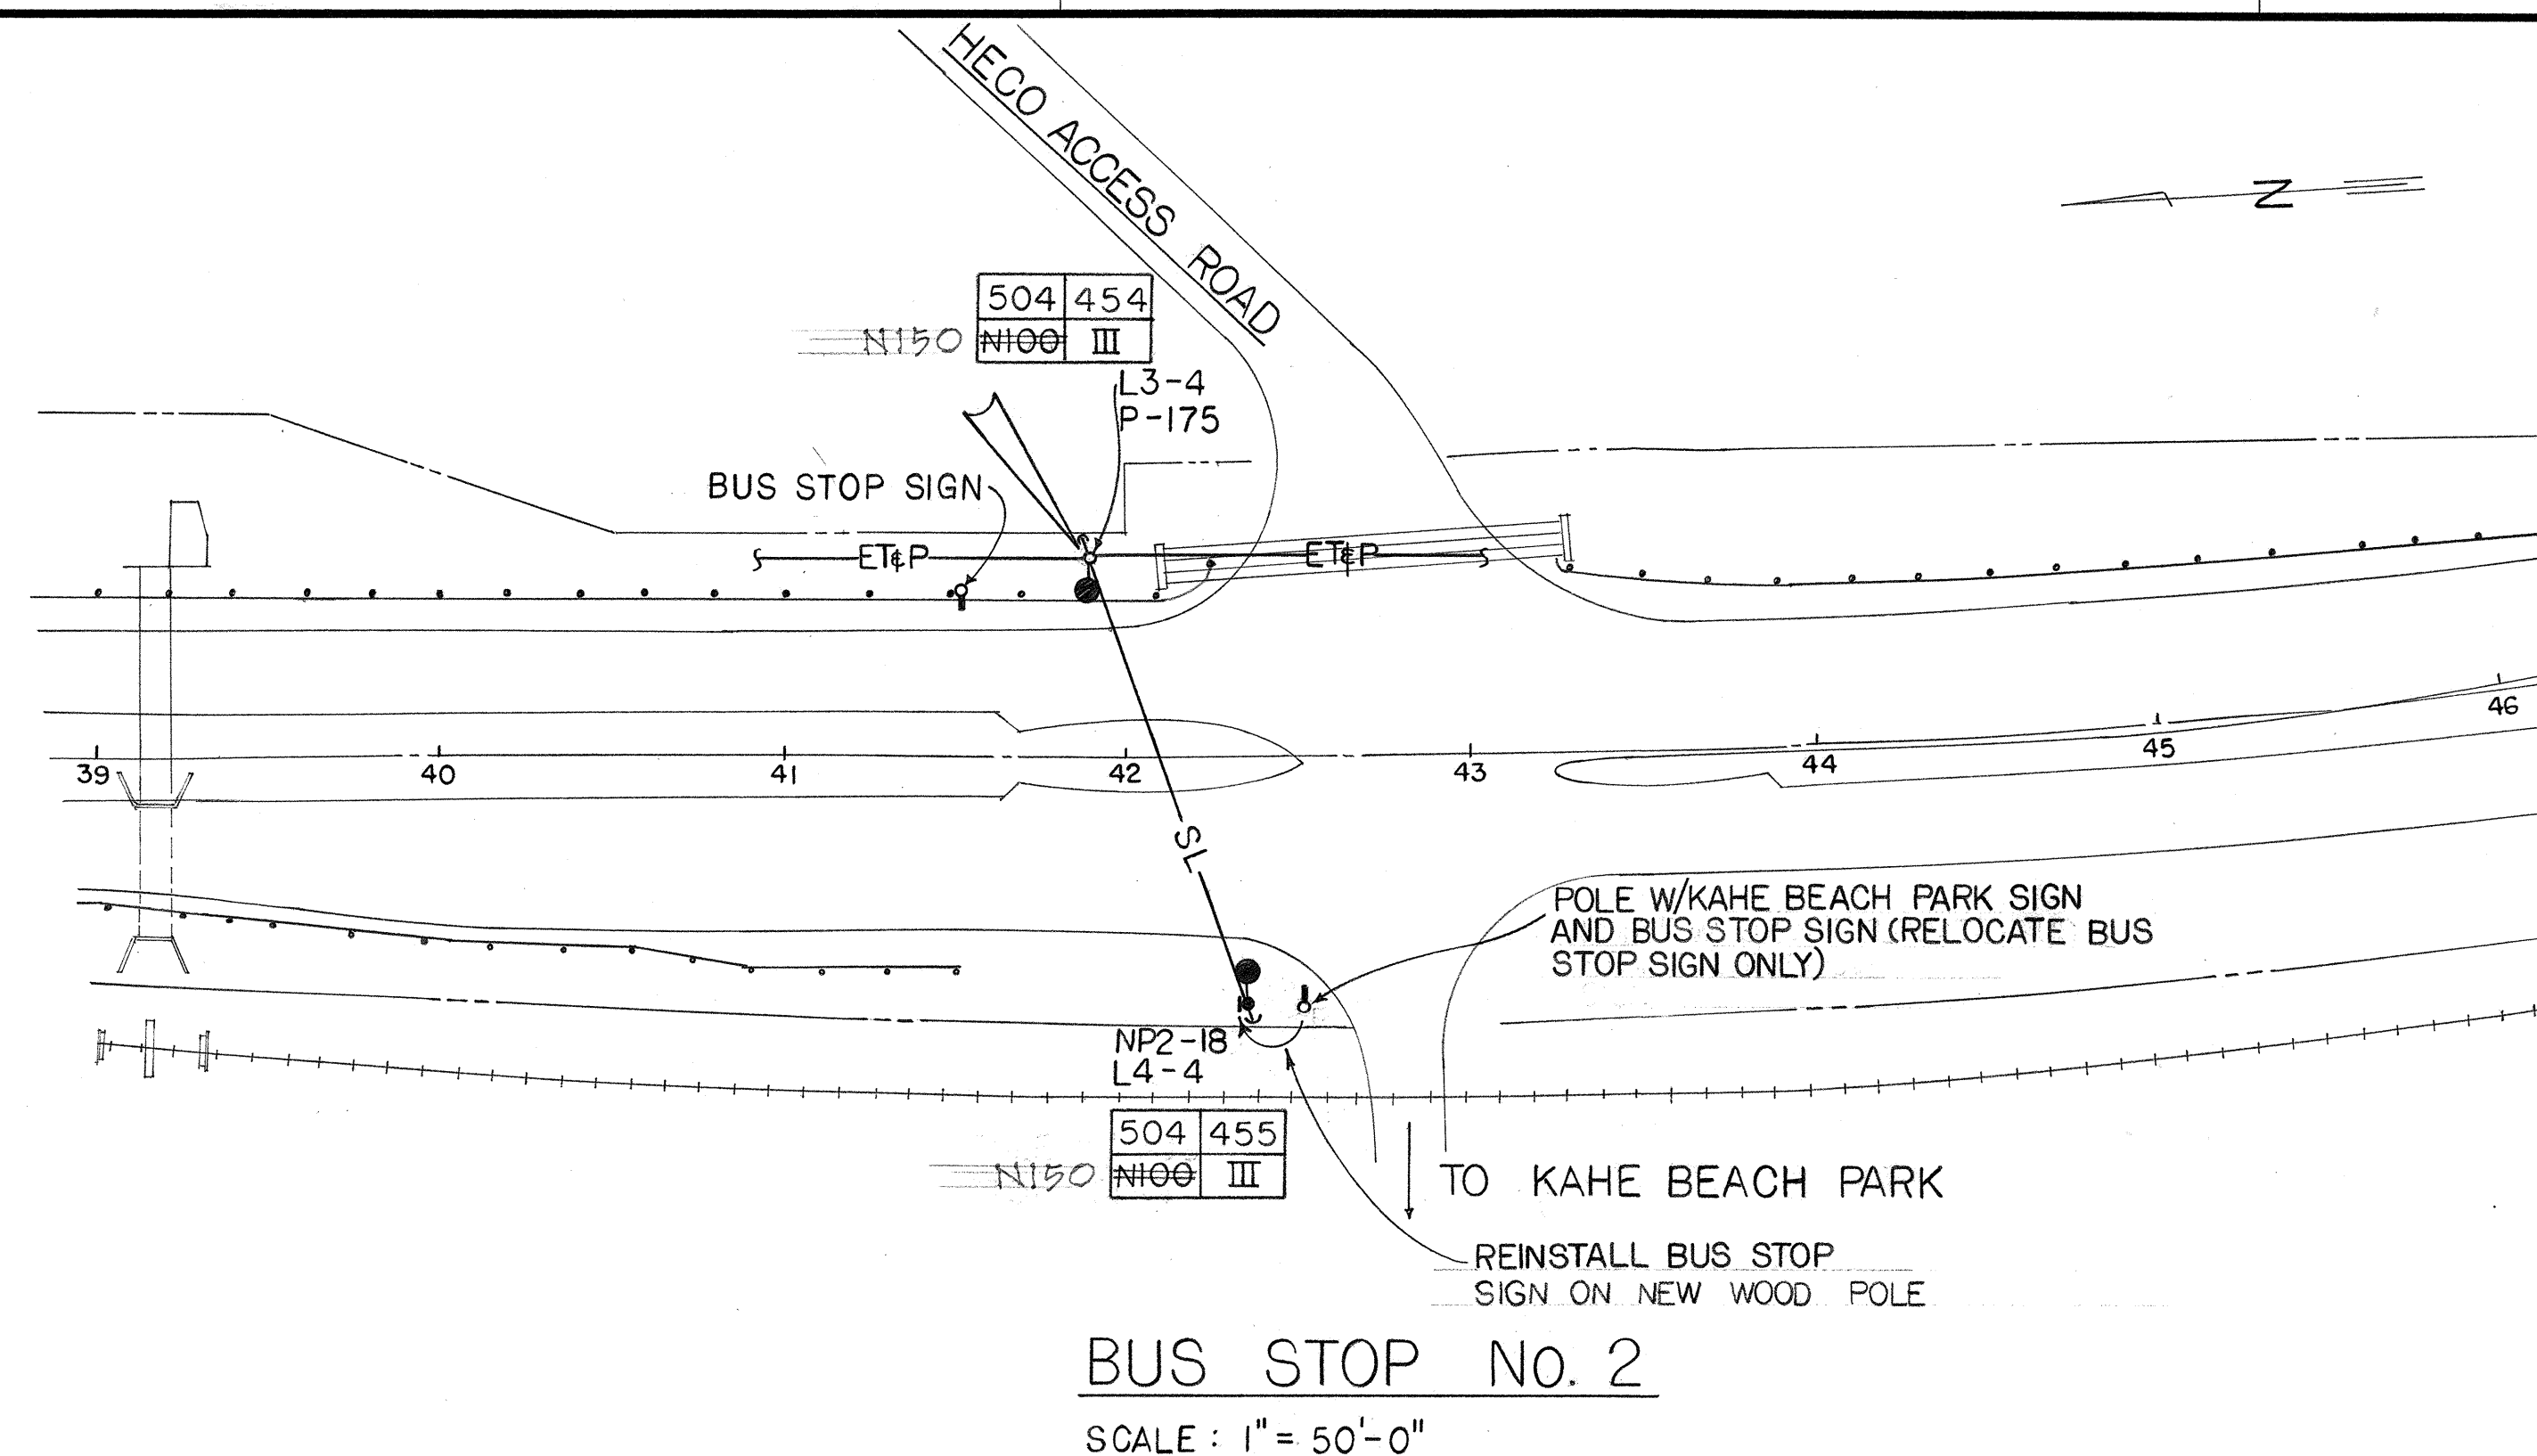

SURVEY PLOTTED BY	DATE
DESIGNED BY	
CHECKED BY	
NOTE BOOK	
NO.	

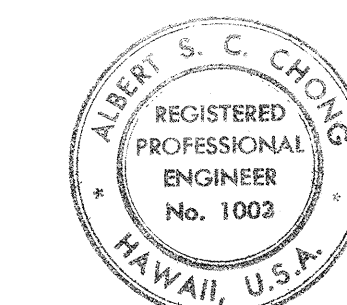

THIS WORK WAS PREPARED BY ME  
OR UNDER MY SUPERVISION

*Albert S. C. Chong*  
Albert S. C. Chong, PE

STATE OF HAWAII  
DEPARTMENT OF TRANSPORTATION  
HIGHWAYS DIVISION

FARRINGTON HIGHWAY,  
STREET LIGHTS AT BUS STOPS,  
KAHE TO WAIOMEA STREET  
PROJECT NO. 93A-01-78

SHEET No. 3 OF 4 SHEETS