IN	DEX TO DRAWINGS	
SHEET NO.	DESCRIPTION	
··· Alim	TITLE SHEET	
2-4	TYPICAL SECTIONS	
5-8	ROADWAY PLAN AND PROFILE	-
9-14	INTERSECTION DETAILS	. · · · · · · · · · · · · · · · · · · ·
15 -20	ROADWAY DETAILS	(a)
21-49	R/W ADJUSTMENT DETAILS	
50-60	ORDER OF WORK AND DETOURS	Septime you
61-71	SIGNS AND MARKINGS	
72-85	DRAINAGE SYSTEM	(b)
86-89	UTILITIES PLAN AND PROFILE	
89A-89J	PLAN AND PROFILE OF 20"WATER MAIN	
90-102	UTILITIES DETAILS	(c)
103-120	KAUPUNI CHANNEL BRIDGE	
121 - 128	HIGHWAY LIGHTING SYSTEM	(d)
129-137	TRAFFIC SIGNAL SYSTEM	
138-144	CROSS SECTIONS	a m
145-149	FIELD OFFICE	gramma na
	The state of the s	· remand
**************************************		William I
		-0000

Sheet Nos. (a) C.O. 17S-1 & C.O. 17S-2, (b) 76S-1, (c) C.O. 90S-1 & C.O. 96S-1, & (d) C.O. 125S-1 are supplementary sheets to this project.

Total sheet count after "As-Built" postings: 165 sheets.



STATE OF HAWAII

DEPARTMENT OF TRANSPORTATION LAND TRANSPORTATION FACILITIES DIVISION

HONOLULU, HAWAII
"AS - BUILT"
PLANS OF

FARRINGTON HIGHWAY WIDENING

LUALUALEI HOMESTEAD ROAD TO JADE STREET

(LUALUALEI HOMESTEAD RD. TO ALA WALUA ST.)

PROJECT 93B-01-75, UNIT I

DISTRICT OF WAIANAE ISLAND OF OAHU

SCALES:

PLAN & PROFILE

HOR. I" = 50' VER. I" = 5'

CROSS SECTIONS

HOR. I" = 10' VER. I" = 5'

LAYOUT PLAN

BEGIN PROJECT

STA. 34-00

MIKILIA BEACH PARK

PORAL BAY

STAR MARCH

RESEMBLY

RESEMBLY

STA. 34-00

TO THE COMMINITY

STA. 04-00


MIKILIA BEACH PARK

PORAL BAY

STAR MARCH

RESEMBLY

R

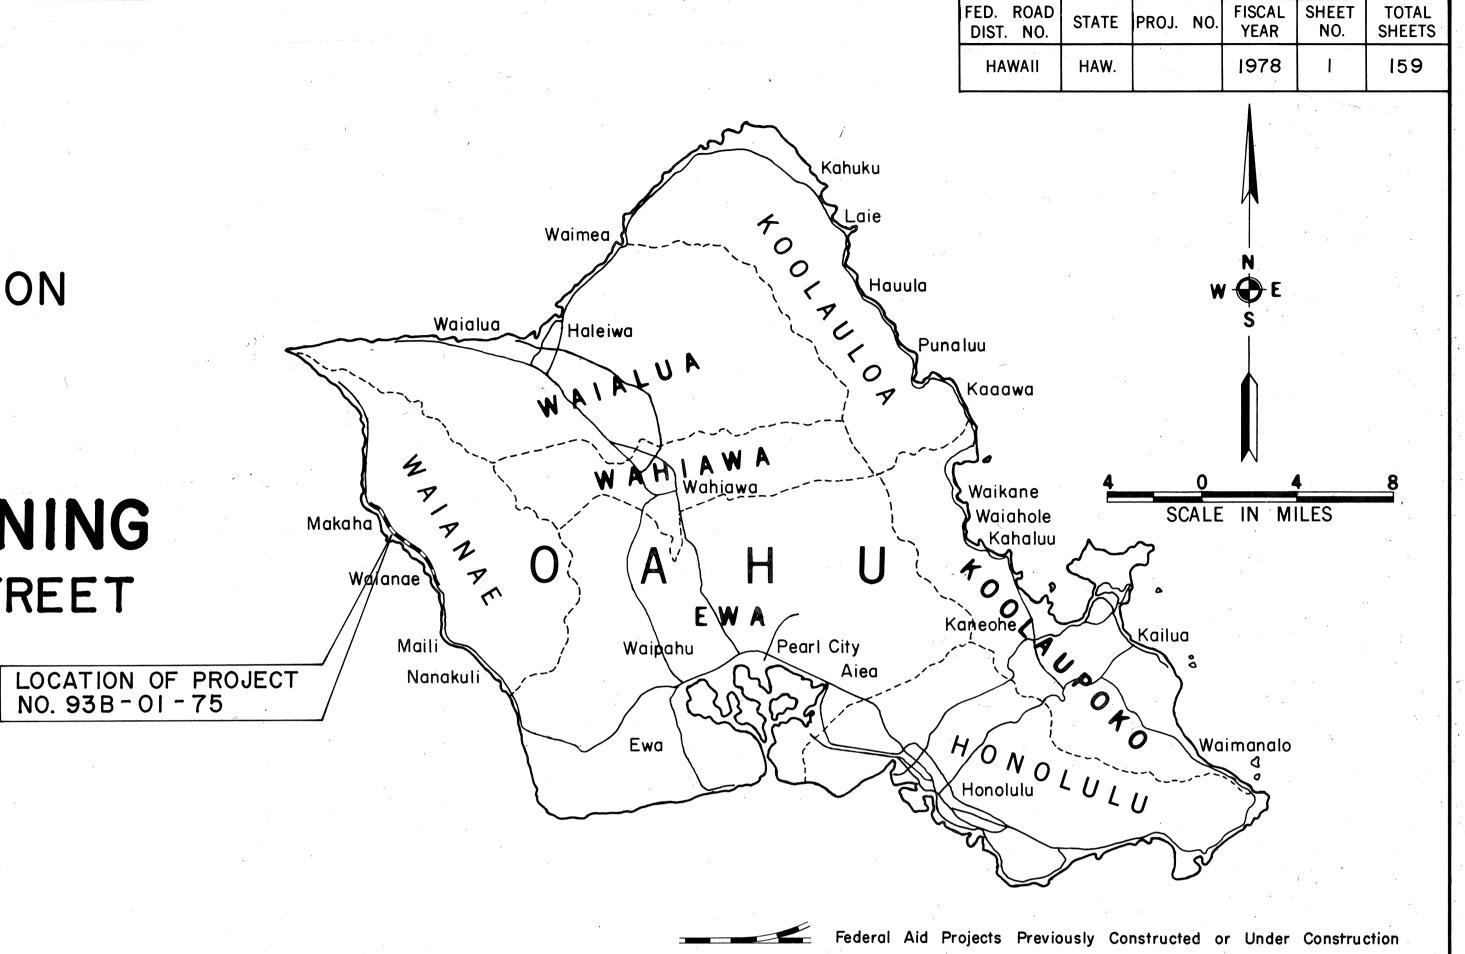

DESIGN CLASSIFICATION

CURRENT ADT	20,900	
DESIGN ADT	36,800	
DHV	2,944	
D	55/45	
T	3 %	
T 24	4 %	
V	25 MPH	

PLANS PREPARED BY:

PAUL T. TANIGUCHI, LTD. CIVIL AND STRUCTURAL ENGINEERS

ALL CHANGES MADE DURING CONSTRUCTION HAVE BEEN INCORPORATED ON THESE PLANS IN RED EXCEPT CHANGES IN THE ORIGINAL THEORETICAL QUANTITIES. FOR ACTUAL QUANTITIES, REFER TO PROJECT LEDGER AND/OR COMPUTATION BOOK.

RESIDENT ENGINEER

12/21/83 DATE

DEPARTMENT OF TRANSPORTATION
STATE OF HAWAII

APPROVED:
Rushiel: Higashionna 4/12