	INDEX TO DRAWINGS
SHEET NO.	DESCRIPTION
l	TITLE SHEET
2	TRAFFIC SIGNAL PLAN
3	STRIPING PLAN AND DETAILS
4	MISCELLANEOUS DETAILS
5-6	TYPICAL DETAILS OF WHEEL CHAIR RAMPS
7-16	STANDARD DETAILS
	,



STATE OF HAWAII

DEPARTMENT OF TRANSPORTATION TRANSPORTATION FACILITIES DIVISION


HONOLULU, HAWAII


"AS BUILT"

PLANS FOR

FARRINGTON HIGHWAY TRAFFIC SIGNALS AT HAKIMO ROAD PROJECT NO. 93A-02-79

DISTRICT OF WAIANAE ISLAND OF OAHU

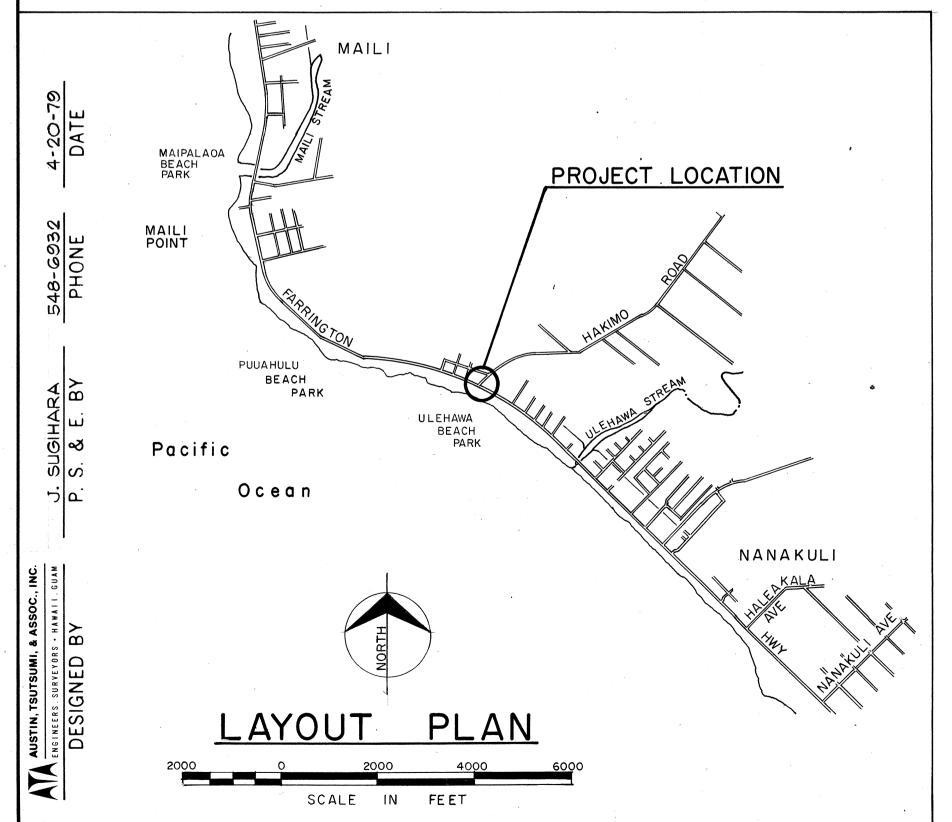

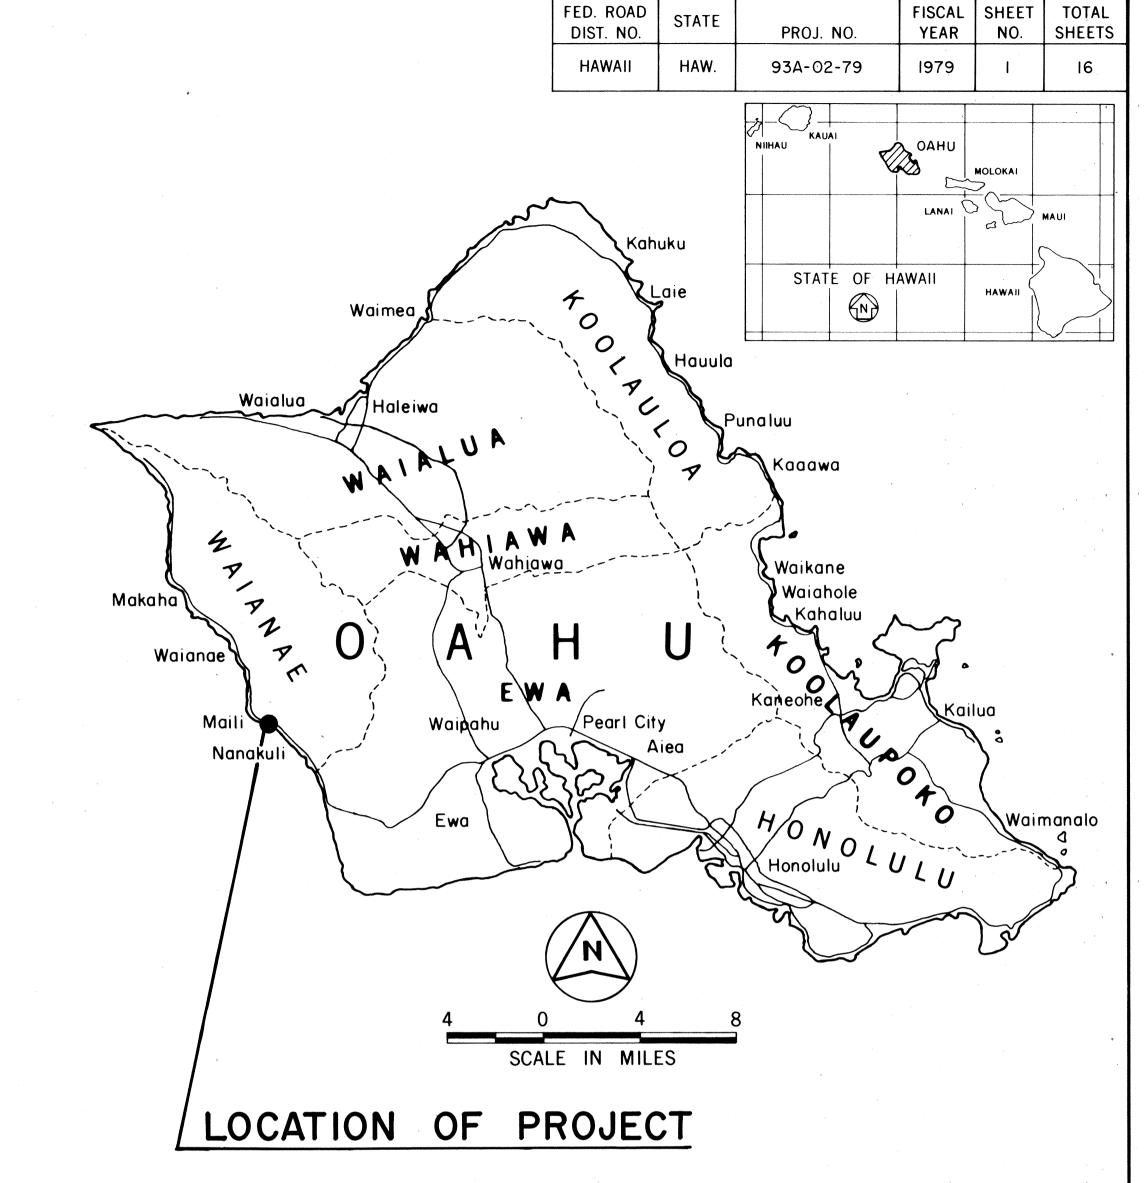

STATE

ALL CHANGES MADE DURING CONSTRUCTION HAVE BEEN INCORPORATED ON THESE PLANS EXCEPT CHANGES IN THE ORIGINAL THEORETICAL QUANTITIES.

7-17-80 DATE

DEPARTMENT OF TRANSPORTATION STATE OF HAWAII DIR. OF TRANSPORTATION