| | INDEX TO DRAWINGS |
|-----------|------------------------------|
| SHEET NO. | DESCRIPTION |
| . 1 | TITLE SHEET |
| 2 | GENERAL NOTES & LEGEND |
| 3 | PAVEMENT MARKINGS, SIGNING & |
| | UTILITIES |
| 5 - 15 | MISCELLANEOUS, TYPICAL & |
| | STANDARD DETAILS |
| | |
| | |
STATE OF HAWAII

DEPARTMENT OF TRANSPORTATION HIGHWAYS DIVISION

"AS BUILT "


PLANS FOR

INSTALLATION OF TRAFFIC SIGNALS ON

FARRINGTON HWY. AT MAILIILII ROAD

PROJECT NO. 93A-03-79

DISTRICT OF WAIANAE ISLAND OF OAHU

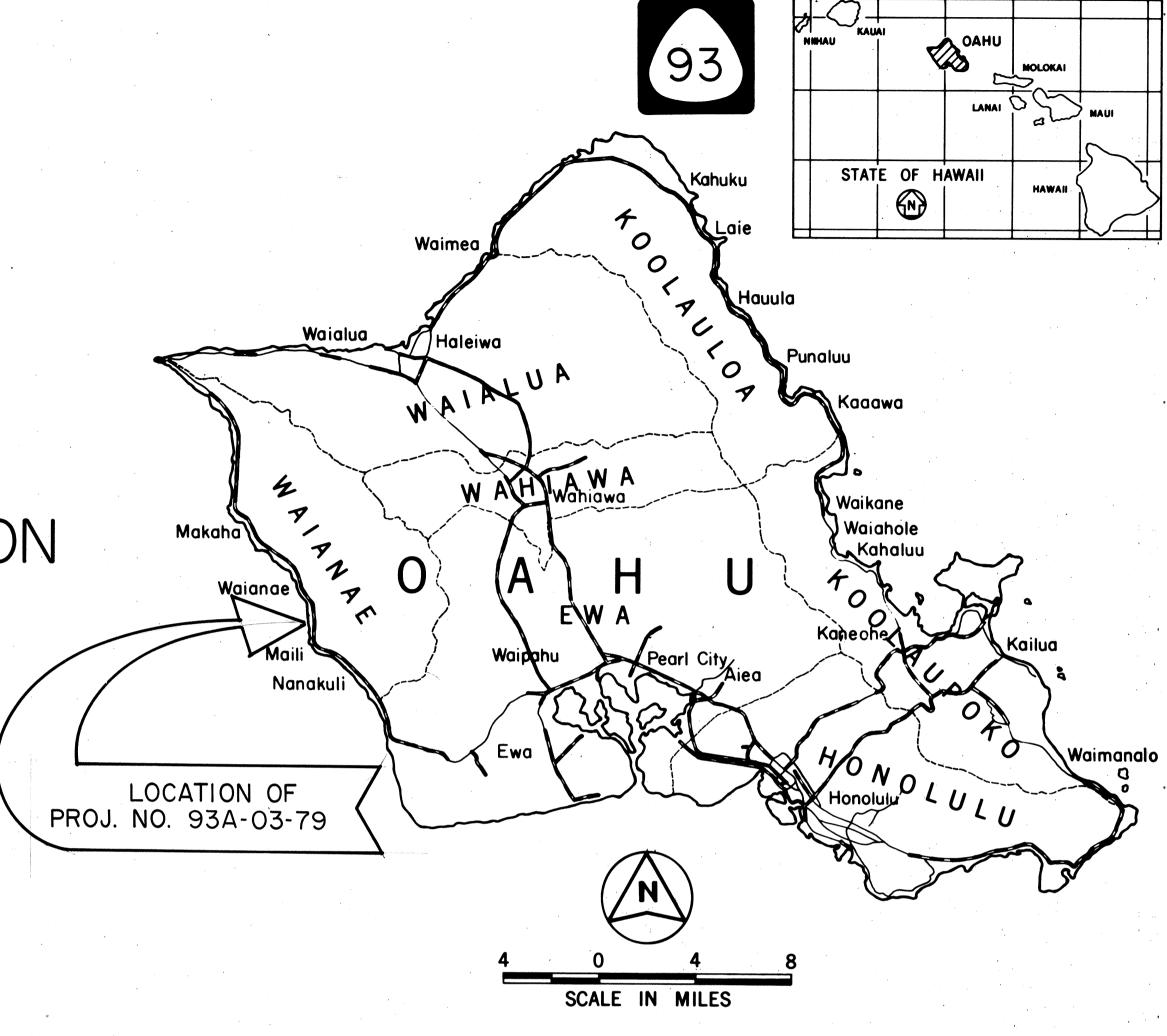

FED. ROAD DIST. NO.

•

OR UNDER CONSTRUCTION

FEDERAL AID PROJECTS PREVIOUSLY CONSTRUCTED

Robert & Scart 7/6/81

NO AS-BUILT CHANGES MADE

TO LOCATION OF PROJECT

Way and a Company of the Month of

DEPARTMENT OF TRANSPORTATION STATE OF HAWAII

APPROVED:

FISCAL SHEET TOTAL YEAR NO. SHEETS

PROJ. NO.

DIR. OF TRANSPORTATION