	INDEX TO DRAWINGS
SHEET NO.	DESCRIPTION
l	TITLE SHEET
2	LEGEND AND NOTES
3 – 4	TRAFFIC SIGNAL PLAN
5 – 6	TYPICAL DETAILS OF WHEELCHAIR RAMPS
7 – 14	STANDARD DETAILS
1 31	
*	
	•



STATE OF HAWAII

## DEPARTMENT OF TRANSPORTATION HIGHWAYS DIVISION


HONOLULU, HAWAII


"AS BUILT"

PLANS FOR

FARRINGTON HIGHWAY, TRAFFIC SIGNALS
AT HELELUA STREET AND
AT HALEAKALA AVENUE
PROJECT NO. 93A-01-82

DISTRICT OF WAIANAE
ISLAND OF OAHU

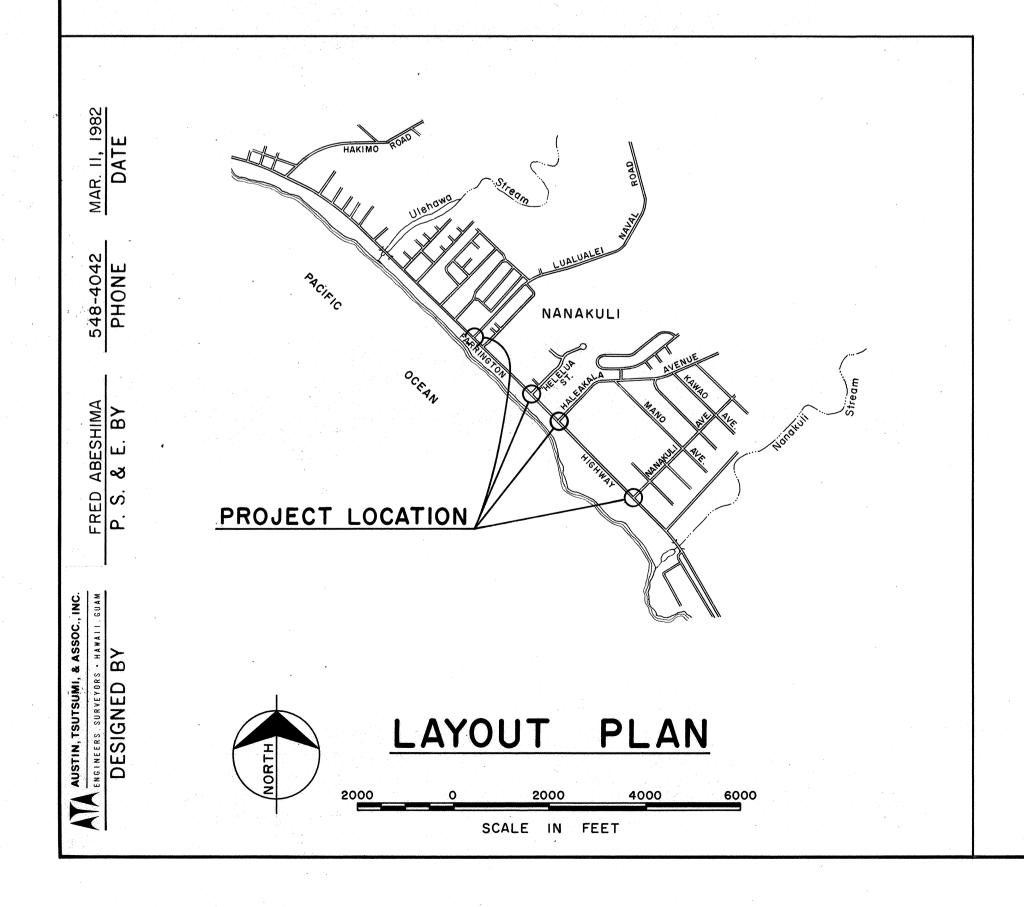

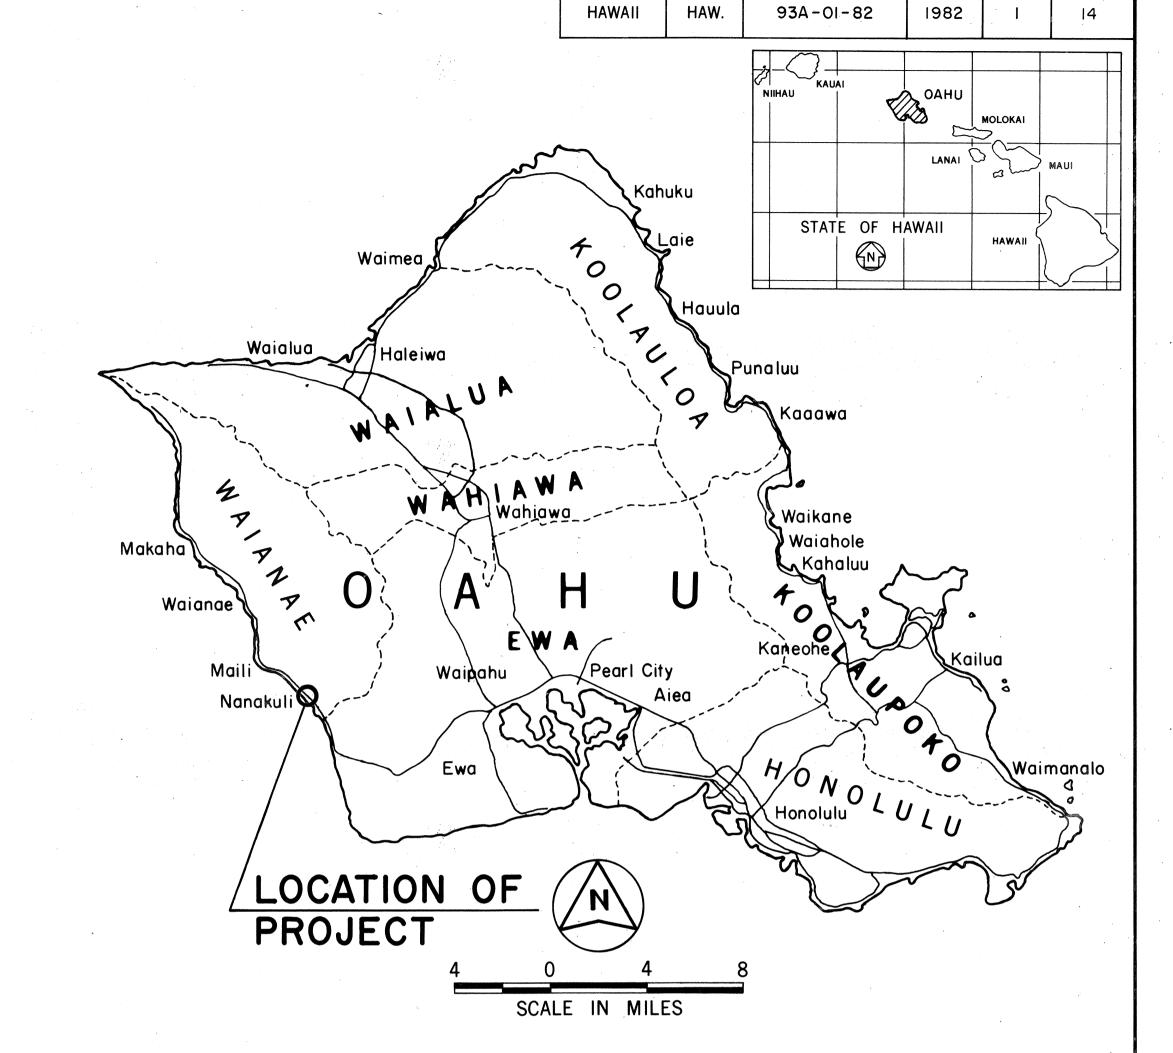

FED. ROAD DIST. NO.

ALL CHANGES MADE DURING CONSTRUCTION HAVE BEEN INCORPORATED ON THESE PLANS IN RED EXCEPT CHANGES IN THE ORIGINAL THEORETICAL QUANTITIES, FOR ACTUAL QUANTITIES, REFER TO PROJECT LEDGER AND/OR COMPUTATION BOOK.

Robert Y. Omai RESIDENT ENGINEER

5/14/84 DATE

FISCAL SHEET TOTAL YEAR NO. SHEETS

PROJ. NO.

DEPARTMENT OF TRANSPORTATION
STATE OF HAWAII

APPROVED:

James R. Canas 3/5/82