

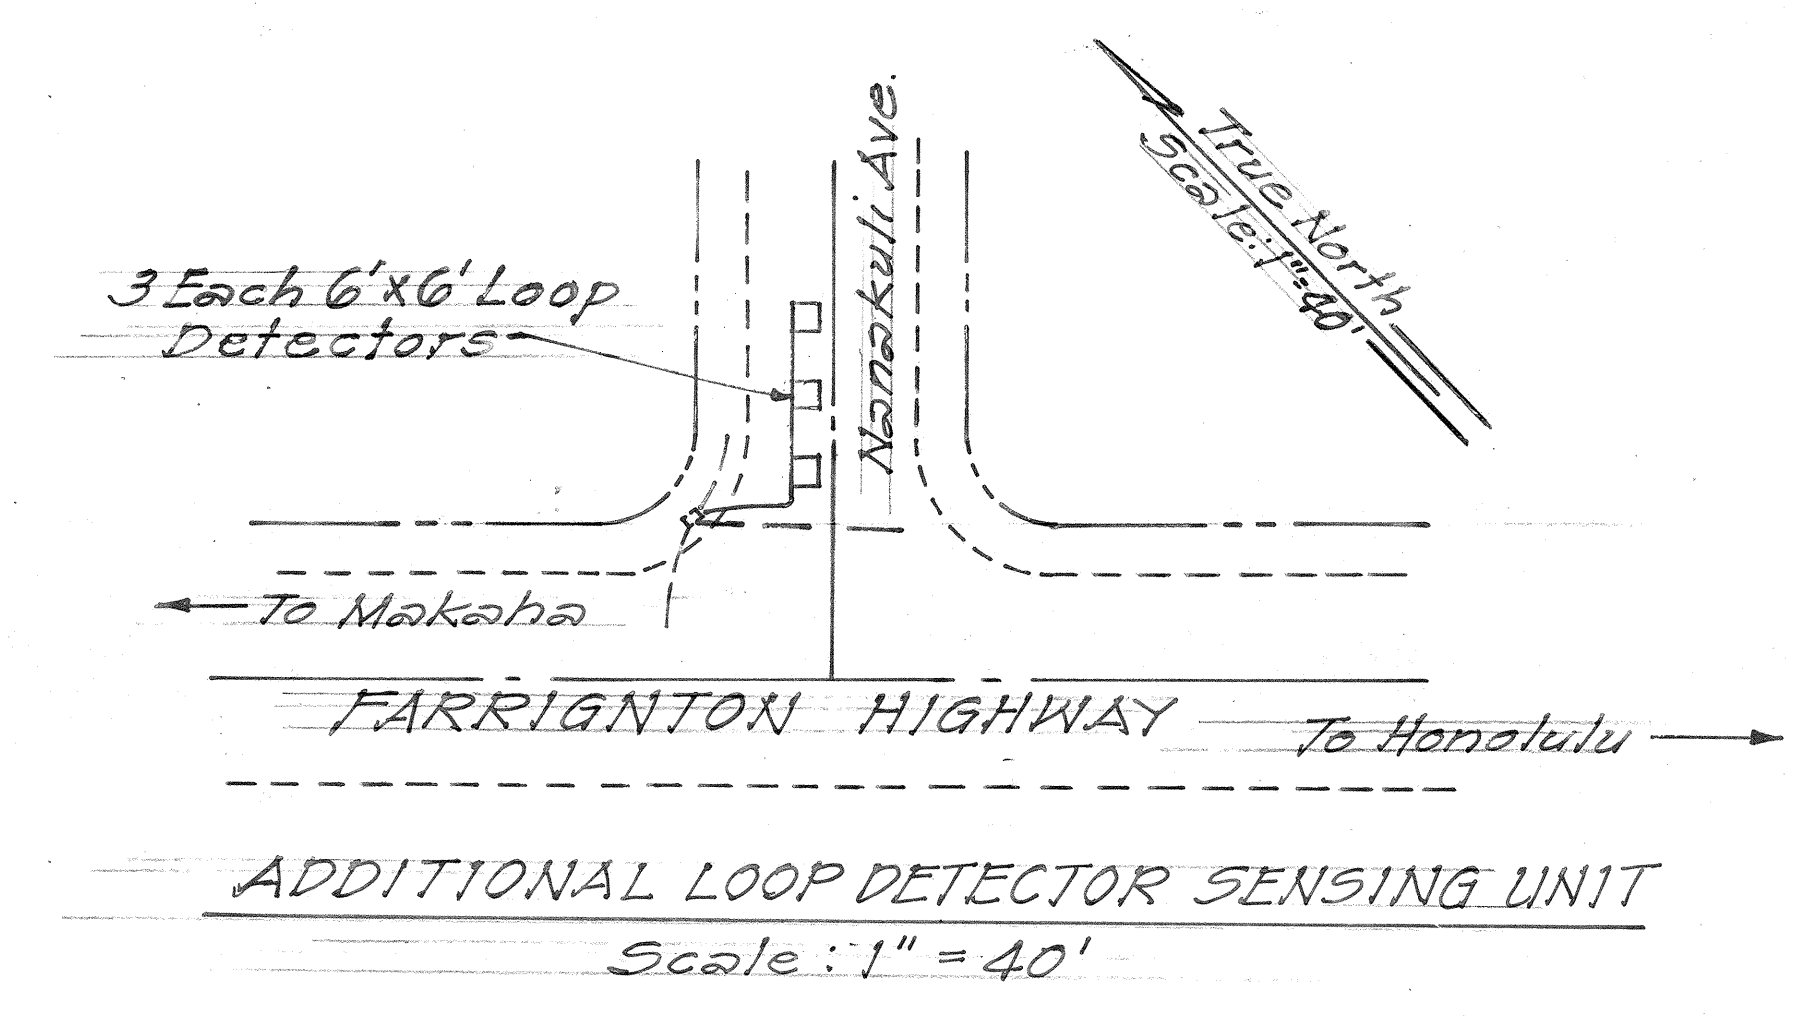
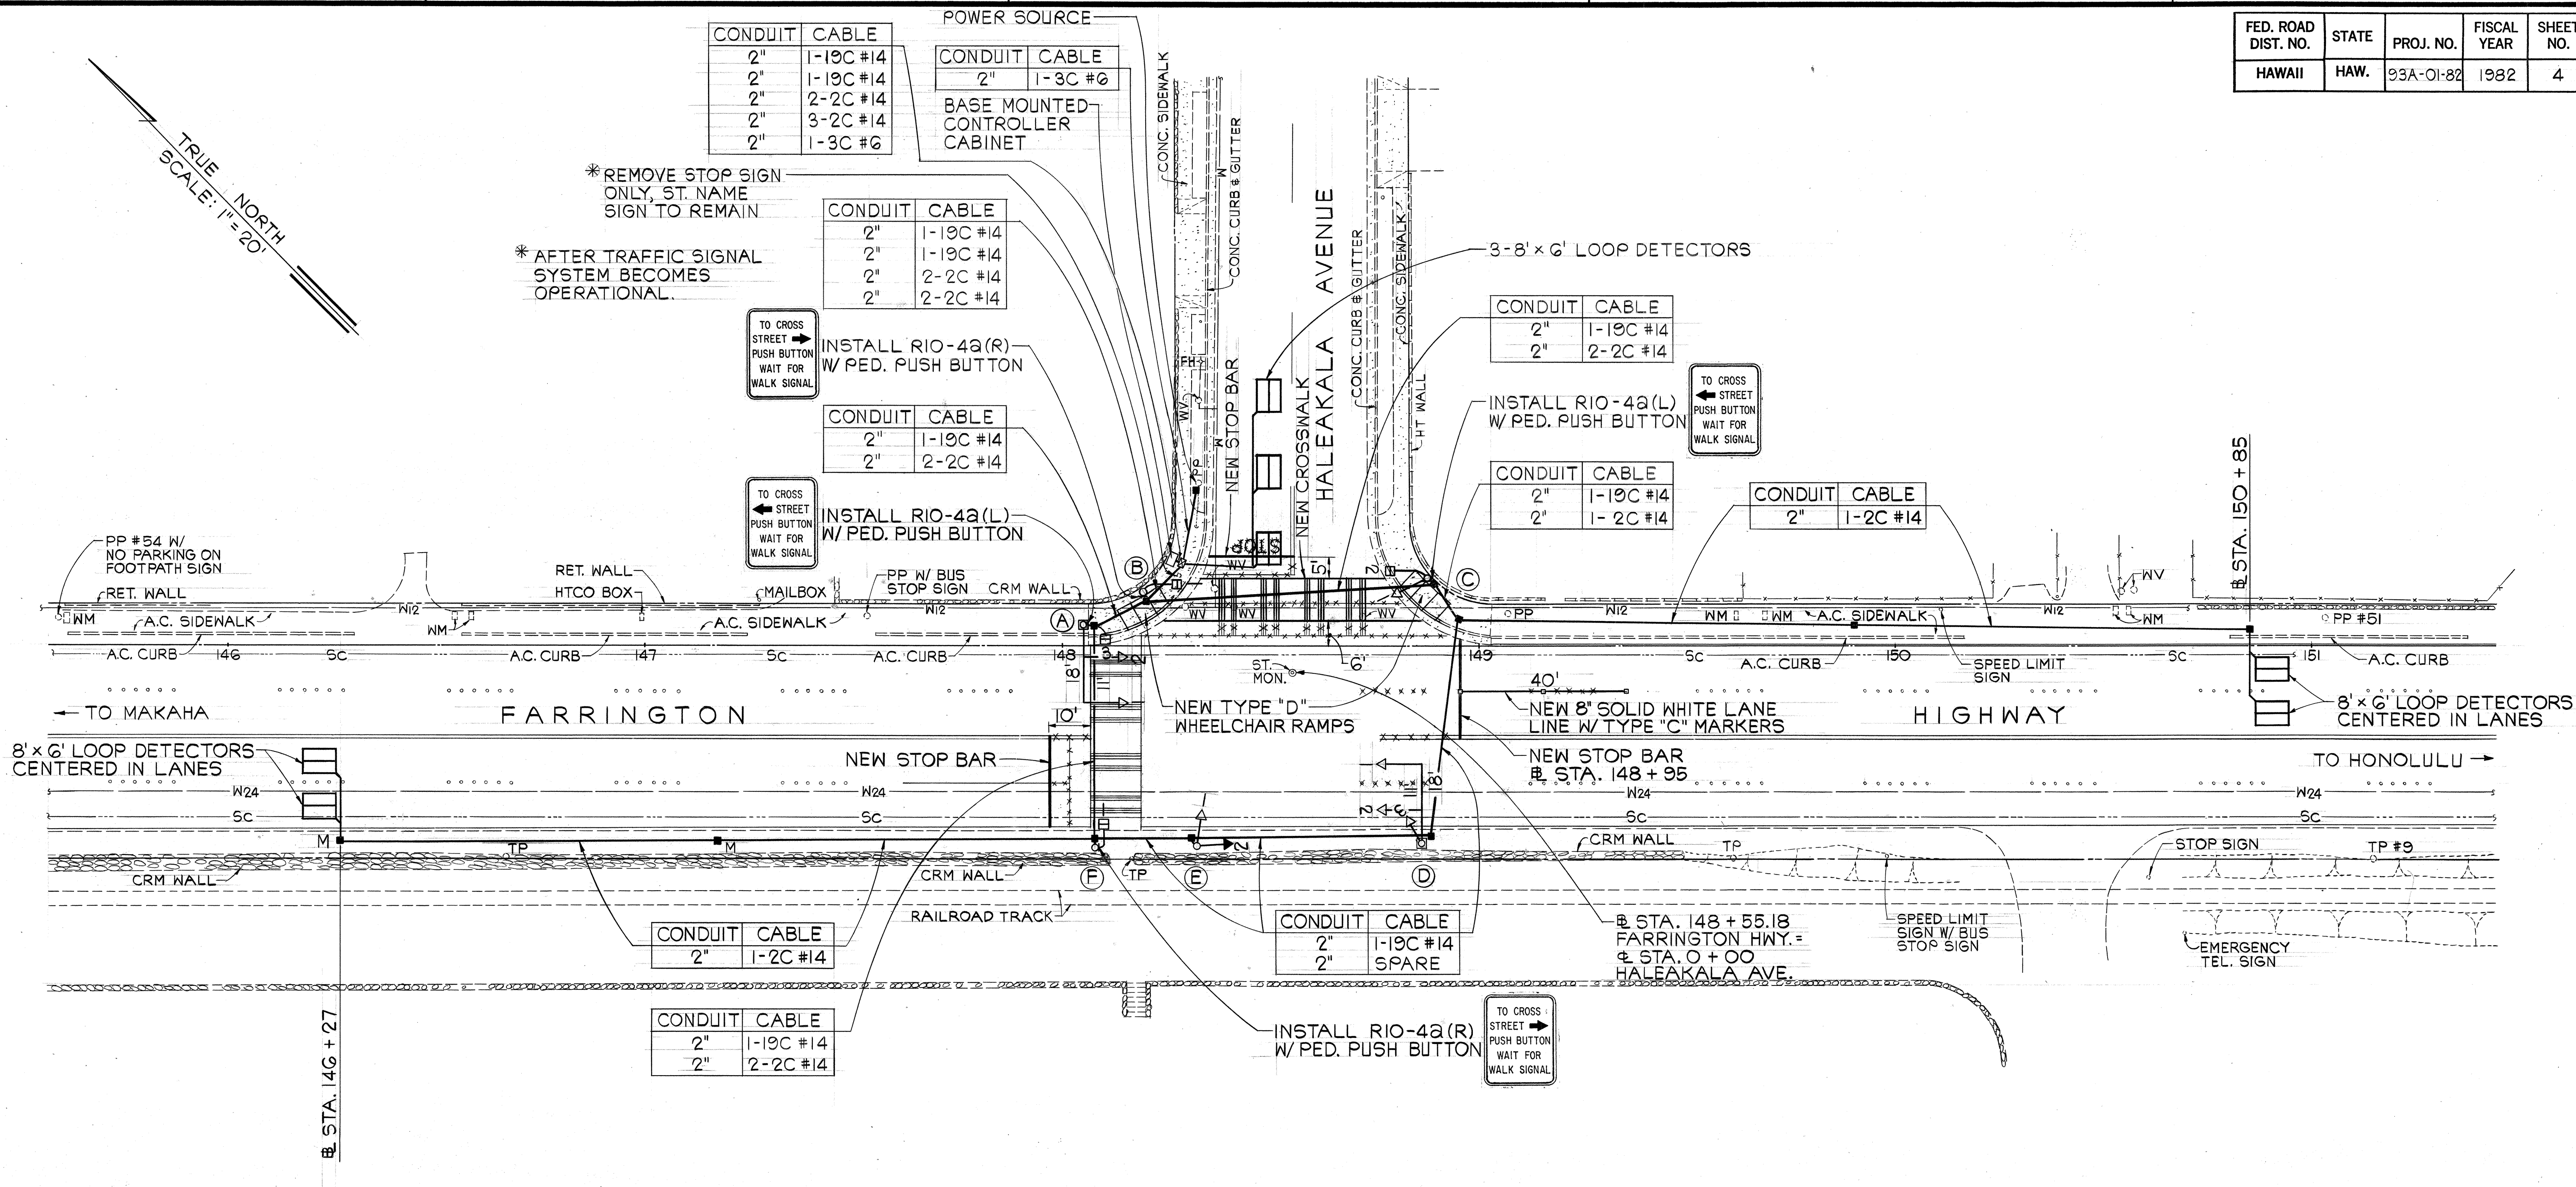


FED. ROAD DIST. NO.	STATE	PROJ. NO.	FISCAL YEAR	SHEET NO.	TOTAL SHEETS
HAWAII	HAW.	93A-01-82	1982	4	14

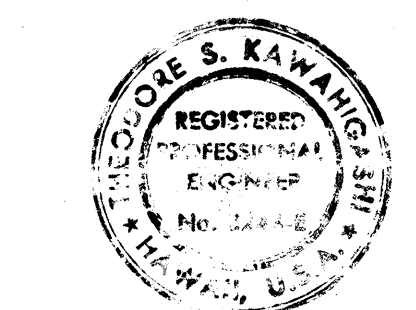

PHASE DIAGRAM

SIGNAL INDICATIONS

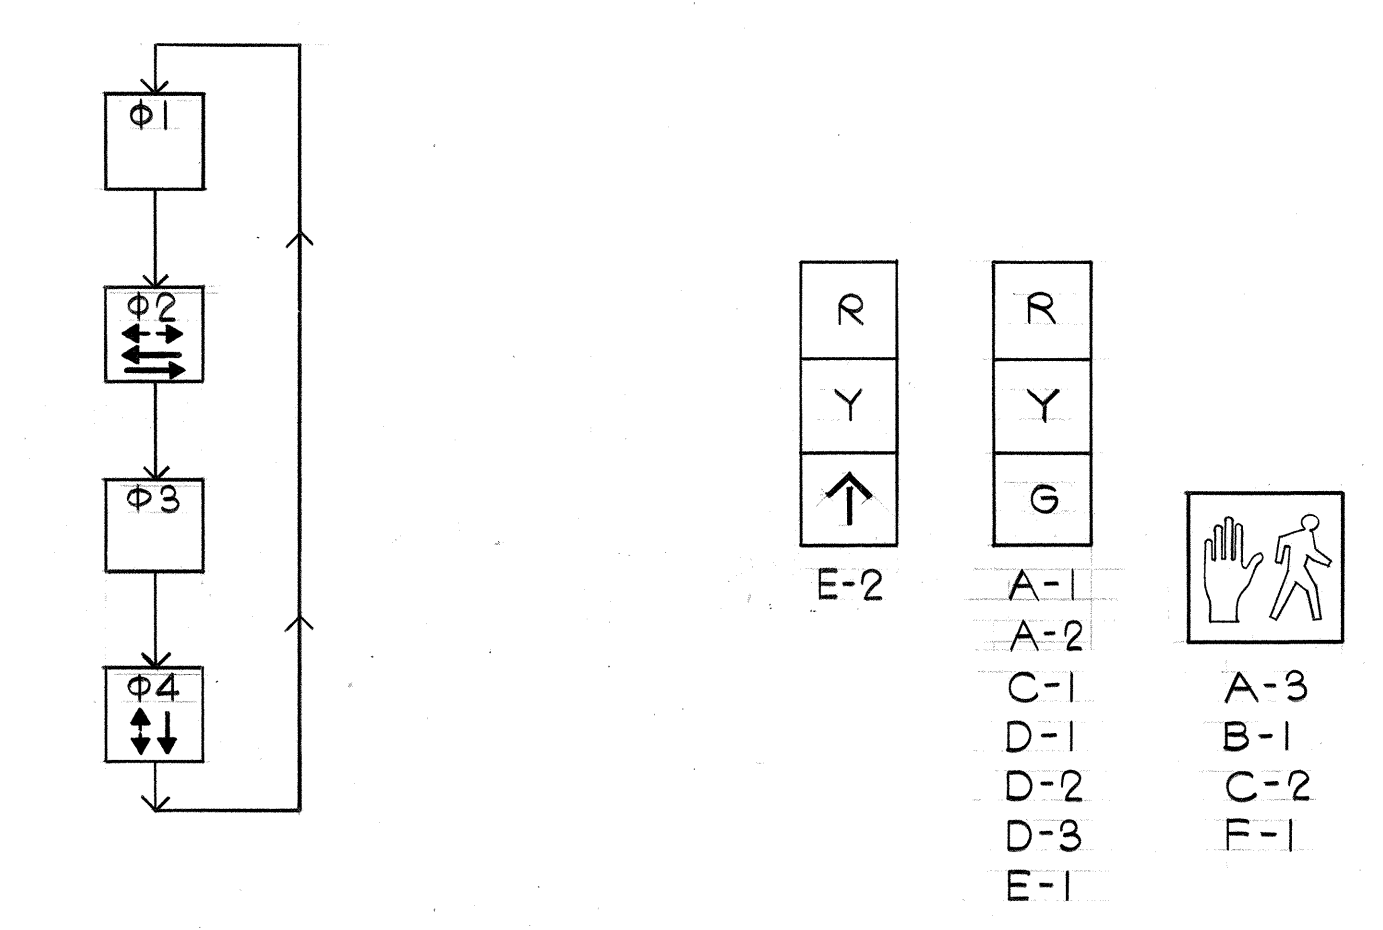

THIS WORK WAS PREPARED BY ME
OR UNDER MY SUPERVISION
Shirley A. Kawaijima
Signature

STATE OF HAWAII
DEPARTMENT OF TRANSPORTATION
HIGHWAYS DIVISION

TRAFFIC SIGNAL PLAN
(HALEAKALA AVENUE)

FARRINGTON HWY, TRAFFIC SIGNALS
AT HELELUA STREET AND
AT HALEAKALA AVENUE
PROJECT NO. 93A-01-82
SCALE: AS SHOWN
DATE: 3-11-82
SHEET No. 2 OF 2 SHEETS

4