1	
•	INDEX TO DRAWINGS
SHEET NO.	DESCRIPTION
	TITLE SHEET
2	LEGEND AND NOTES
3	TRAFFIC SIGNAL PLAN
4-10	STANDARD DETAILS
4	
1 20	
	•



STATE OF HAWAII

TRANSPORTATION DEPARTMENT HIGHWAYS DIVISION


HONOLULU, HAWAII

"AS BUILT"

PLANS FOR

FARRINGTON HIGHWAY TRAFFIC SIGNALS AT WAIANAE SHOPPING MALL PROJECT NO. 93A-02-82


DISTRICT OF WAIANAE ISLAND OF OAHU

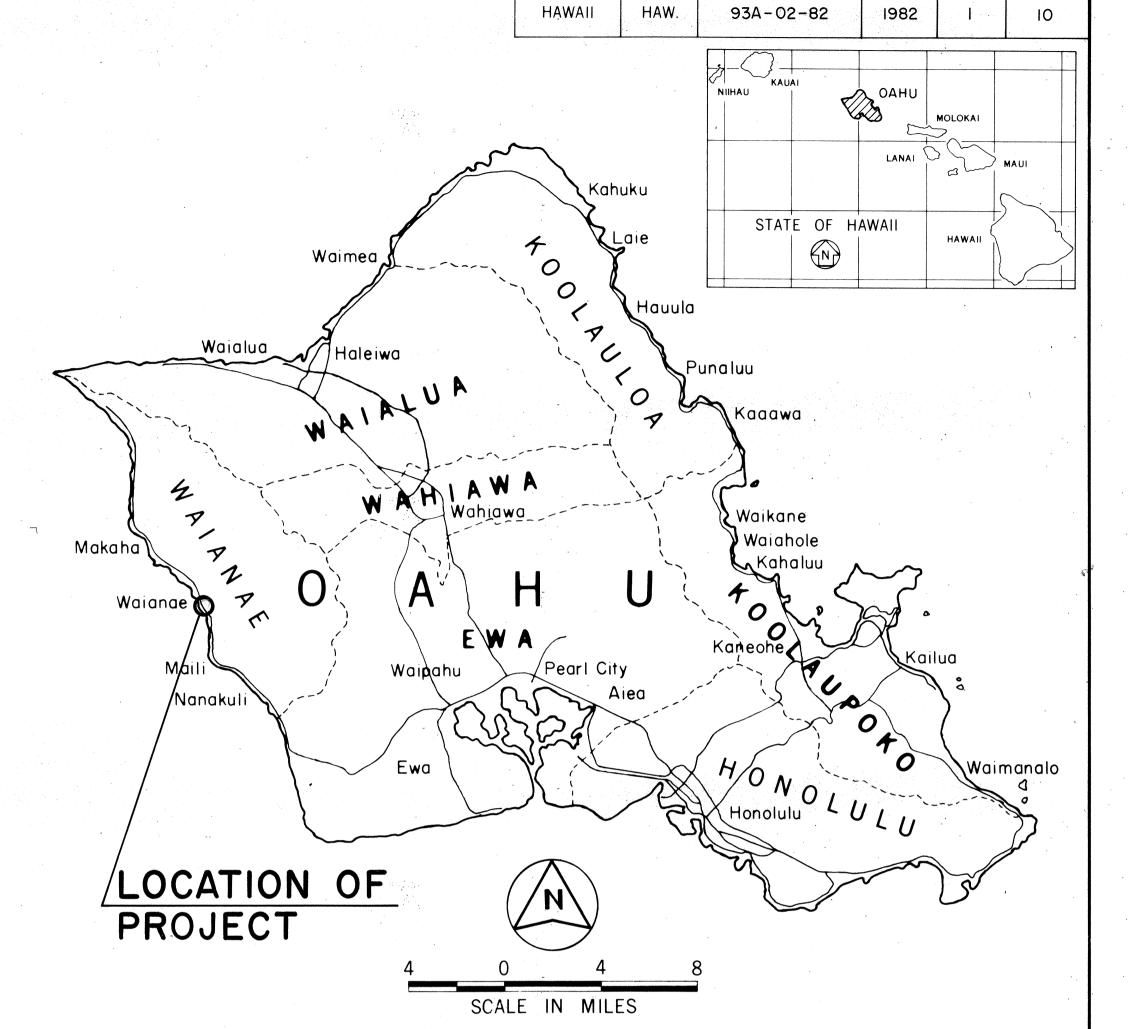

FED. ROAD DIST. NO.

FISCAL YEAR

PROJ. NO.

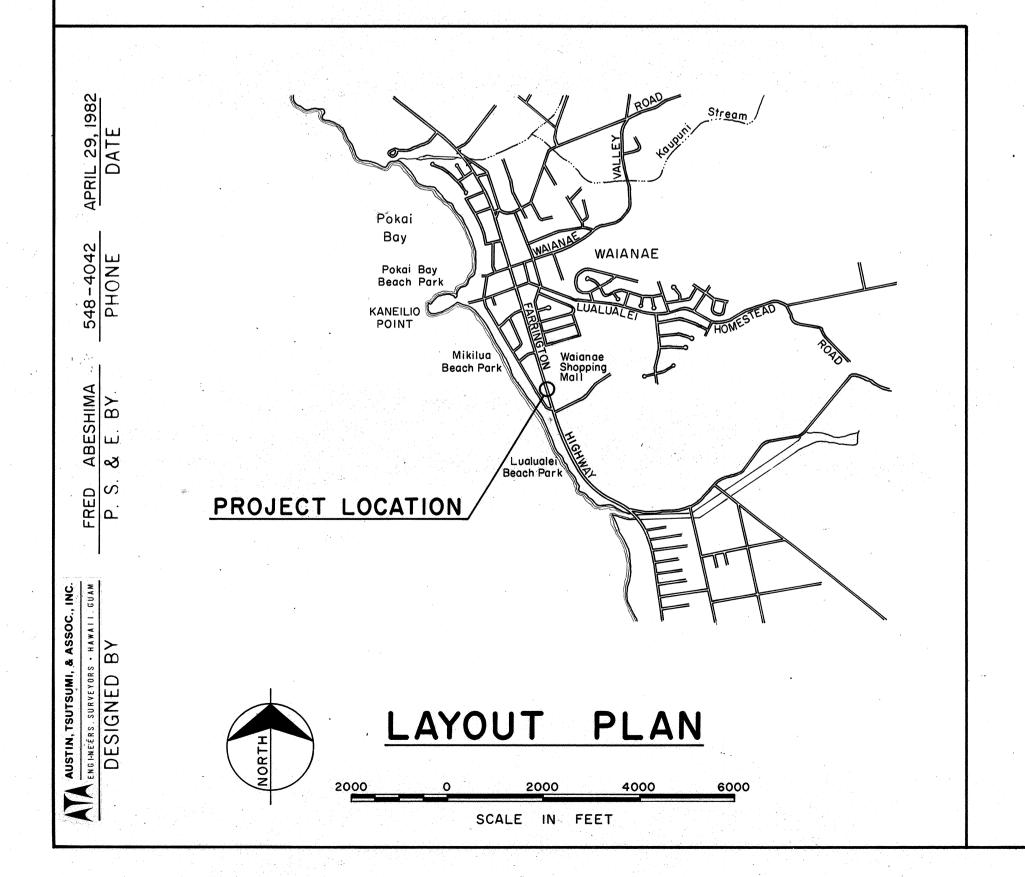

ORIGINAL THEORETICAL QUANTITIES. FOR ACTUAL QUANTITIES, REFER TO PROJECT LEDGER AND/OR COMPUTATION BOOK.

DEPARTMENT OF TRANSPORTATION STATE OF HAWAII