
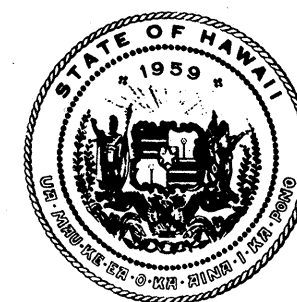
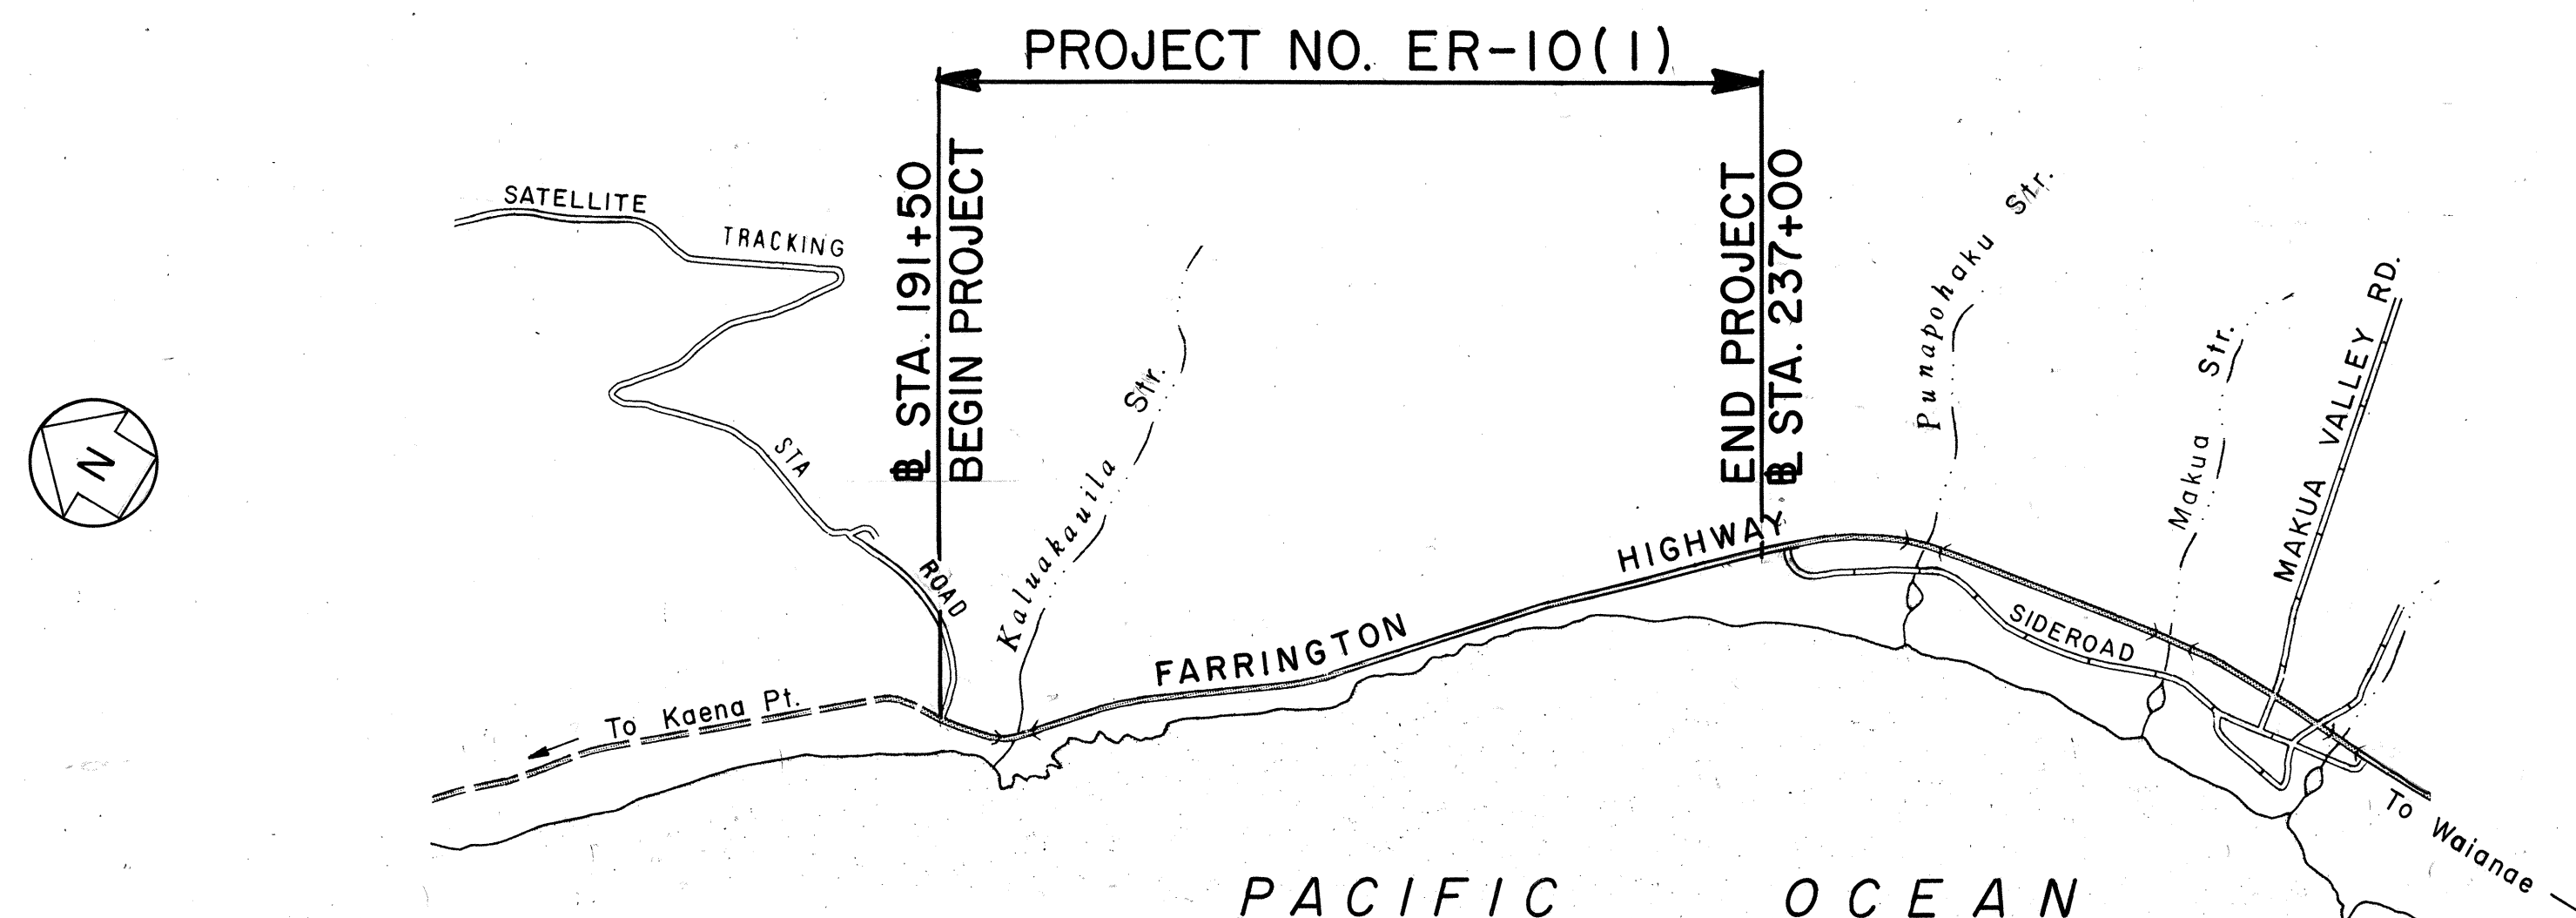
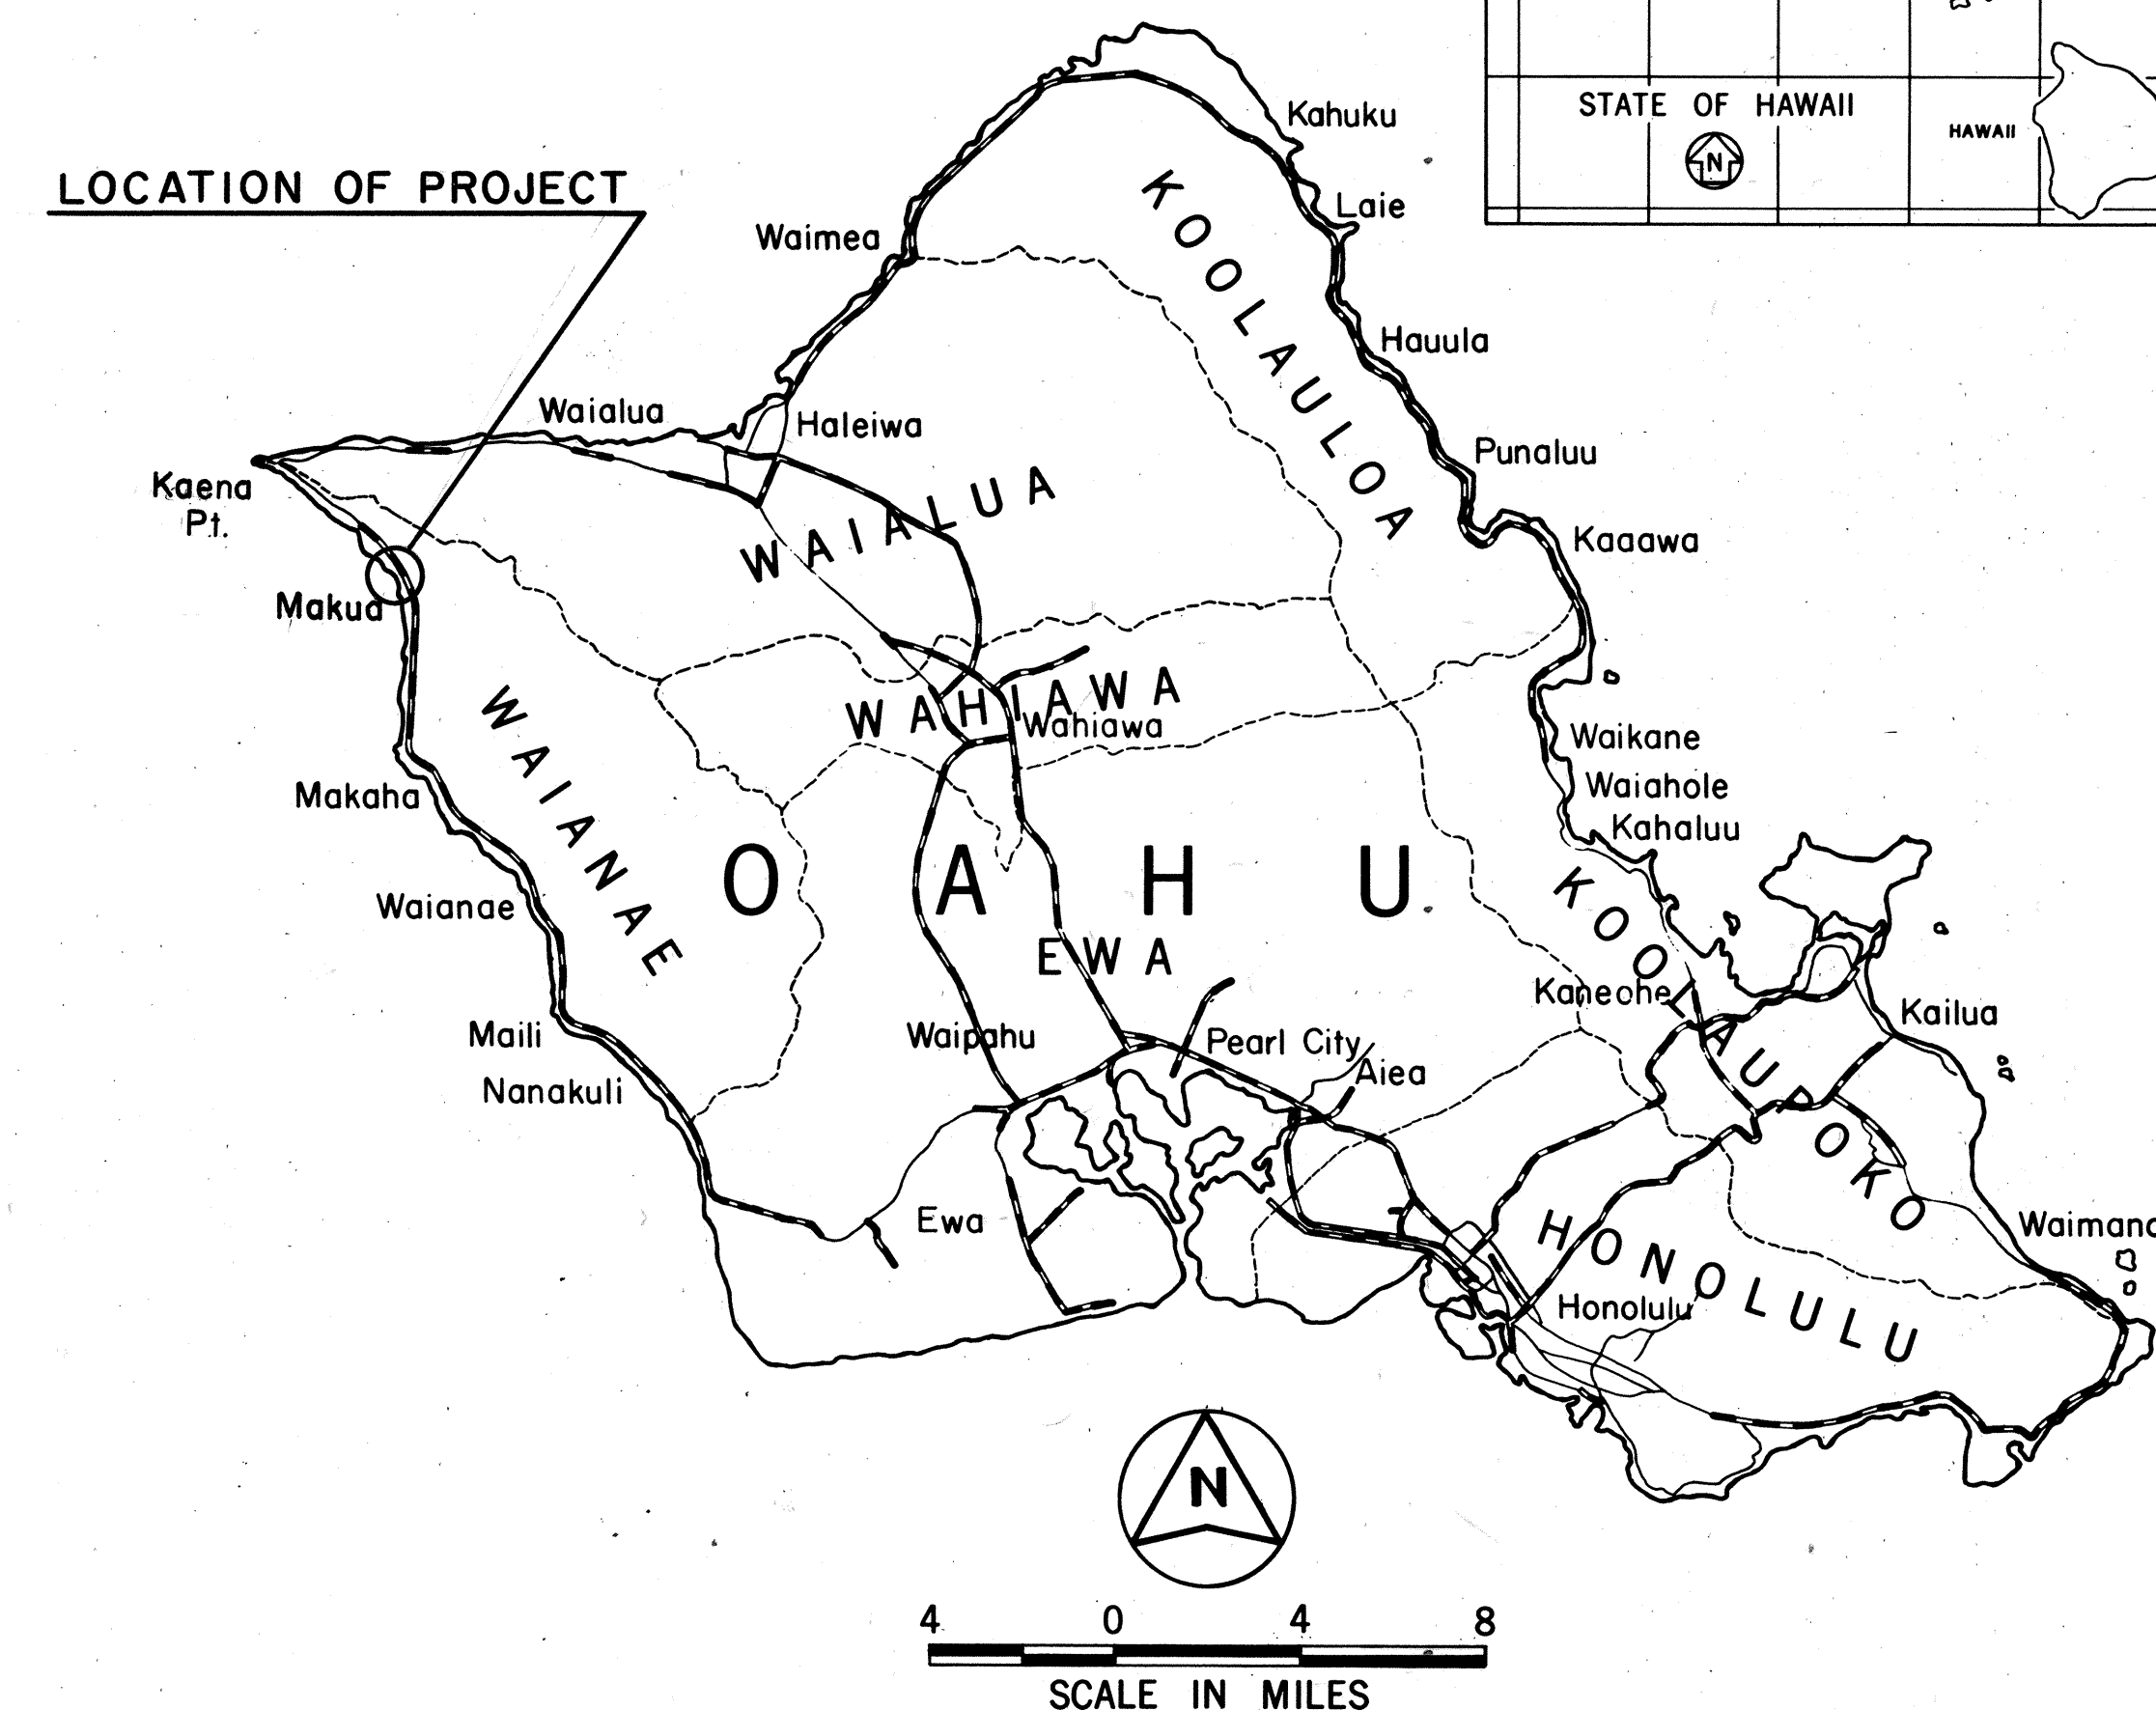


[illegible]

STATE OF HAWAII  
DEPARTMENT OF TRANSPORTATION  
HIGHWAYS DIVISION  
**"AS-BUILT"**  
PLANS FOR  
FARRINGTON HIGHWAY  
EMERGENCY REPAIRS, MAKUA SECTION  
FEDERAL AID PROJECT NO. ER-10(1)

FED. ROAD DIST. NO.	STATE	FED. AID PROJ. NO.	FISCAL YEAR	SHEET NO.	TOTAL SHEET
HAWAII	HAW.	ER-10(1)	1984	1	27

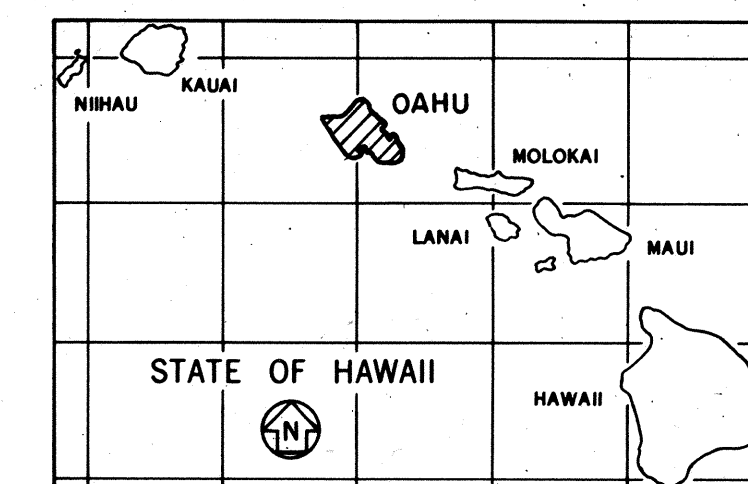


CHANGES MADE DURING CONSTRUCTION HAVE BEEN INCORPORATED ON THESE PLANS EXCEPT CHANGES IN THE ORIGINAL THEORETICAL QUANTITIES. FOR ACTUAL QUANTITIES, REFER TO PROJECT LEDGER AND/OR COMPUTATION BOOK.


10-2-85  
DATE

DESIGN DESIGNATION



## LAYOUT PLAN

DEPARTMENT OF TRANSPORTATION FEDERAL HIGHWAY ADMINISTRATION	
APPROVED:	
	3/14/8
DIVISION ADMINISTRATOR	DATE

DEPARTMENT OF TRANSPORTATION STATE OF HAWAII	
APPROVED:  DIR. OF TRANSPORTATION	2/29/04 DATE