




FED. ROAD DIST. NO.	STATE	PROJ. NO.	FISCAL YEAR	SHEET NO.	TOTAL SHEETS
HAWAII	HAW.	93A-01-85M	1985	2	30

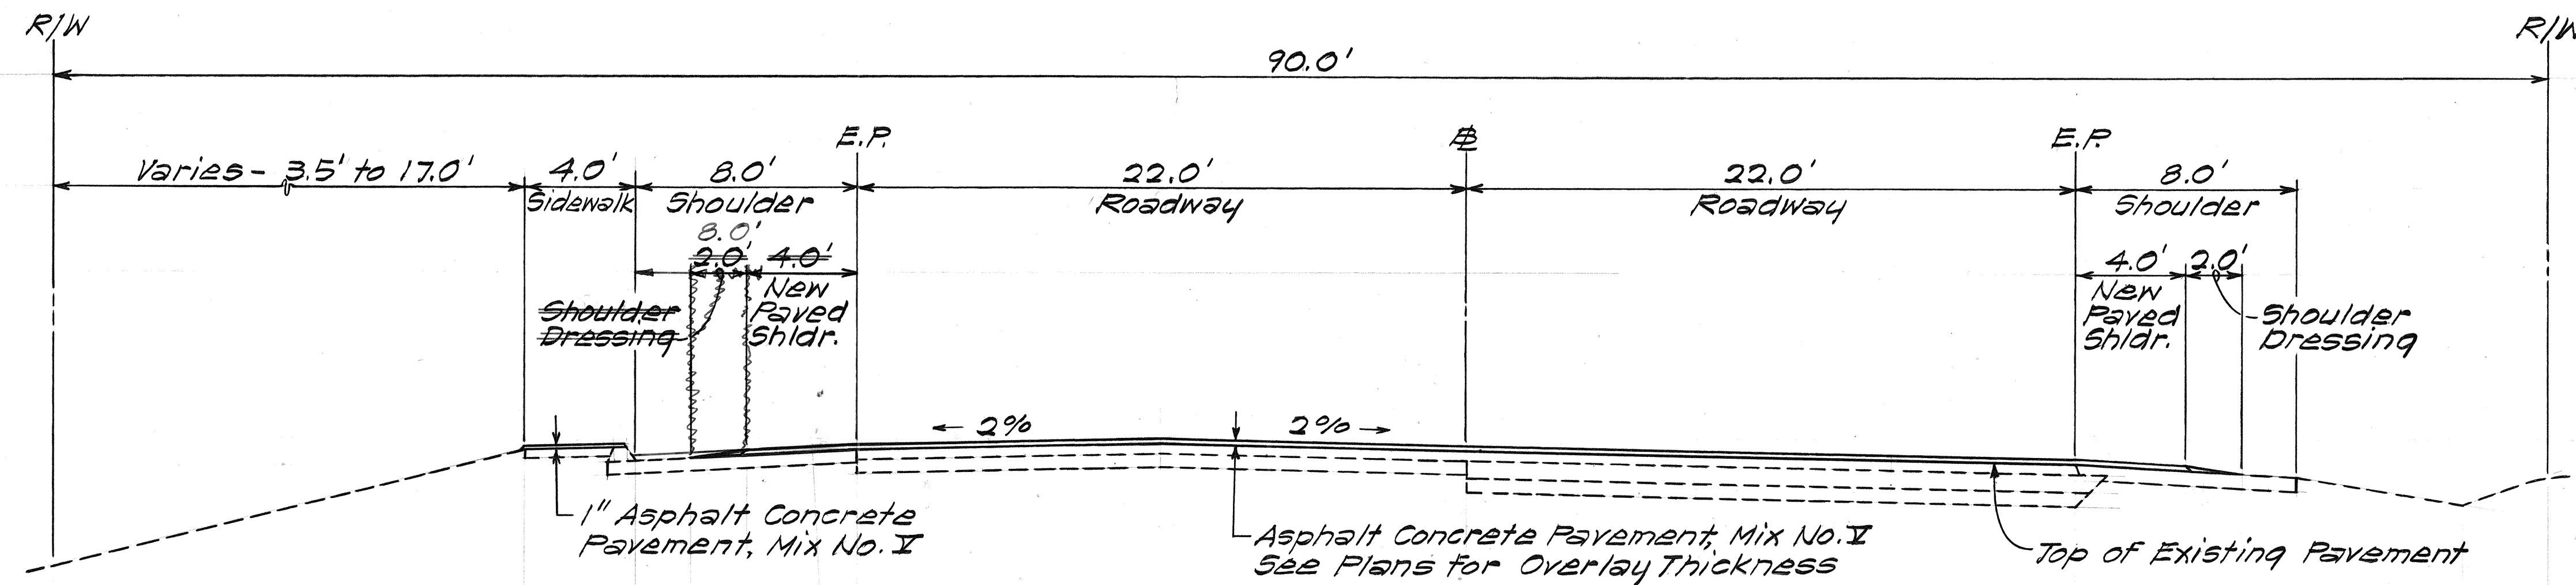


TYPICAL SECTION ON TANGENT
Scale: 1/4" = 1'-0"

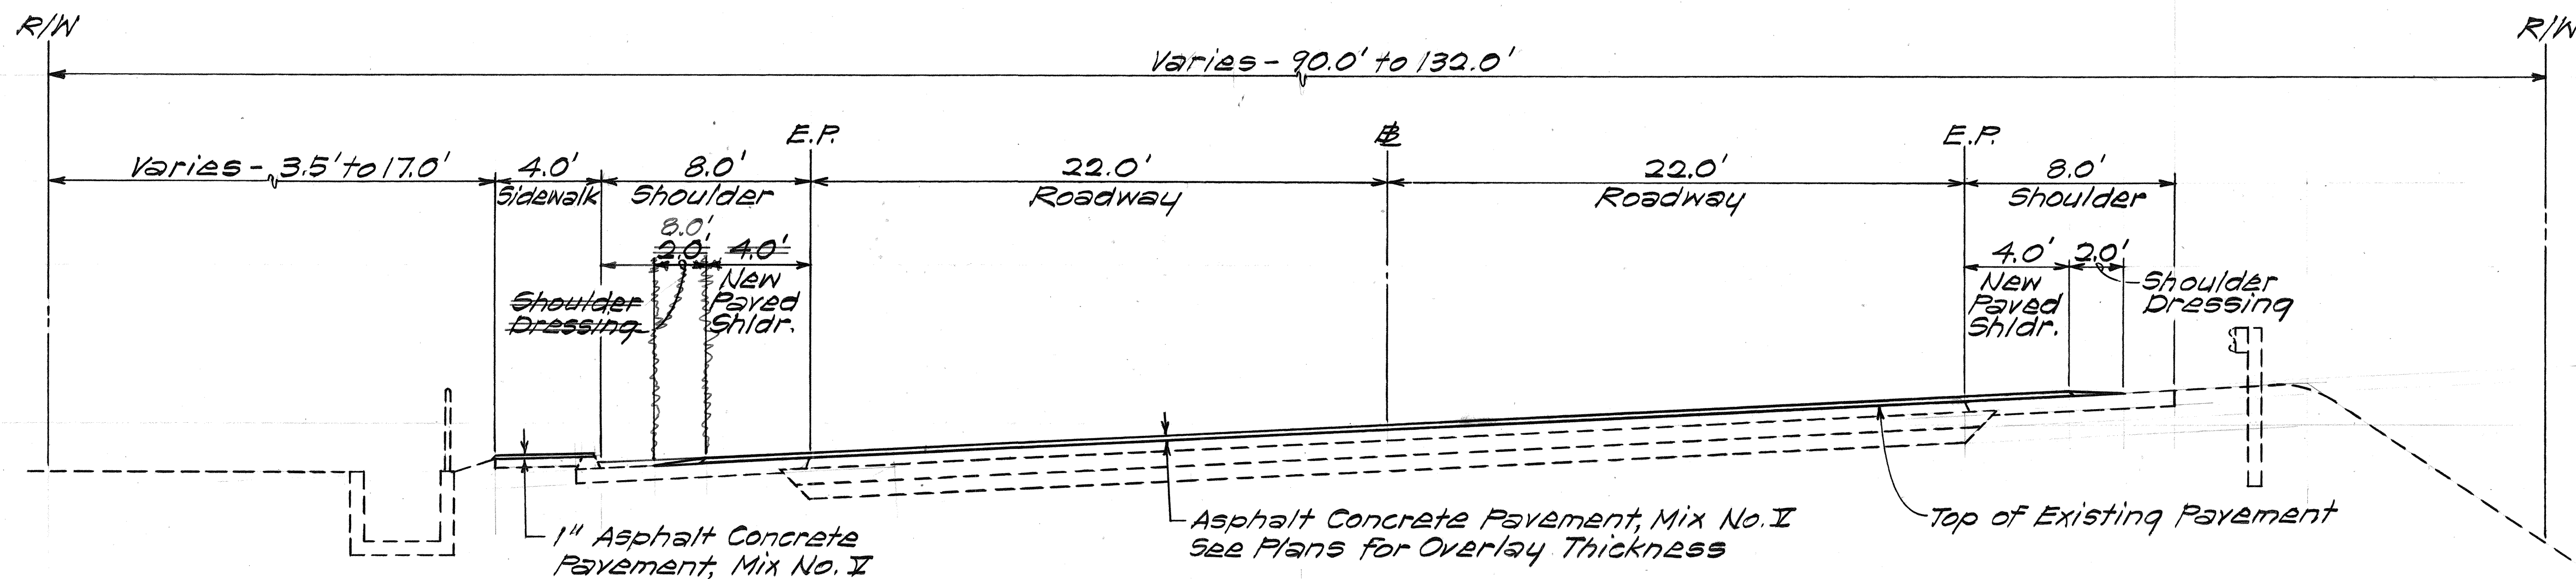


TYPICAL SECTION ON CURVE
Scale: 1/4" = 1'-0"

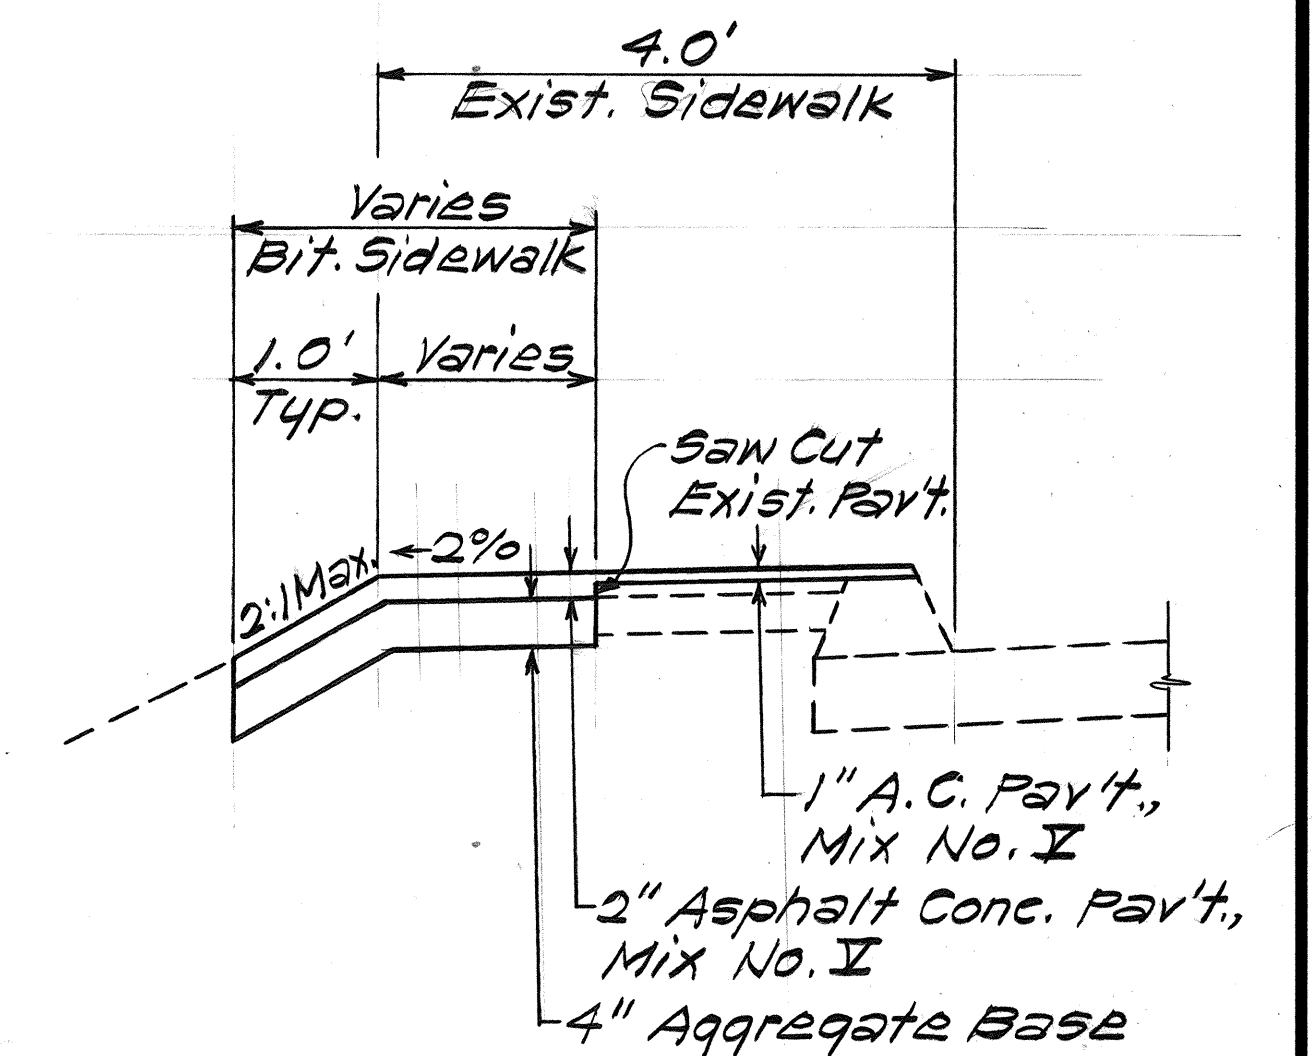


SIDEWALK RECONSTRUCTION
Scale: 3/4" = 1'-0"

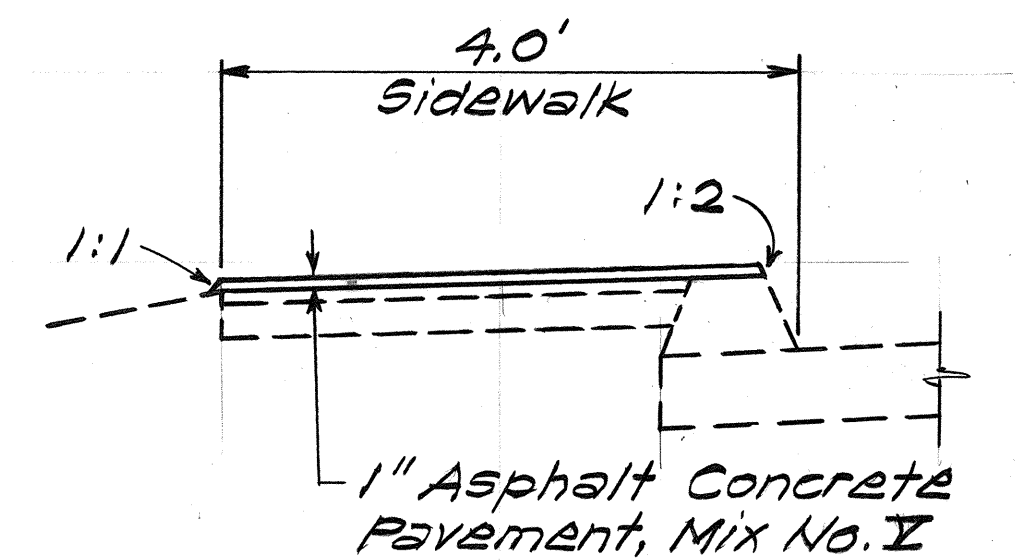


SIDEWALK RESURFACING
Scale: 3/4" = 1'-0"

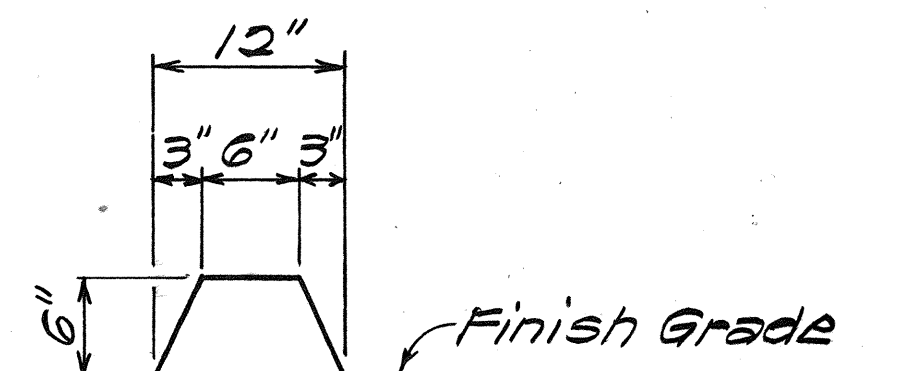

BITUMINOUS CURB TYPE 6
Scale: 1" = 1'-0"

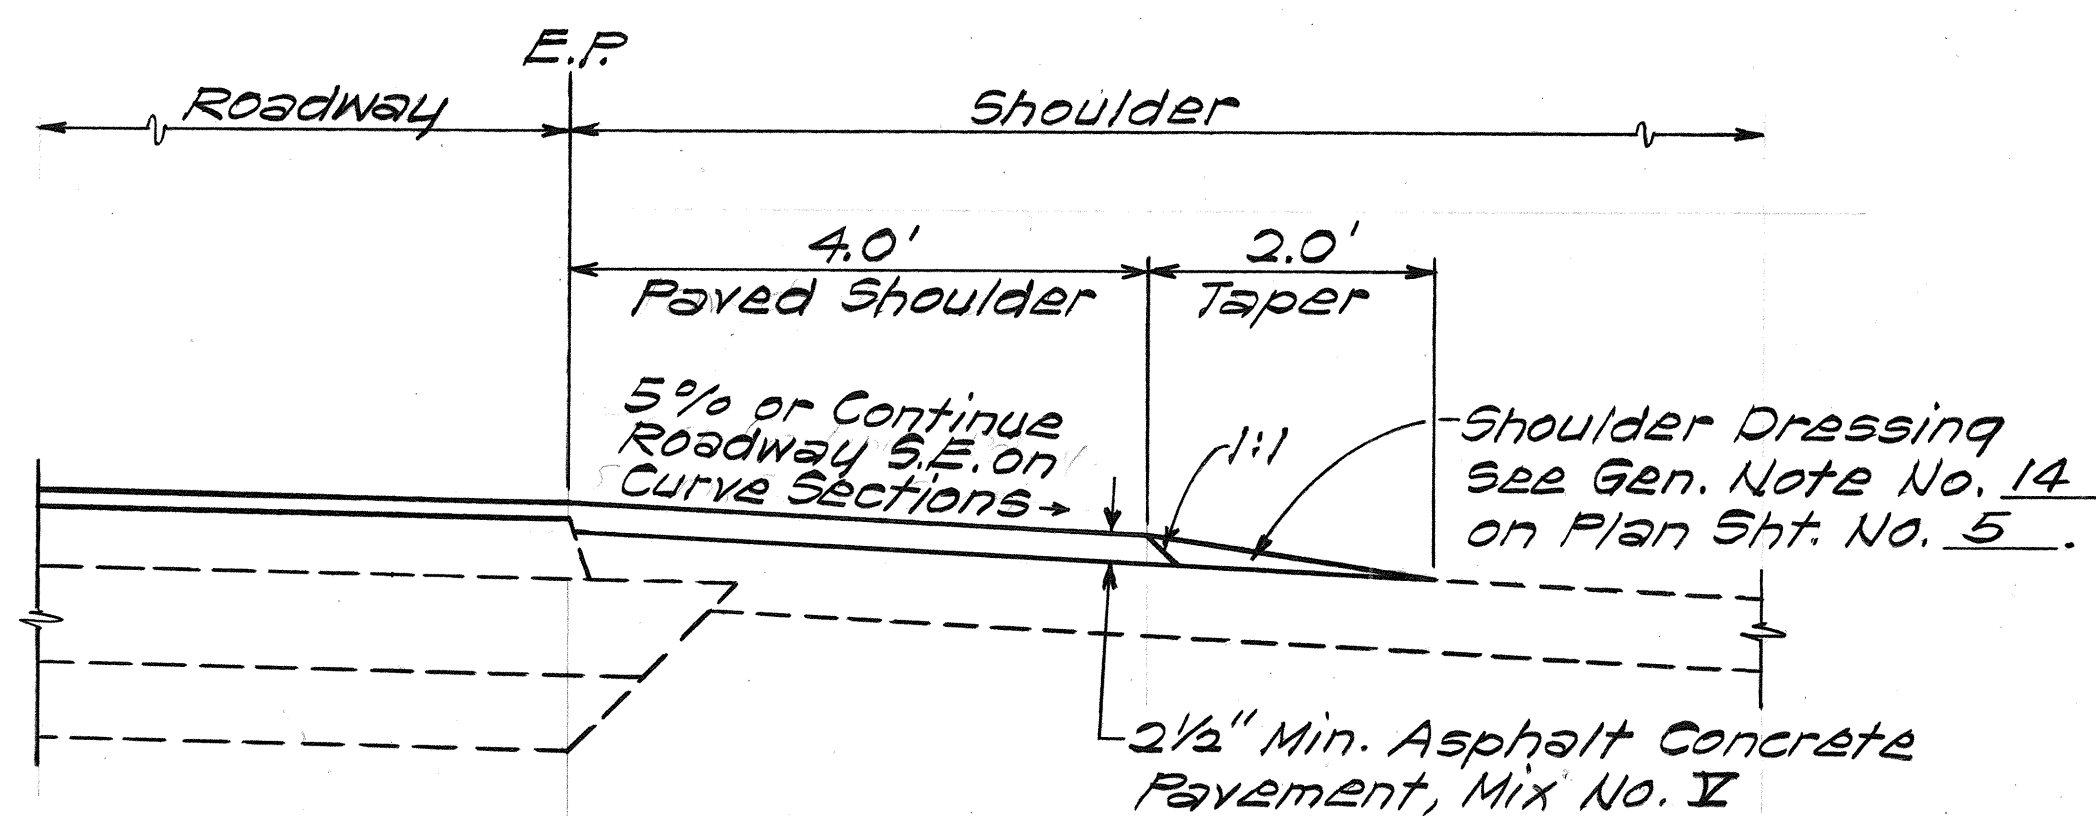


TYPICAL SECTION PAVED SHOULDER
Scale: 3/4" = 1'-0"

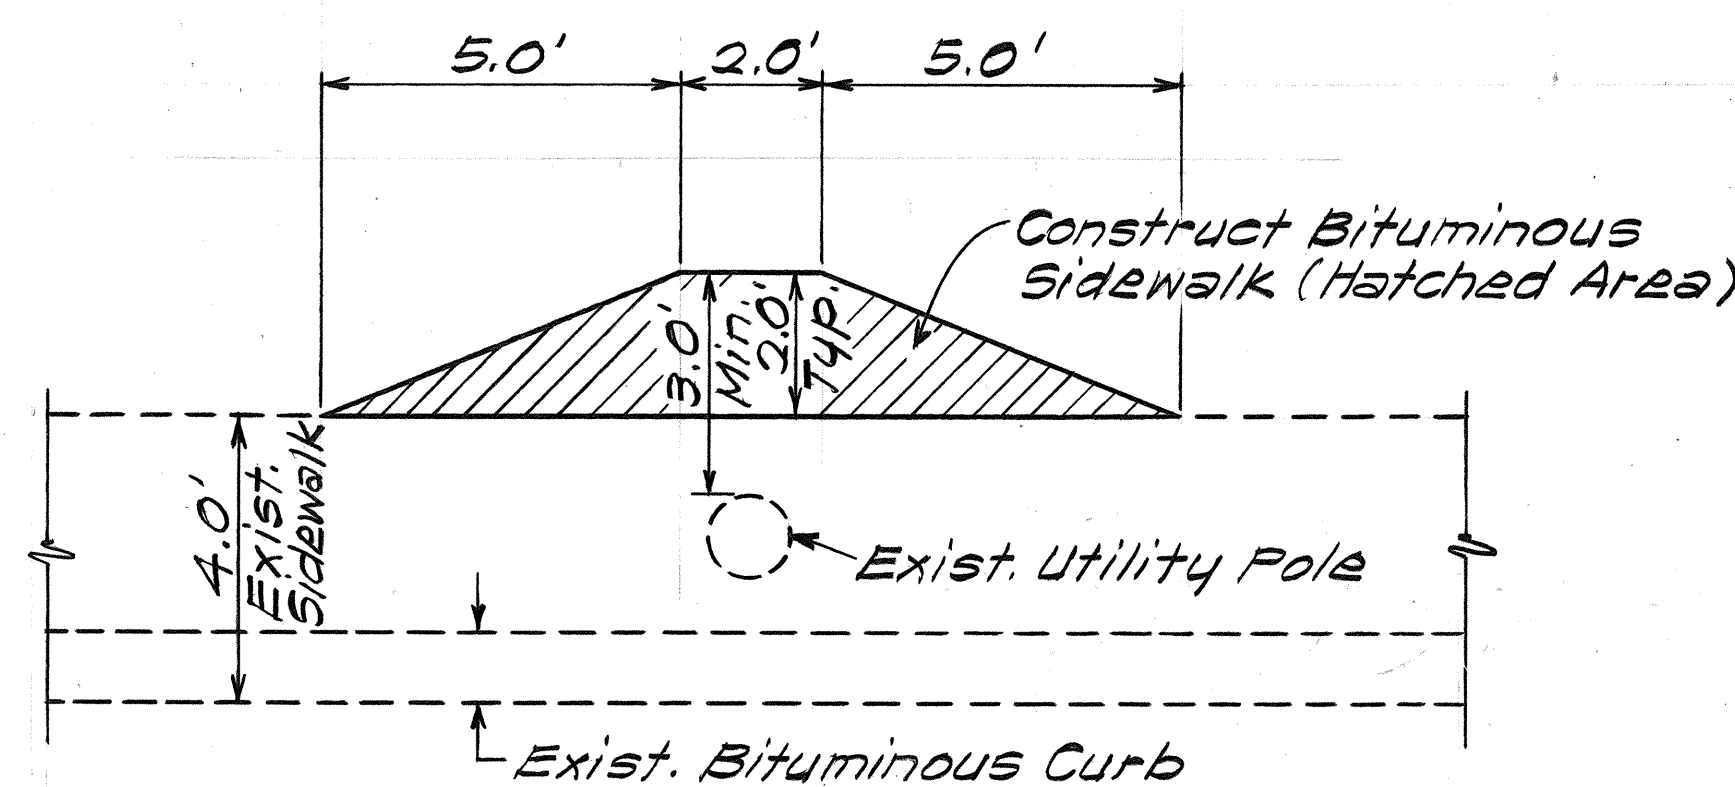


TYPICAL PLAN BITUMINOUS SIDEWALK AROUND UTILITY POLE
Scale: 3/8" = 1'-0"

STATE OF HAWAII DEPARTMENT OF TRANSPORTATION HIGHWAYS DIVISION
TYPICAL SECTIONS
FARRINGTON HIGHWAY RESURFACING Palanaki St. toward Uluhewa Bridge PROJECT NO. 93A-01-85M
Scale: As Shown Date: Nov., 1984
SHEET No. E1 OF 3 SHEETS


FED. ROAD DIST. NO.	STATE	PROJ. NO.	FISCAL YEAR	SHEET NO.	TOTAL SHEETS
HAWAII	HAW.	93A-01-85M	1985	3	30

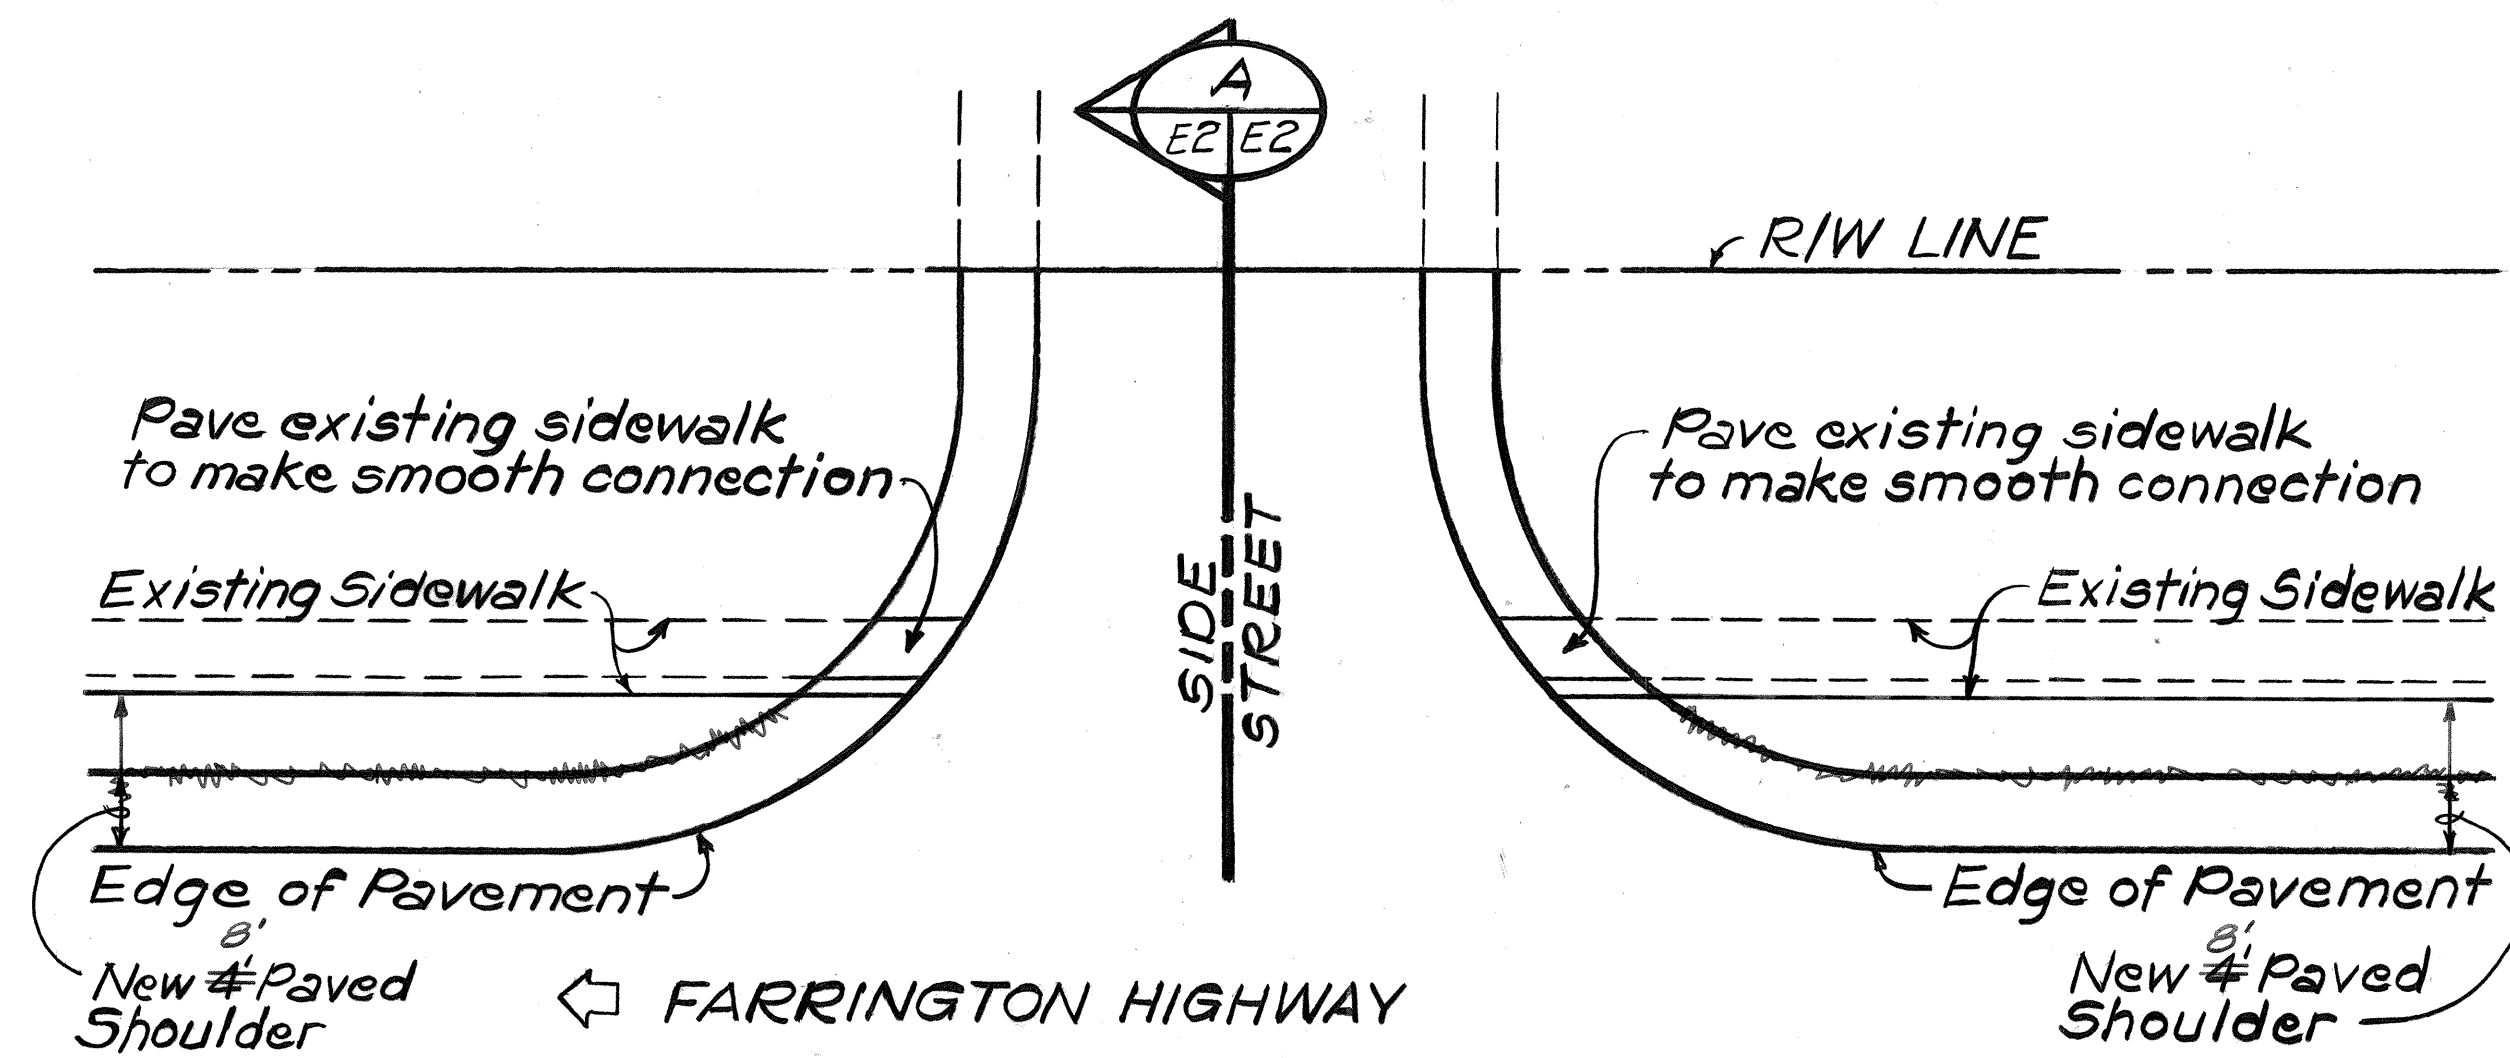


TYPICAL SIDE STREET PLAN
Scale: 1" = 10'

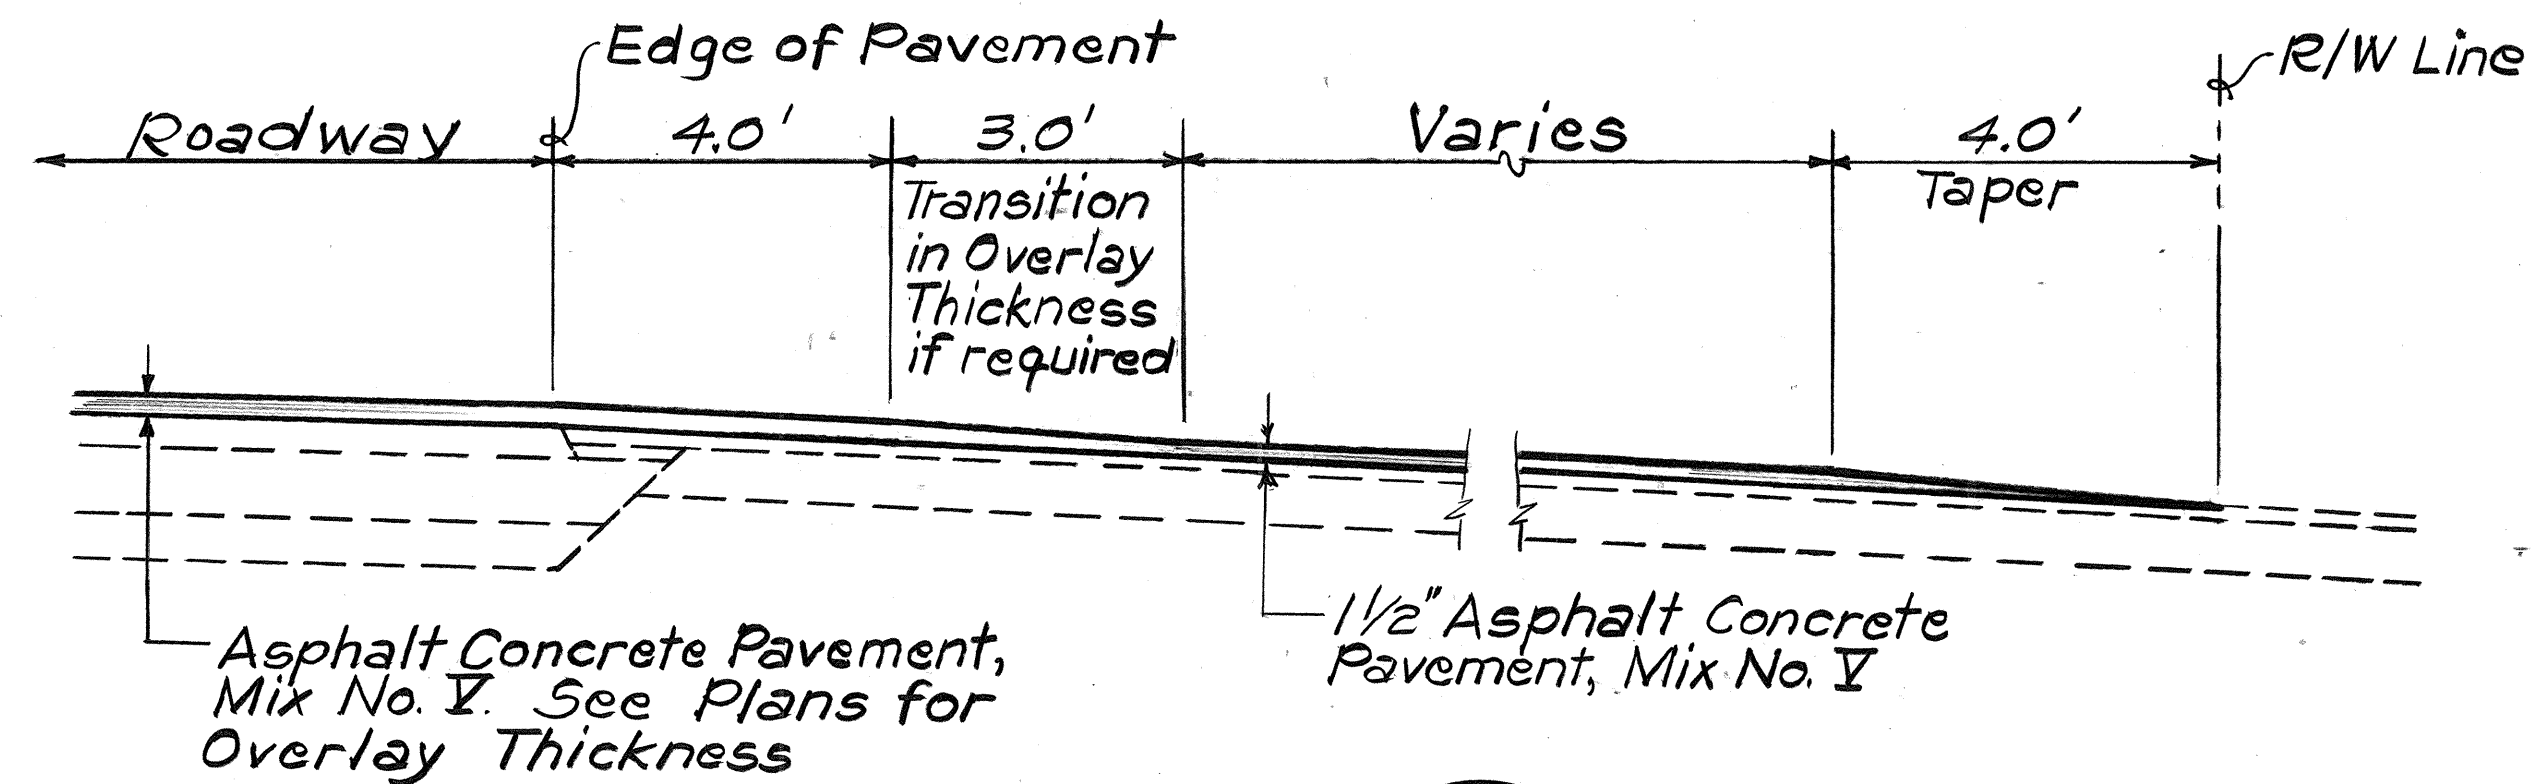


SECTION A
Scale: 1/2" = 1'-0"

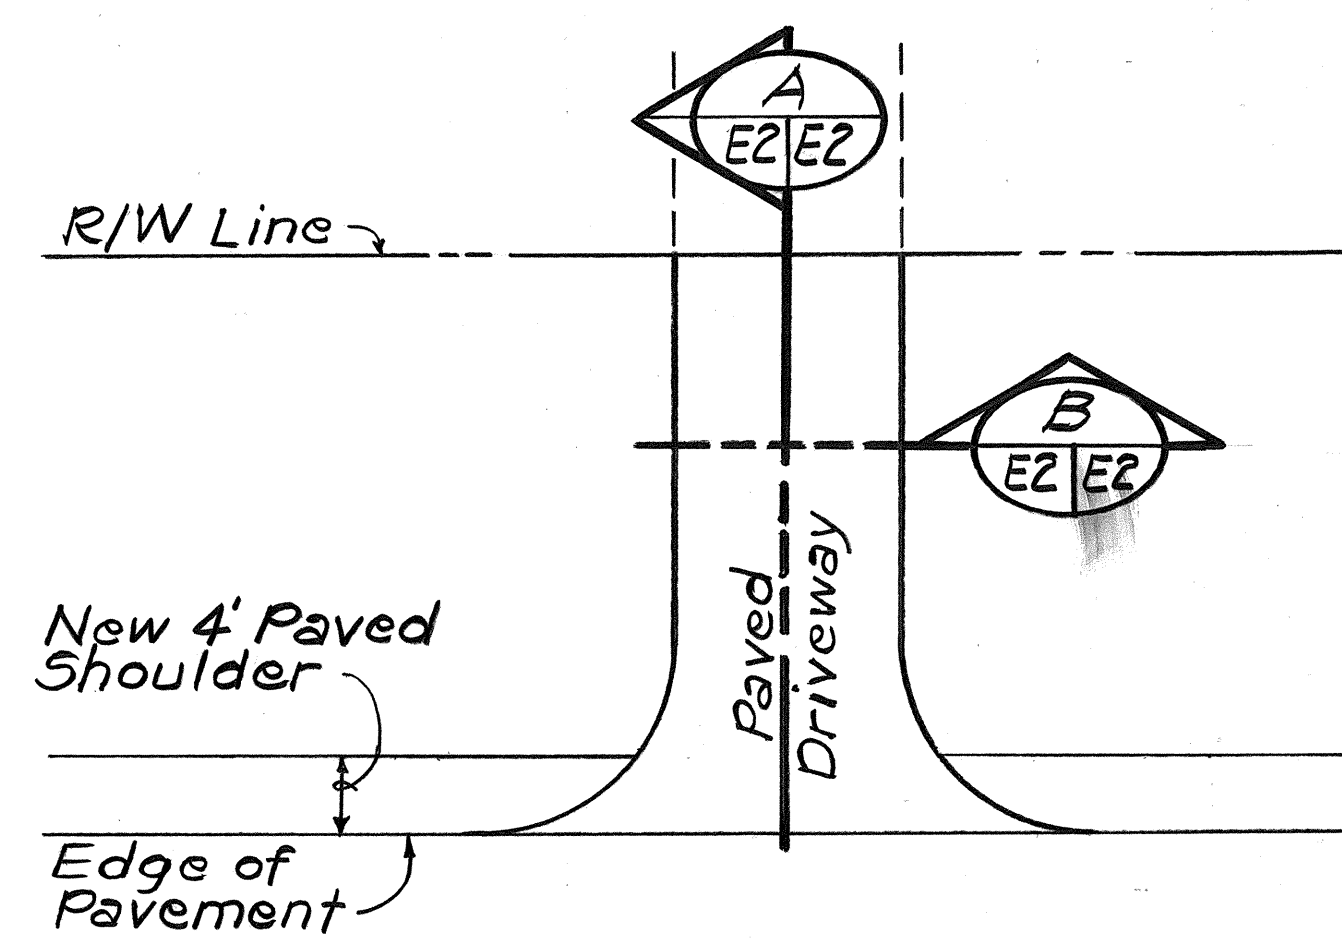


TYPICAL PAVED DRIVEWAY PLAN
Scale: 1" = 10'

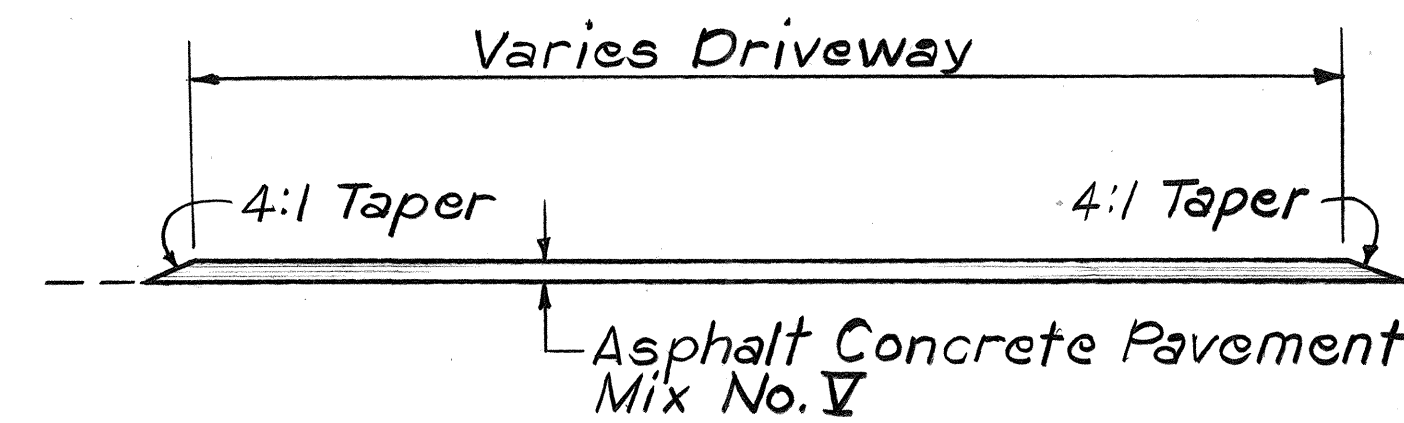


SECTION B
Scale: 1/2" = 1'-0"

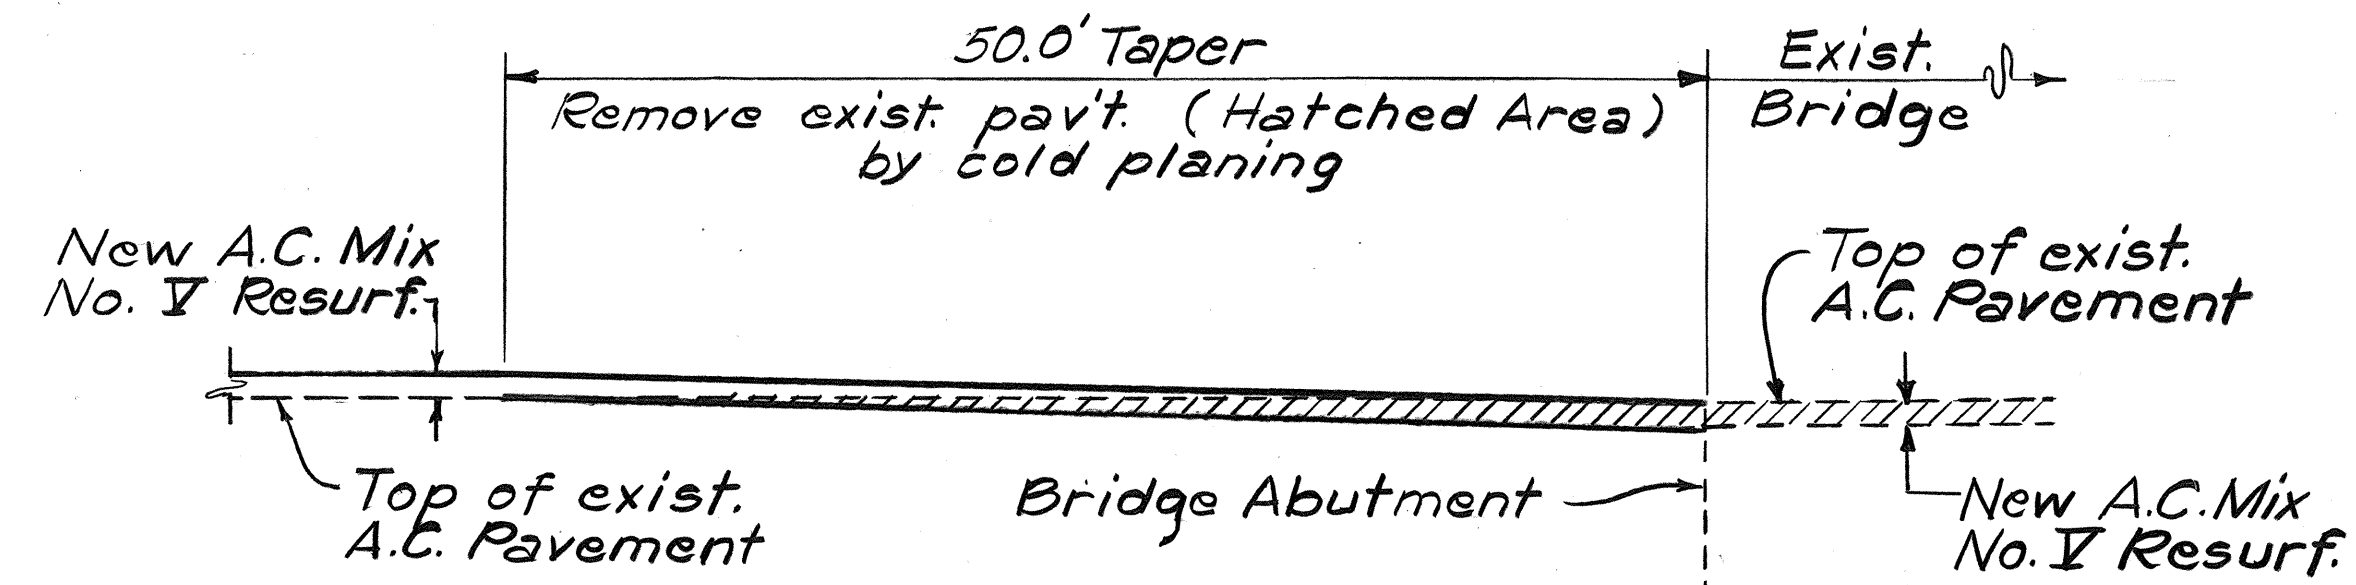

RESURFACING AT MAIPALAOA BRIDGE DETAIL
Not to Scale

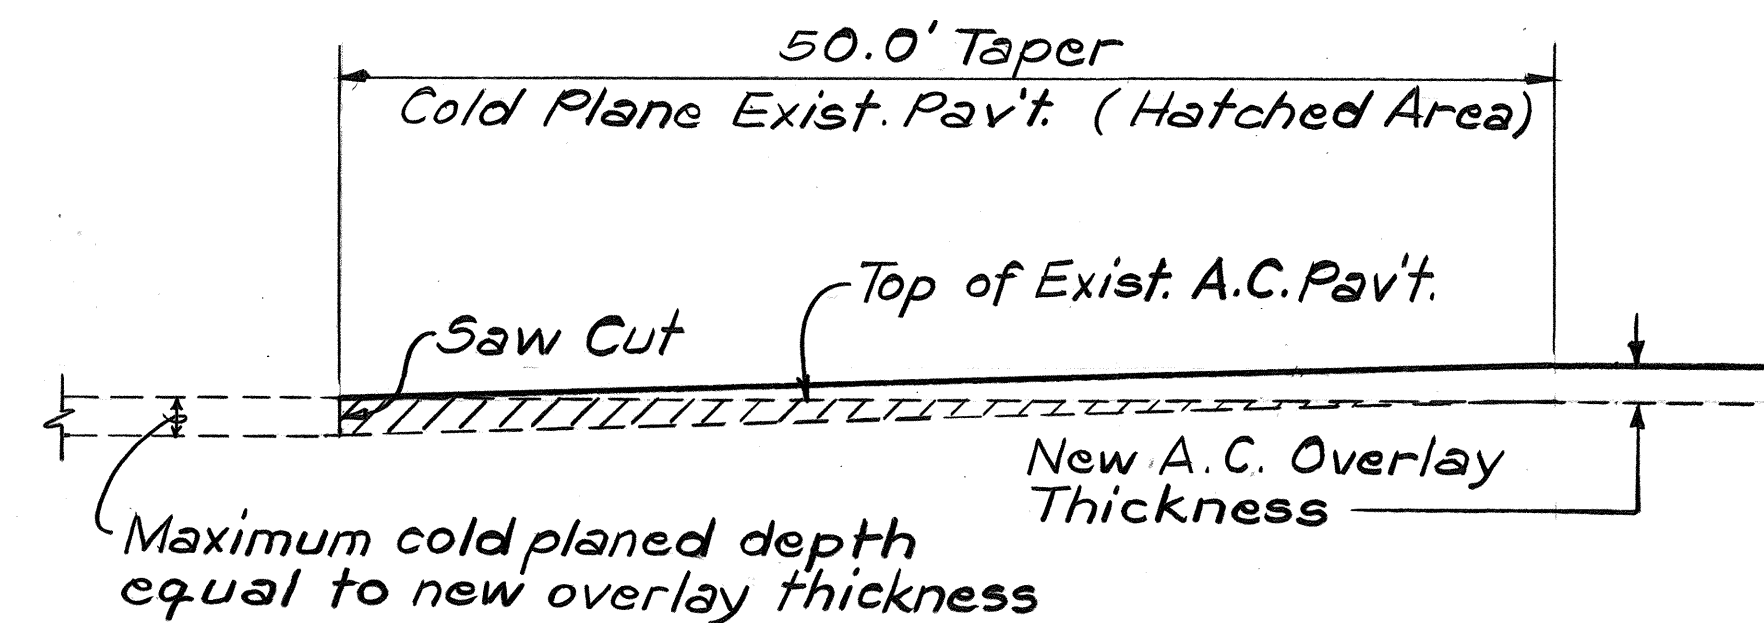

COLD PLANE TRANSITION TO EXISTING PAVEMENT DETAIL AT BEGINNING OF PROJECT
Not to Scale

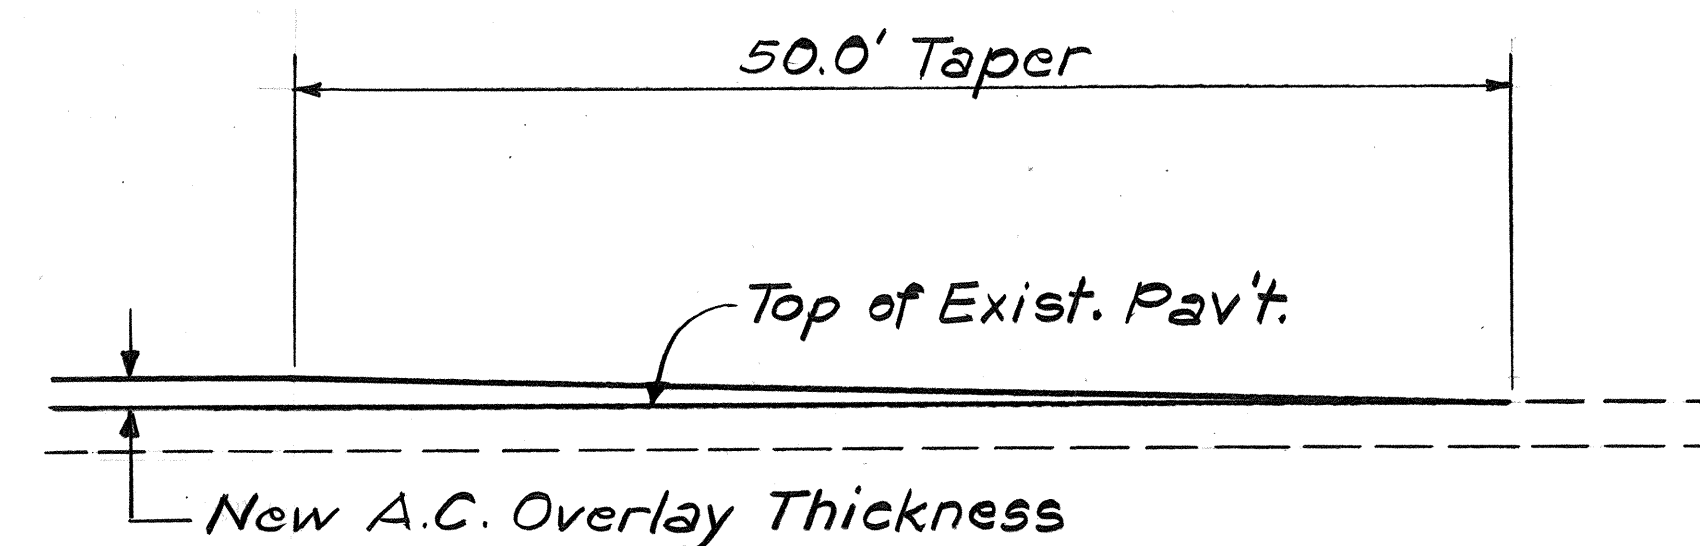


TRANSITION TO EXISTING PAVEMENT DETAIL AT END OF PROJECT
Not to Scale

STATE OF HAWAII
DEPARTMENT OF TRANSPORTATION
HIGHWAYS DIVISION


MISCELLANEOUS RESURFACING DETAILS

FARRINGTON HIGHWAY RESURFACING
Pelapaki St. toward Ulehewa Bridge
PROJECT NO. 93A-01-85M
Scale: As Shown Date: Nov, 1984
SHEET NO. E2 OF 3 SHEETS


FED. ROAD DIST. NO.	STATE	PROJ. NO.	FISCAL YEAR	SHEET NO.	TOTAL SHEETS
HAWAII	HAW.	93A-01-B5M	1985	4	30

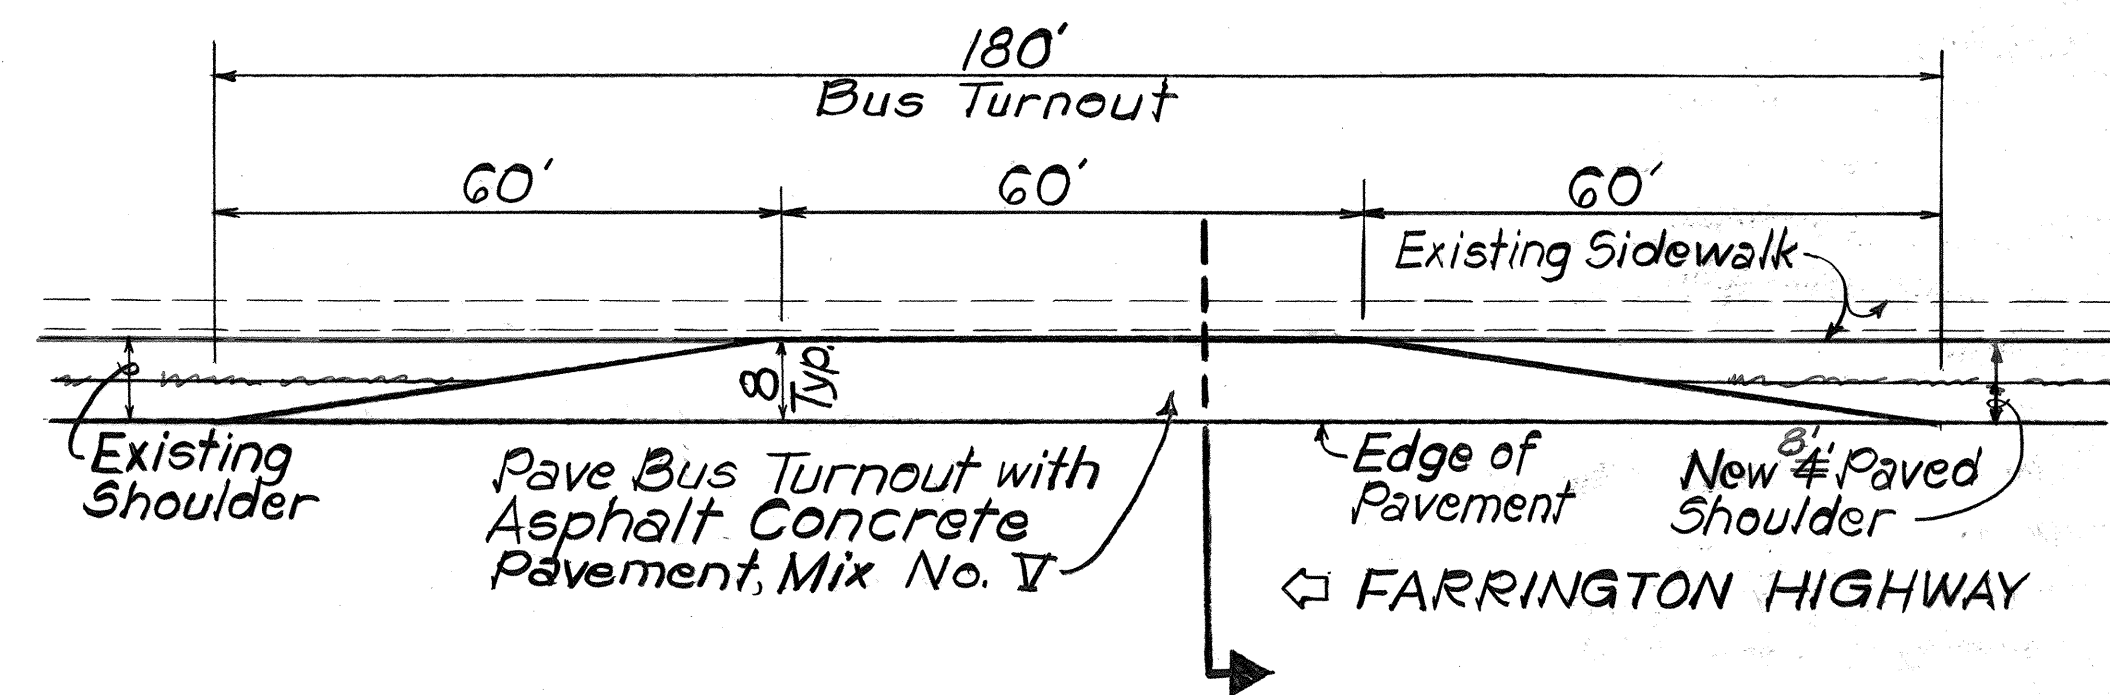

PLAN
Scale: 1" = 20'

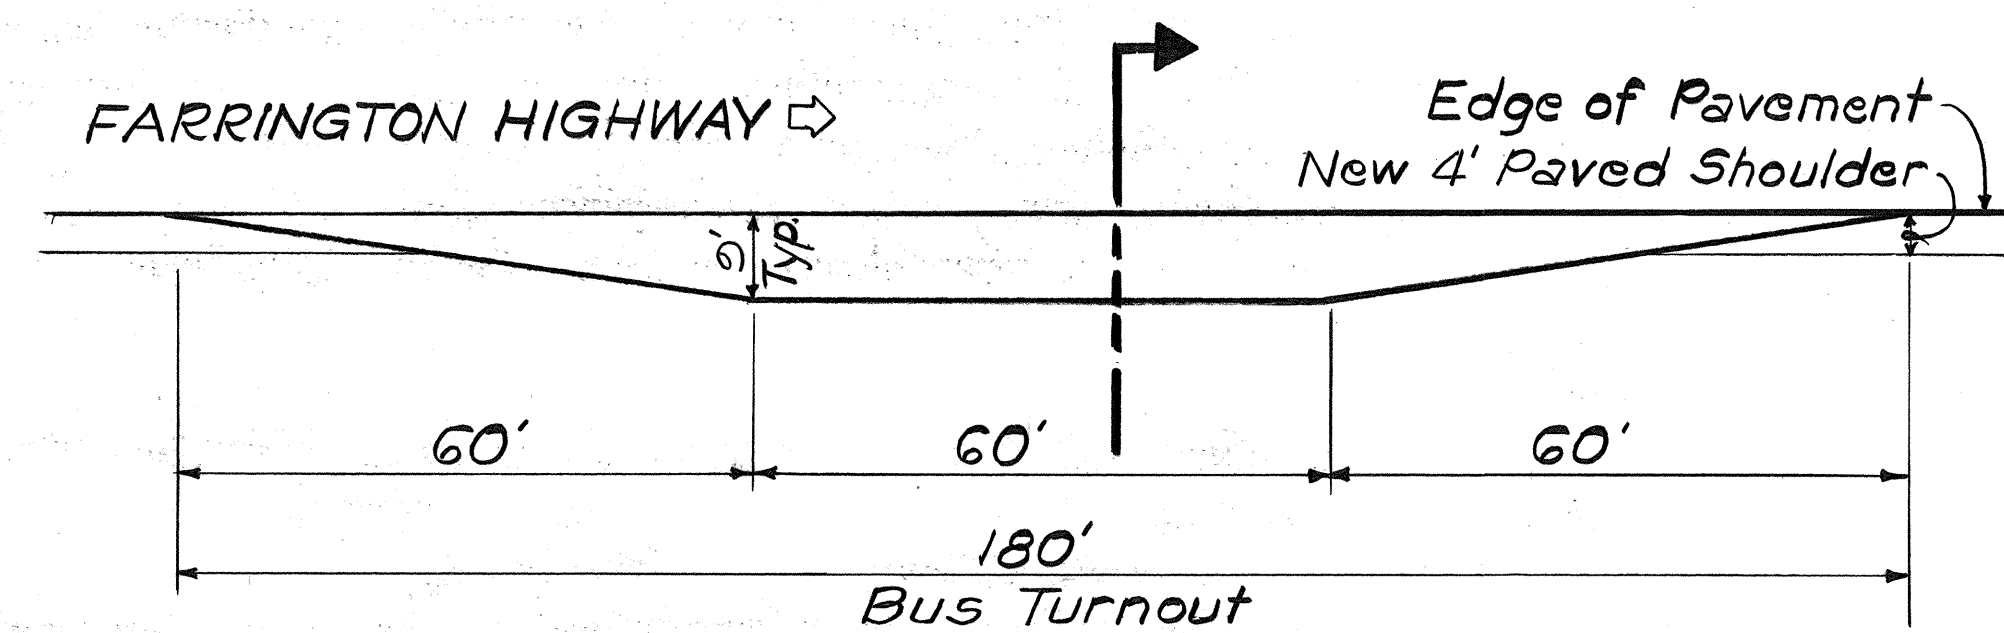


PLAN
Scale: 1" = 20'

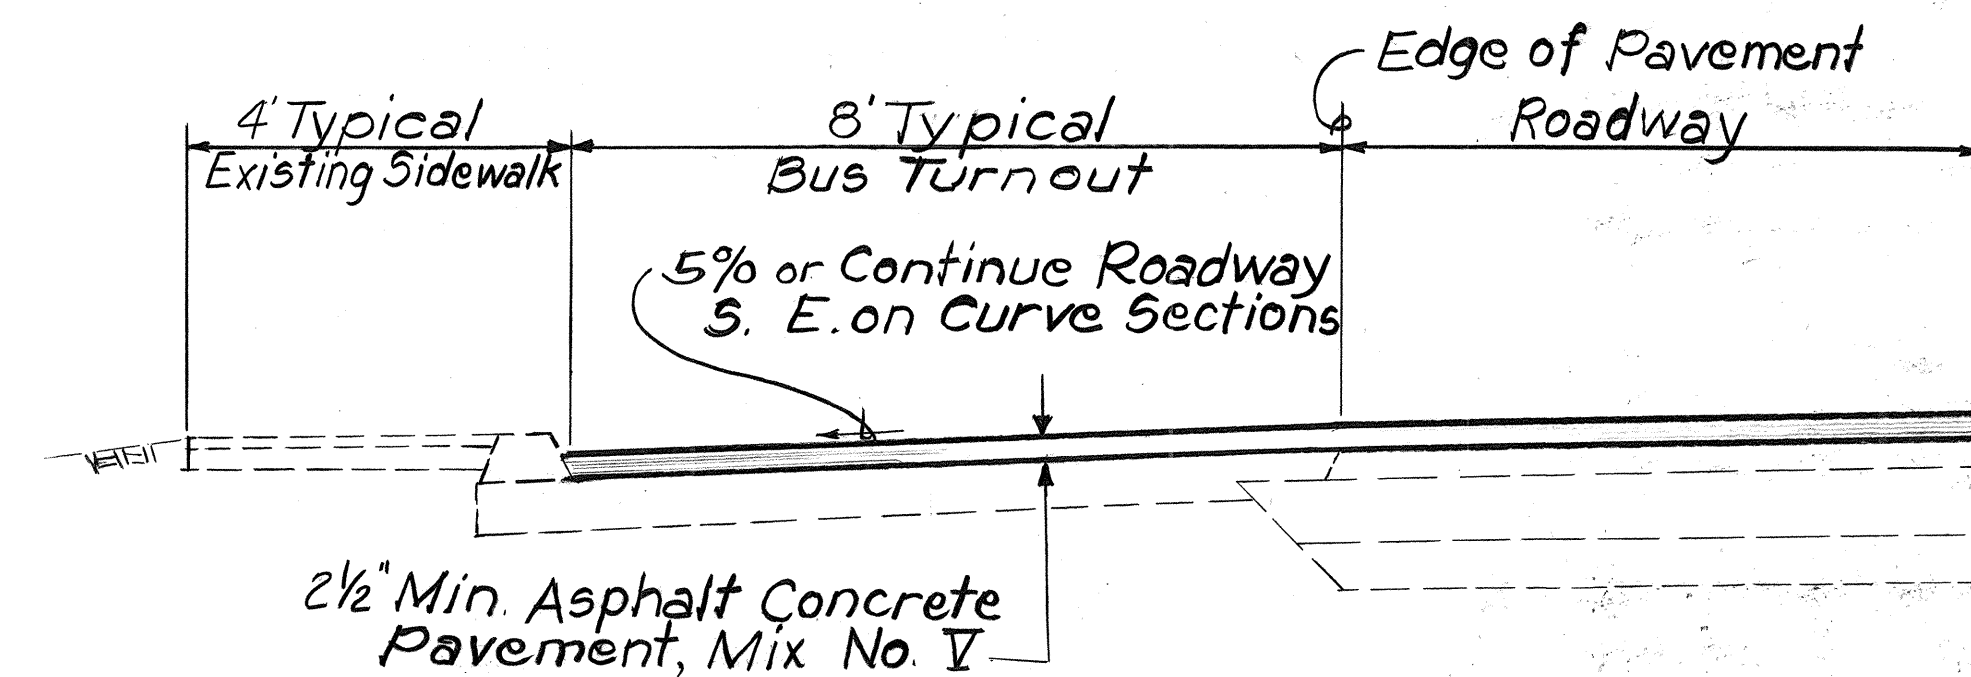


SECTION
Scale: 1/2" = 1'-0"

TYPICAL BUS TURNOUT - OUTBOUND

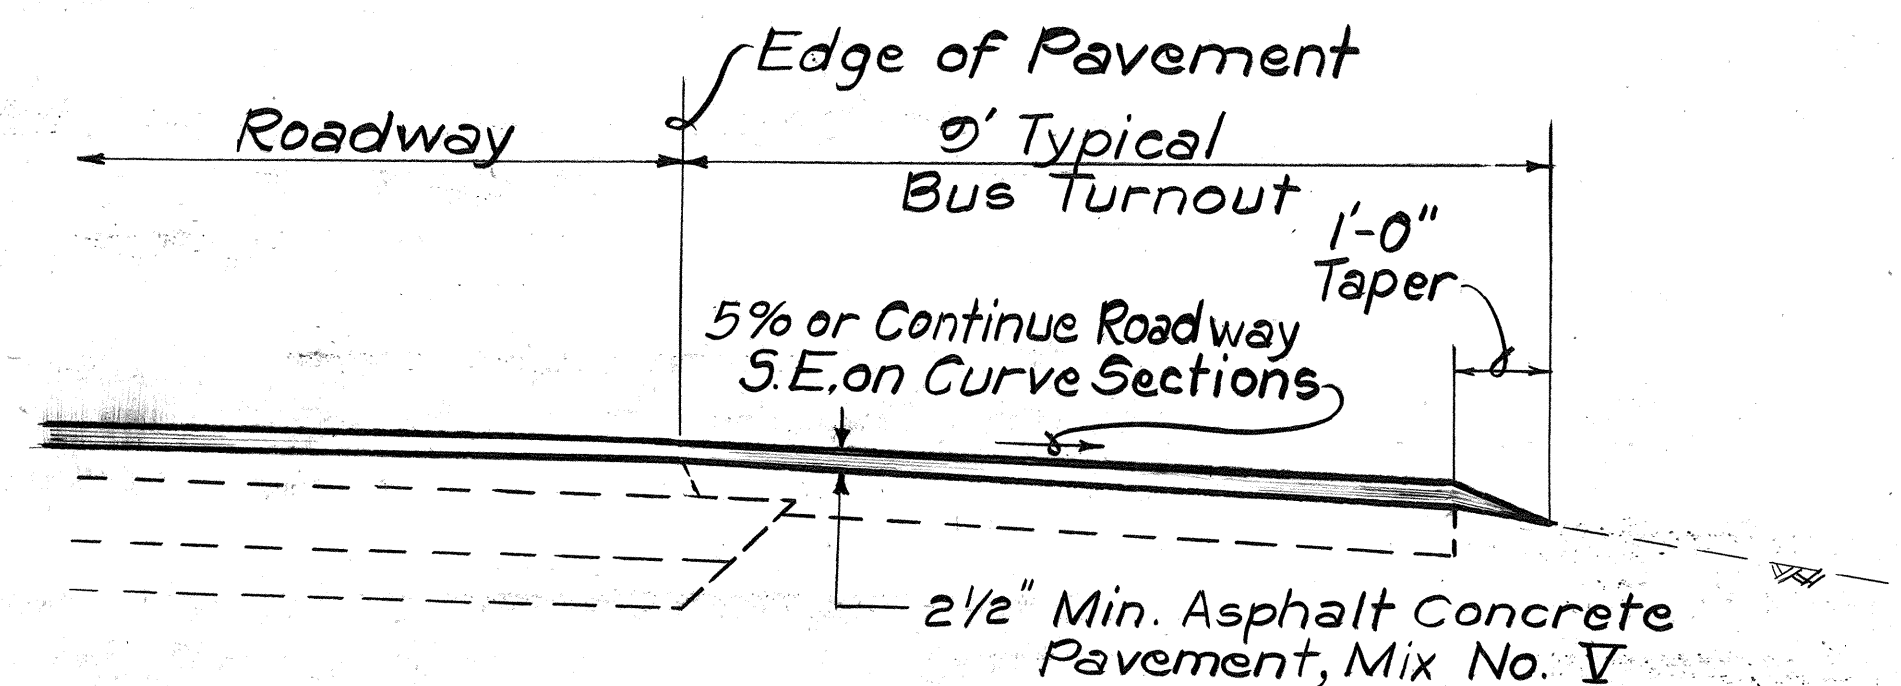


SECTION
Scale: 1/2" = 1'-0"


TYPICAL BUS TURNOUT - INBOUND

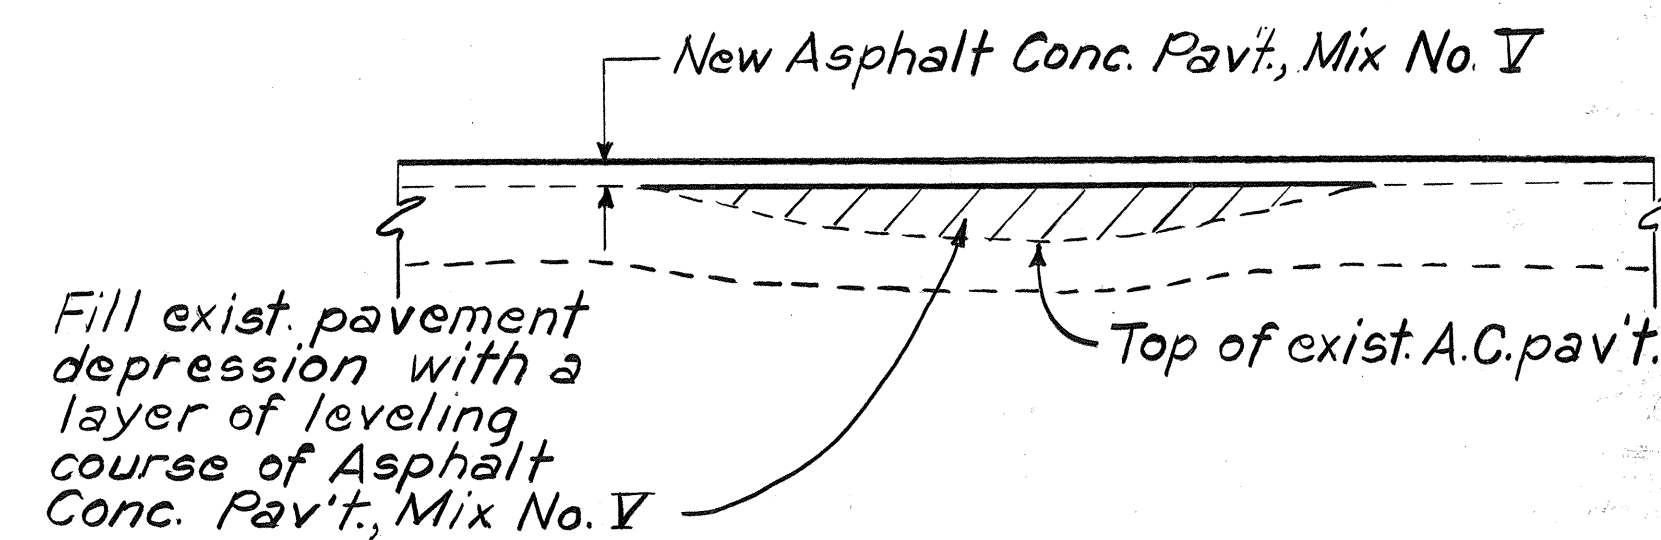

LEVELING COURSE DETAIL
Scale: 1" = 1'-0"

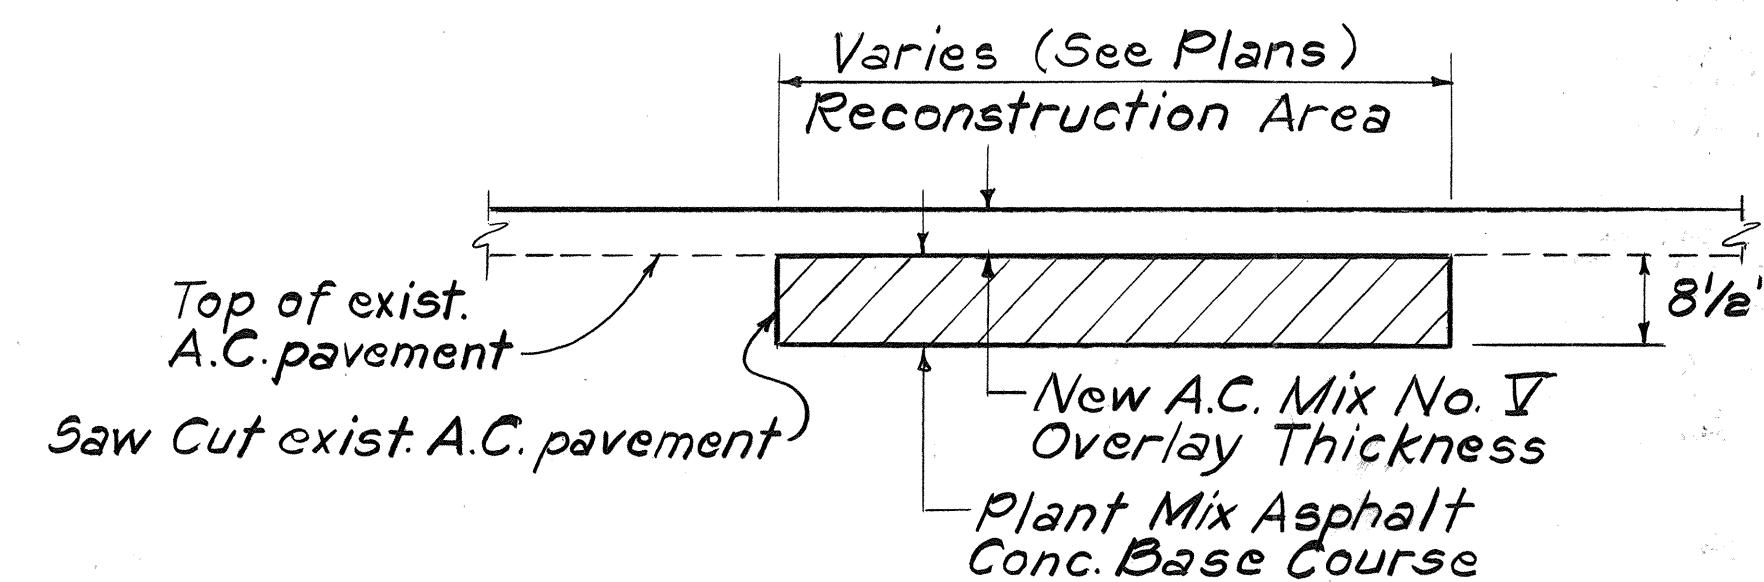

TYPICAL RECONSTRUCTION AREA
Not to Scale

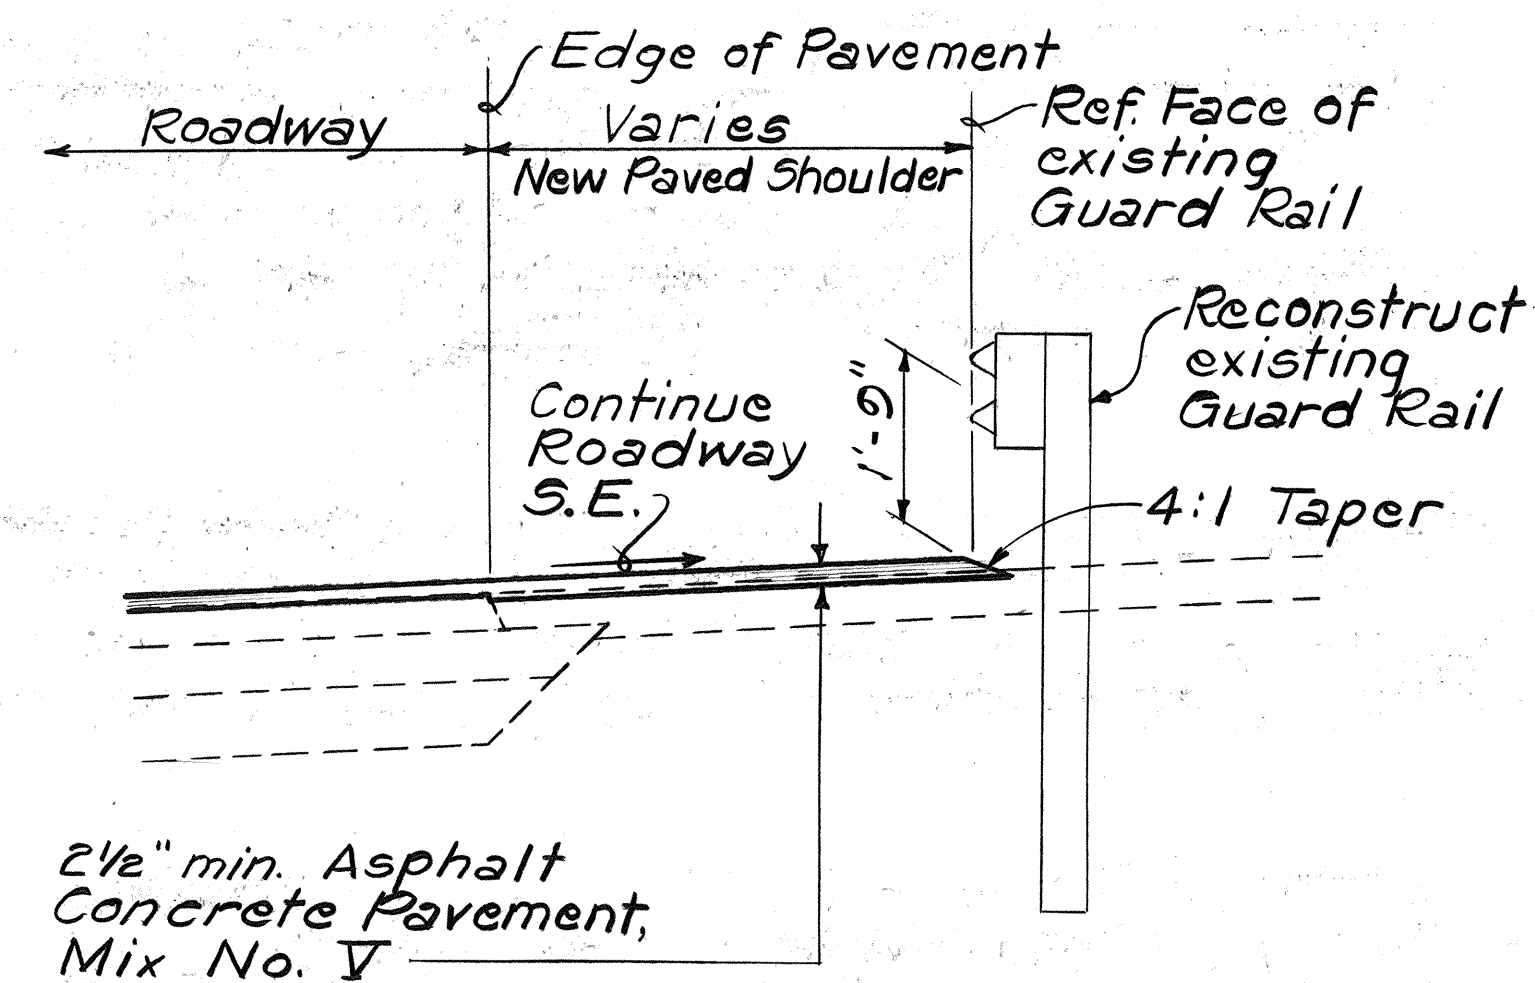

TYPICAL SECTION
@ STA. 183+20± RT. TO STA. 186+70± RT.
Scale: 1/2" = 1'-0"

STATE OF HAWAII
DEPARTMENT OF TRANSPORTATION
HIGHWAYS DIVISION

**MISCELLANEOUS RESURFACING
DETAILS**

FARRINGTON HIGHWAY RESURFACING
Pelanaki St. toward Ulehewa Bridge
PROJECT NO. 93A-01-B5M
Scale: As Shown Date: Nov., 1984
SHEET No. E3 OF 3 SHEETS