
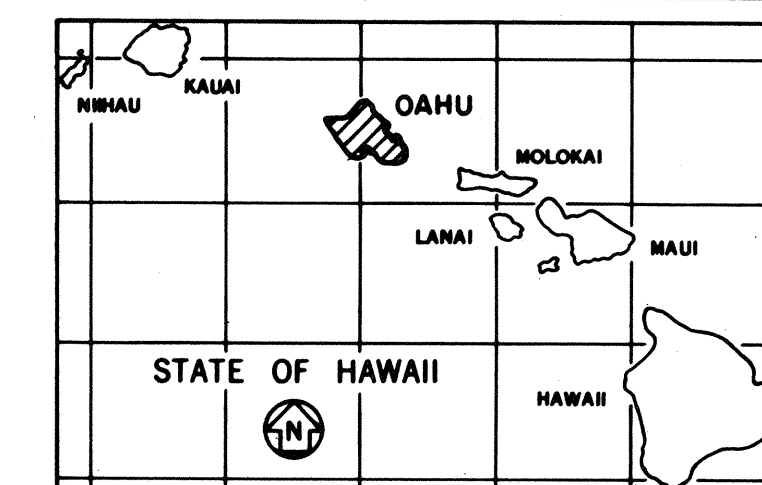
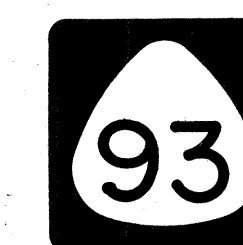


[illegible]


FED. ROAD DIST. NO.	STATE	PROJ. NO.	FISCAL YEAR	SHEET NO.	TOTAL SHEETS
HAWAII	HAW.	93A-01-86M 93B-01-86M	1986	1	52

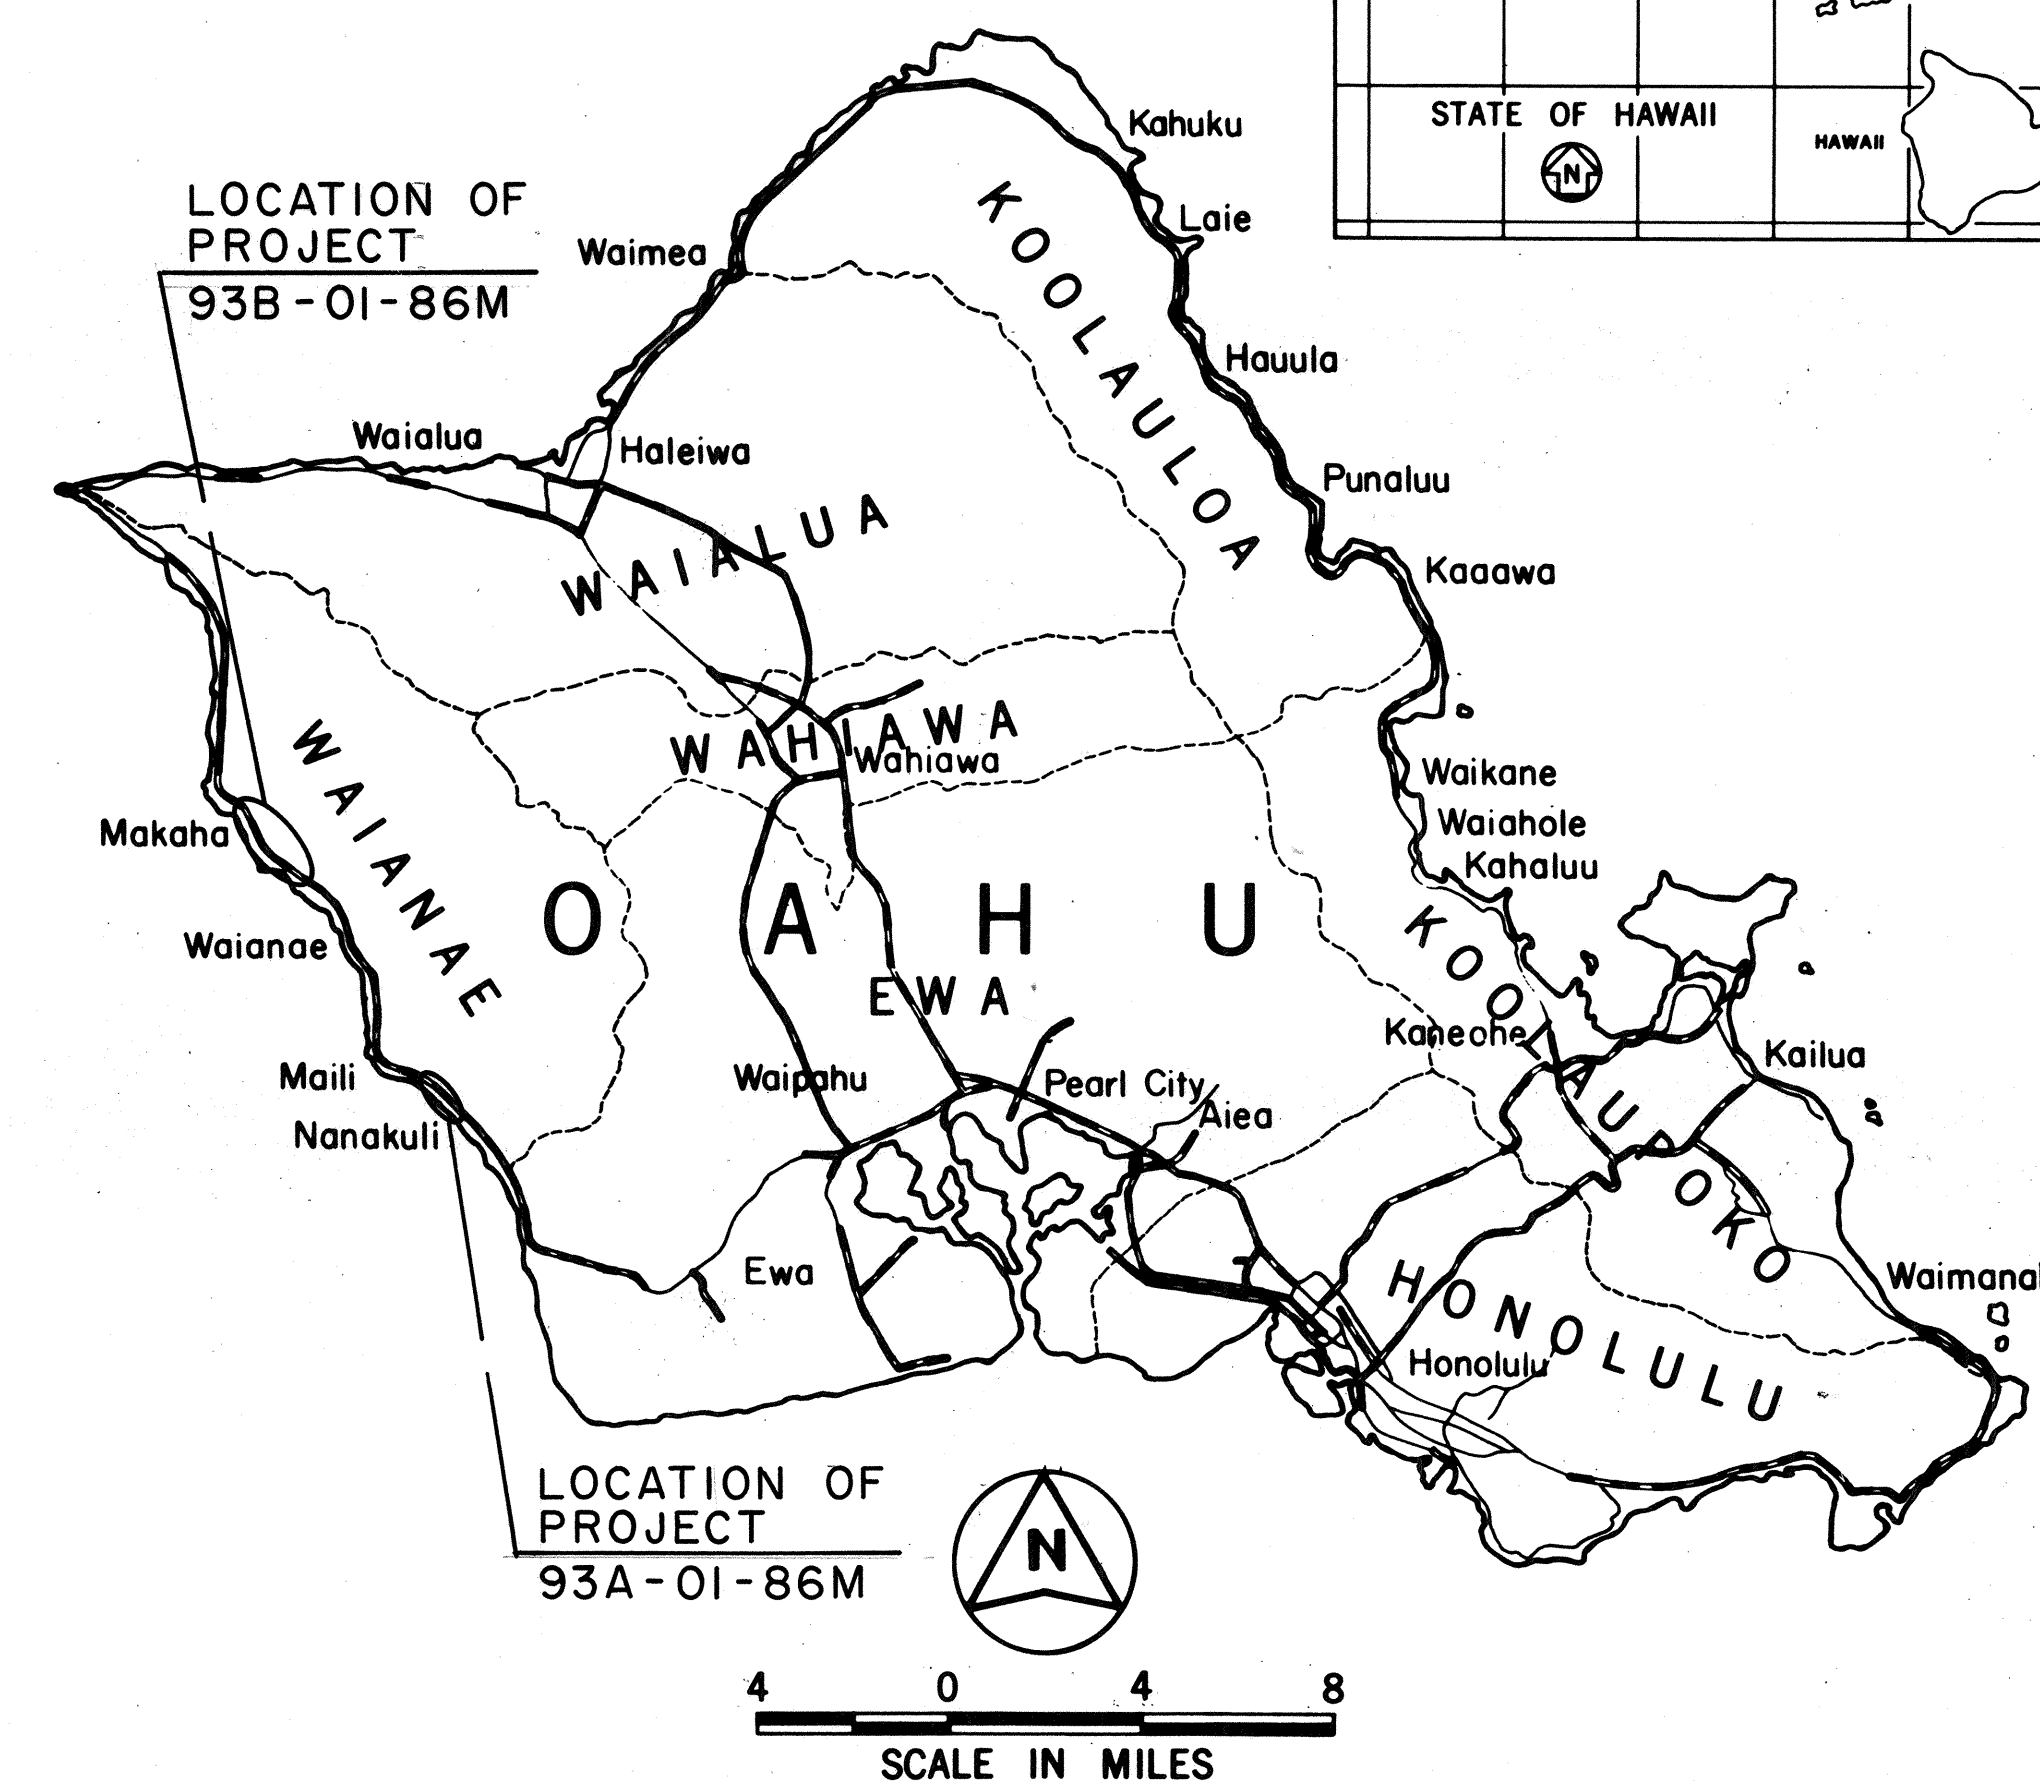

STATE OF HAWAII
DEPARTMENT OF TRANSPORTATION
HIGHWAYS DIVISION
HONOLULU, HAWAII
"AS-BUILT"
PLANS FOR
FARRINGTON HIGHWAY RESURFACING
PUUOHULU BEACH TO ULEHAWA BRIDGE
PROJECT NO. 93A-01-86M
AND
KAUPUNI STREAM TO MAKAHA
PROJECT NO. 93B-01-86M


DISTRICT OF WAIANAE
ISLAND OF OAHU

**FEDERAL AID PROJECTS PREVIOUSLY CONSTRUCTED
OR UNDER CONSTRUCTION**

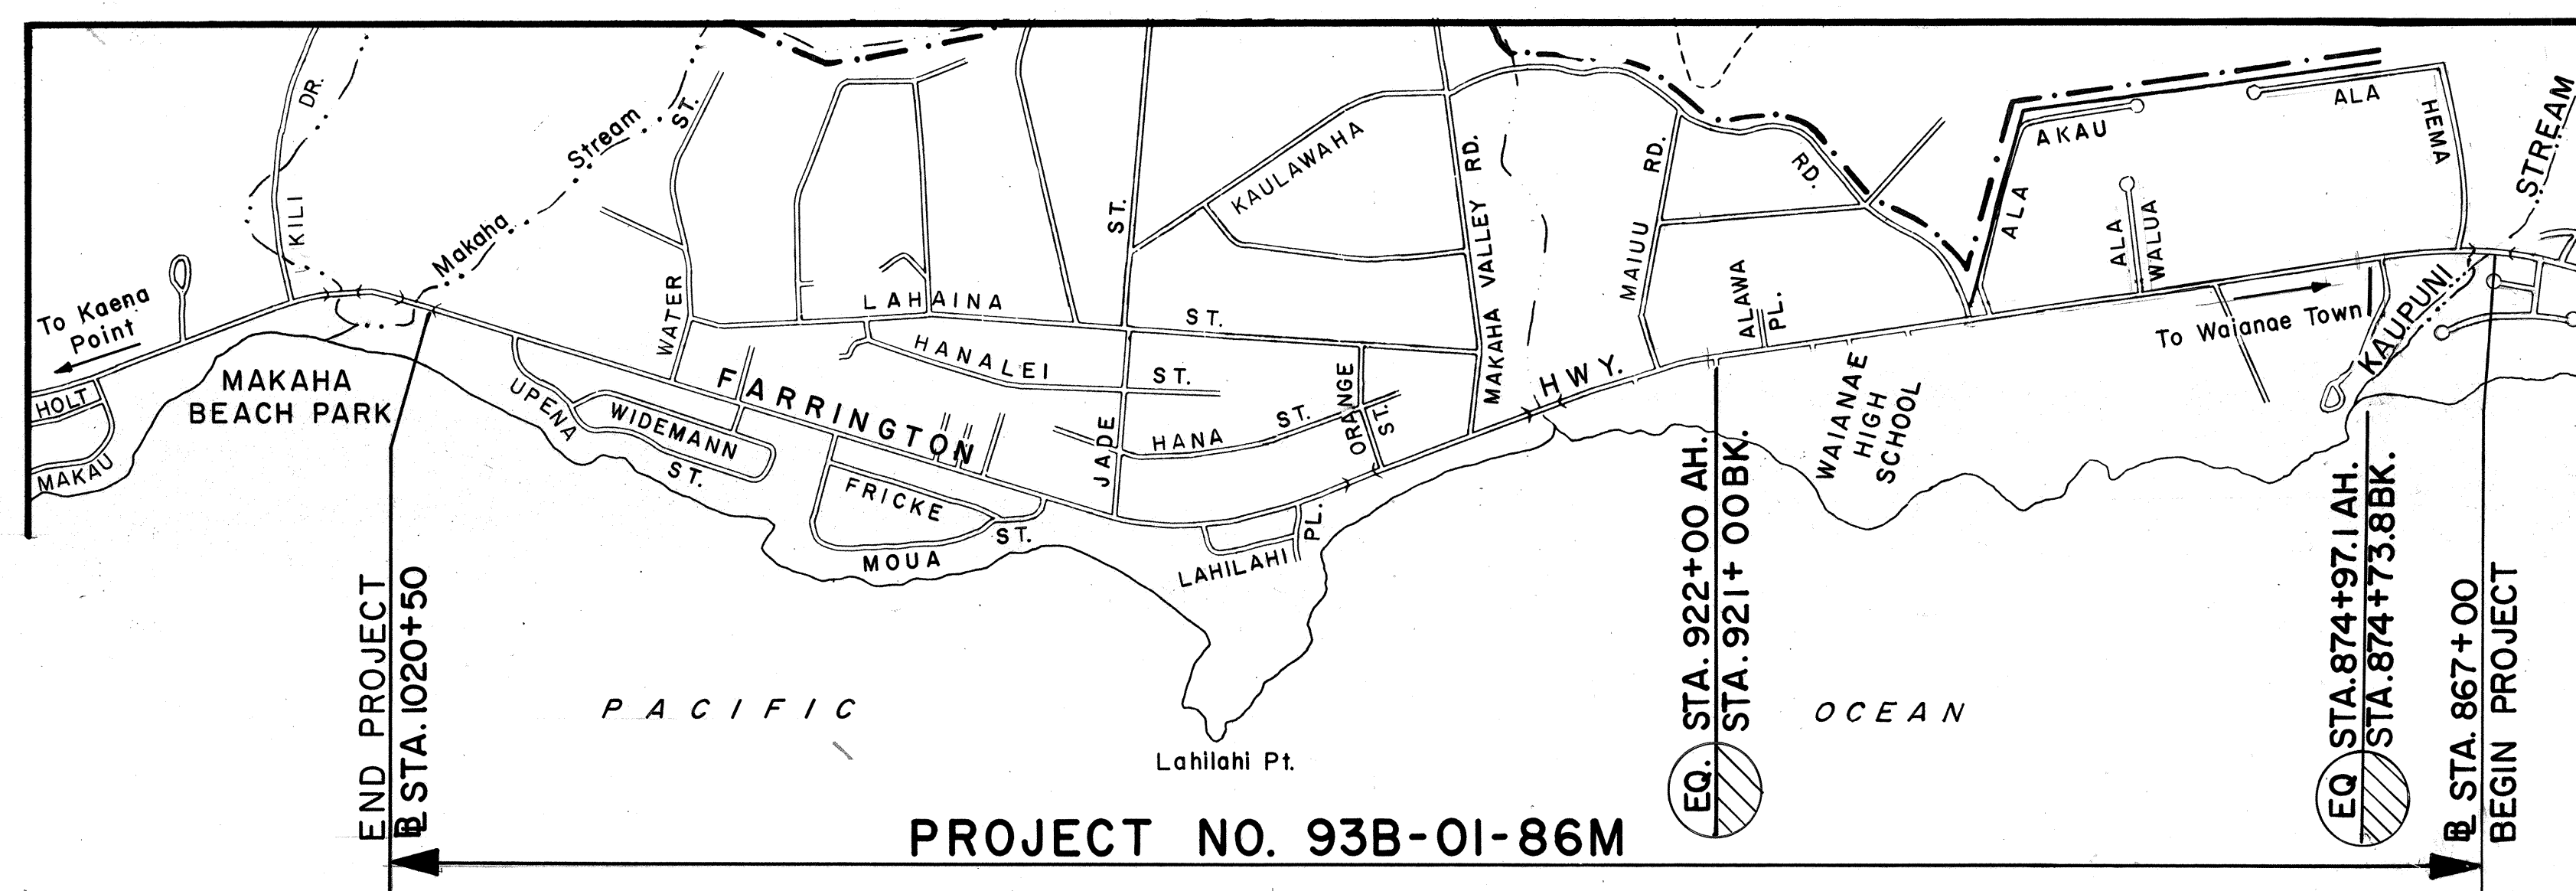

LAYOUT PLAN

GROSS LENGTH OF PROJECT...2.884 MI.
NET LENGTH OF PROJECT....2.884 MI.

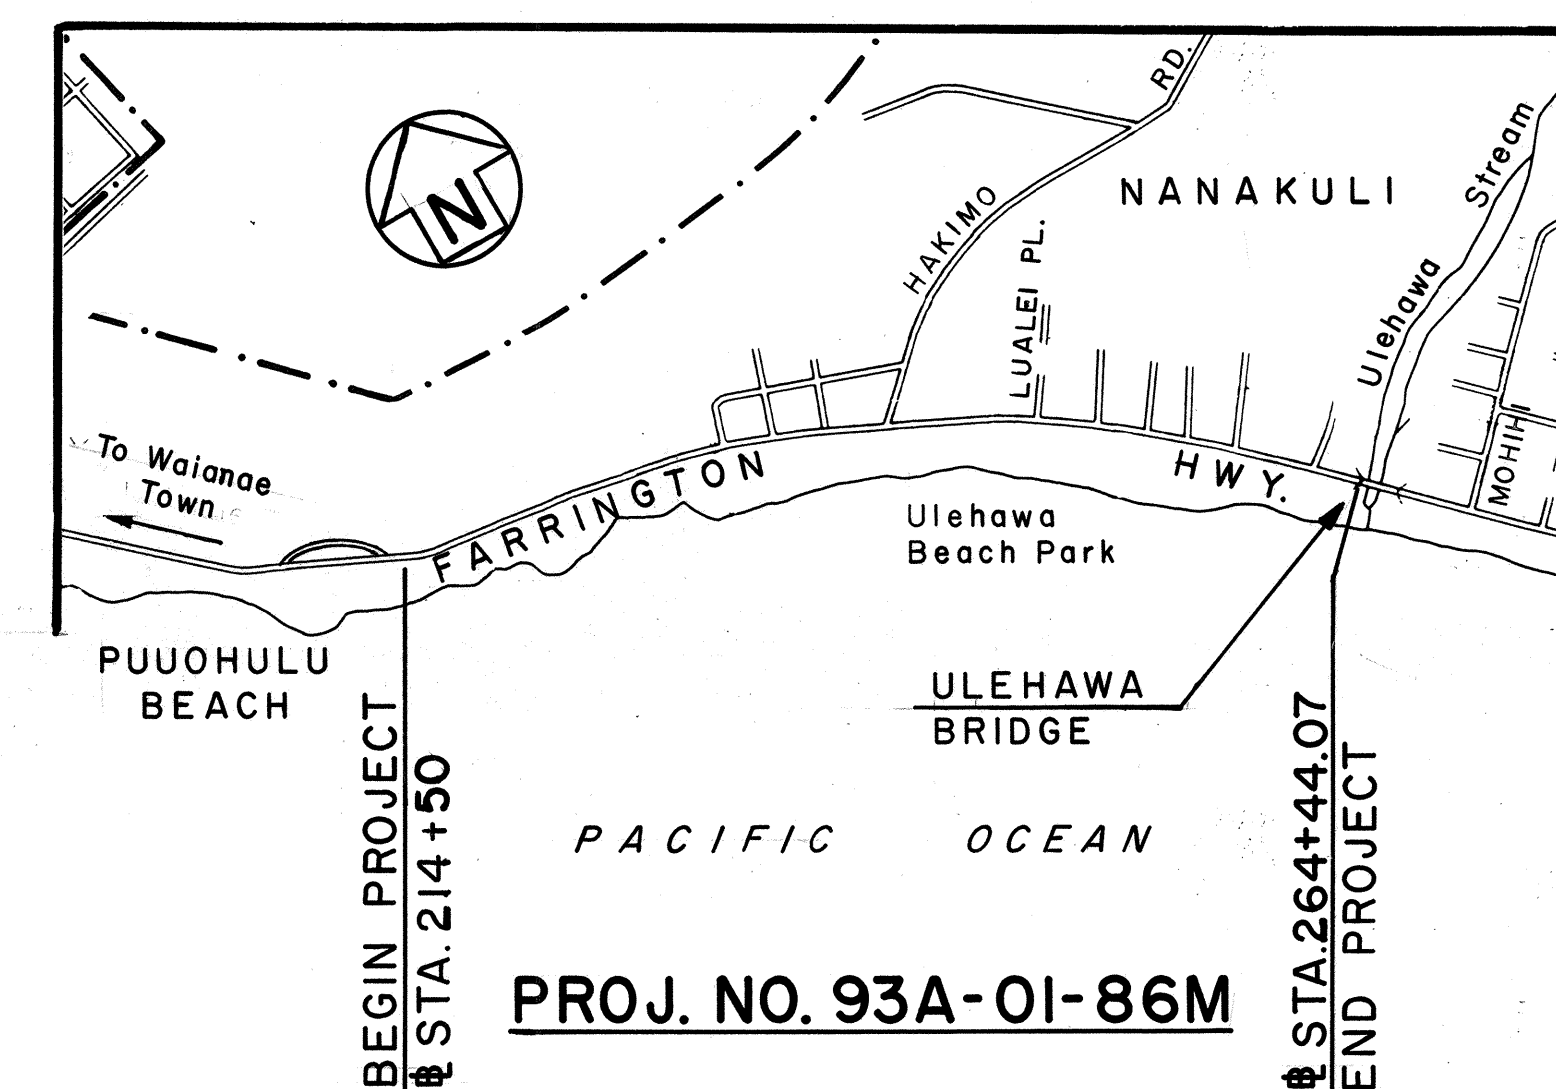

LAYOUT PLAN

GROSS LENGTH OF PROJECT...0.946 MI.
NET LENGTH OF PROJECT....0.946 MI.



CHANGES MADE DURING CONSTRUCTION
HAVE BEEN INCORPORATED ON THESE
PLANS EXCEPT CHANGES IN THE
ORIGINAL THEORETICAL QUANTITIES.
FOR ACTUAL QUANTITIES, REFER TO
PROJECT LEDGER AND/OR COMPUTATION
BOOK.

Michael Dmiga 1/31/89
RESIDENT ENGINEER DATE

DEPARTMENT OF TRANSPORTATION
STATE OF HAWAII

APPROVED: for Cheryl D. Boon 3/20/85
DIR. OF TRANSPORTATION DATE

A. NISHIMURA
DESIGNED BY

A. NISHIMURA
P. S. & E. BY

548-7490
PHONE

MARCH 19, 1986
DATE