
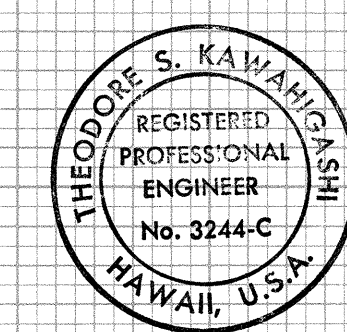
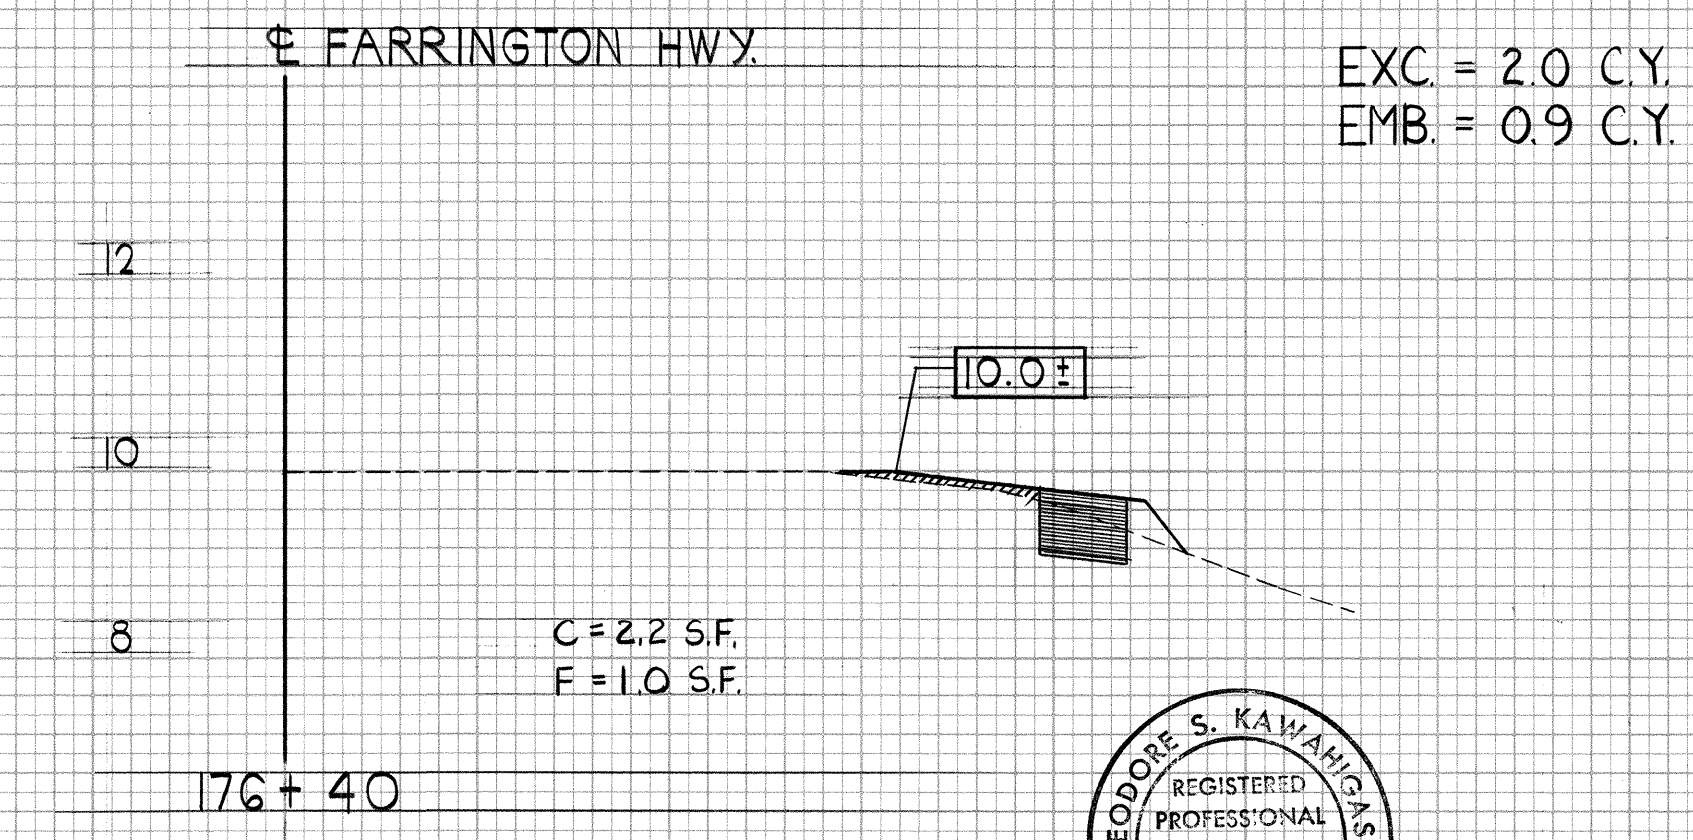
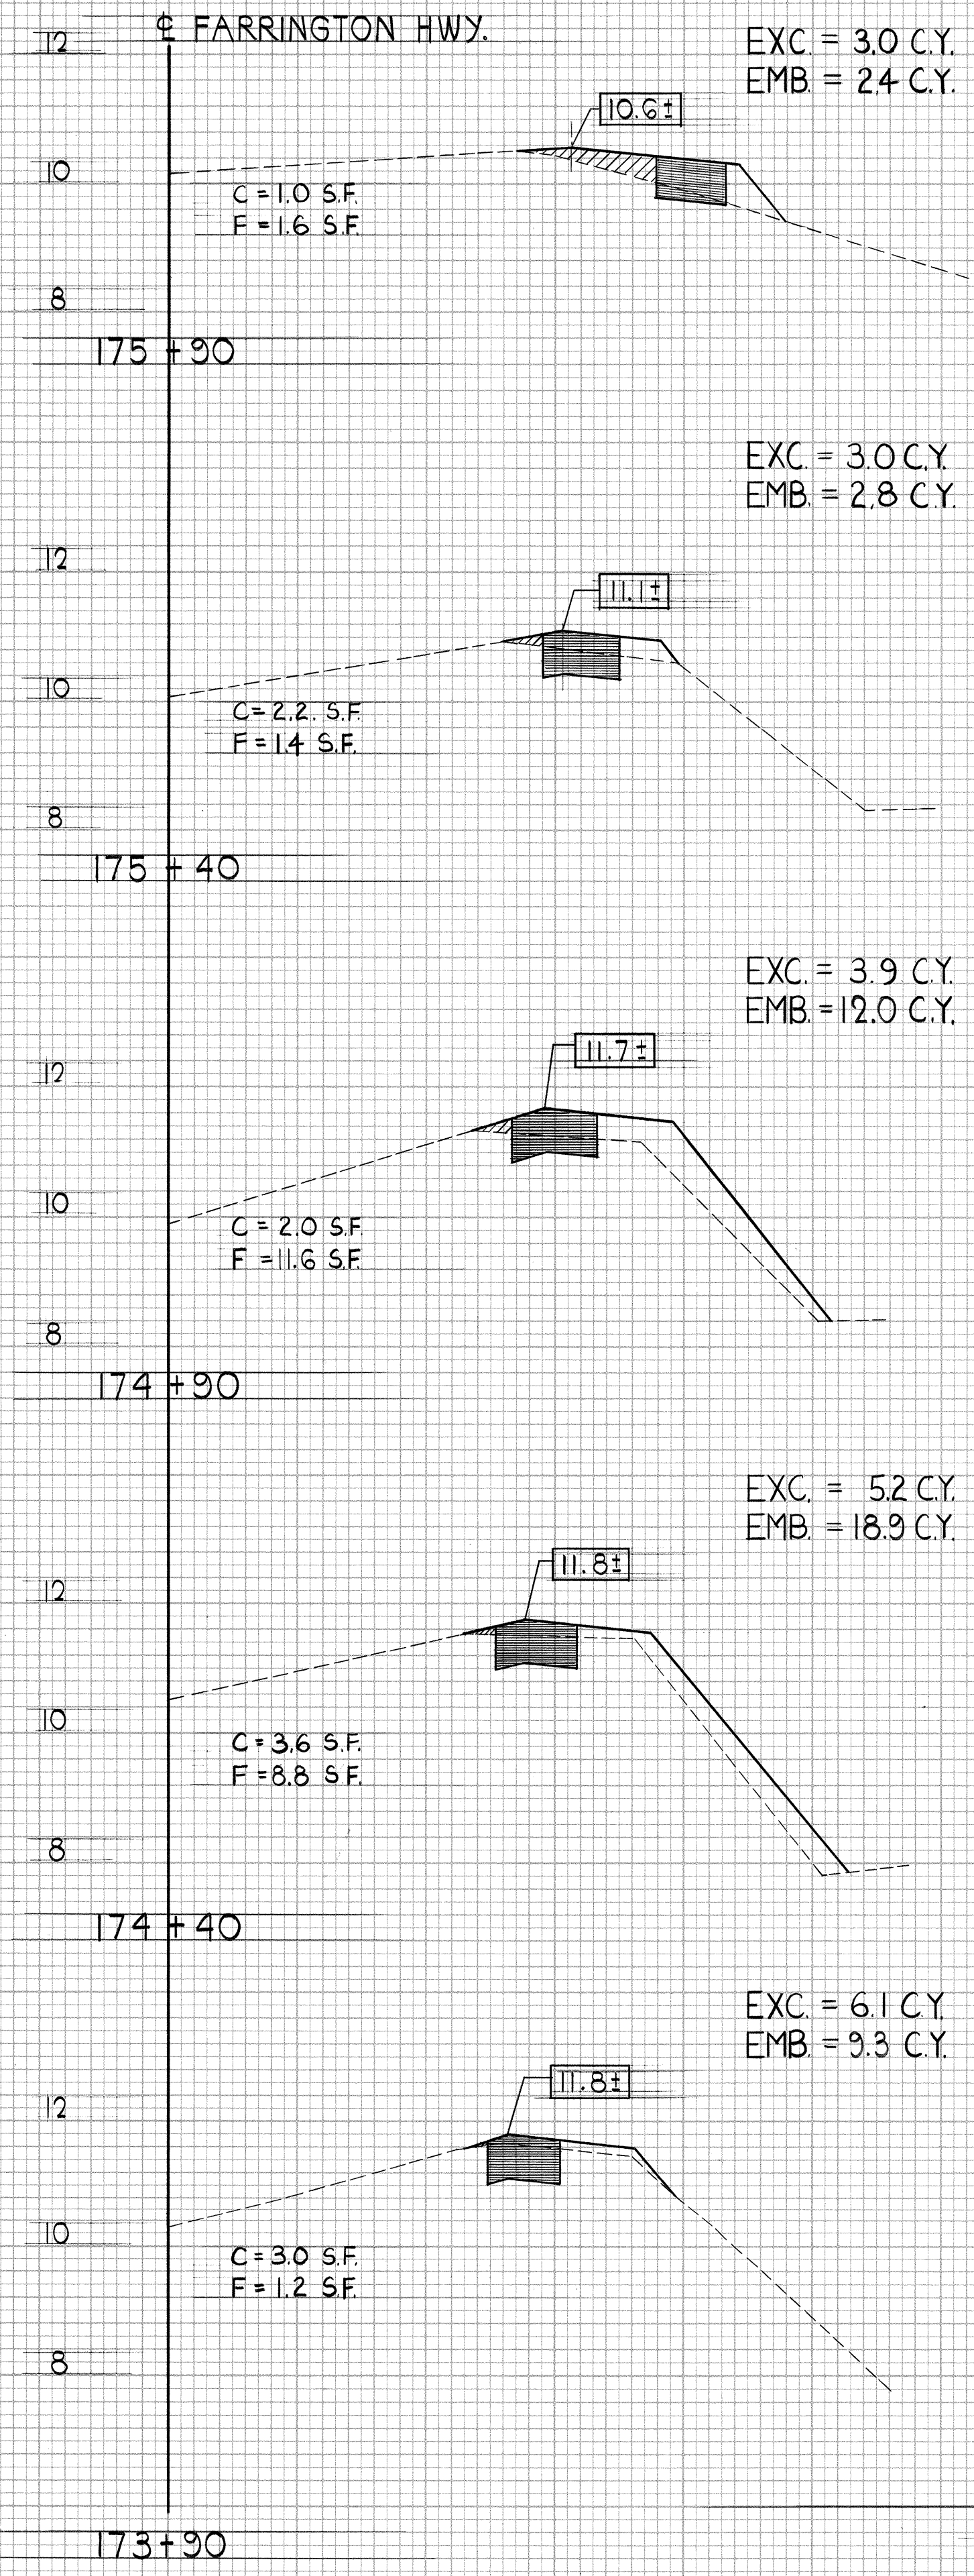


FED. ROAD DIST. NO.	STATE	PROJ. NO.	FISCAL YEAR	SHEET NO.	TOTAL SHEETS
HAWAII	HAW.	93A-03-86	1986	5	20

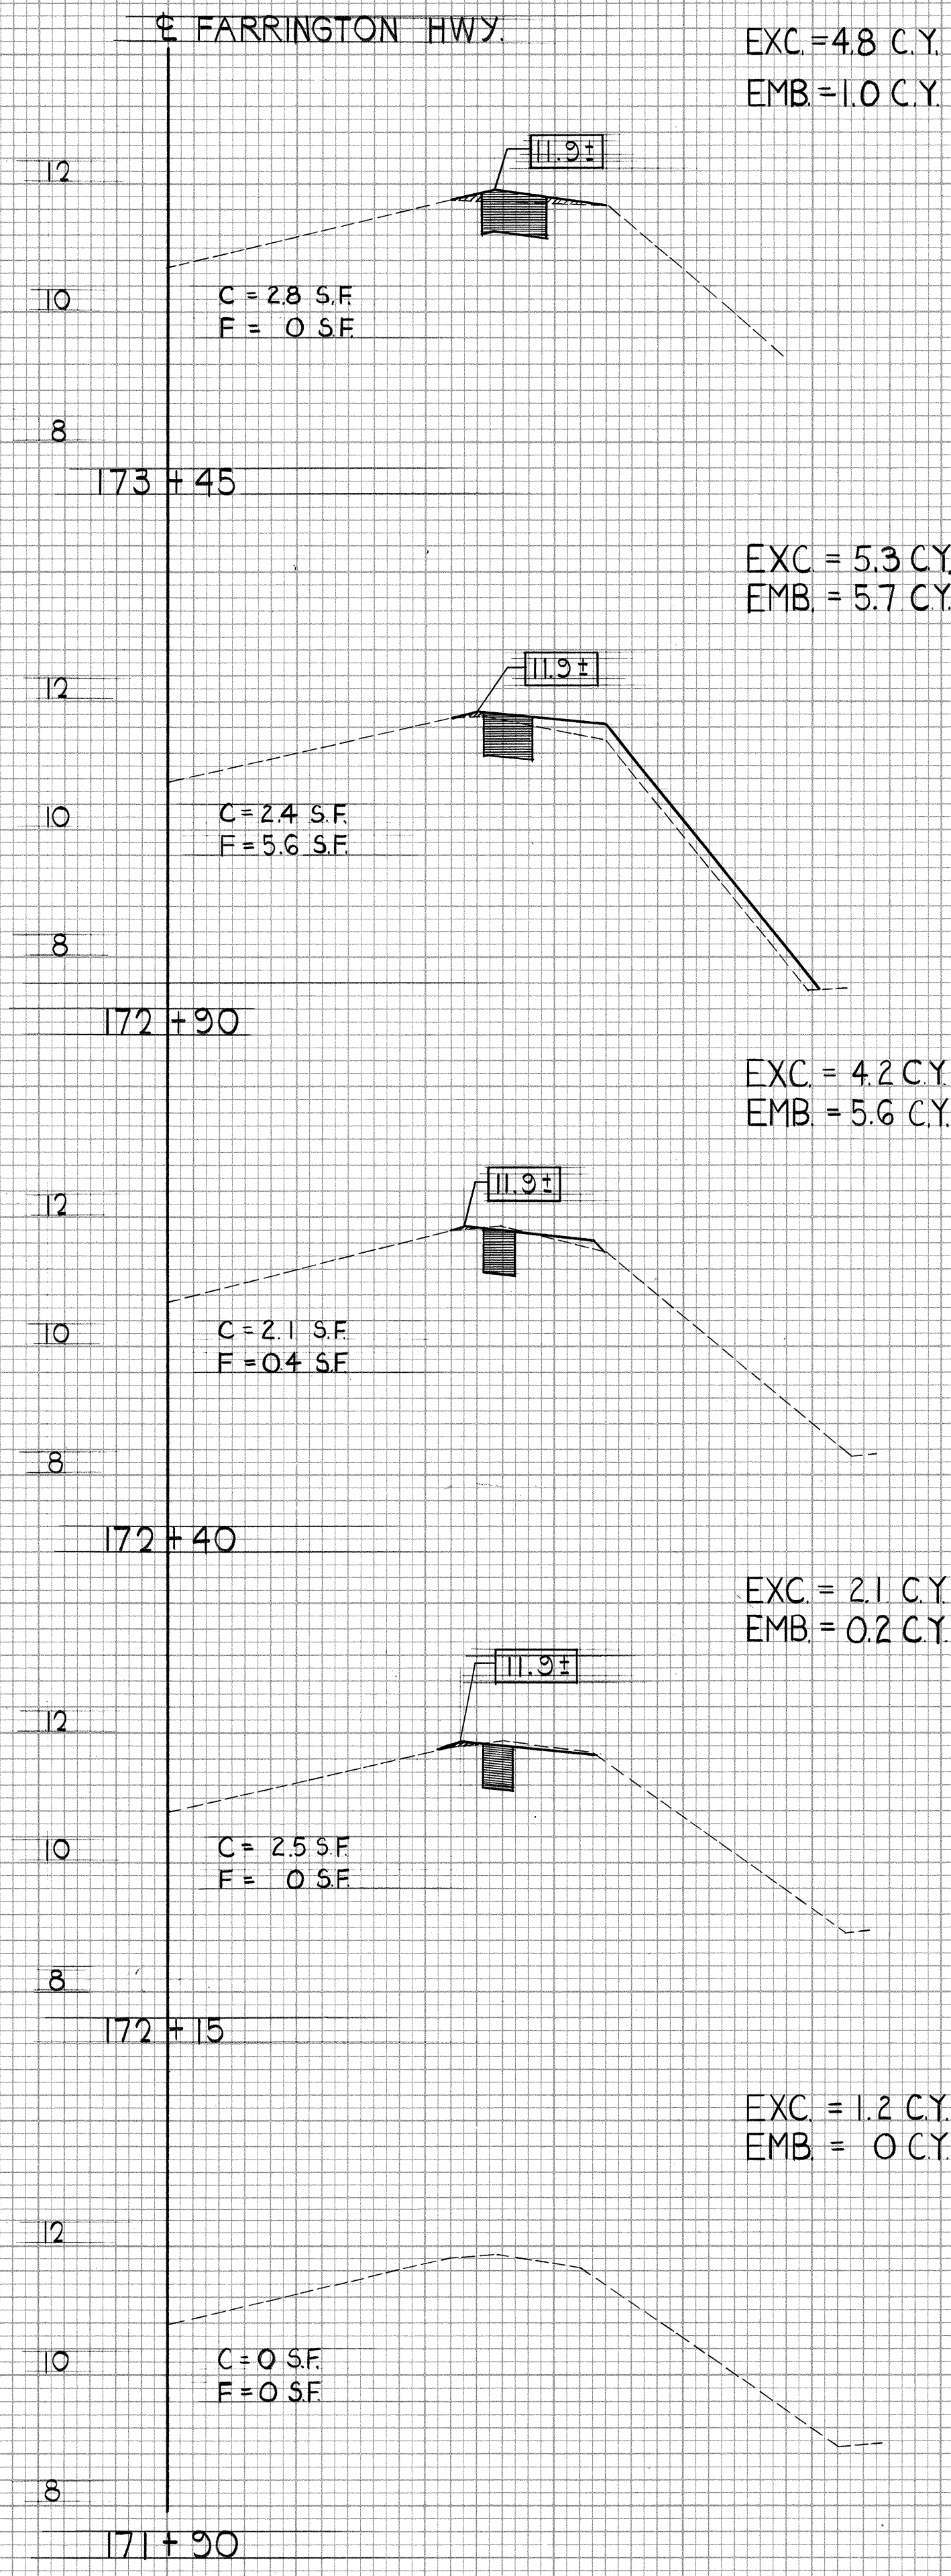

THIS WORK WAS PREPARED BY ME
 OR UNDER MY SUPERVISION
 Theodore S. Kawahigashi
 Signature

CROSS SECTIONS
 SCALE: HORIZ. 1"=10'
 VERT. 1"=2'

SCALE: AS NOTED
 SHEET No. 1 OF 1 SHEETS
 DATE: MAY 16, 1986