
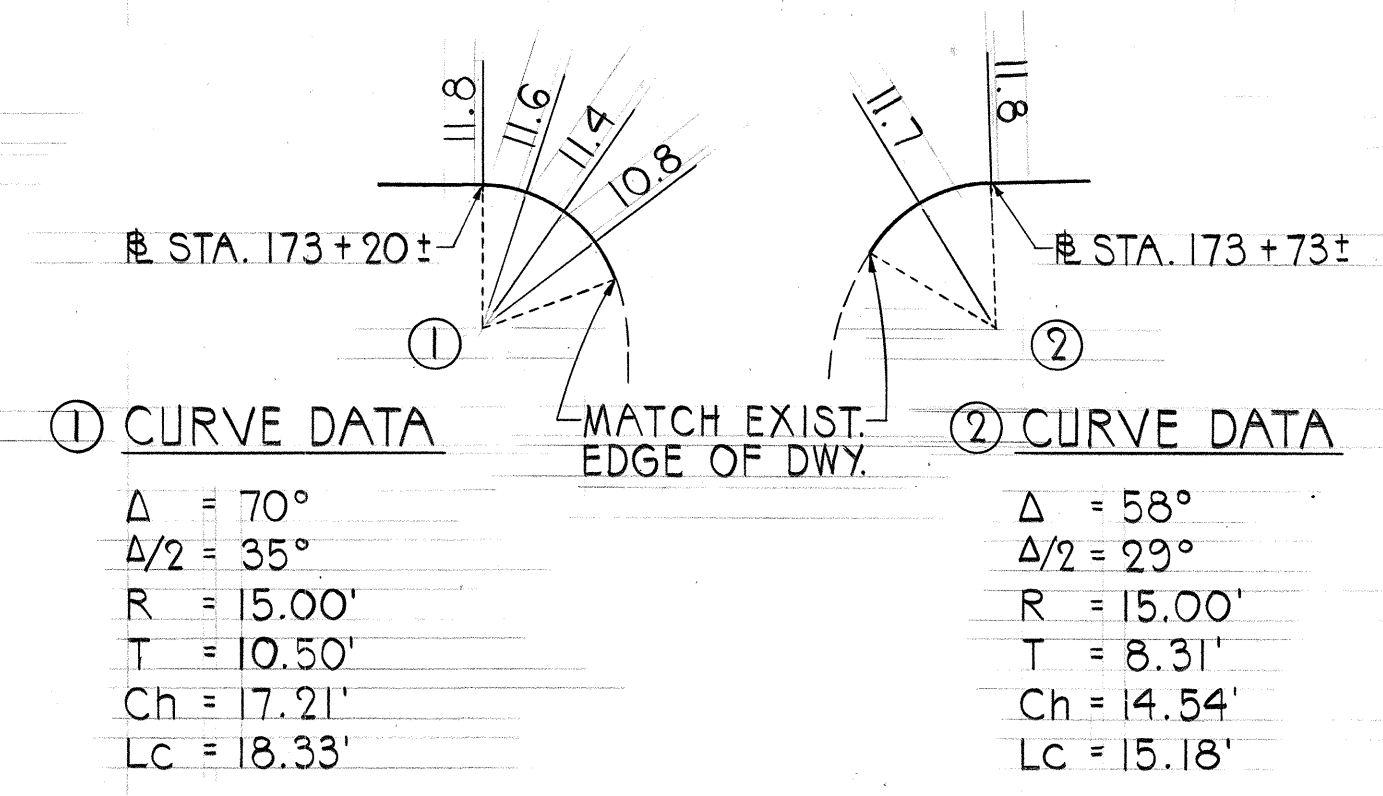
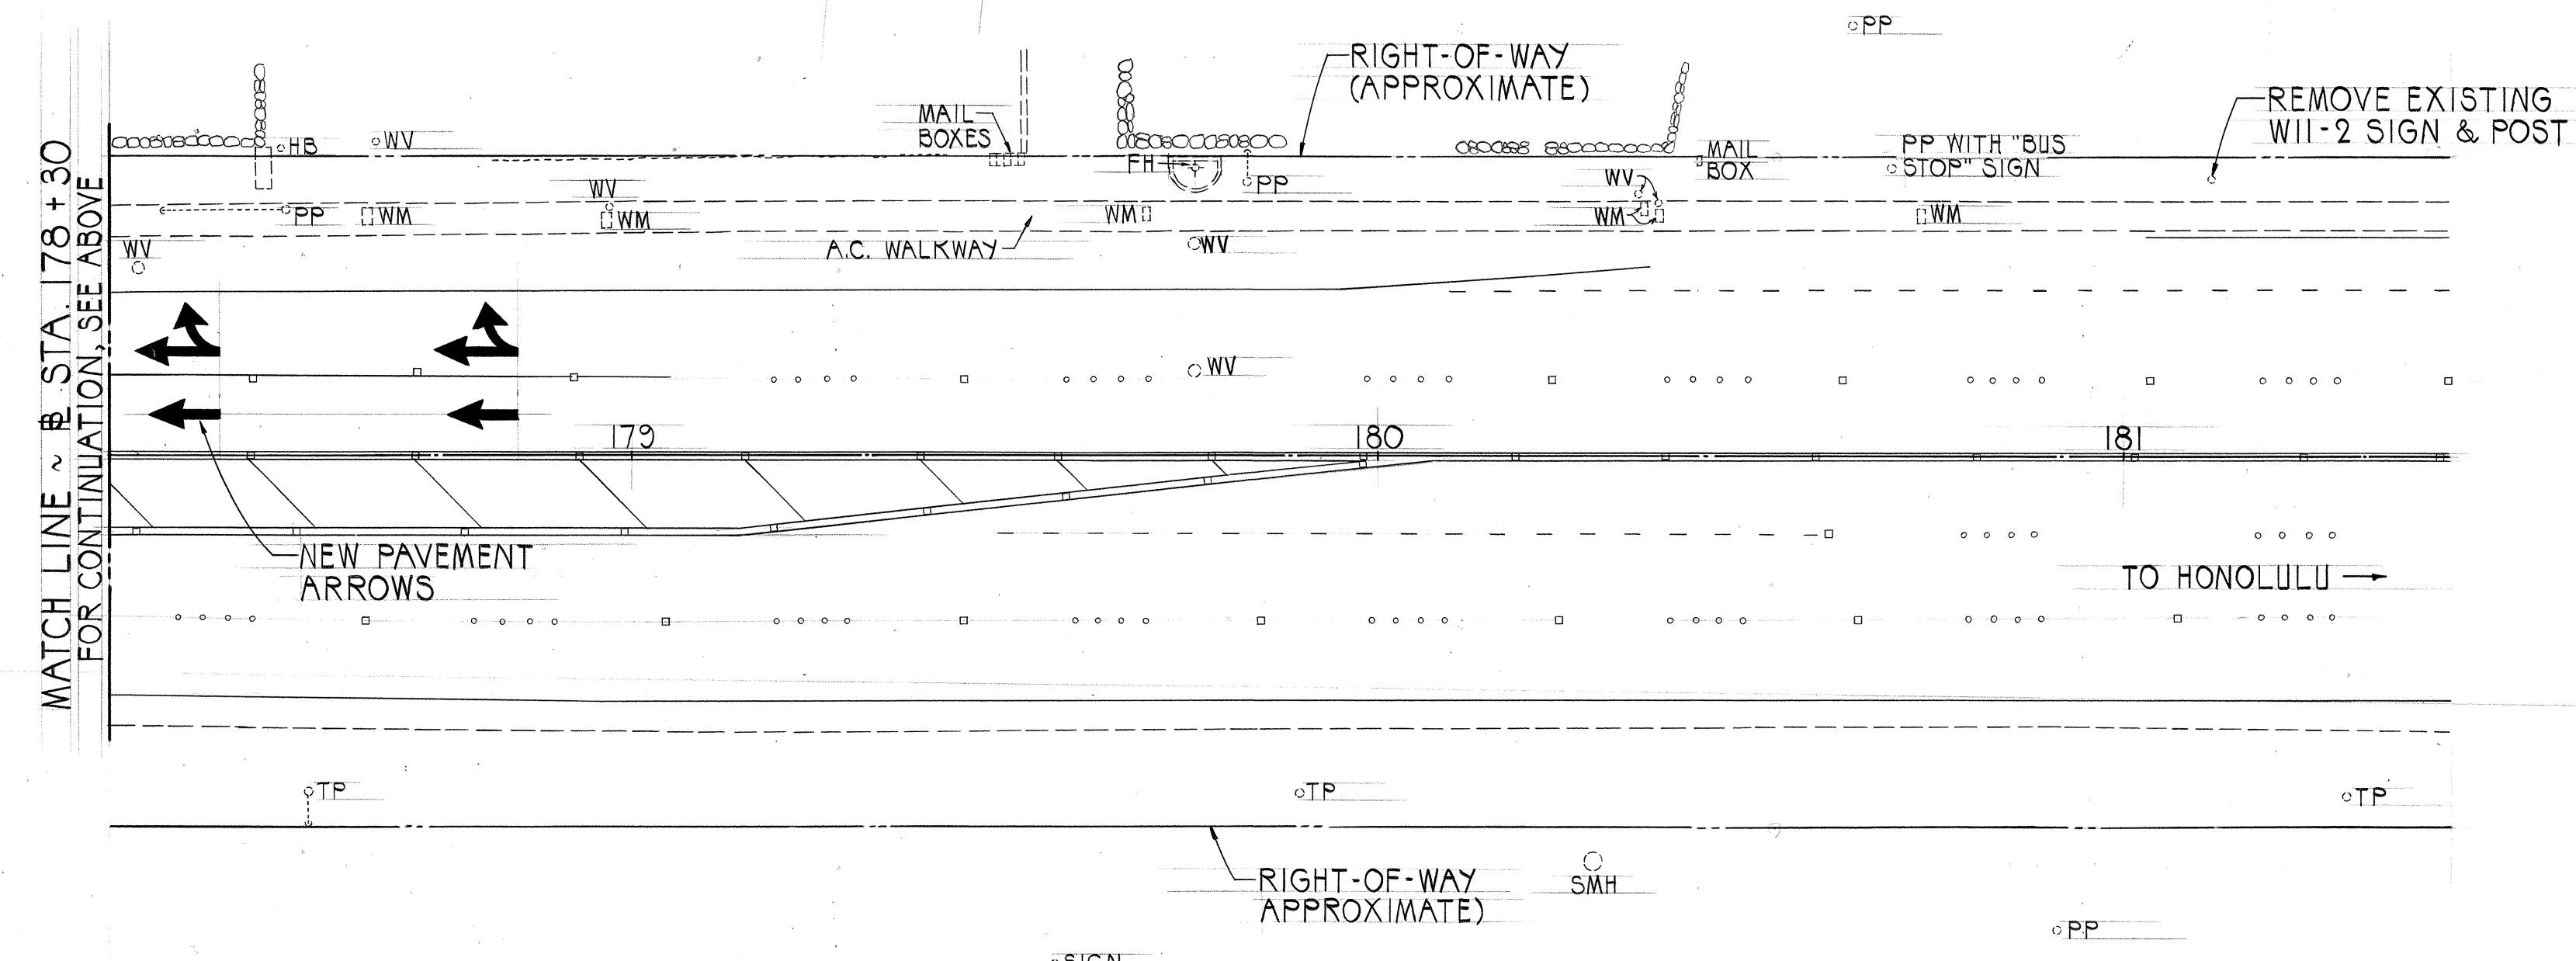


| FED. ROAD DIST. NO. | STATE | PROJ. NO. | FISCAL YEAR | SHEET NO. | TOTAL SHEETS |
|---------------------|-------|-----------|-------------|-----------|--------------|
| HAWAII              | HAW.  | 93A-03-86 | 1986        | 3         | 20           |

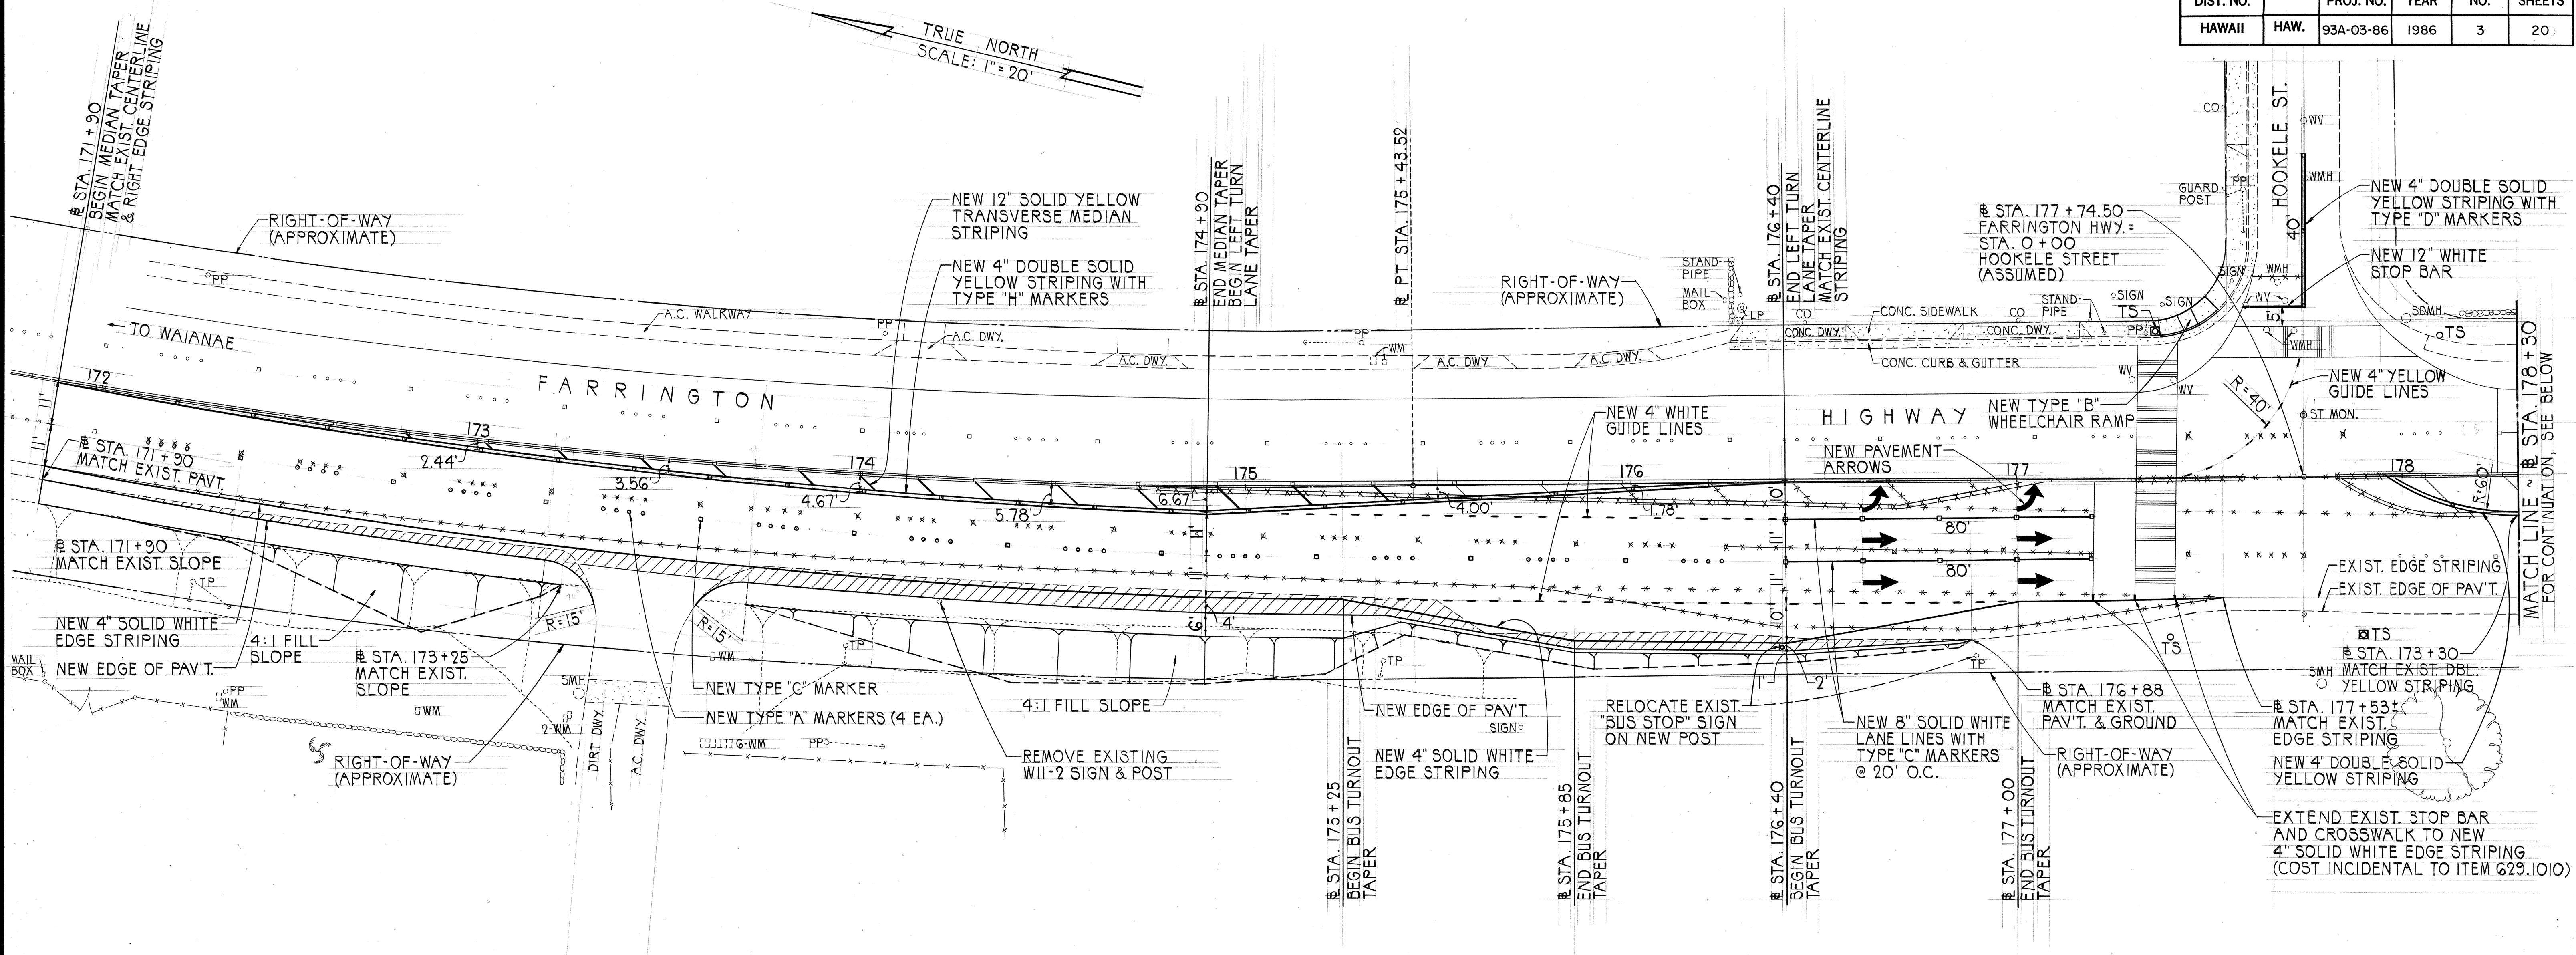

NOTE: ALL PAVEMENT STRIPING (EXCEPT EDGE STRIPING) CHANGED TO THERMOPLASTIC EXTRUSION (CHANGE ORDER NO. 1)

PAVEMENT RETURN GRADES  
SCALE: 1" = 20'

|                   |       |
|-------------------|-------|
| DATE              | _____ |
| SURVEY PLOTTED BY | _____ |
| DESIGNED BY       | _____ |
| NOTED BY          | _____ |
| CHECKED BY        | _____ |

THEODORE S. KAWAHIGASHI  
REGISTERED PROFESSIONAL ENGINEER  
No. 3244-C  
HAWAII, U.S.A.

THIS WORK WAS PREPARED BY ME OR UNDER MY SUPERVISION

*Theodore S. Kawahigashi*  
Signature

STATE OF HAWAII  
DEPARTMENT OF TRANSPORTATION  
HIGHWAYS DIVISION

**GEOMETRICS AND STRIPING PLAN**

FARRINGTON HIGHWAY  
TRAFFIC SIGNALS AT  
HOOKELE STREET  
PROJECT NO. 93A-03-86

SCALE: 1" = 20' DATE: MAY 16, 1986  
SHEET NO. 1 OF 1 SHEETS