

[illegible]

STATE OF HAWAII  
DEPARTMENT OF TRANSPORTATION  
HIGHWAYS DIVISION

HONOLULU, HAWAII

"AS-BUILT"

# PLANS FOR



## FARRINGTON HIGHWAY, TRAFFIC SIGNALS

AT HOOKELE STREET


PROJECT NO. 93A - 03 - 86

**DISTRICT OF WAIANAE**  
**ISLAND OF OAHU**

FED. ROAD DIST. NO.	STATE	PROJ. NO.	FISCAL YEAR	SHEET NO.	TOTAL SHEETS
HAWAII	HAW.	93A-03-86	1986	1	20

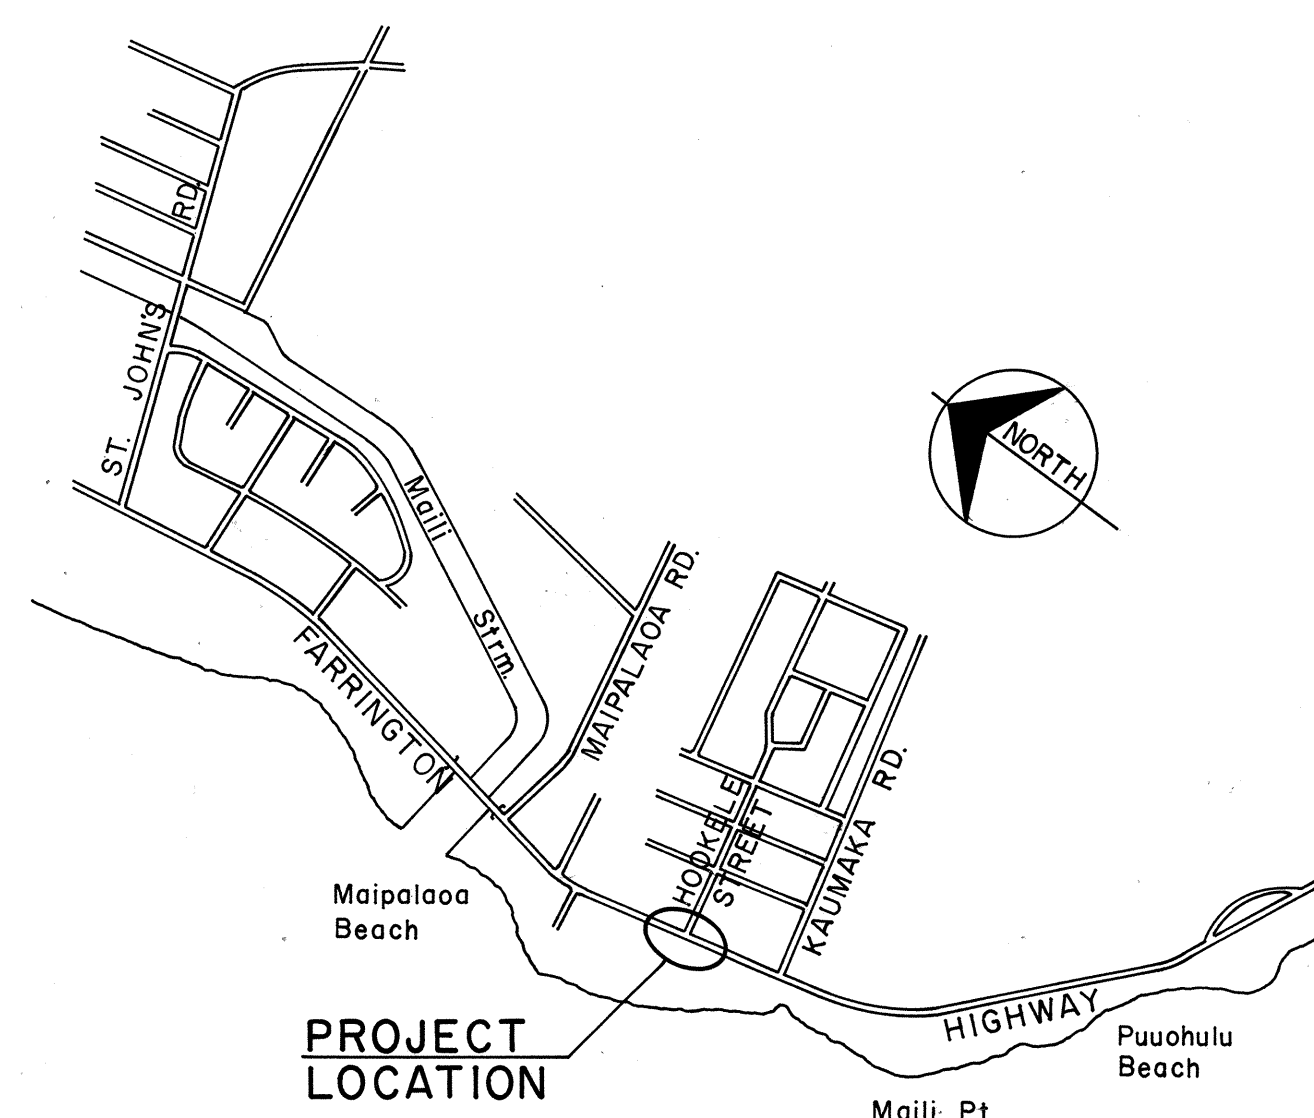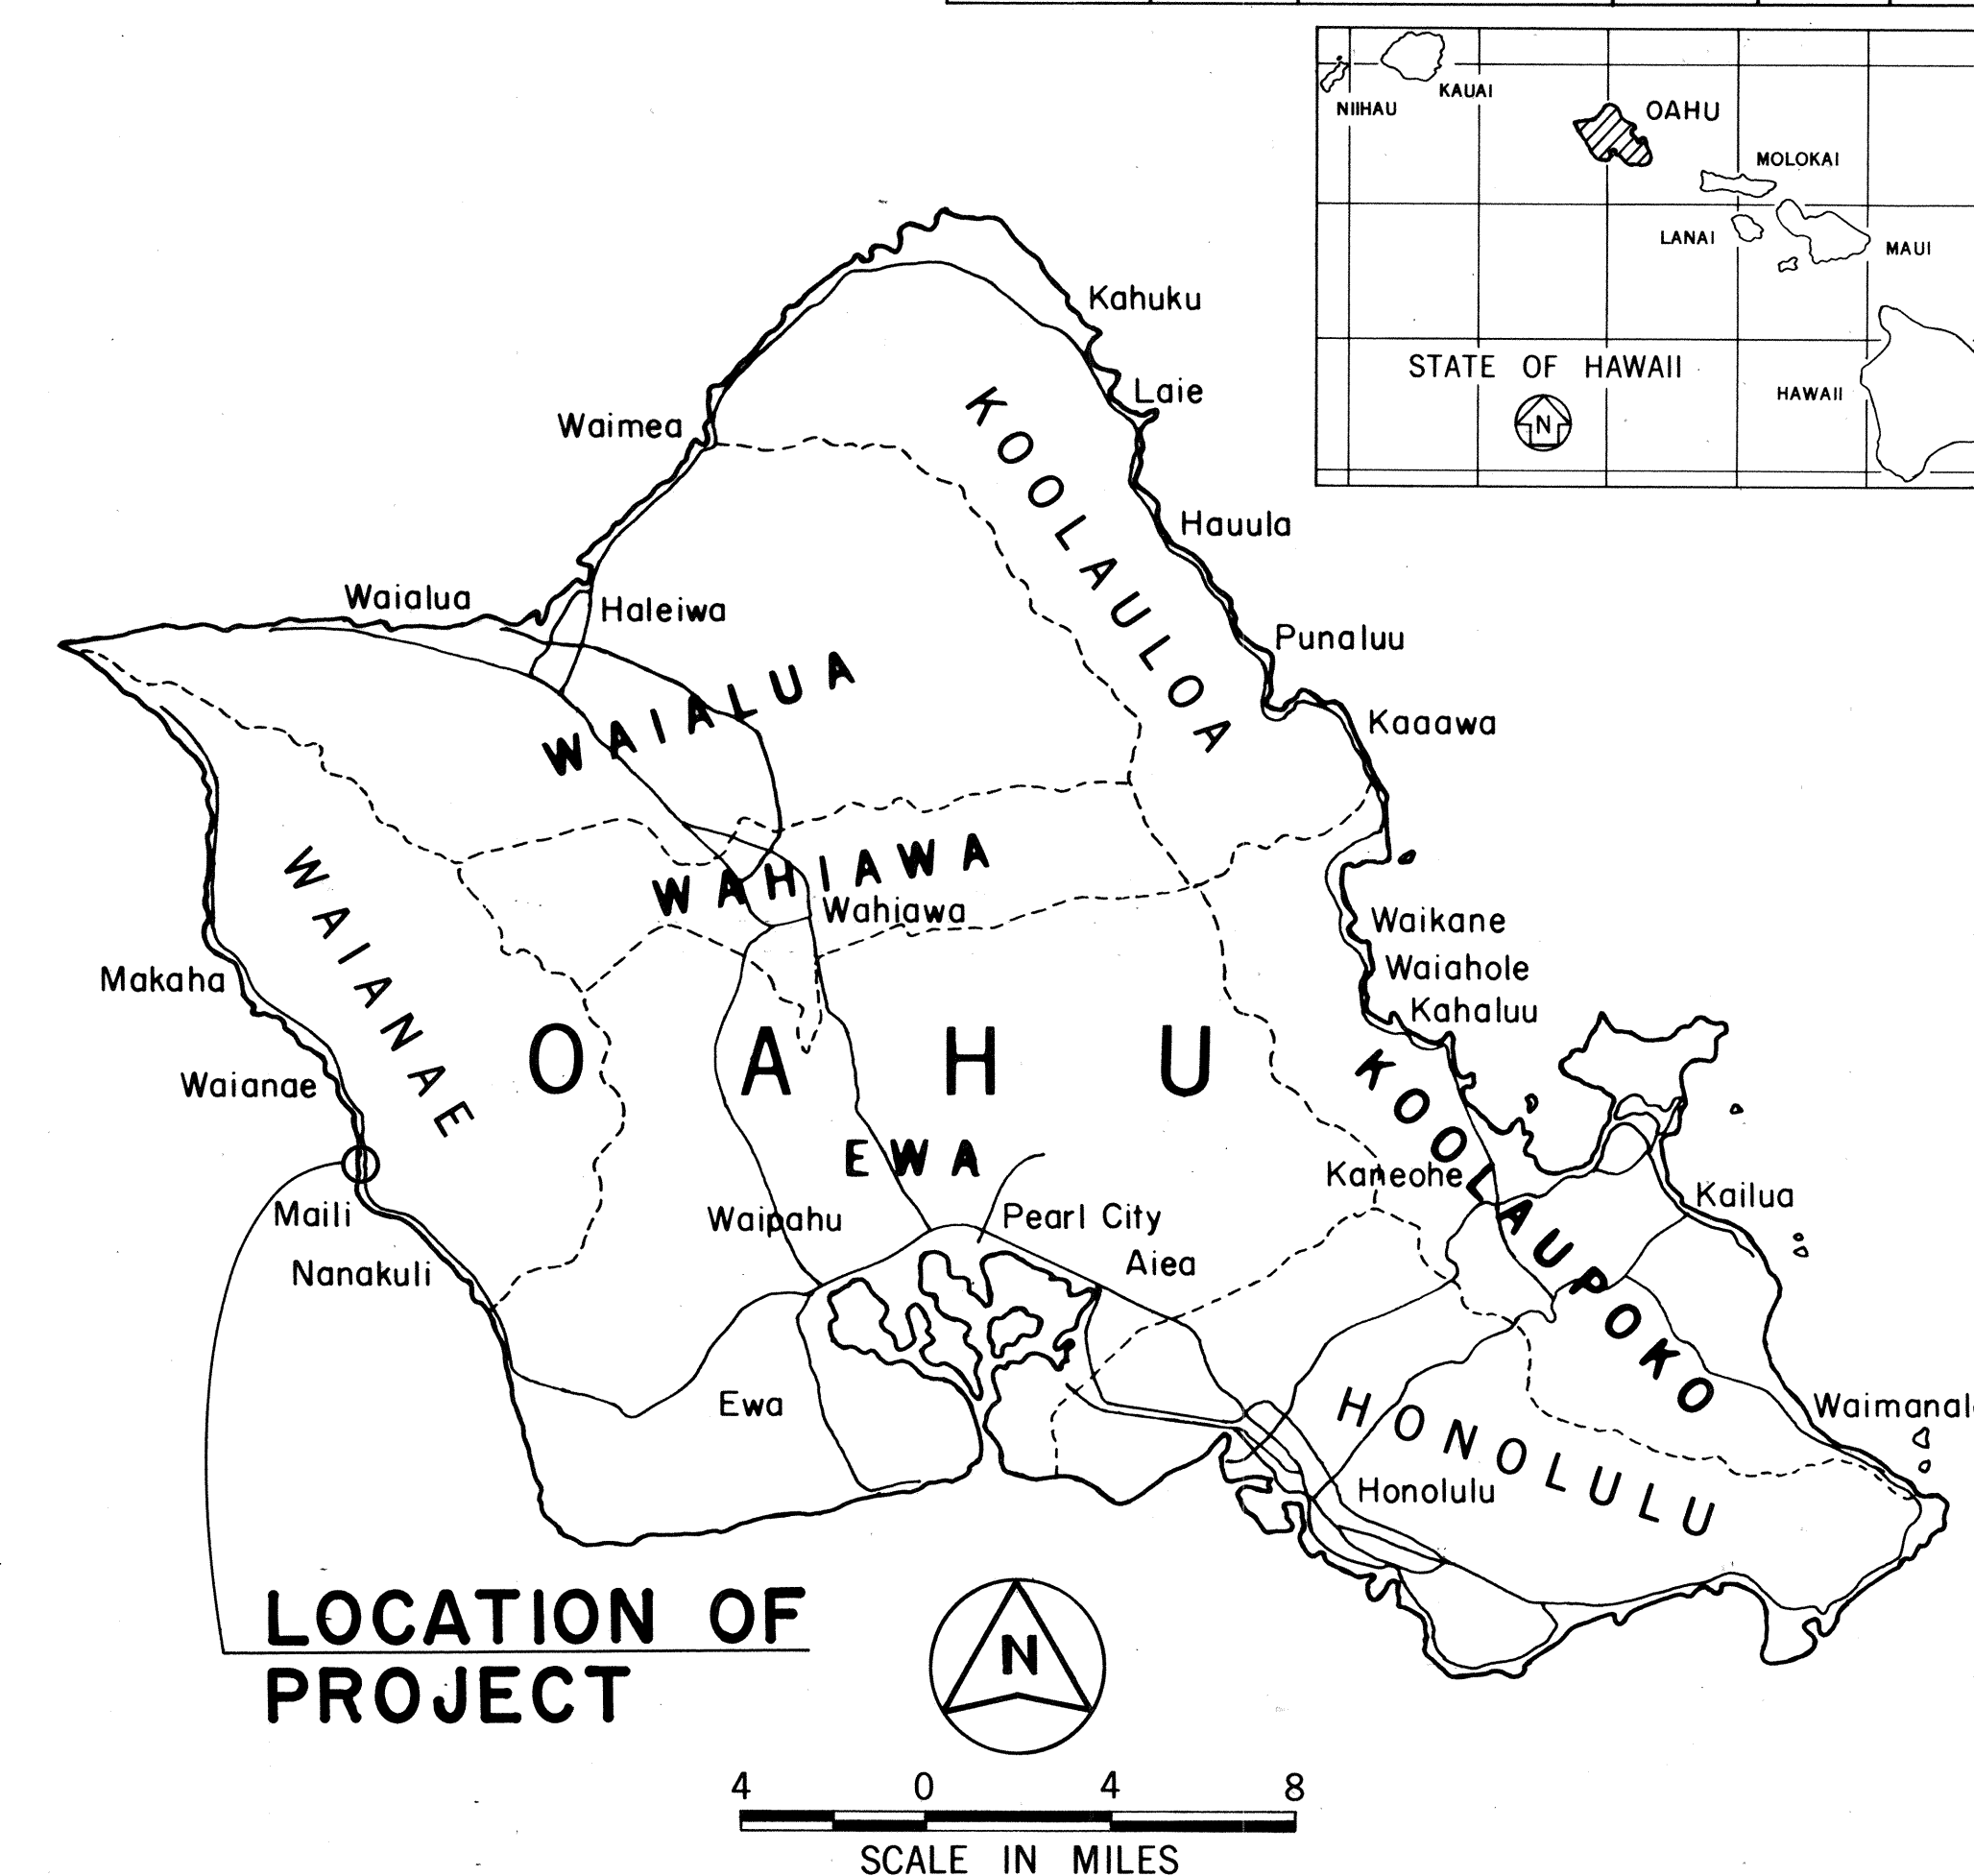

## LAYOUT PLAN

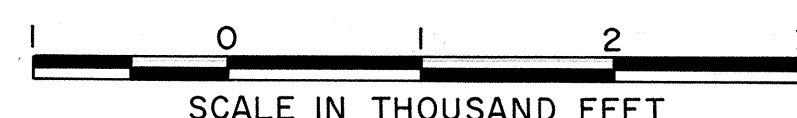

CHANGES MADE DURING CONSTRUCTION HAVE  
BEEN INCORPORATED ON THESE PLANS EXCEPT  
CHANGES IN THE ORIGINAL THEORETICAL  
QUANTITIES. FOR ACTUAL QUANTITIES, REFER TO  
PROJECT LEDGER AND/OR COMPUTATION BOOK.

Michael Dimega

RESIDENT ENGINEER

9/14/8

DATE

DEPARTMENT OF TRANSPORTATION  
STATE OF HAWAII

APPROVED:

Matthew J. Chini 5-19-8

DIR. OF TRANSPORTATION DAT