



ORIGINAL PLAN	SURVEY PLOTTED BY _____	DATE _____
NOTE BOOK	DRAWN BY _____	TRACED BY _____
	DESIGNED BY _____	QUANTITIES BY _____
	CHECKED BY _____	
	No. _____	

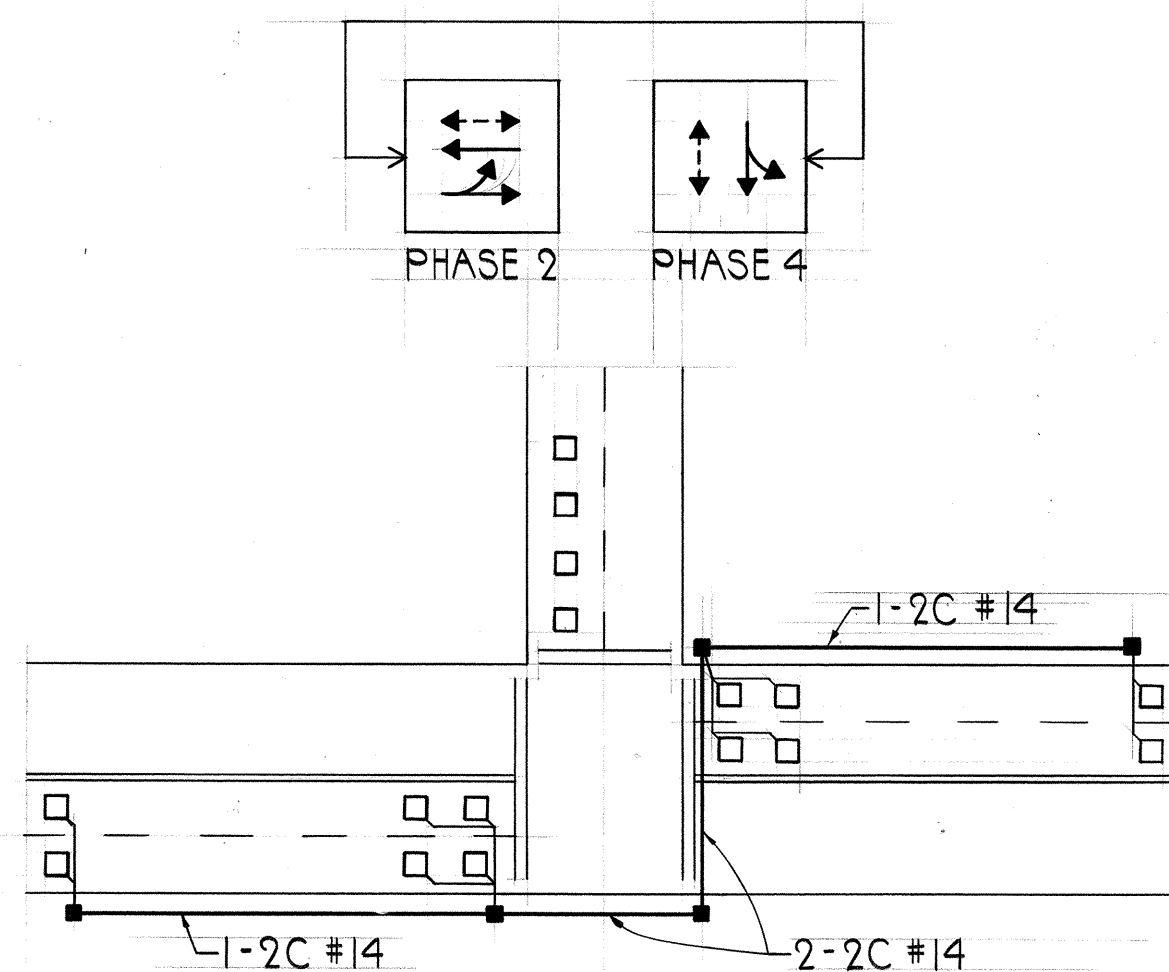

DETECTOR ASSIGNMENT SHALL
BE PER CALIFORNIA DEPT. OF
TRANSPORTATION "TRAFFIC SIGNAL
CONTROL LOCAL INTERSECTION
PROGRAM", JULY 1978.

SIGNAL INDICATIONS

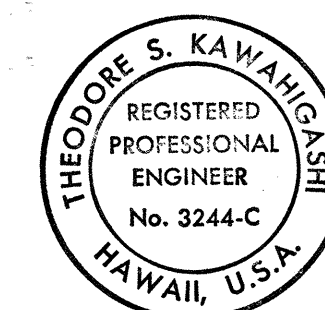

Theodore S. Kawahiga
Signature

SHEET No. 1 OF 1 SHEETS