



FED. ROAD DIST. NO.	STATE	FED. AID PROJ. NO.	FISCAL YEAR	SHEET NO.	TOTAL SHEETS
HAWAII	HAW.	BR-093-1(10)	1987	5	27

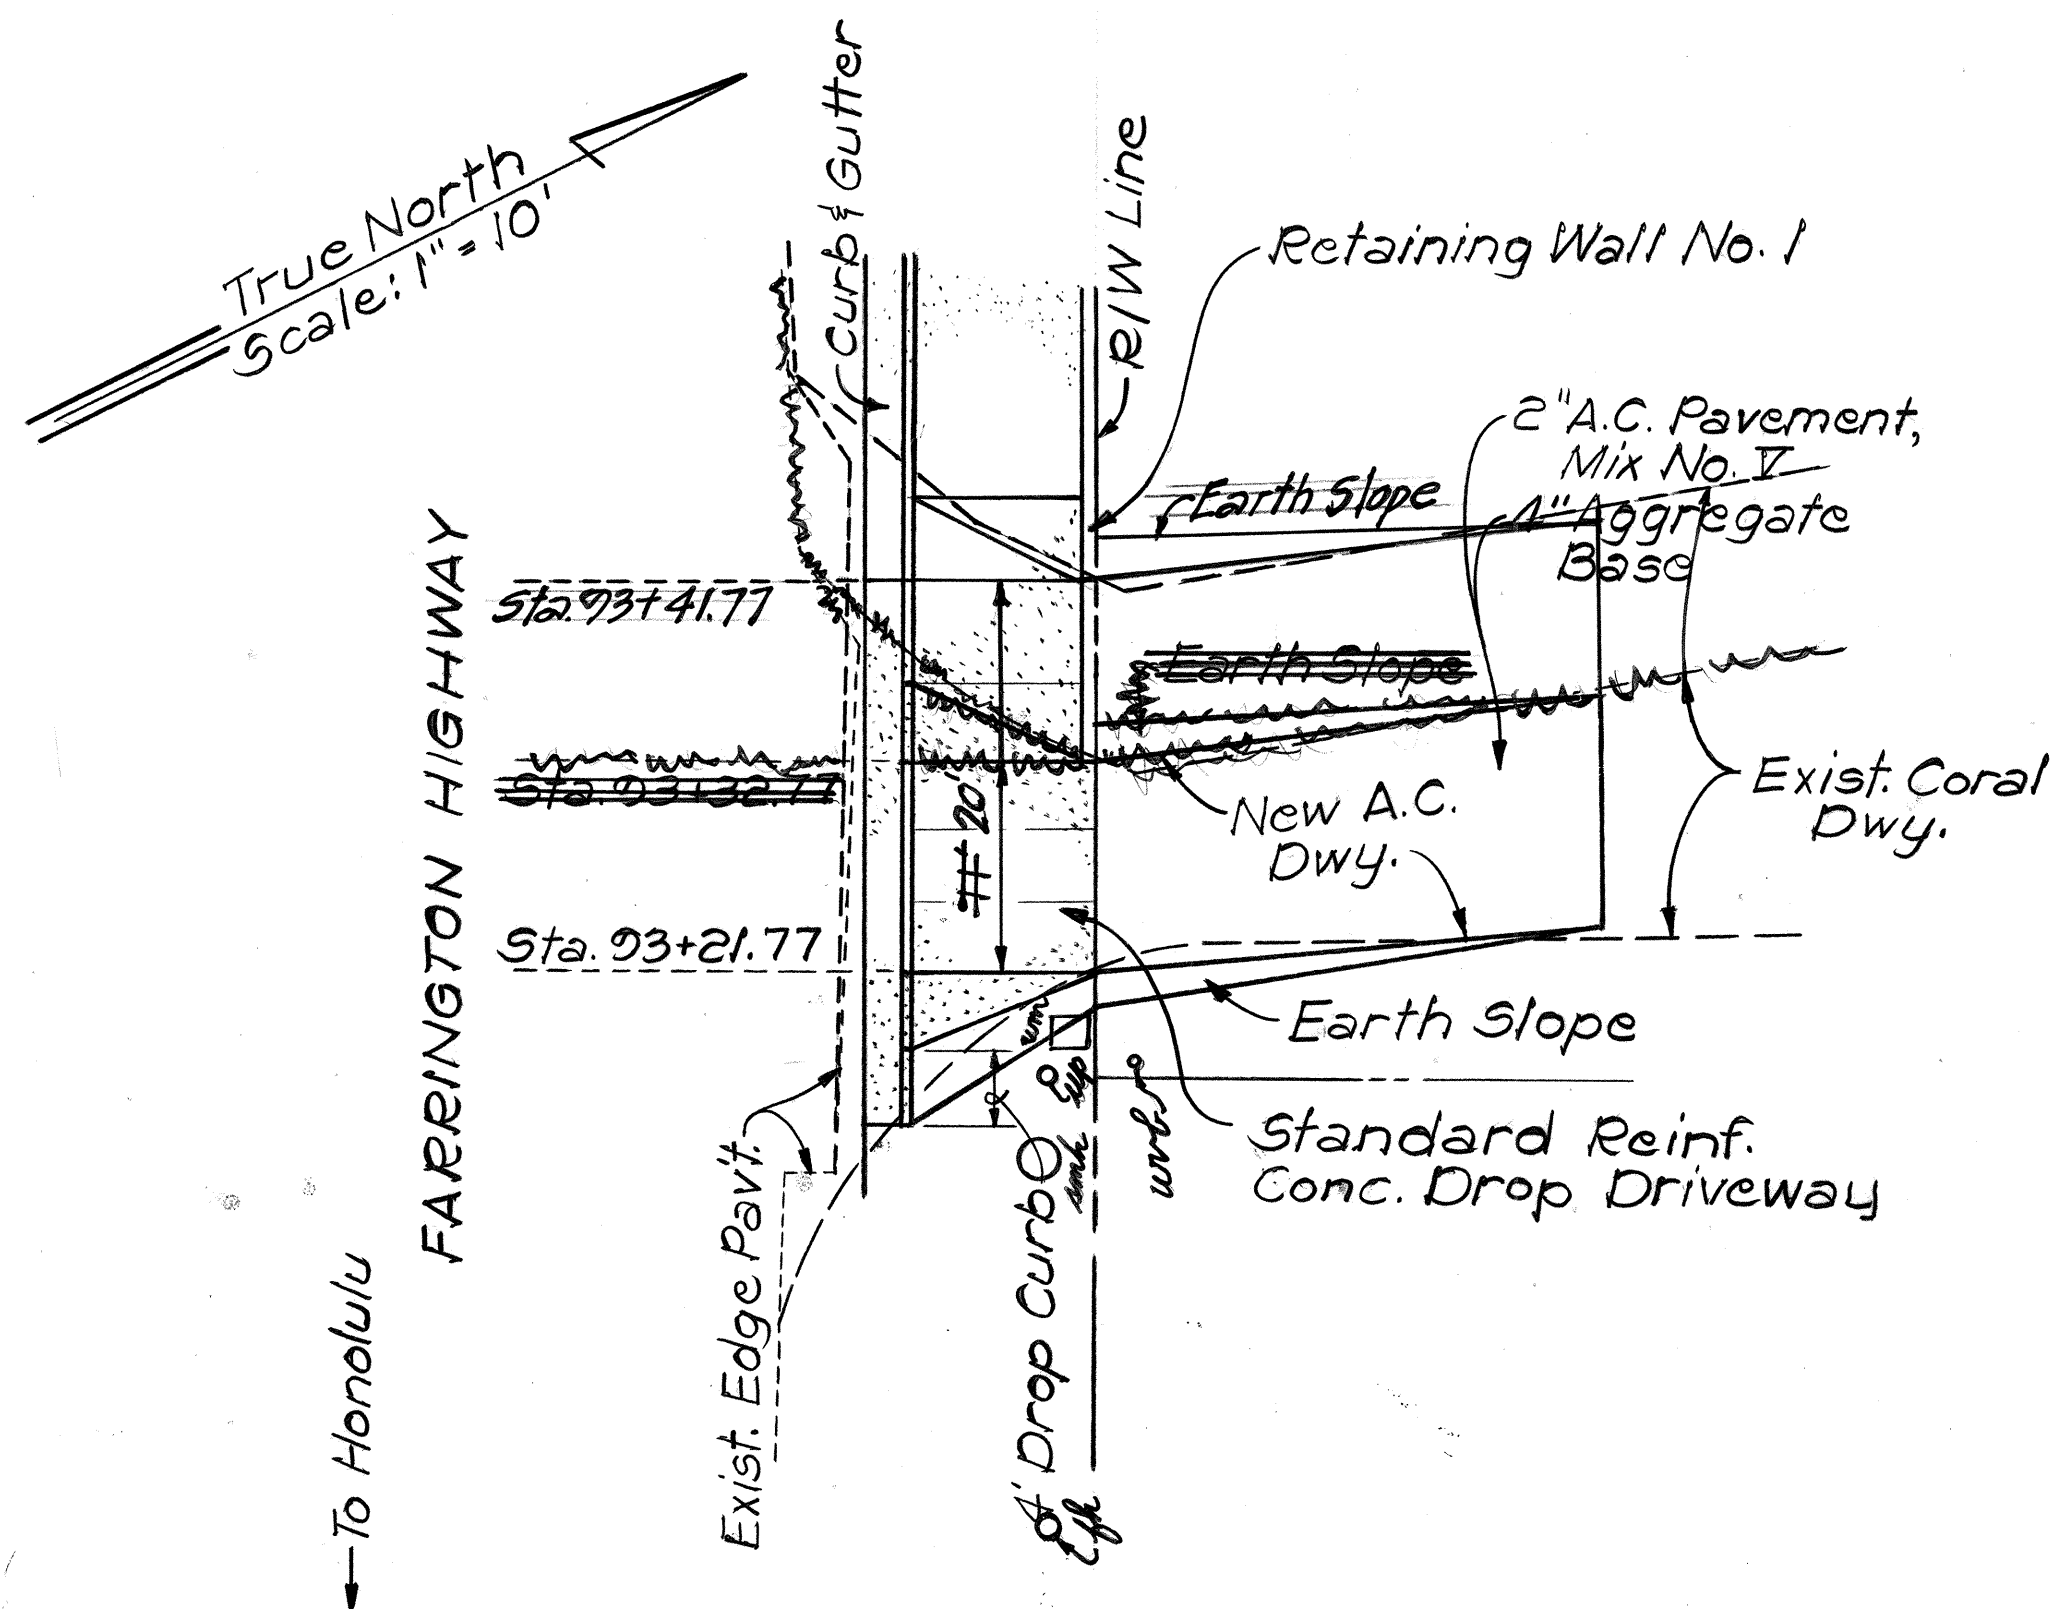


PLAN
T.M.K.: 8-5-18:12
Scale: 1"=10'

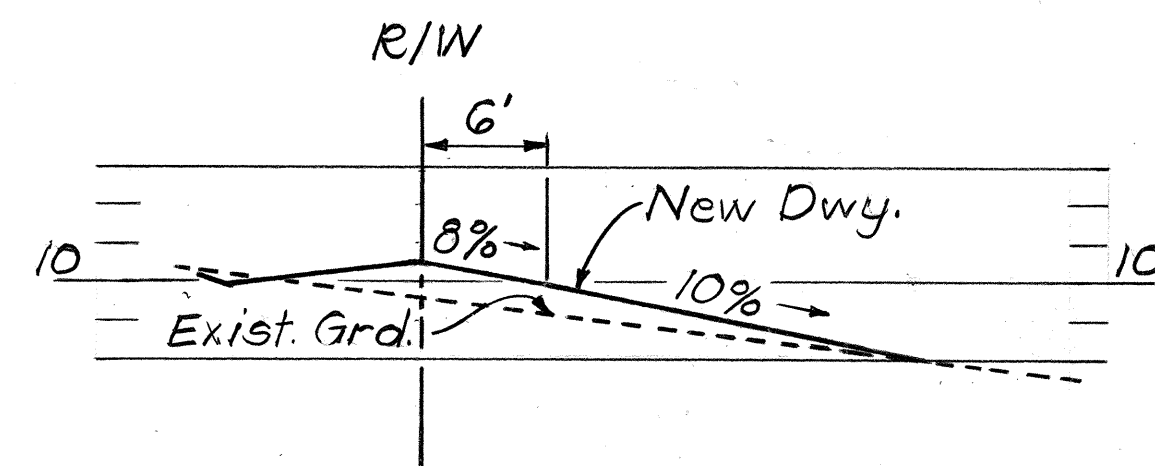


PROFILE
Scale: Horiz.: 1"=10'
Vert.: 1"=5'

DRIVEWAY AT STA. 93+21.77 (RIGHT)
Scale: As Noted

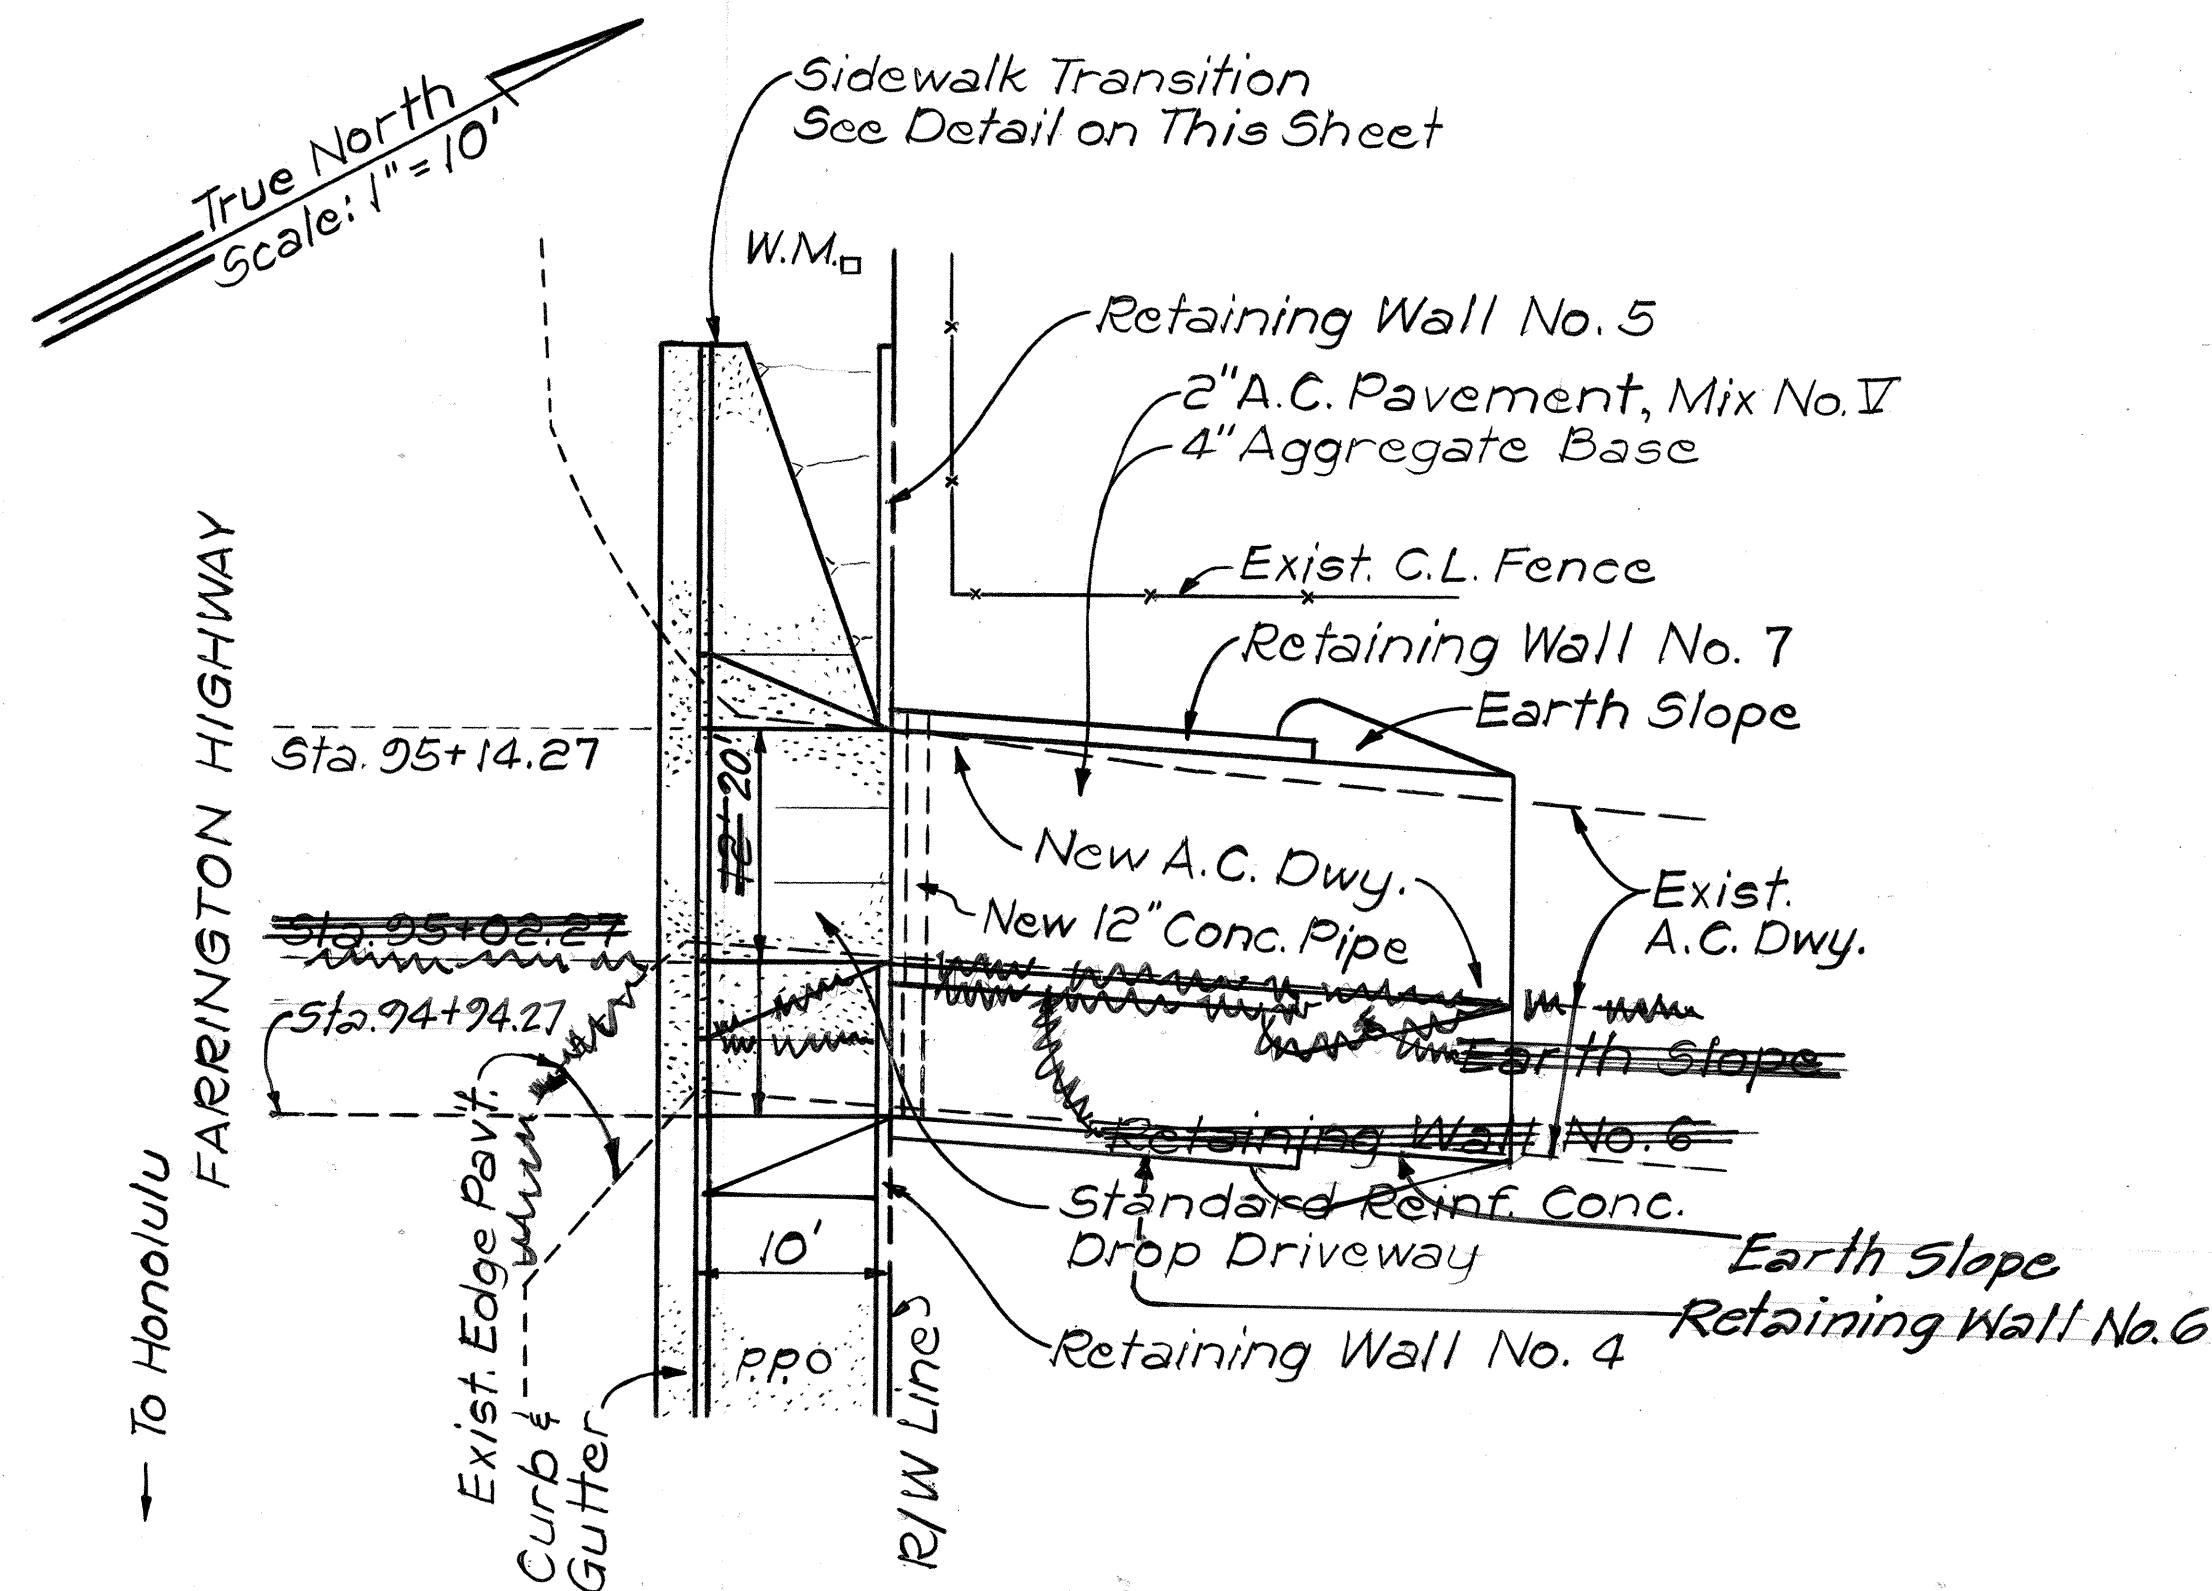


PLAN
T.M.K.: 8-5-18:15
Scale: 1"=10'

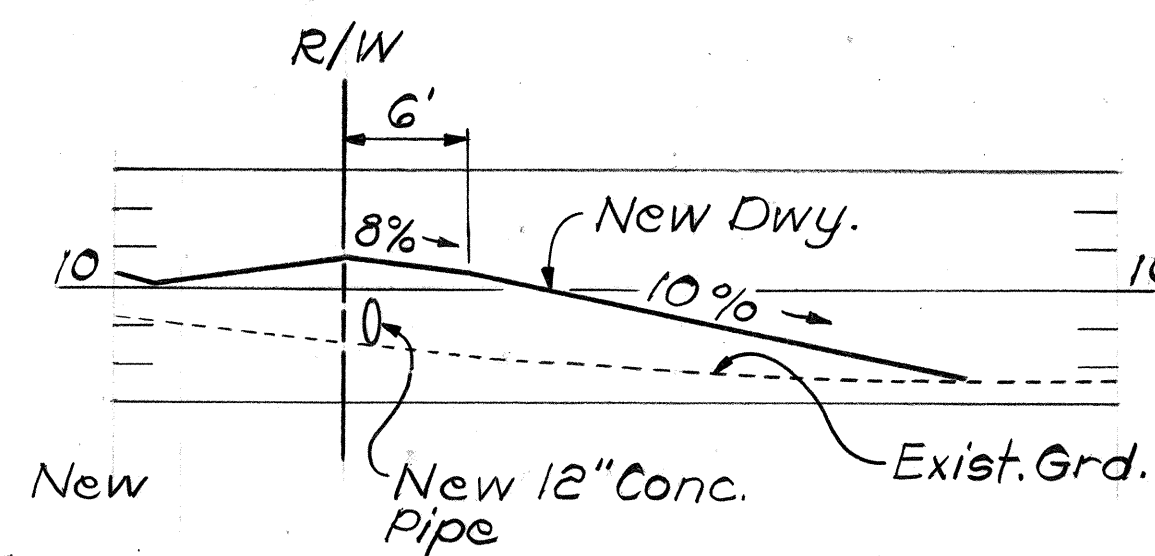


PROFILE
Scale: Horiz.: 1"=10'
Vert.: 1"=5'


DRIVEWAY AT STA. 95+08.27 (RIGHT)
Scale: As Noted

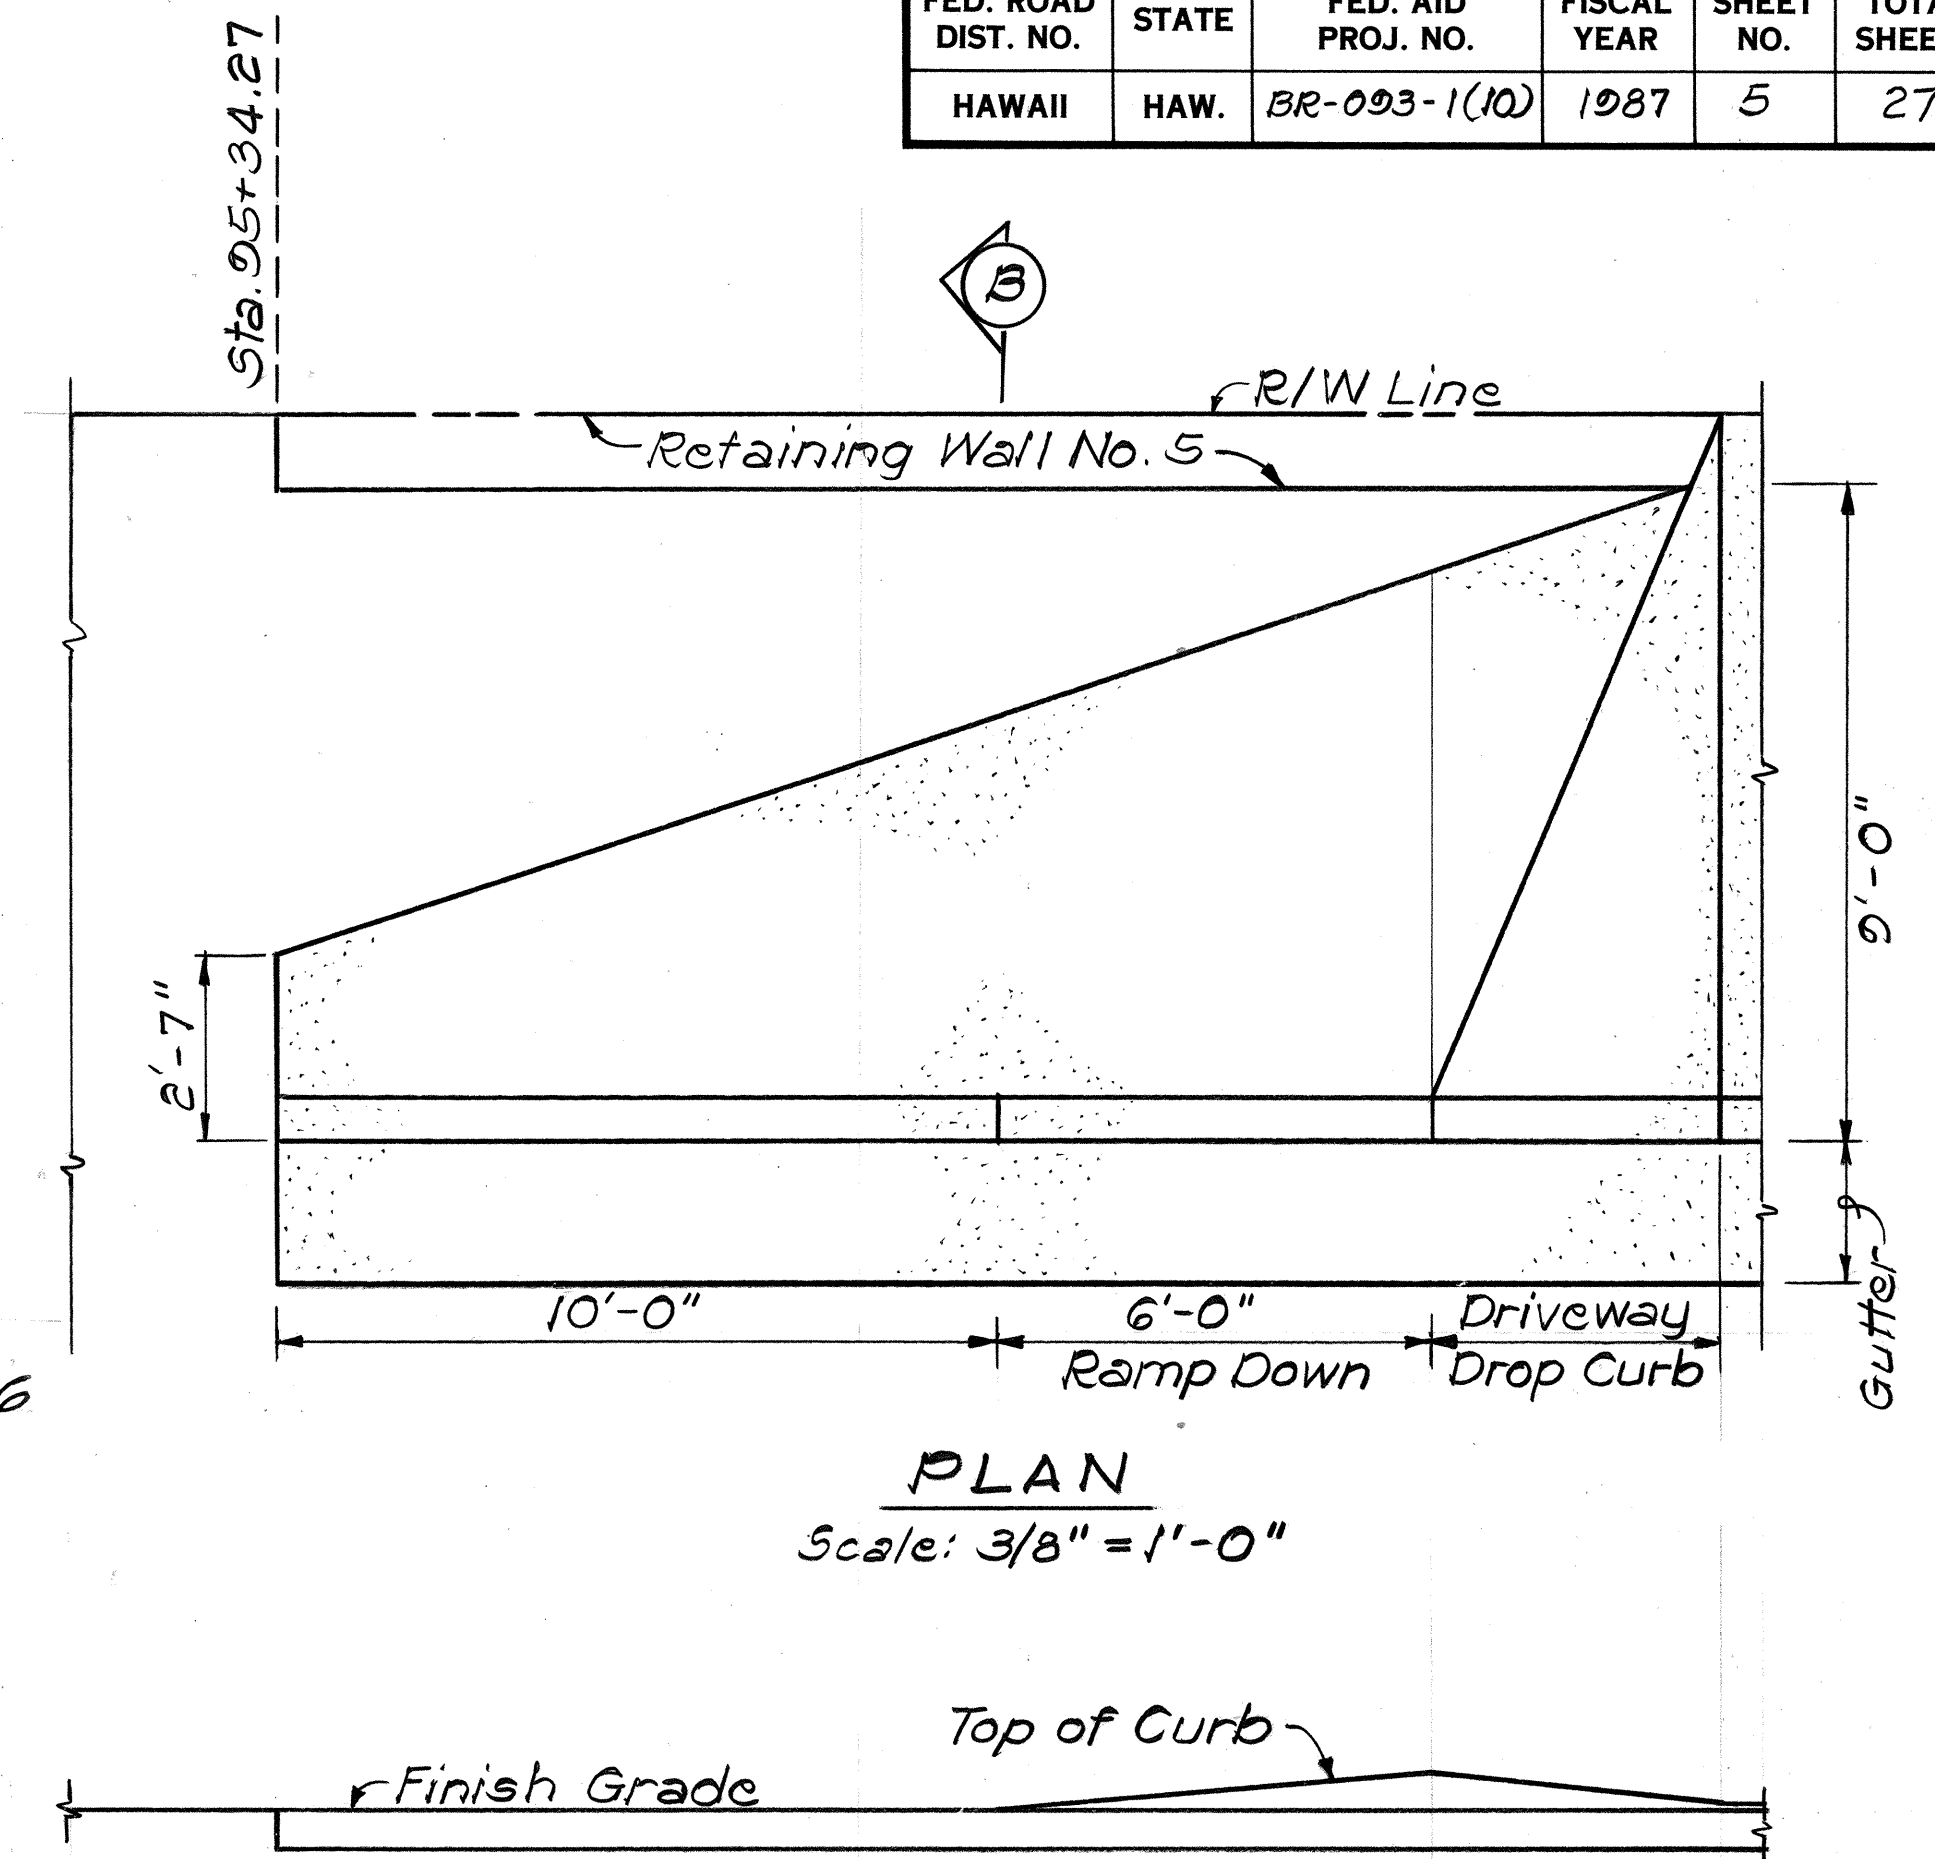

PLAN
Scale: 3/8"=1'-0"

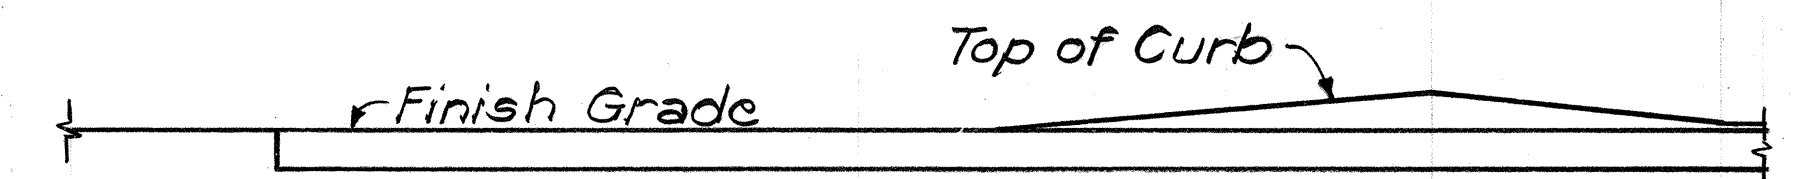

ELEVATION
Scale: 3/8"=1'-0"

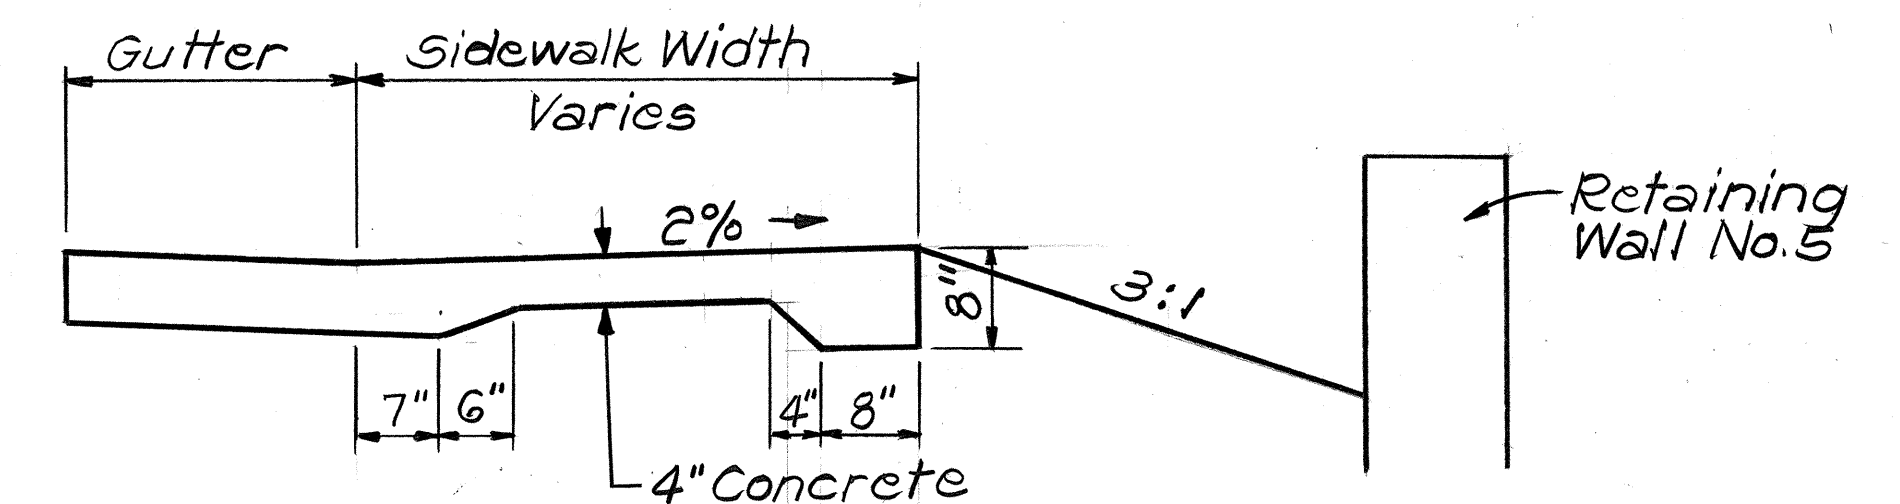


SECTION (B)
Scale: 3/4"=1'-0"


SIDEWALK TRANSITION
Scale: As Noted

STATE OF HAWAII
DEPARTMENT OF TRANSPORTATION
HIGHWAYS DIVISION
**DRIVEWAY ADJUSTMENT
DETAILS**
FARRINGTON HIGHWAY
FED. AID PROJ. NO. BR-093-1(10)
Scale: As Noted Date: March, 1987
SHEET NO. 1 OF 2 SHEETS


FED. ROAD DIST. NO.	STATE	FED. AID PROJ. NO.	FISCAL YEAR	SHEET NO.	TOTAL SHEETS
HAWAII	HAW.	BR-093-1(10)	1987	6	27

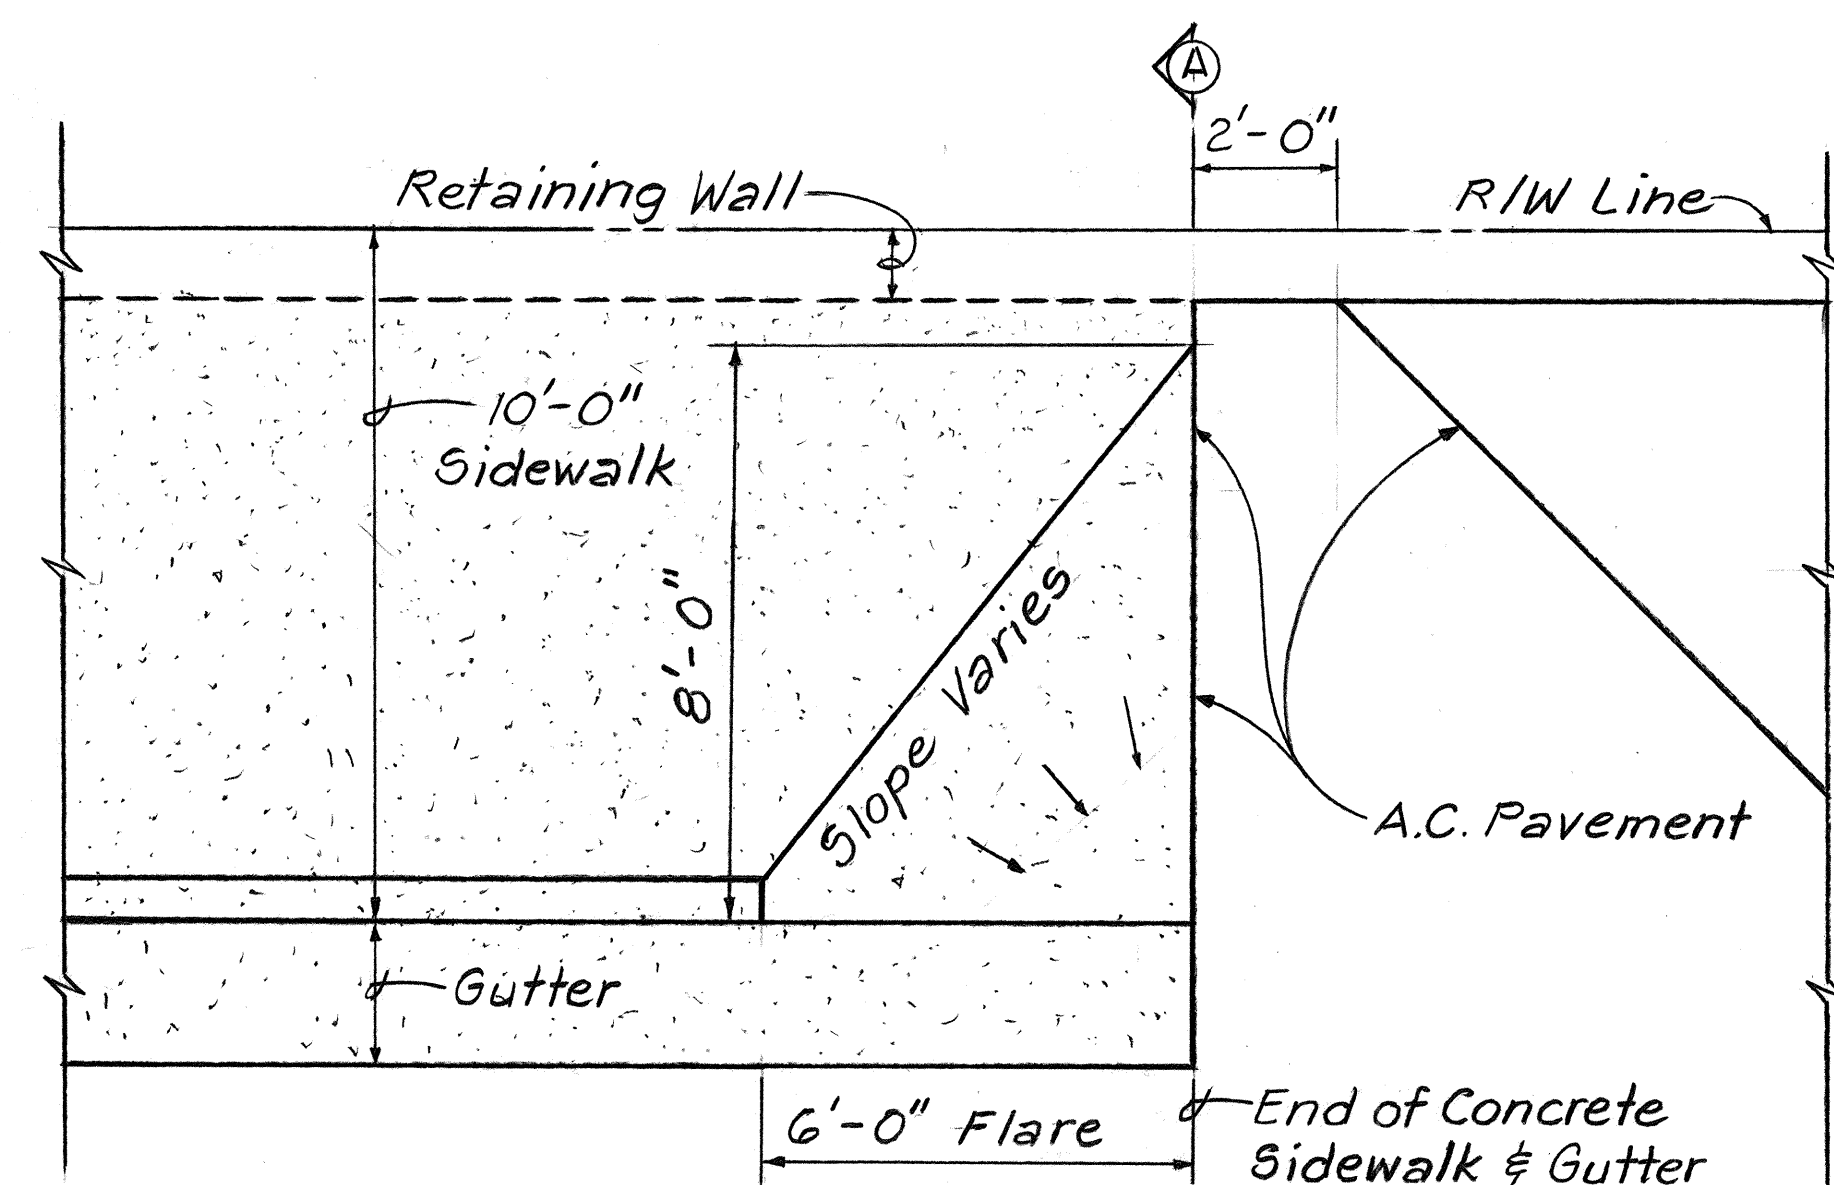

PLAN
Scale: $\frac{3}{8}" = 1'-0"$

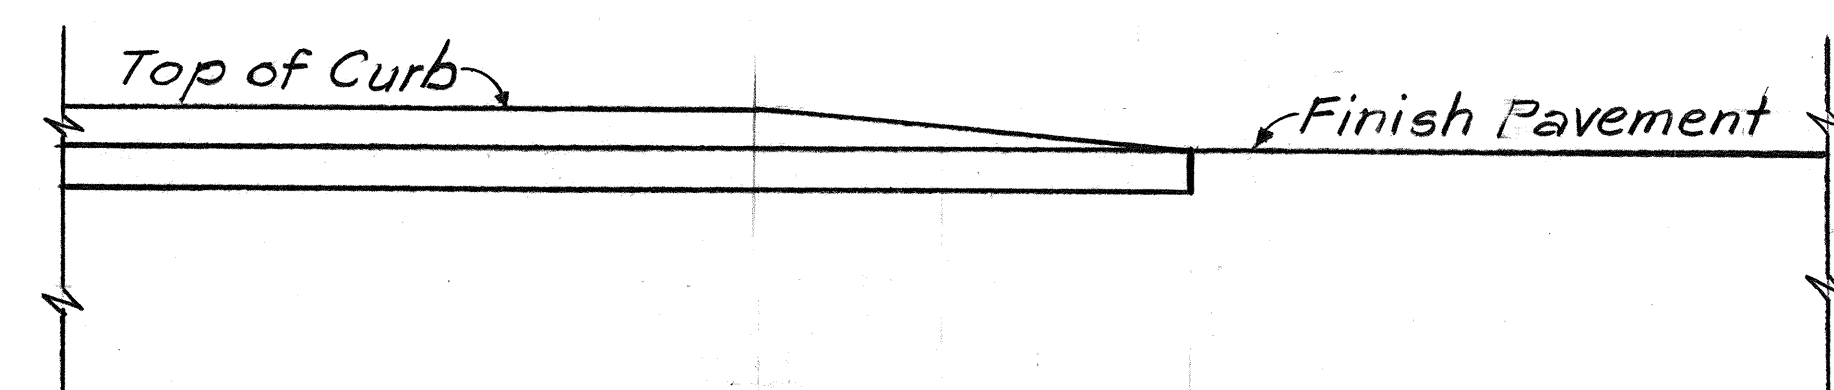


ELEVATION
Scale: $\frac{3}{8}" = 1'-0"$

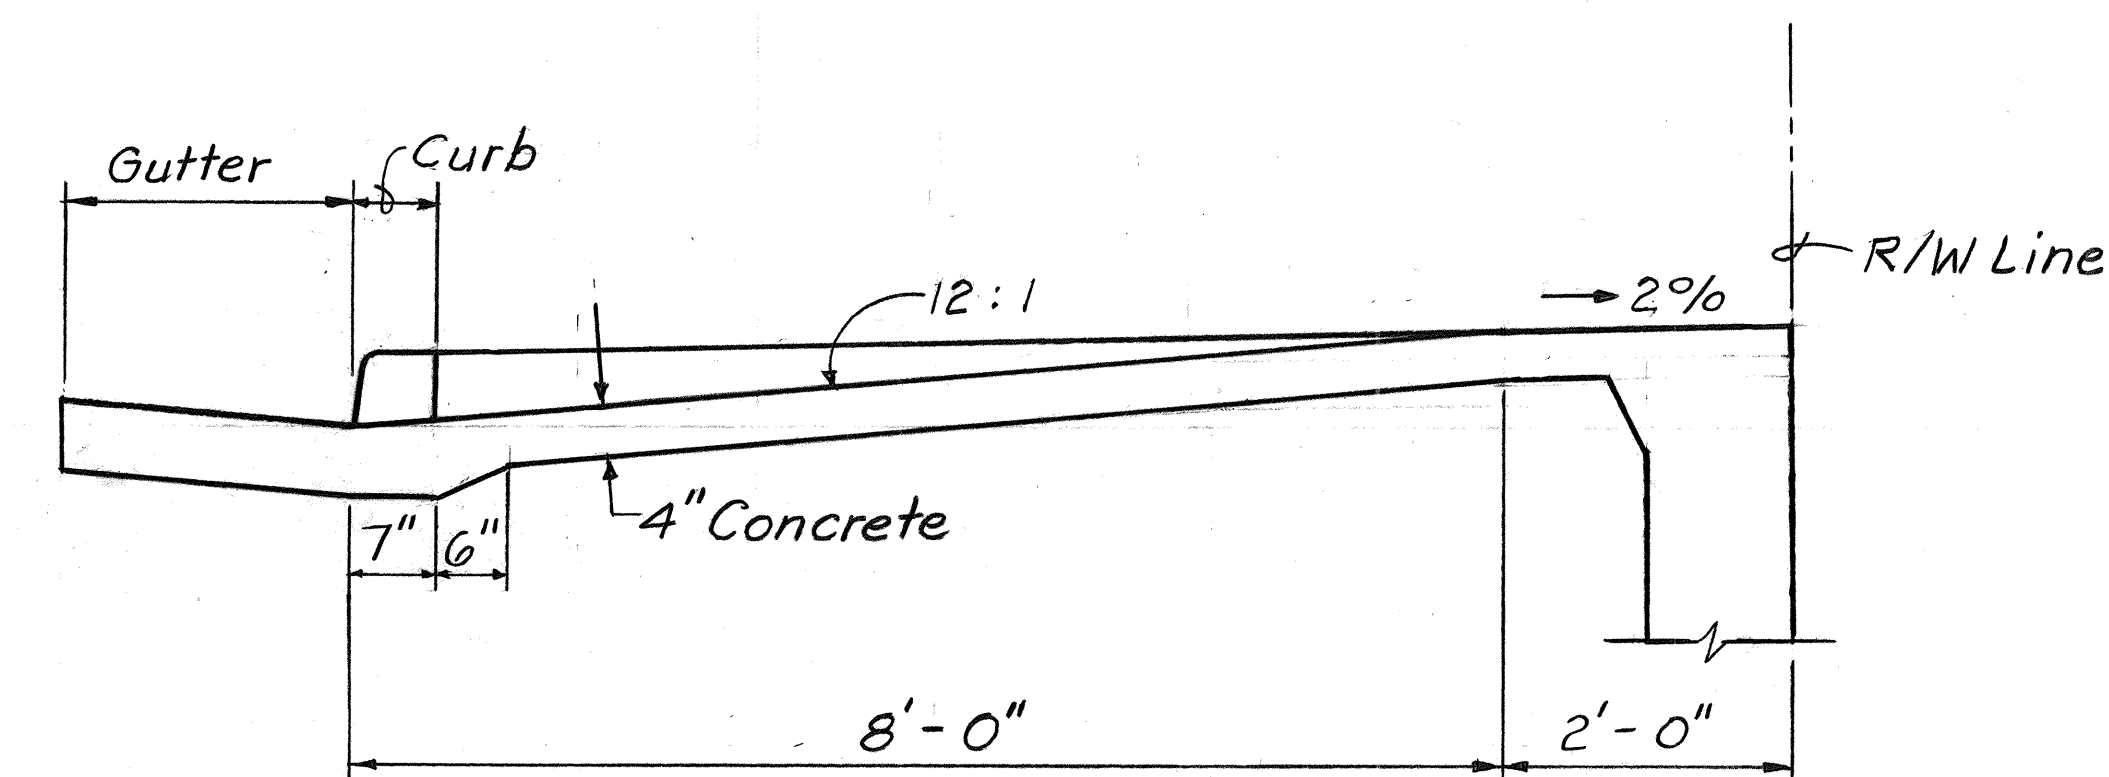


SECTION A
Scale: $\frac{3}{4}" = 1'-0"$

SIDEWALK TERMINUS
STA. 93+93.77 AND STA. 95+05.27
Scale: As Noted

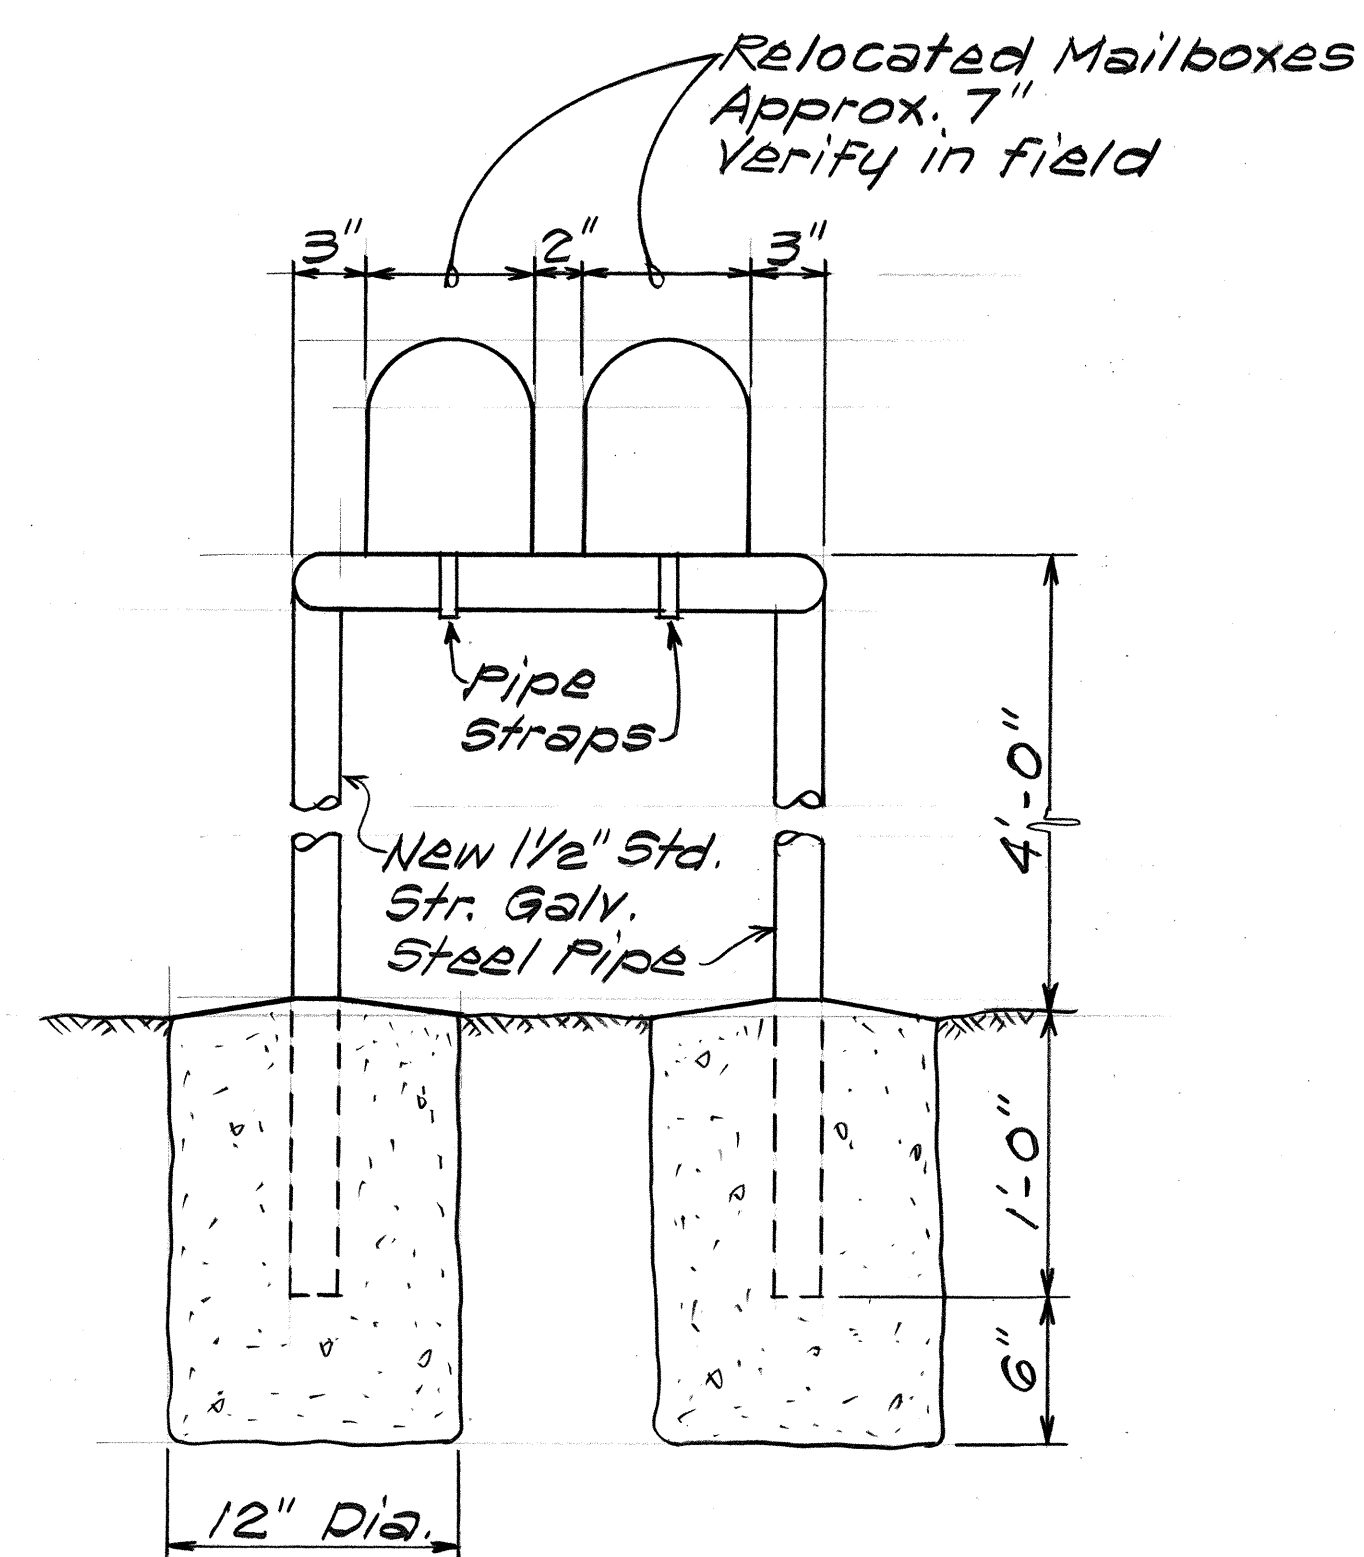

RELOCATED MAILBOXES
Scale: $\frac{1}{2}" = 1'-0"$

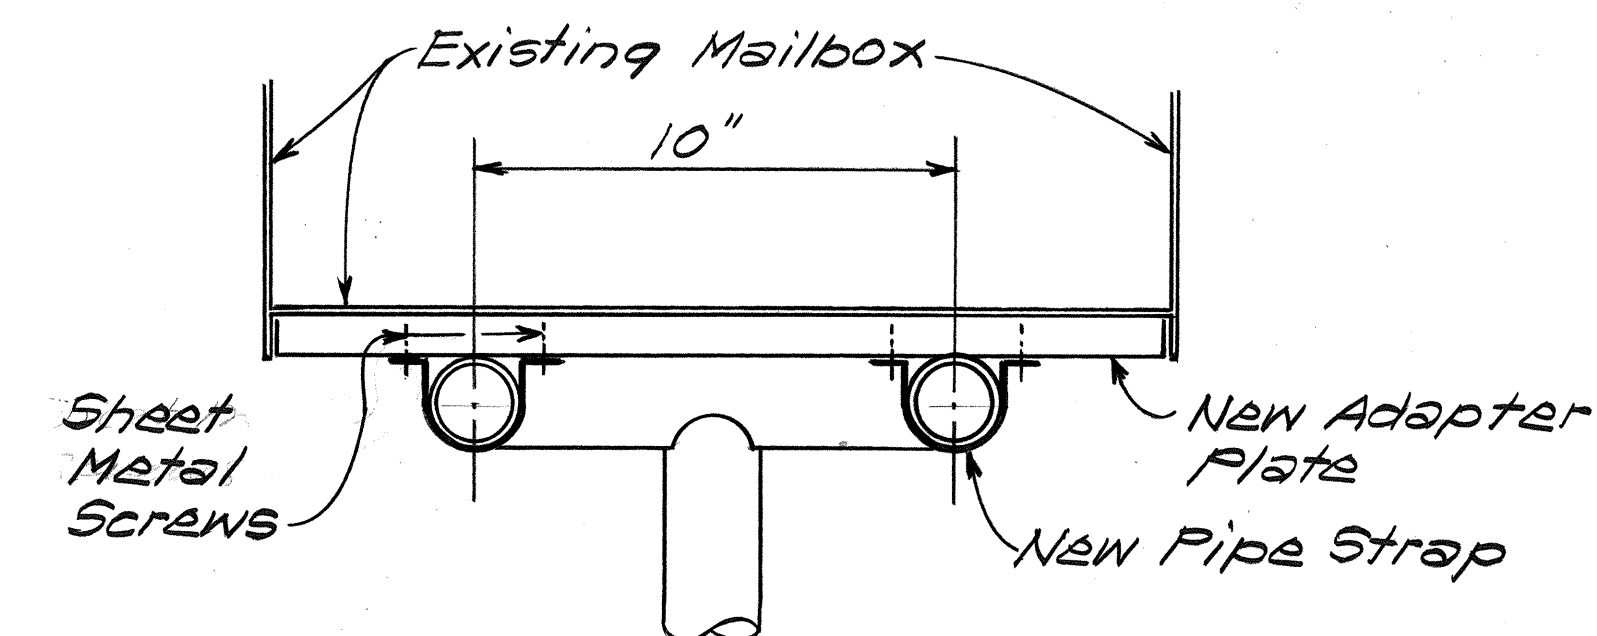

MAILBOX CONNECTION DETAIL
Scale: $\frac{3}{8}" = 1'-0"$

STATE OF HAWAII
DEPARTMENT OF TRANSPORTATION
HIGHWAYS DIVISION

MISCELLANEOUS DETAILS

FARRINGTON HIGHWAY
FED. AID PROJ. NO. BR-093-1(10)

Scale: As Noted Date: March, 1987

SHEET NO. 2 OF 2 SHEETS