



FED. ROAD DIST. NO.	STATE	FED. AID PROJ. NO.	FISCAL YEAR	SHEET NO.	TOTAL SHEETS
HAWAII	HAW.	BR-093-1(10)	1987	12	27

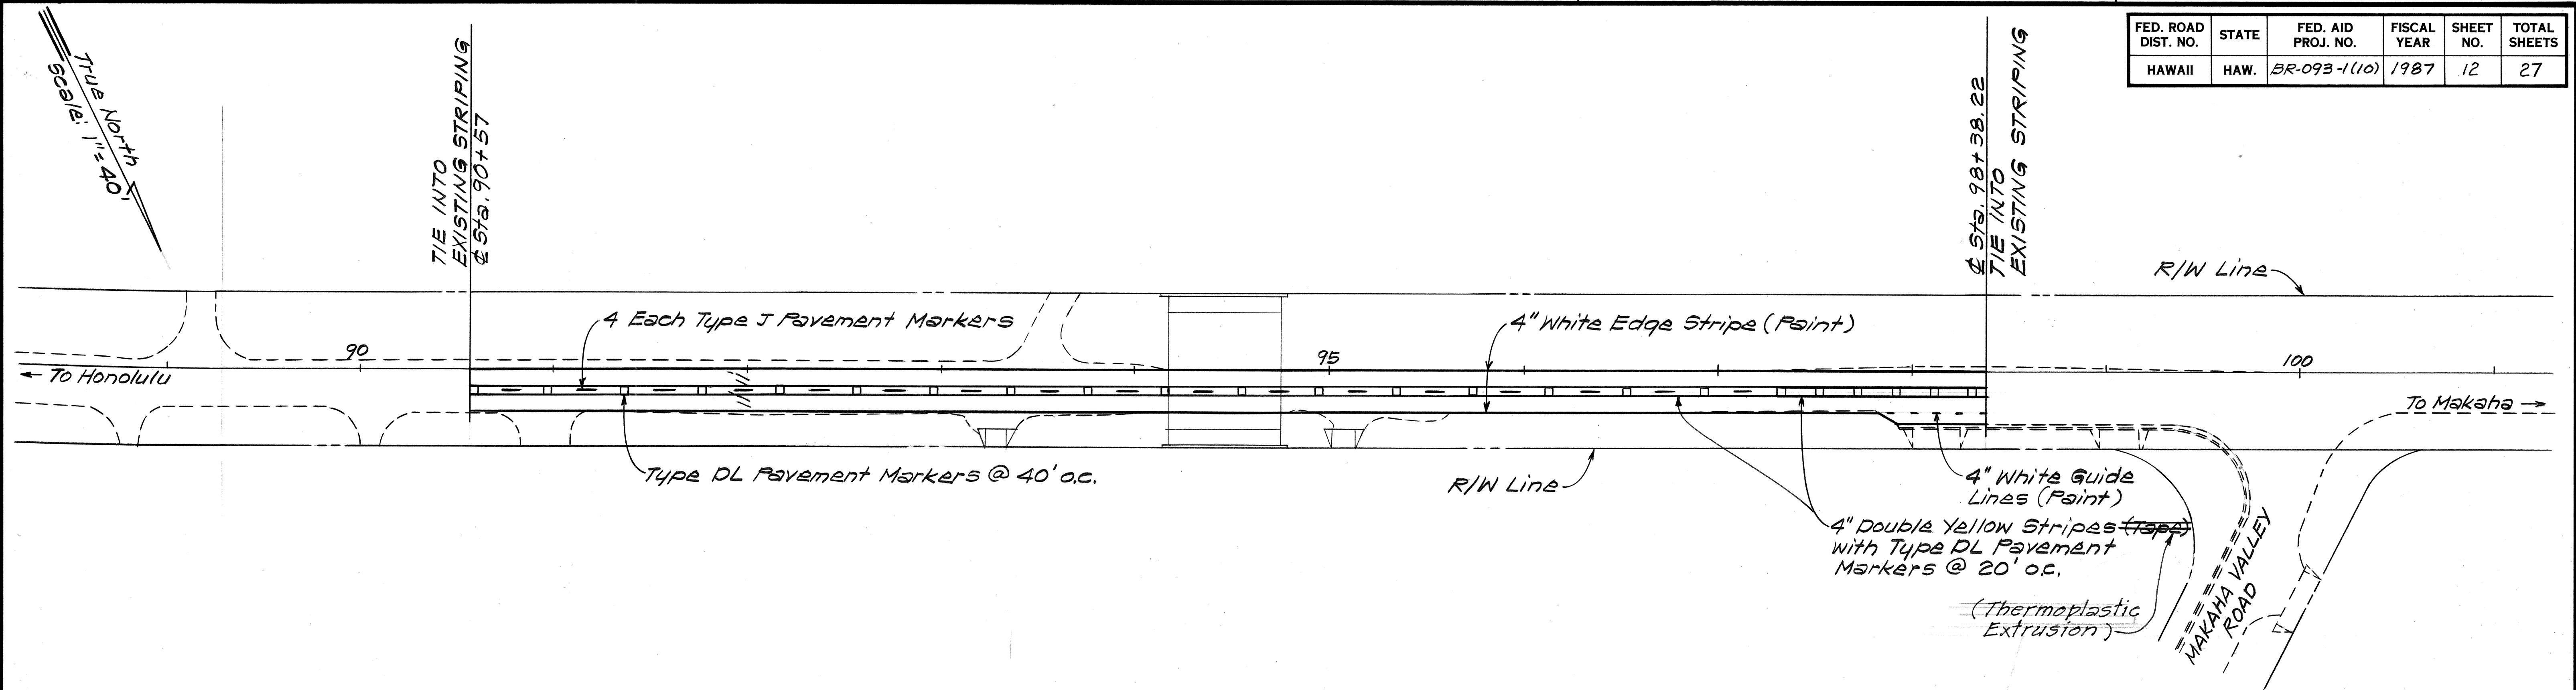

NOTES

1. Location of all new pavement markings shall be staked out by the Contractor for approval by the Engineer prior to installation.
2. Existing pavement markings not incorporated in the final traffic pattern shall be removed as directed by the Engineer. Costs shall be incidental to the various contract items.
3. Removal of existing signs as directed by the Engineer, shall be incidental to the various contract items.
4. Details of Type D Marker on Standard Plan Nos. TE-30 and TE-31 shall be deleted and replaced with detail of Type DL Marker as shown on this sheet. All references to Type D Markers in the plans shall mean Type DL Markers.

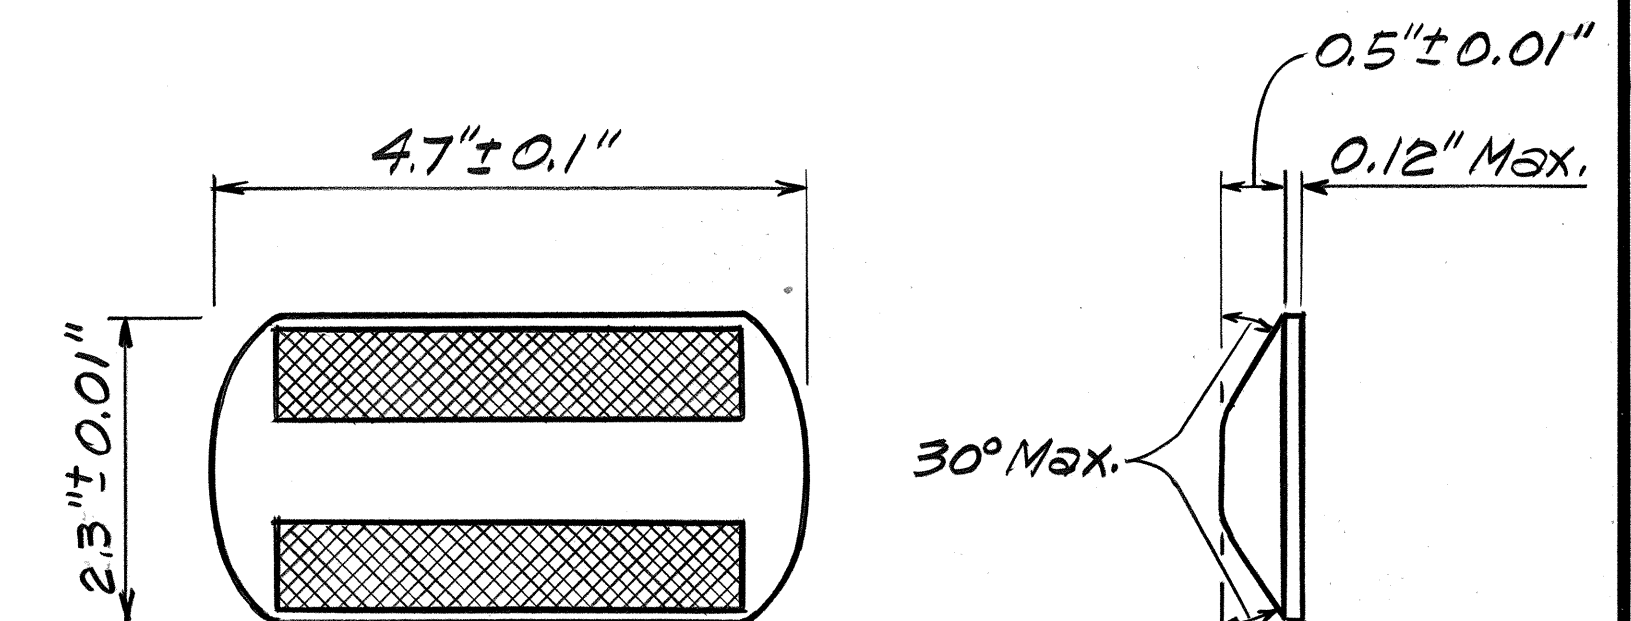

TYPE DL
Two-Way Yellow Reflective Marker
Not to Scale

STATE OF HAWAII DEPARTMENT OF TRANSPORTATION HIGHWAYS DIVISION	
<u>PAVEMENT STRIPING & MARKING PLAN, NOTES AND DETAIL</u>	
FARRINGTON HIGHWAY FED. AID PROJ. NO. BR-093-1(10)	
Scale: As Shown	Date: Apr., 1987
SHEET No. 1 OF 1 SHEETS	

ORIGINAL PLAN	DATE
DESIGNED BY	
TRACED BY	
NOTED BY	
CHECKED BY	
NO.	