


FED. ROAD DIST. NO.	STATE	FED. AID PROJ. NO.	FISCAL YEAR	SHEET NO.	TOTAL SHEETS
HAWAII	HAW.	BR-093-1(10)	1987	9	27

NOTES


1. The Contractor shall clear and remove debris and vegetation, including overhanging tree branches, a distance of 2 feet on either side of and 10 feet above the location of the bituminous sidewalk, prior to opening the sidewalk to pedestrians.
2. Upon completion of the permanent sidewalk, the 4' wide bituminous sidewalk shall be scarified and removed. The corrugated metal pipes shall be removed and the stream shall be restored as close as possible to its original condition.

ESTIMATED QUANTITIES FOR TEMPORARY PEDESTRIAN WALKWAY (LUMP SUM SPECIAL PROVISIONS ITEM NO. 650.1000)


Roadway Excavation	52	Cu. Yds.
Imported Borrow	45	Cu. Yds.
State Furnished 30" Corrugated Metal Pipe	210	Lin. Ft.
Bituminous Sidewalk	5	Tons
Bed Course Material for Sidewalk	9	Cu. Yds.

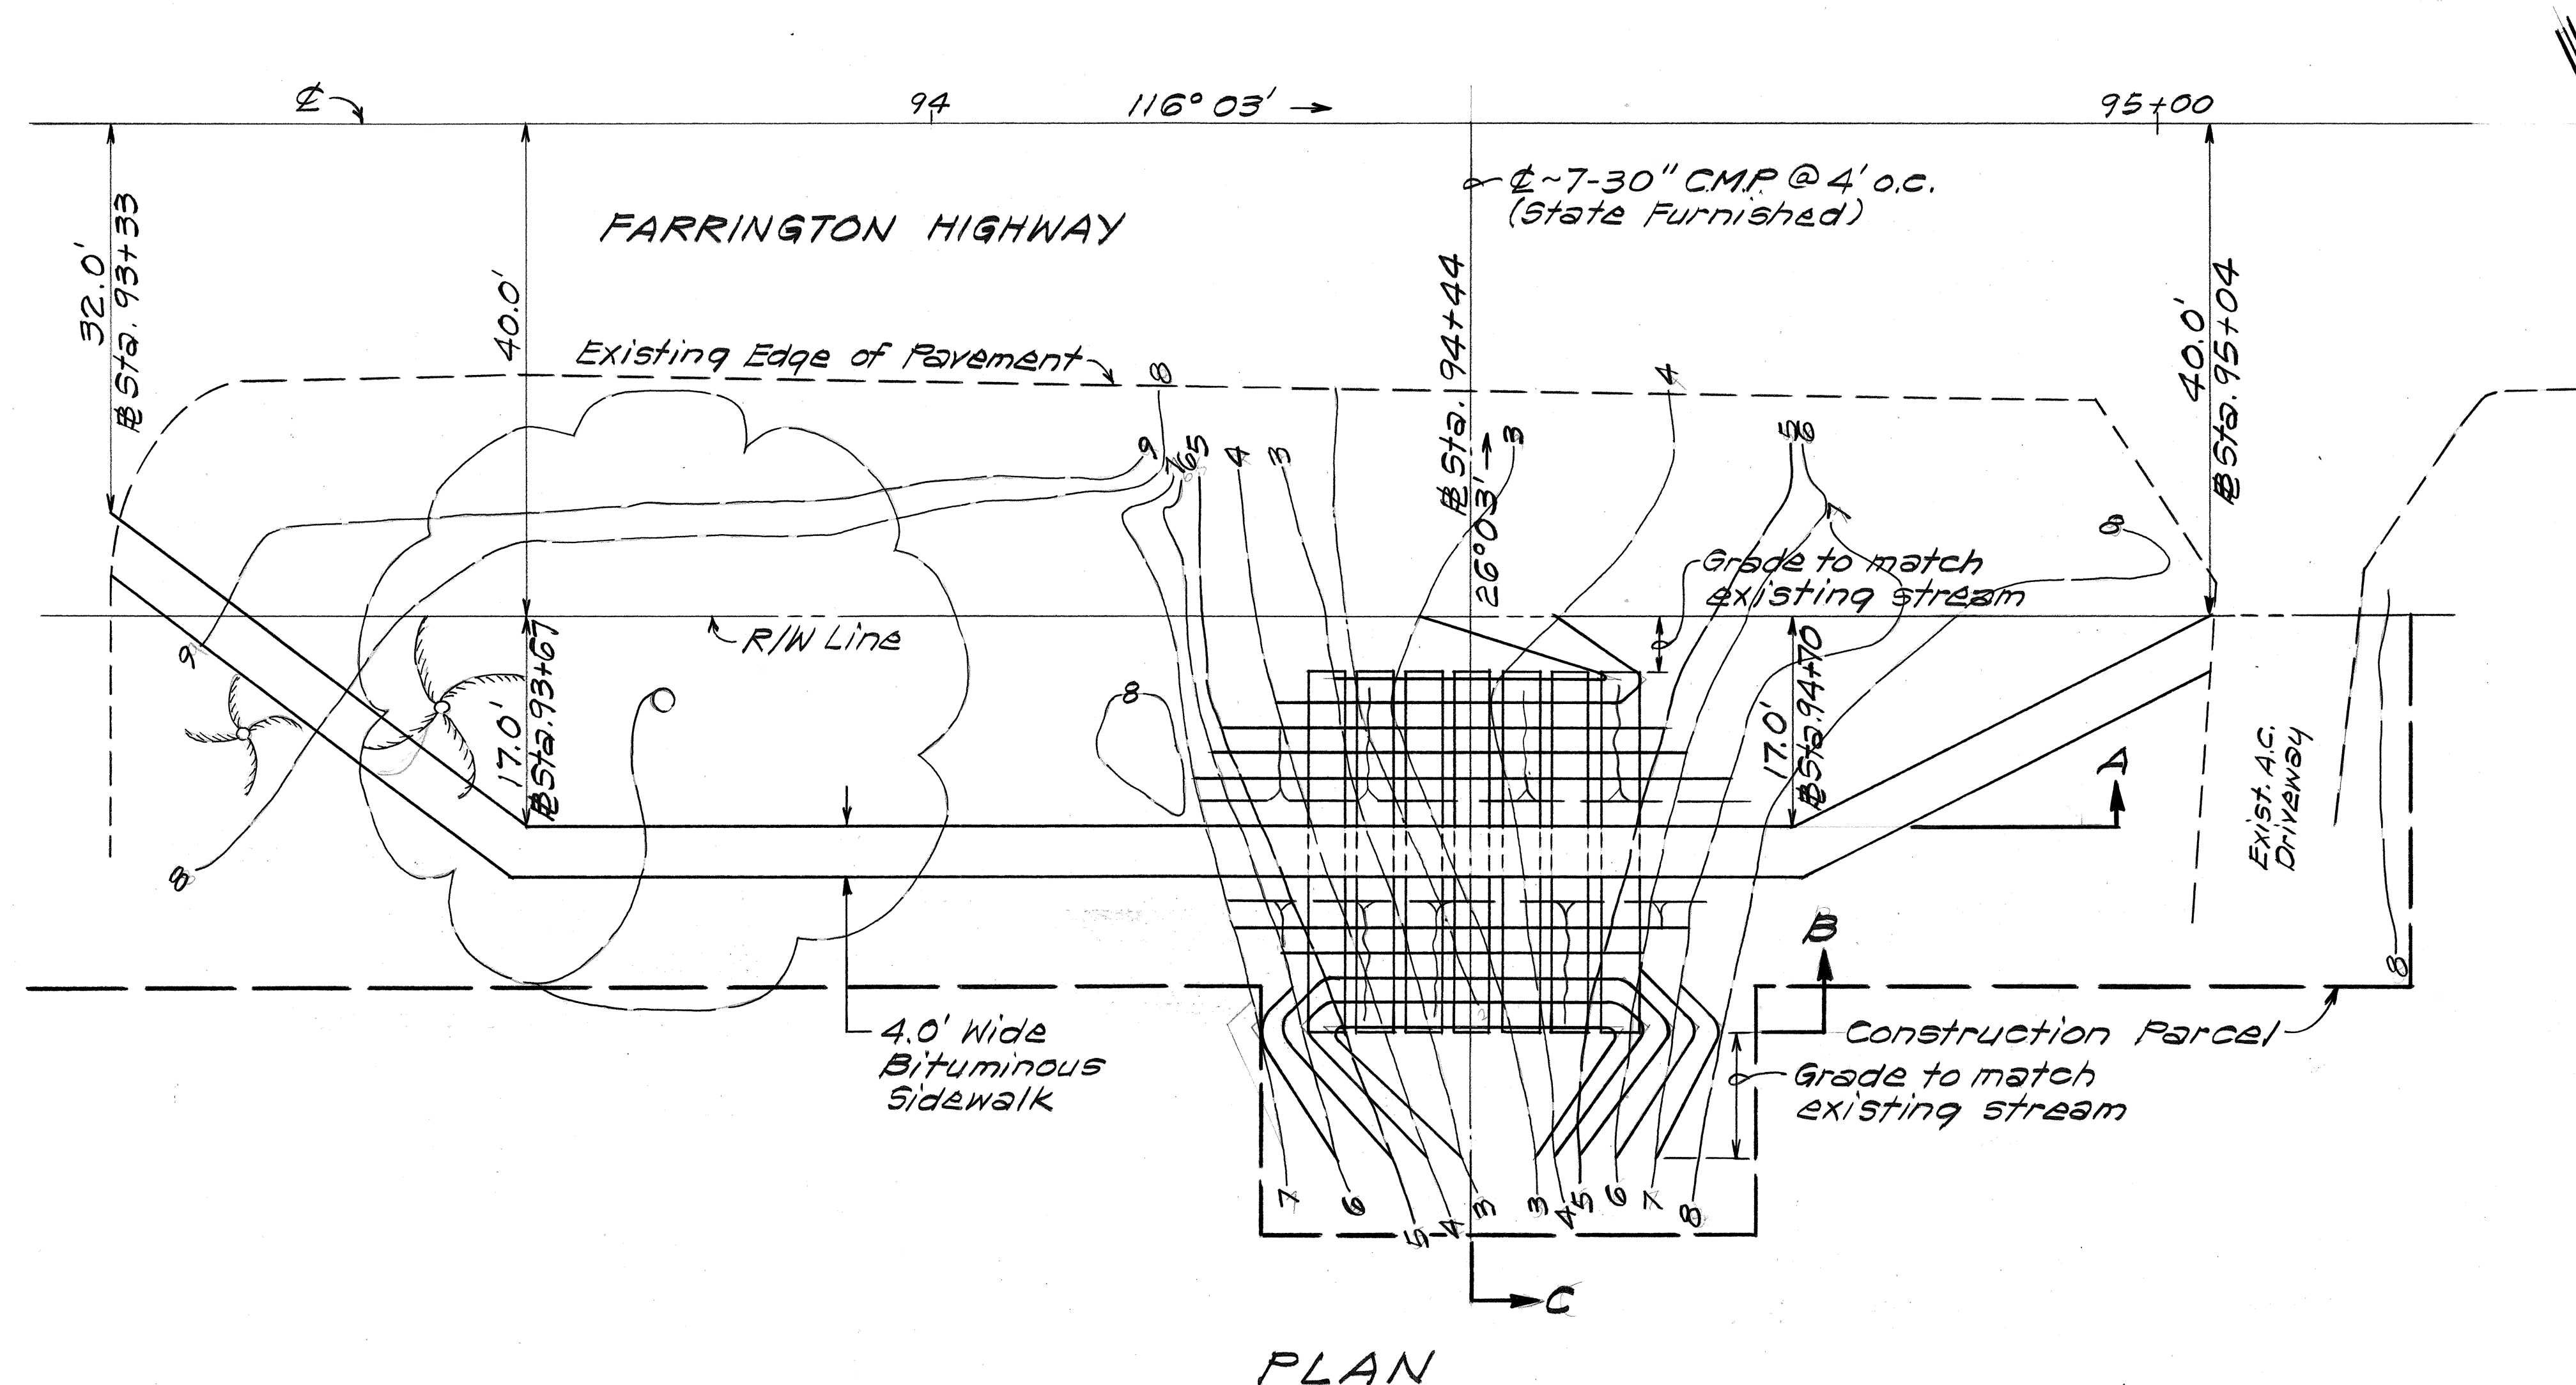


PLAN

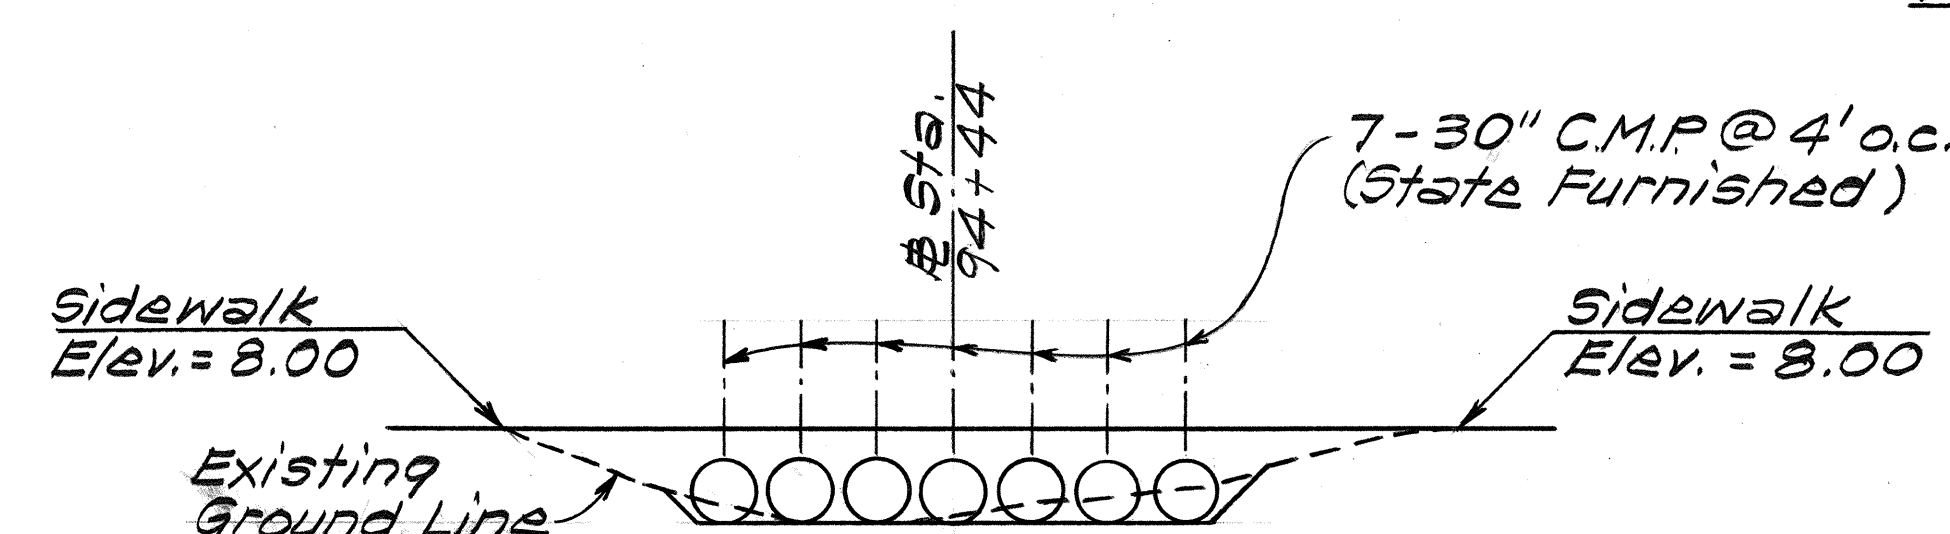


SECTION A
Scale: 1"=10'

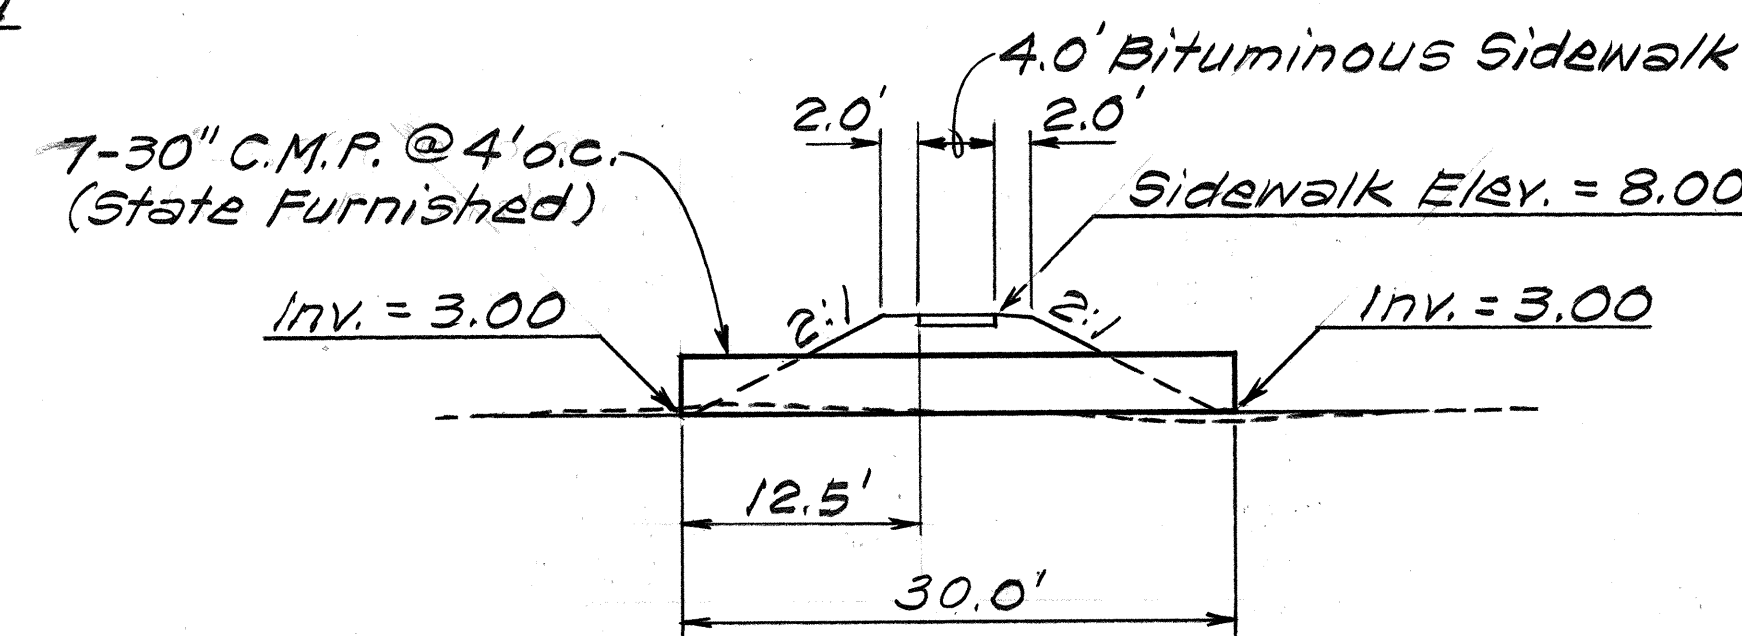


SECTION C
Scale: 1"=10'

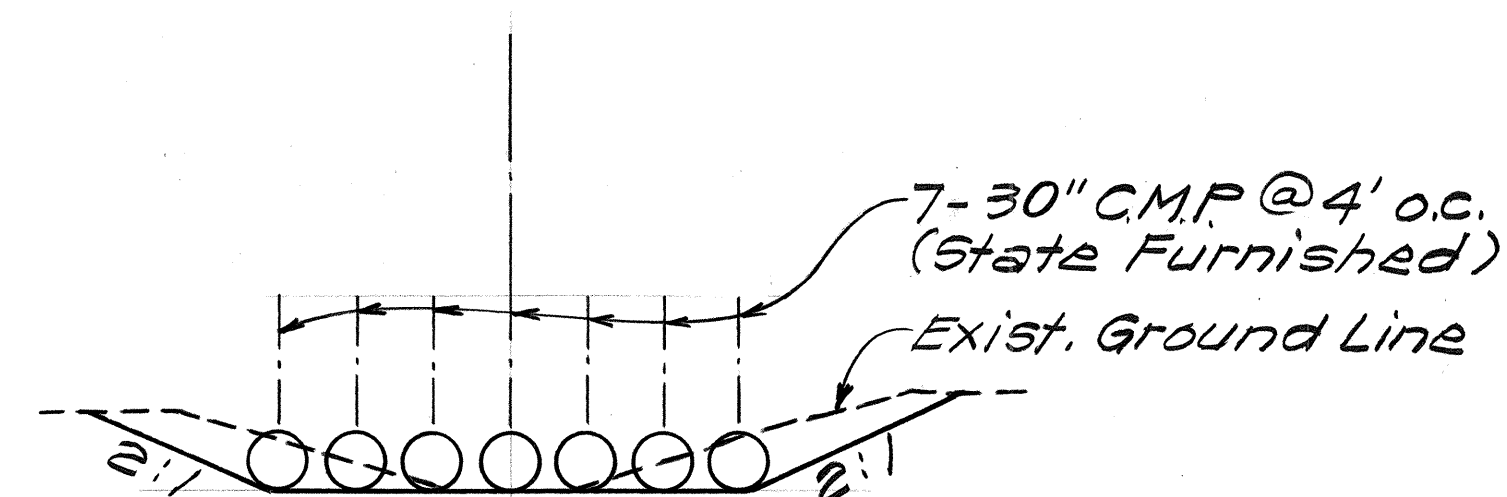

SECTION B
Scale: 1"=10'

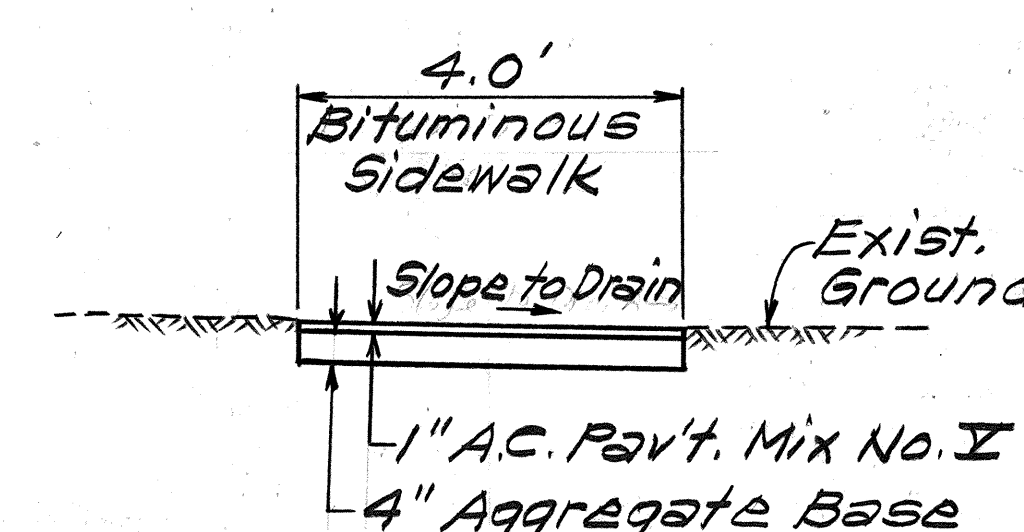

TYPICAL SECTION
BITUMINOUS SIDEWALK
Scale: 1/2"=1'-0"

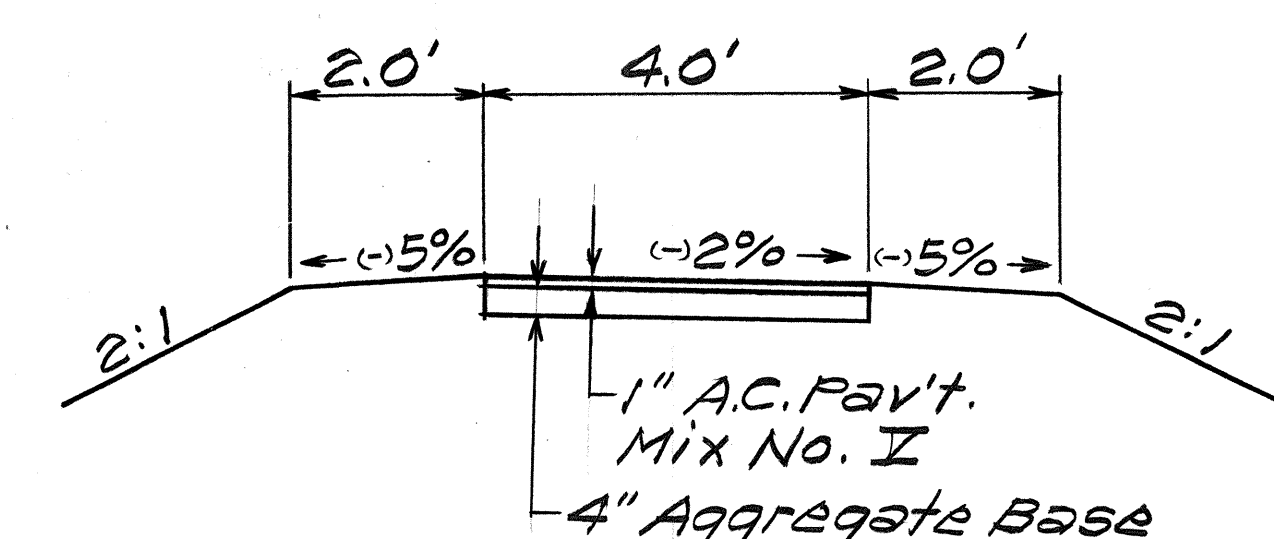

BITUMINOUS SIDEWALK
SECTION OVER C.M.P.s
Scale: 1/2"=1'-0"

STATE OF HAWAII
DEPARTMENT OF TRANSPORTATION
HIGHWAYS DIVISION
**TEMPORARY PEDESTRIAN
WALKWAY**
FARRINGTON HIGHWAY
FED. AID PROJ. NO. BR-093-1(10)
Scale: As Noted Date: March, 1987
SHEET No. 1 OF 1 SHEETS