	INDEX TO DRAWINGS	
SHEET NO.	DESCRIPTION	
	TITLE SHEET	
2	STANDARD PLANS SUMMARY	
3	TYPICAL SECTIONS	
4	PLAN & PROFILE	
5-6	MISCELLANEOUS DETAILS	
7-8	CONSTRUCTION PHASING AND DETOUR PLANS	
9	TEMPORARY PEDESTRIAN WALKWAY	
10-11	UTILITY PLANS & DETAILS	
12	PAVEMENT STRIPING & MARKING PLAN, NOTES & DETAIL	
13-25	MAKAHA BRIDGE NO. 2 PLAN & DETAILS AND RETAINING WALL PLANS & DETAILS	
26-27	CROSS SECTIONS	
Account of the second of the s		


STATE OF HAWAII


DEPARTMENT OF TRANSPORTATION
HIGHWAYS DIVISION
HONOLULU, HAWAII
"AS-BUILT"

PLANS FOR

FARRINGTON HIGHWAY
REPLACEMENT OF MAKAHA BRIDGE NO. 2
FEDERAL AID PROJECT NO. BR-093-1(10)

DISTRICT OF WAIANAE
ISLAND OF OAHU

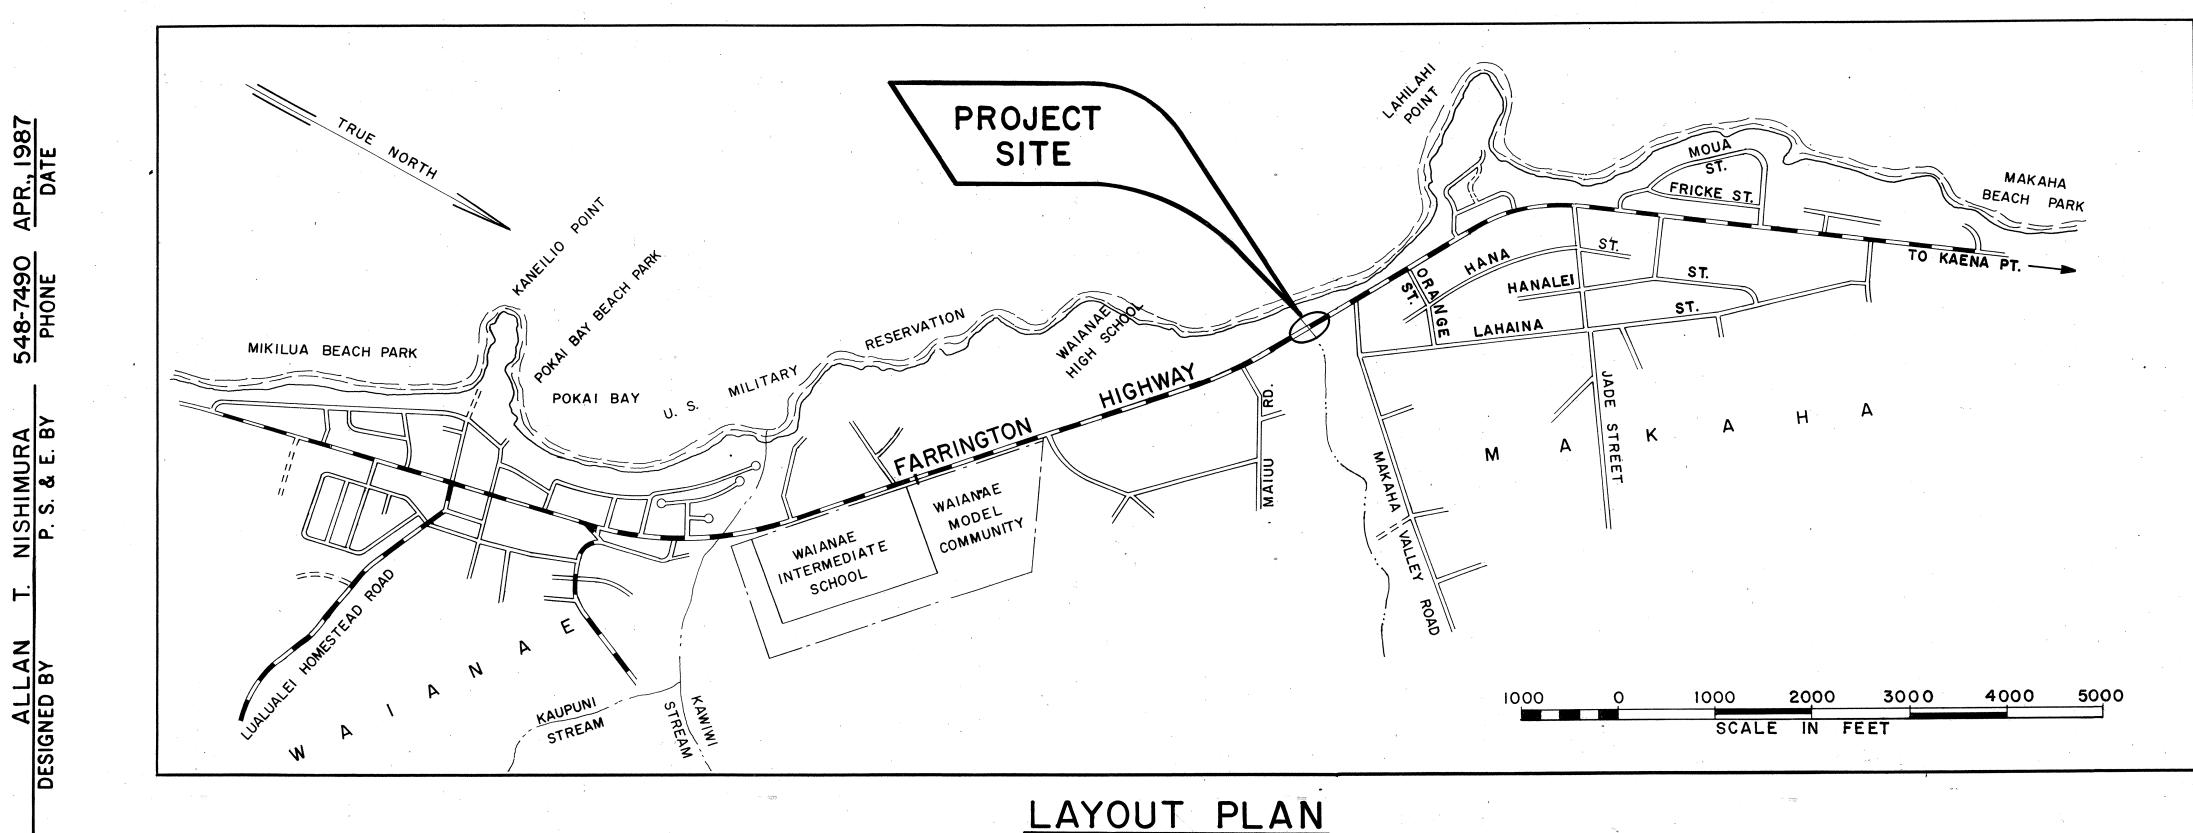

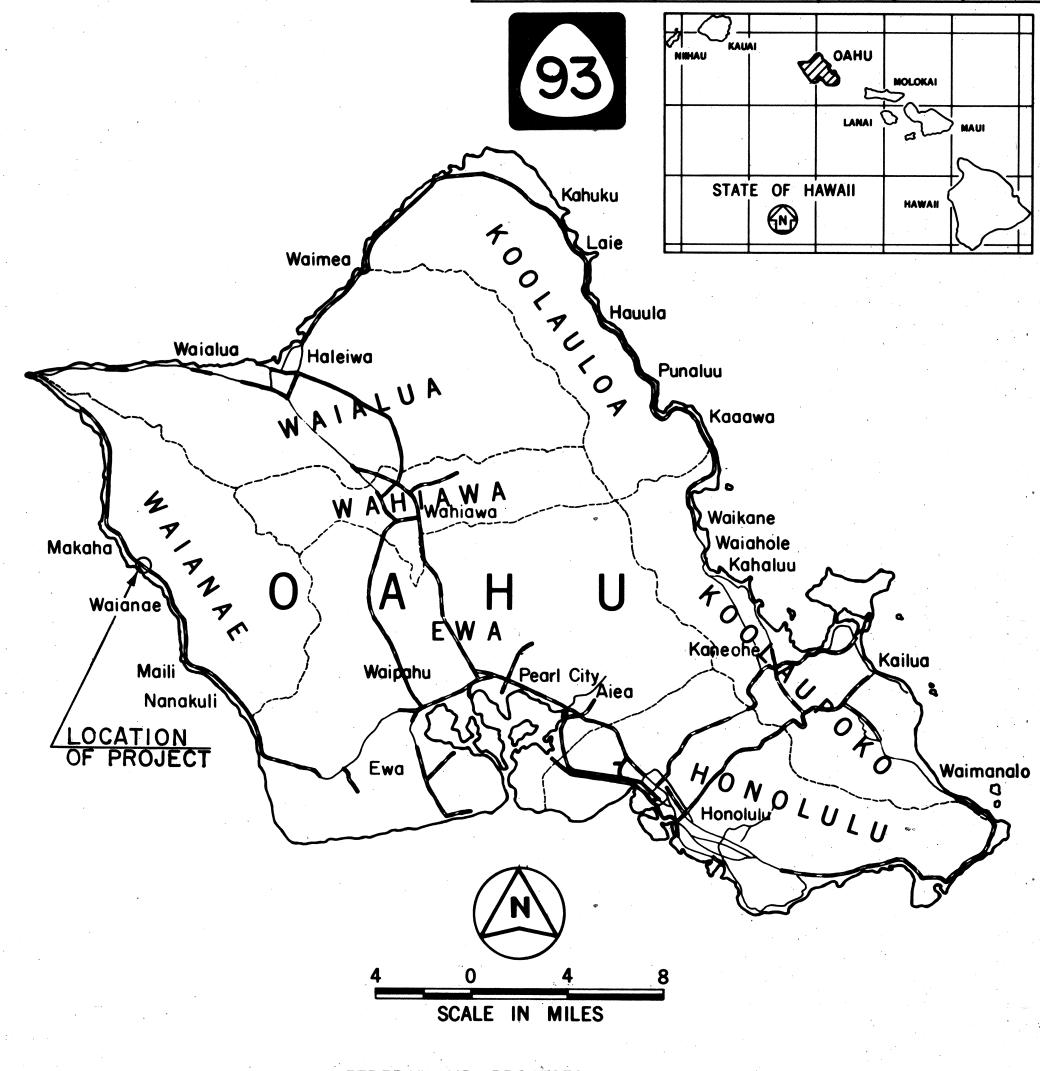

FED. ROAD DIST. NO. FED. AID PROJ. NO.

HAW. BR-093-1(10) 1987

FISCAL YEAR

FEDERAL AID PROJECTS PREVIOUSLY CONSTRUCTED
OR UNDER CONSTRUCTION

DESIGN DESIGNATION

ADT (1987)	, 17, 600
DESIGN ADT (2007)	24,500
DHV	4
D	55/45
T24	4.0%
V	35 MPH

CHANGES MADE DURING CONSTRUCTION HAVE BEEN INCORPORATED ON THESE PLANS EXCEPT CHANGES IN THE ORIGINAL THEORETICAL QUANTITIES. FOR ACTUAL QUANTITIES, REFER TO PROJECT LEDGER AND/OR COMPUTATION BOOK.

Michael Duriga RESIDENT ENGINEER

5/2/9/ DATE

DEPARTMENT OF TRANSPORTATION FEDERAL HIGHWAY ADMINISTRATION APPROVED:

5/zz/87 DATE FOR

DEPARTMENT OF TRANSPORTATION
STATE OF HAWAII

APPROVED:

DIR. OF TRANSPORTATION

DATE