1	INDEX TO DRAWINGS									
SHEET NO.	DESCRIPTION									
1	TITLE SHEET									
2	STANDARD PLANS SUMMARY									
3	LEGEND AND NOTES									
4	TYPICAL PAVEMENT SECTIONS									
5	GEOMETRICS AND STRIPING PLAN KAUKAMANA STREET									
6	GEOMETRICS AND STRIPING PLAN ST. JOHN'S ROAD									
7	TRAFFIC SIGNAL PLAN KAUKAMANA STREET									
8	TRAFFIC SIGNAL PLAN ST. JOHN'S ROAD									
9-10	CROSS SECTIONS									

					Majori.					
C	Λ	T		0		Λ	11			
\mathbf{C}	H	1		U			V	ľ	7	

DEPARTMENT OF TRANSPORTATION HIGHWAYS DIVISION


HONOLULU, HAWAII


"AS-BUILT"

PLANS FOR

FARRINGTON HIGHWAY, TRAFFIC SIGNALS
AT KAUKAMANA STREET
AND AT ST. JOHN'S ROAD
PROJECT NO. 93A-01-88

DISTRICT OF WAIANAE
ISLAND OF OAHU

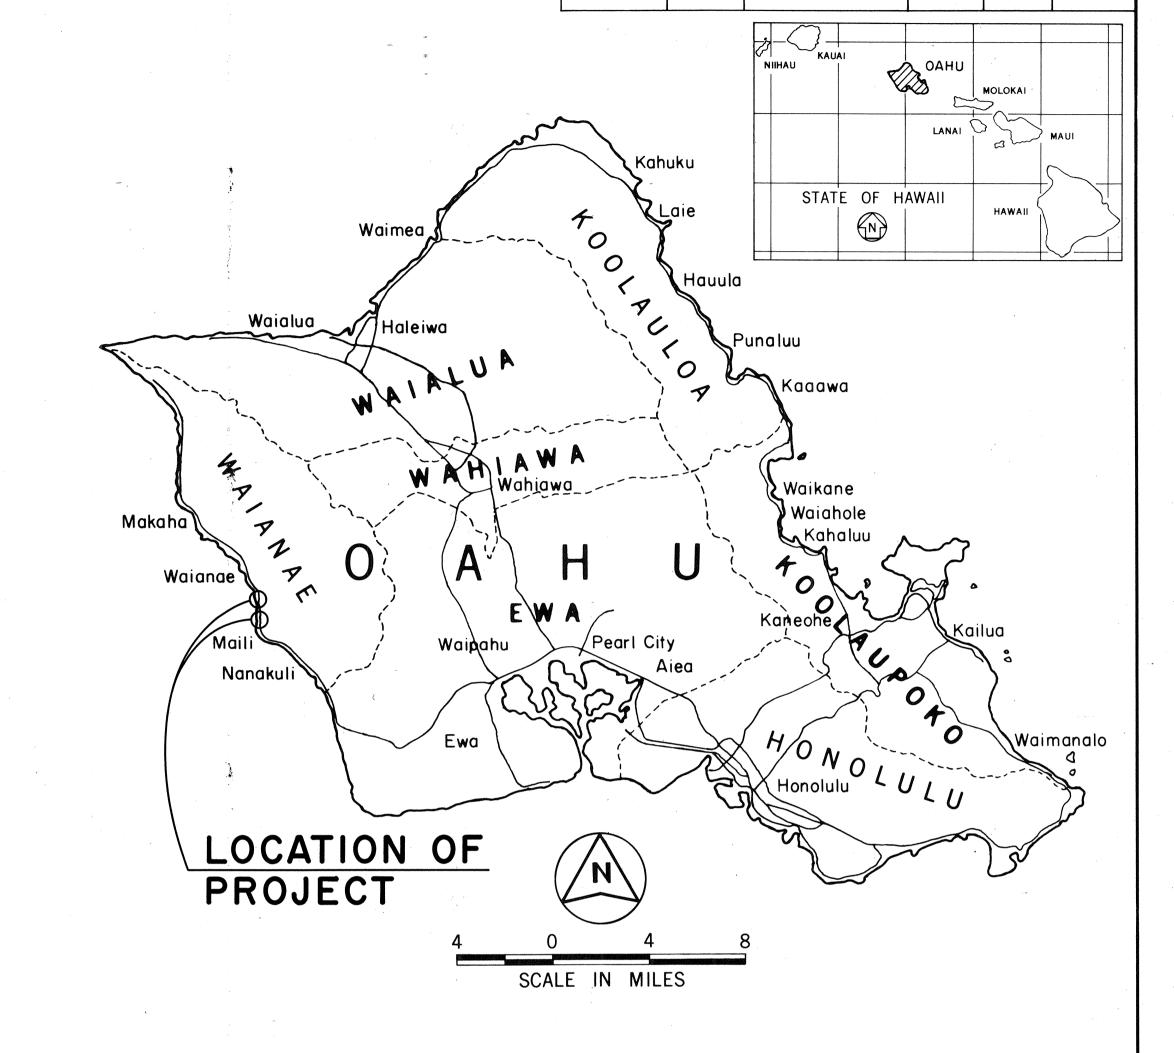

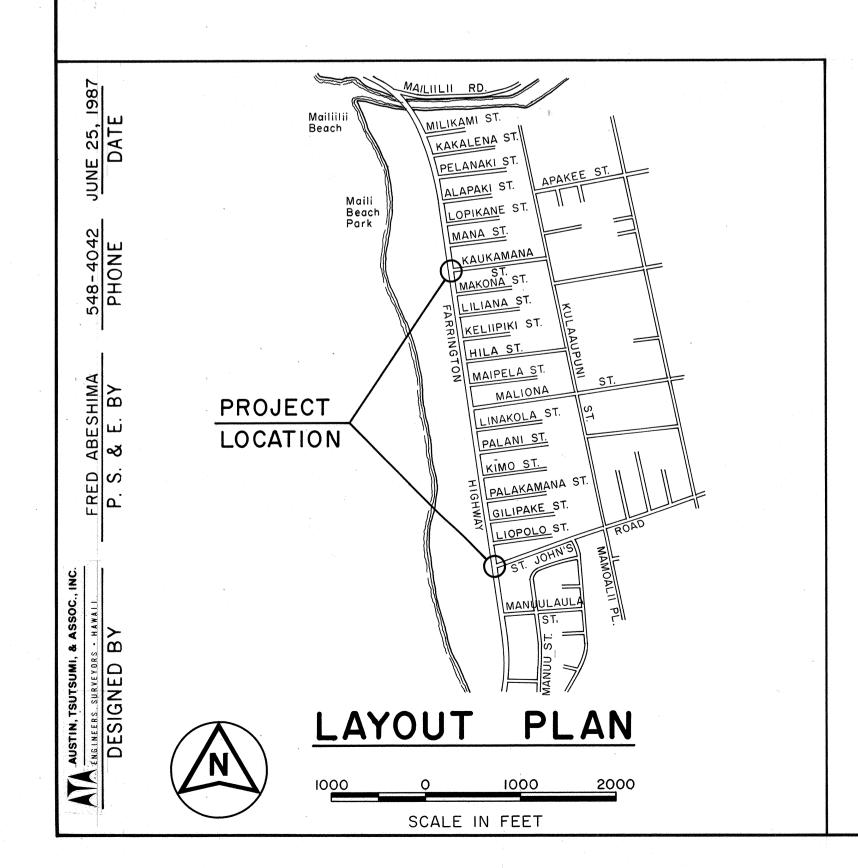

CHANGES MADE DURING CONSTRUCTION HAVE BEEN INCORPORATED ON THESE PLANS EXCEPT CHANGES IN THE ORIGINAL THEORETICAL QUANTITIES. FOR ACTUAL QUANTITIES, REFER TO PROJECT LEDGER AND/OR COMPUTATION BOOK.

Kelvin akazawa FOR RESIDENT ENGINEER

DATE

DEPARTMENT OF TRANSPORTATION STATE OF HAWAII

APPROVED

DIR. OF TRANSPORTATION

DATE

FISCAL SHEET TOTAL YEAR NO. SHEETS

PROJ. NO.

93A - 01 - 88