


FED. ROAD DIST. NO.	STATE	PROJ. NO.	FISCAL YEAR	SHEET NO.	TOTAL SHEETS
HAWAII	HAW.	93A-01-91M	1991	3	4

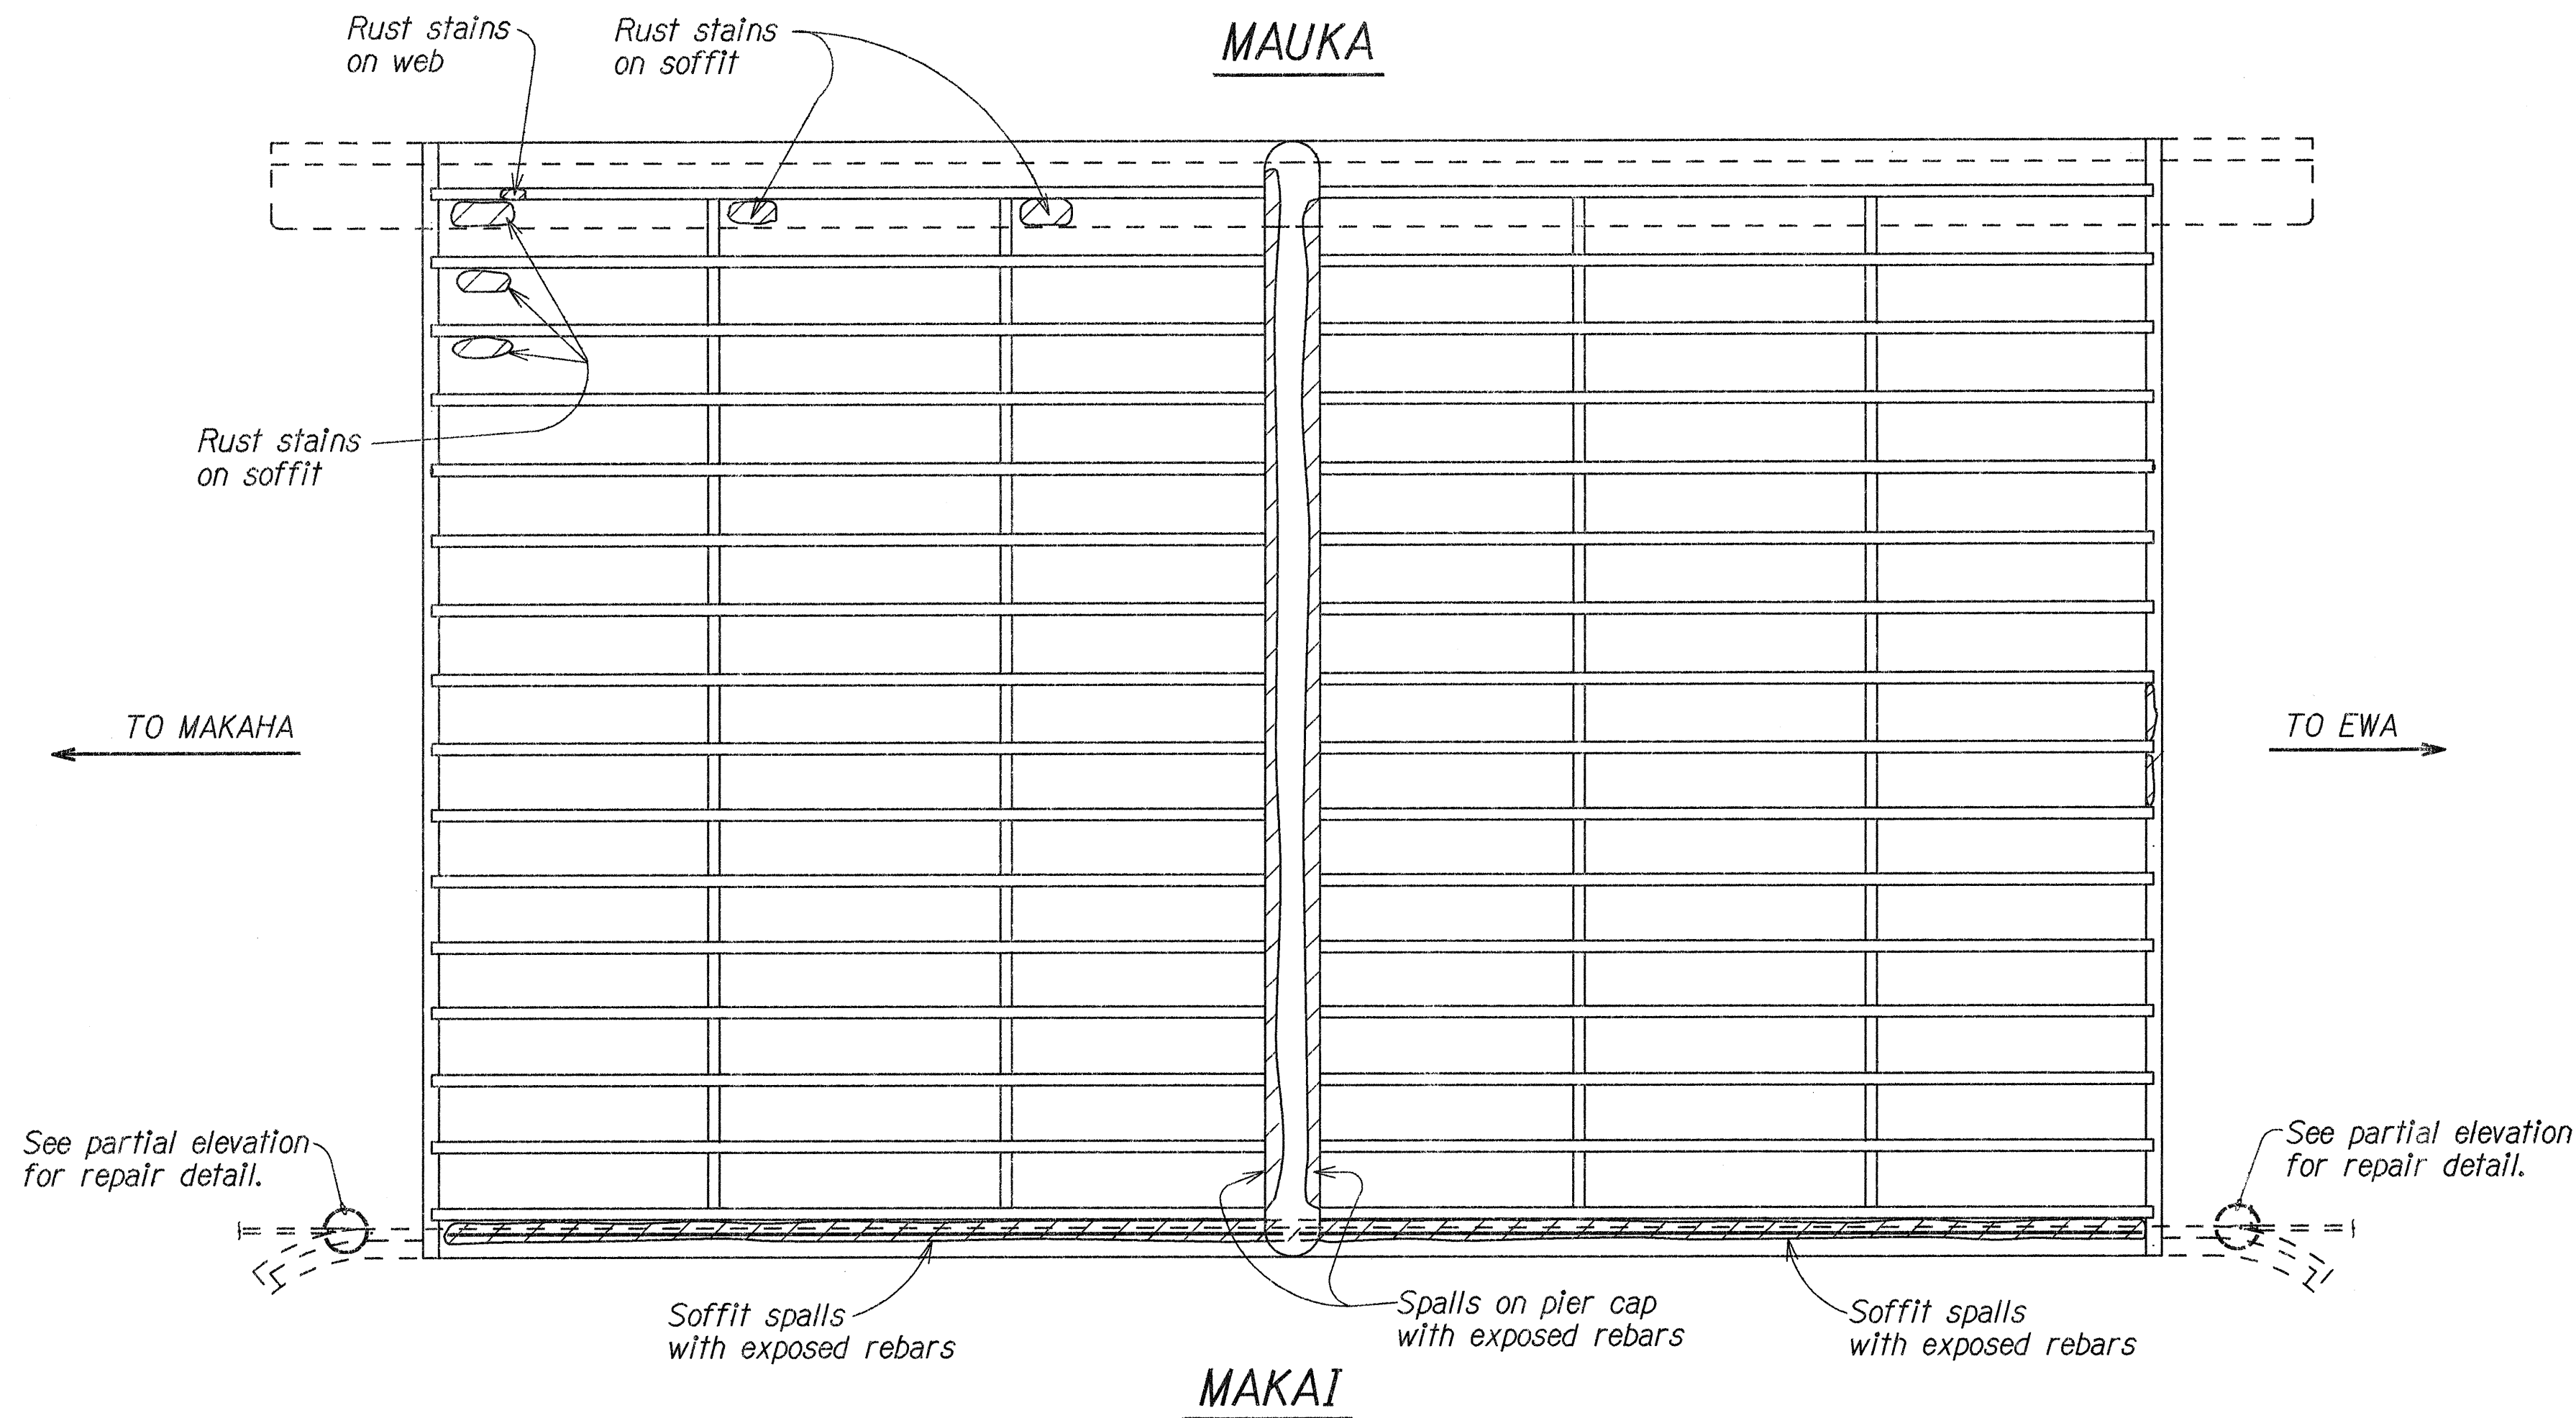


NOTE:
1. Spall locations are for illustration purposes only. Actual locations are to be determined by the Engineer in the field.

REFLECTED CEILING PLAN


Scale: 1/8"=1'-0"

ESTIMATED QUANTITIES			
ITEM NO.	ITEM	UNIT	QUANTITY
676.1000	Repair of Spalls	S.F.	1,000 S.F. ← 1246 S.F.
677.1000	Sealing Cracks	L.F.	200 L.F.

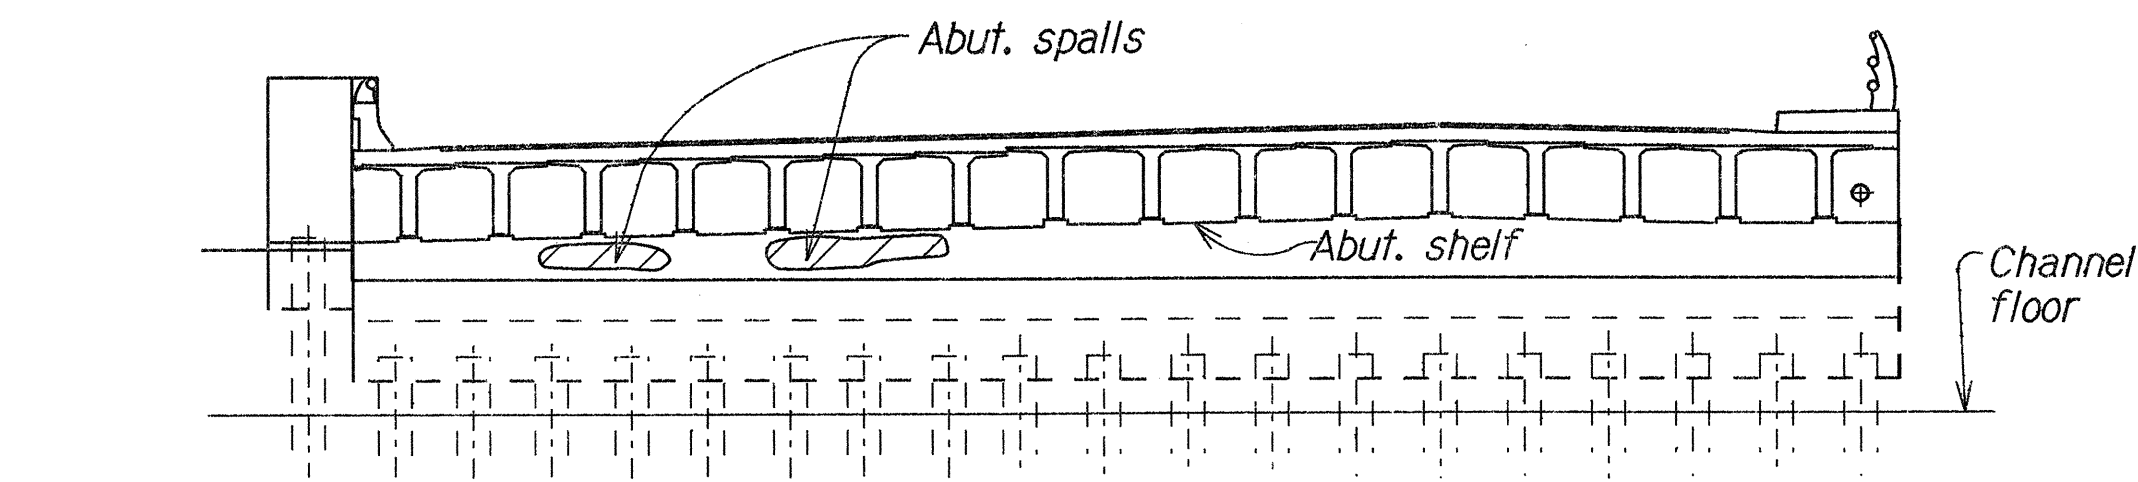


ABUTMENT NO. 1 ELEVATION

Scale: 1/8"=1'-0"

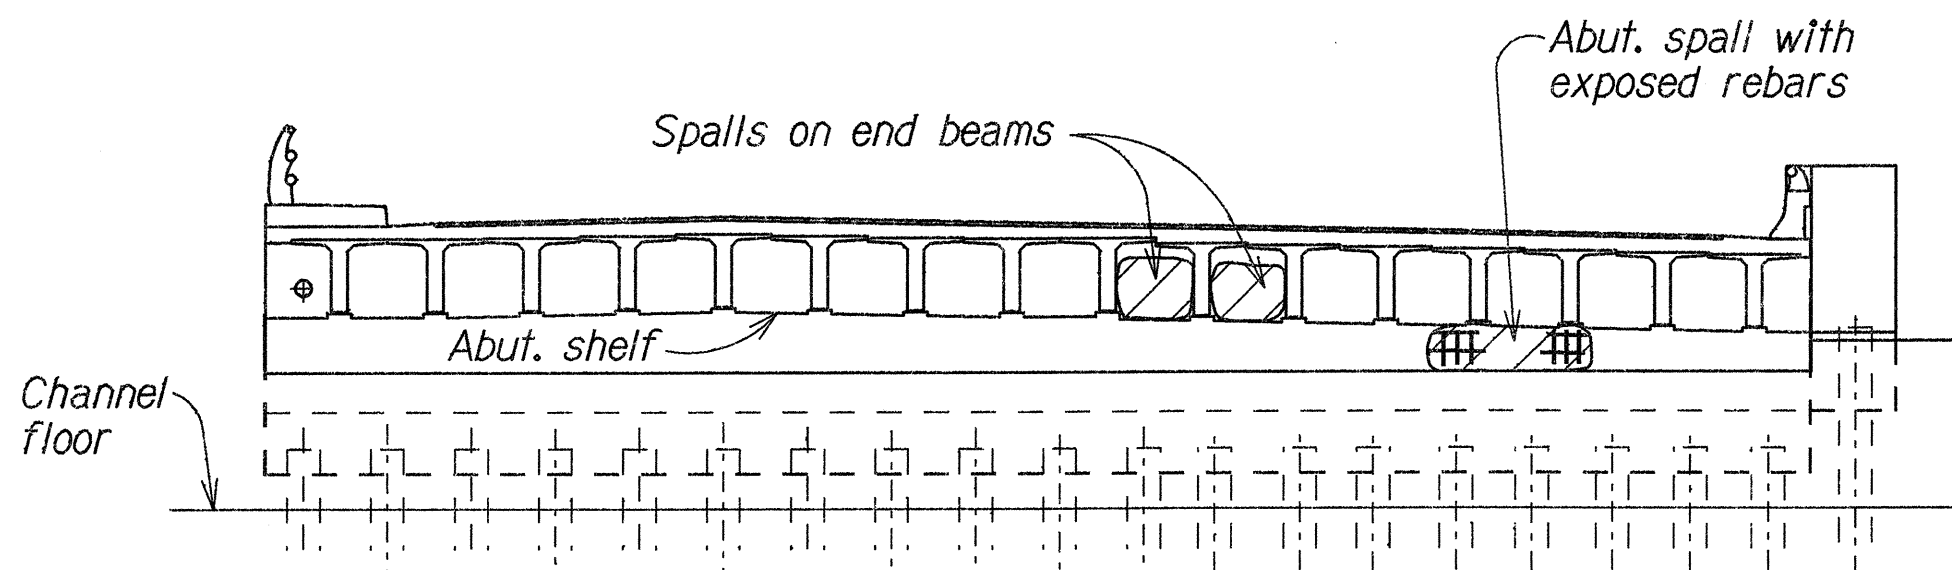

ABUTMENT NO. 2 ELEVATION


Scale: 1/8"=1'-0"

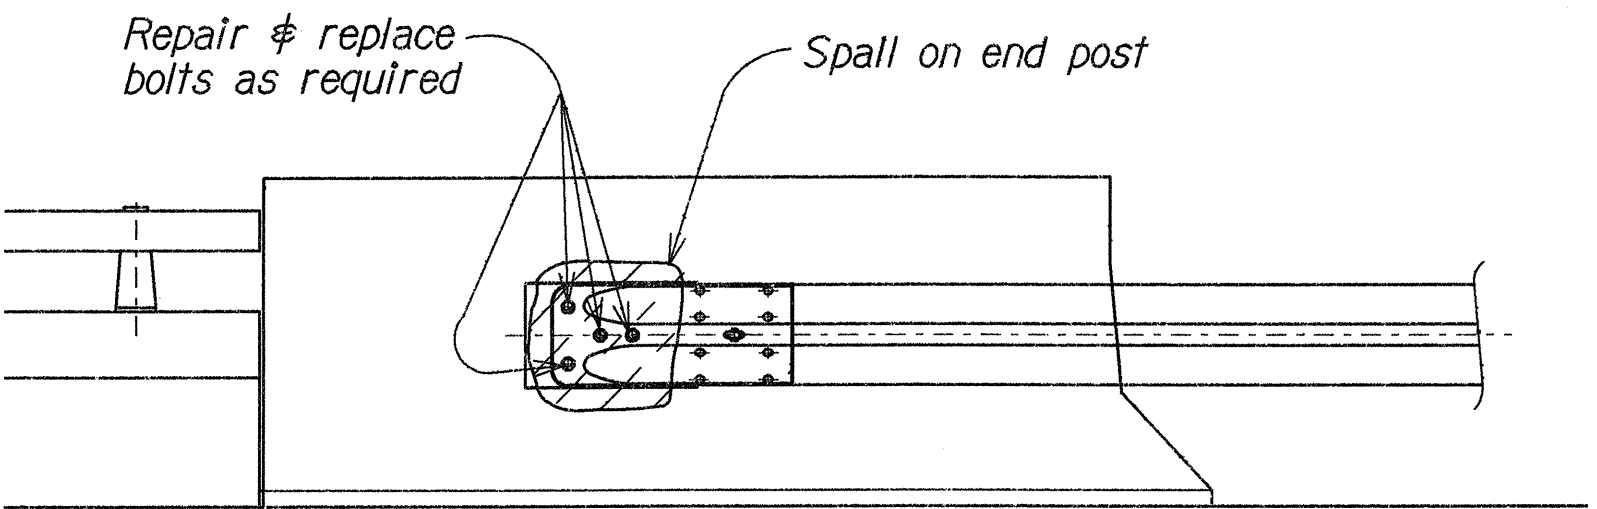

PARTIAL END POST ELEVATION - ABUT. NO. 1

(OPPOSITE END SIMILAR)

Scale: 1/2"=1'-0"

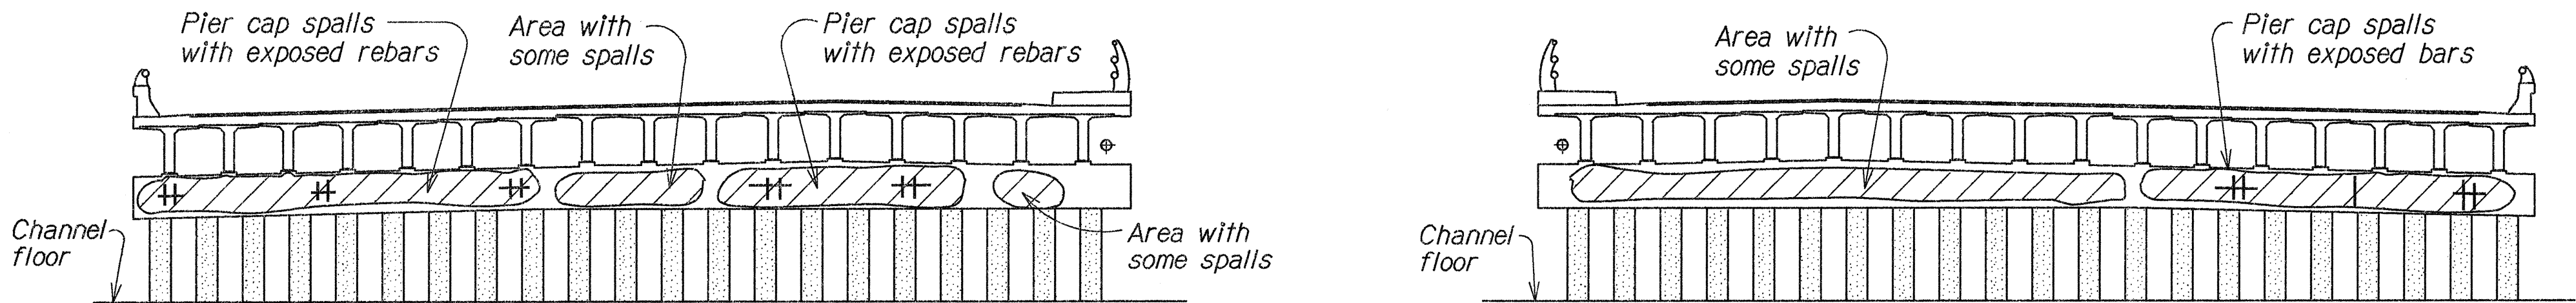

NORTH SIDE (MAKAHA)

SOUTH SIDE (EWA)

PIER ELEVATION

Scale: 1/8"=1'-0"

DESIGNED BY	DATE
DRAWN BY	JUL 1990
CHECKED BY	JUL 1990
NOTED BY	JUL 1990
QUANTITIES BY	JUL 1990
REVISIONS	
NO.	REMARKS

STATE OF HAWAII
DEPARTMENT OF TRANSPORTATION
HIGHWAYS DIVISION

MAIPALAOA BRIDGE REPAIR
REPAIRS AND MODIFICATIONS
FARRINGTON HIGHWAY
Proj. No. 93A-01-91M
Scale: As Noted
July 1990

SHEET No. 1 OF 2 SHEETS