

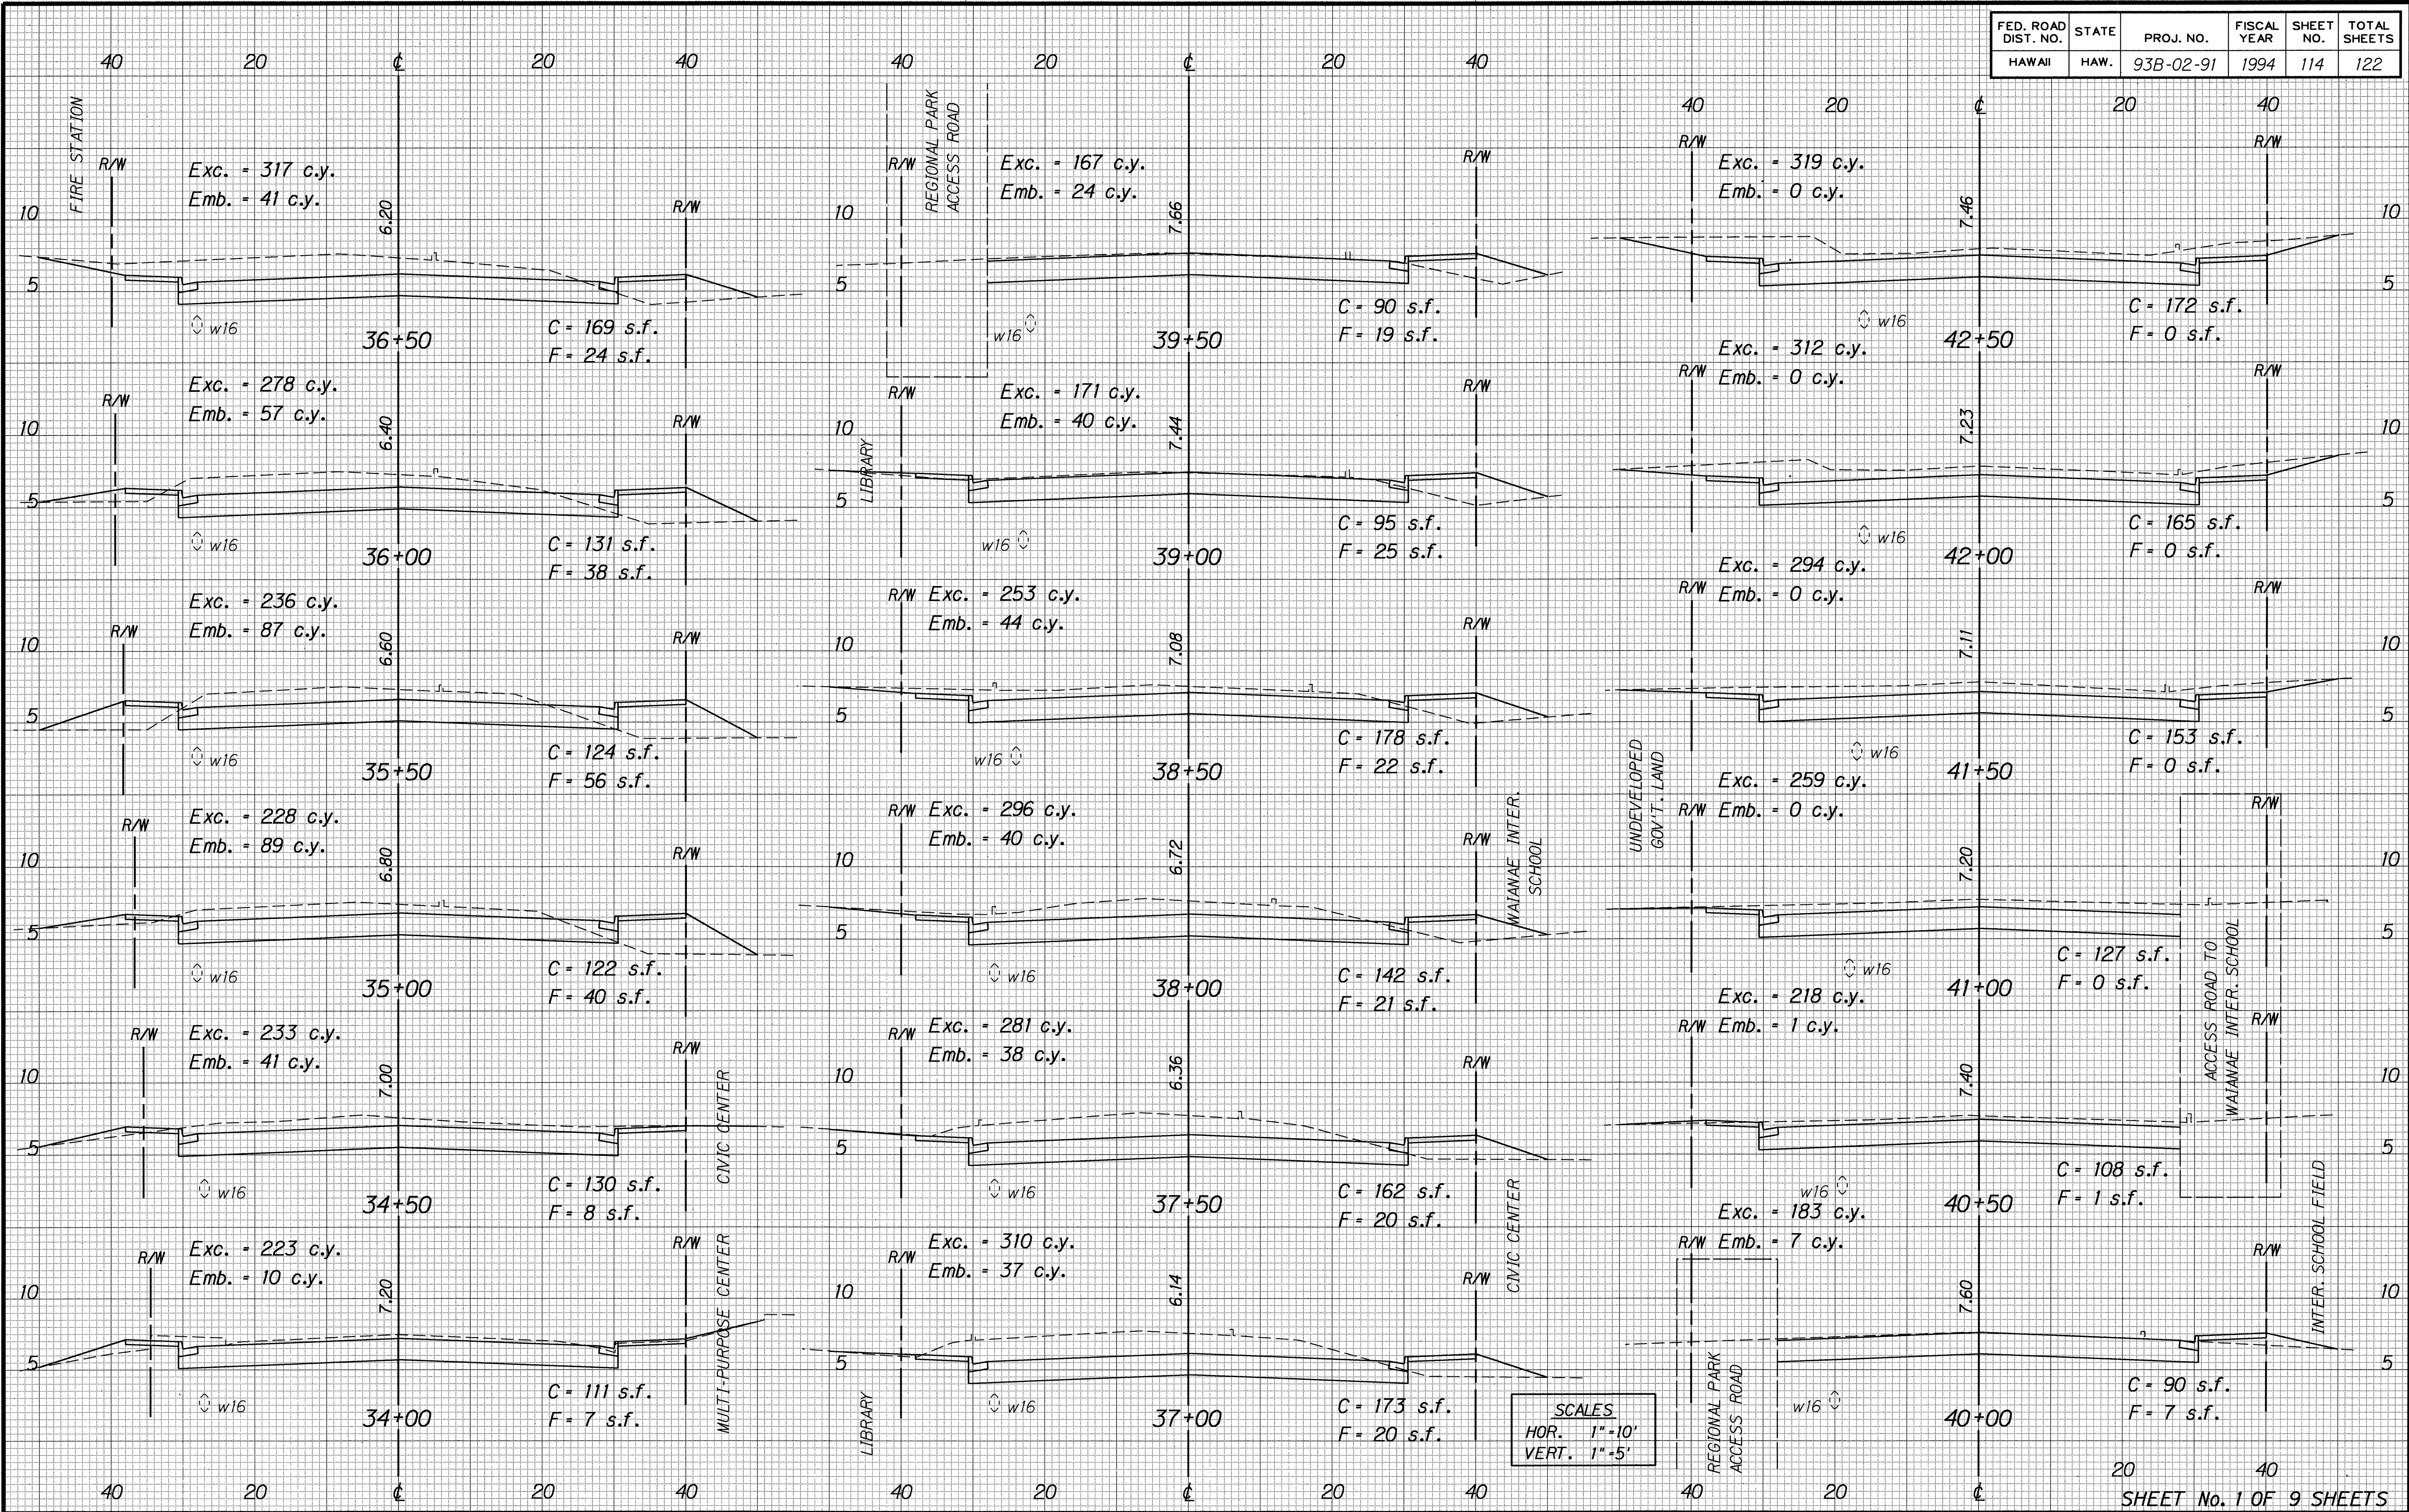


FED. ROAD DIST. NO.	STATE	PROJ. NO.	FISCAL YEAR	SHEET NO.	TOTAL SHEETS
HAWAII	HAW.	93B-02-91	1994	114	122

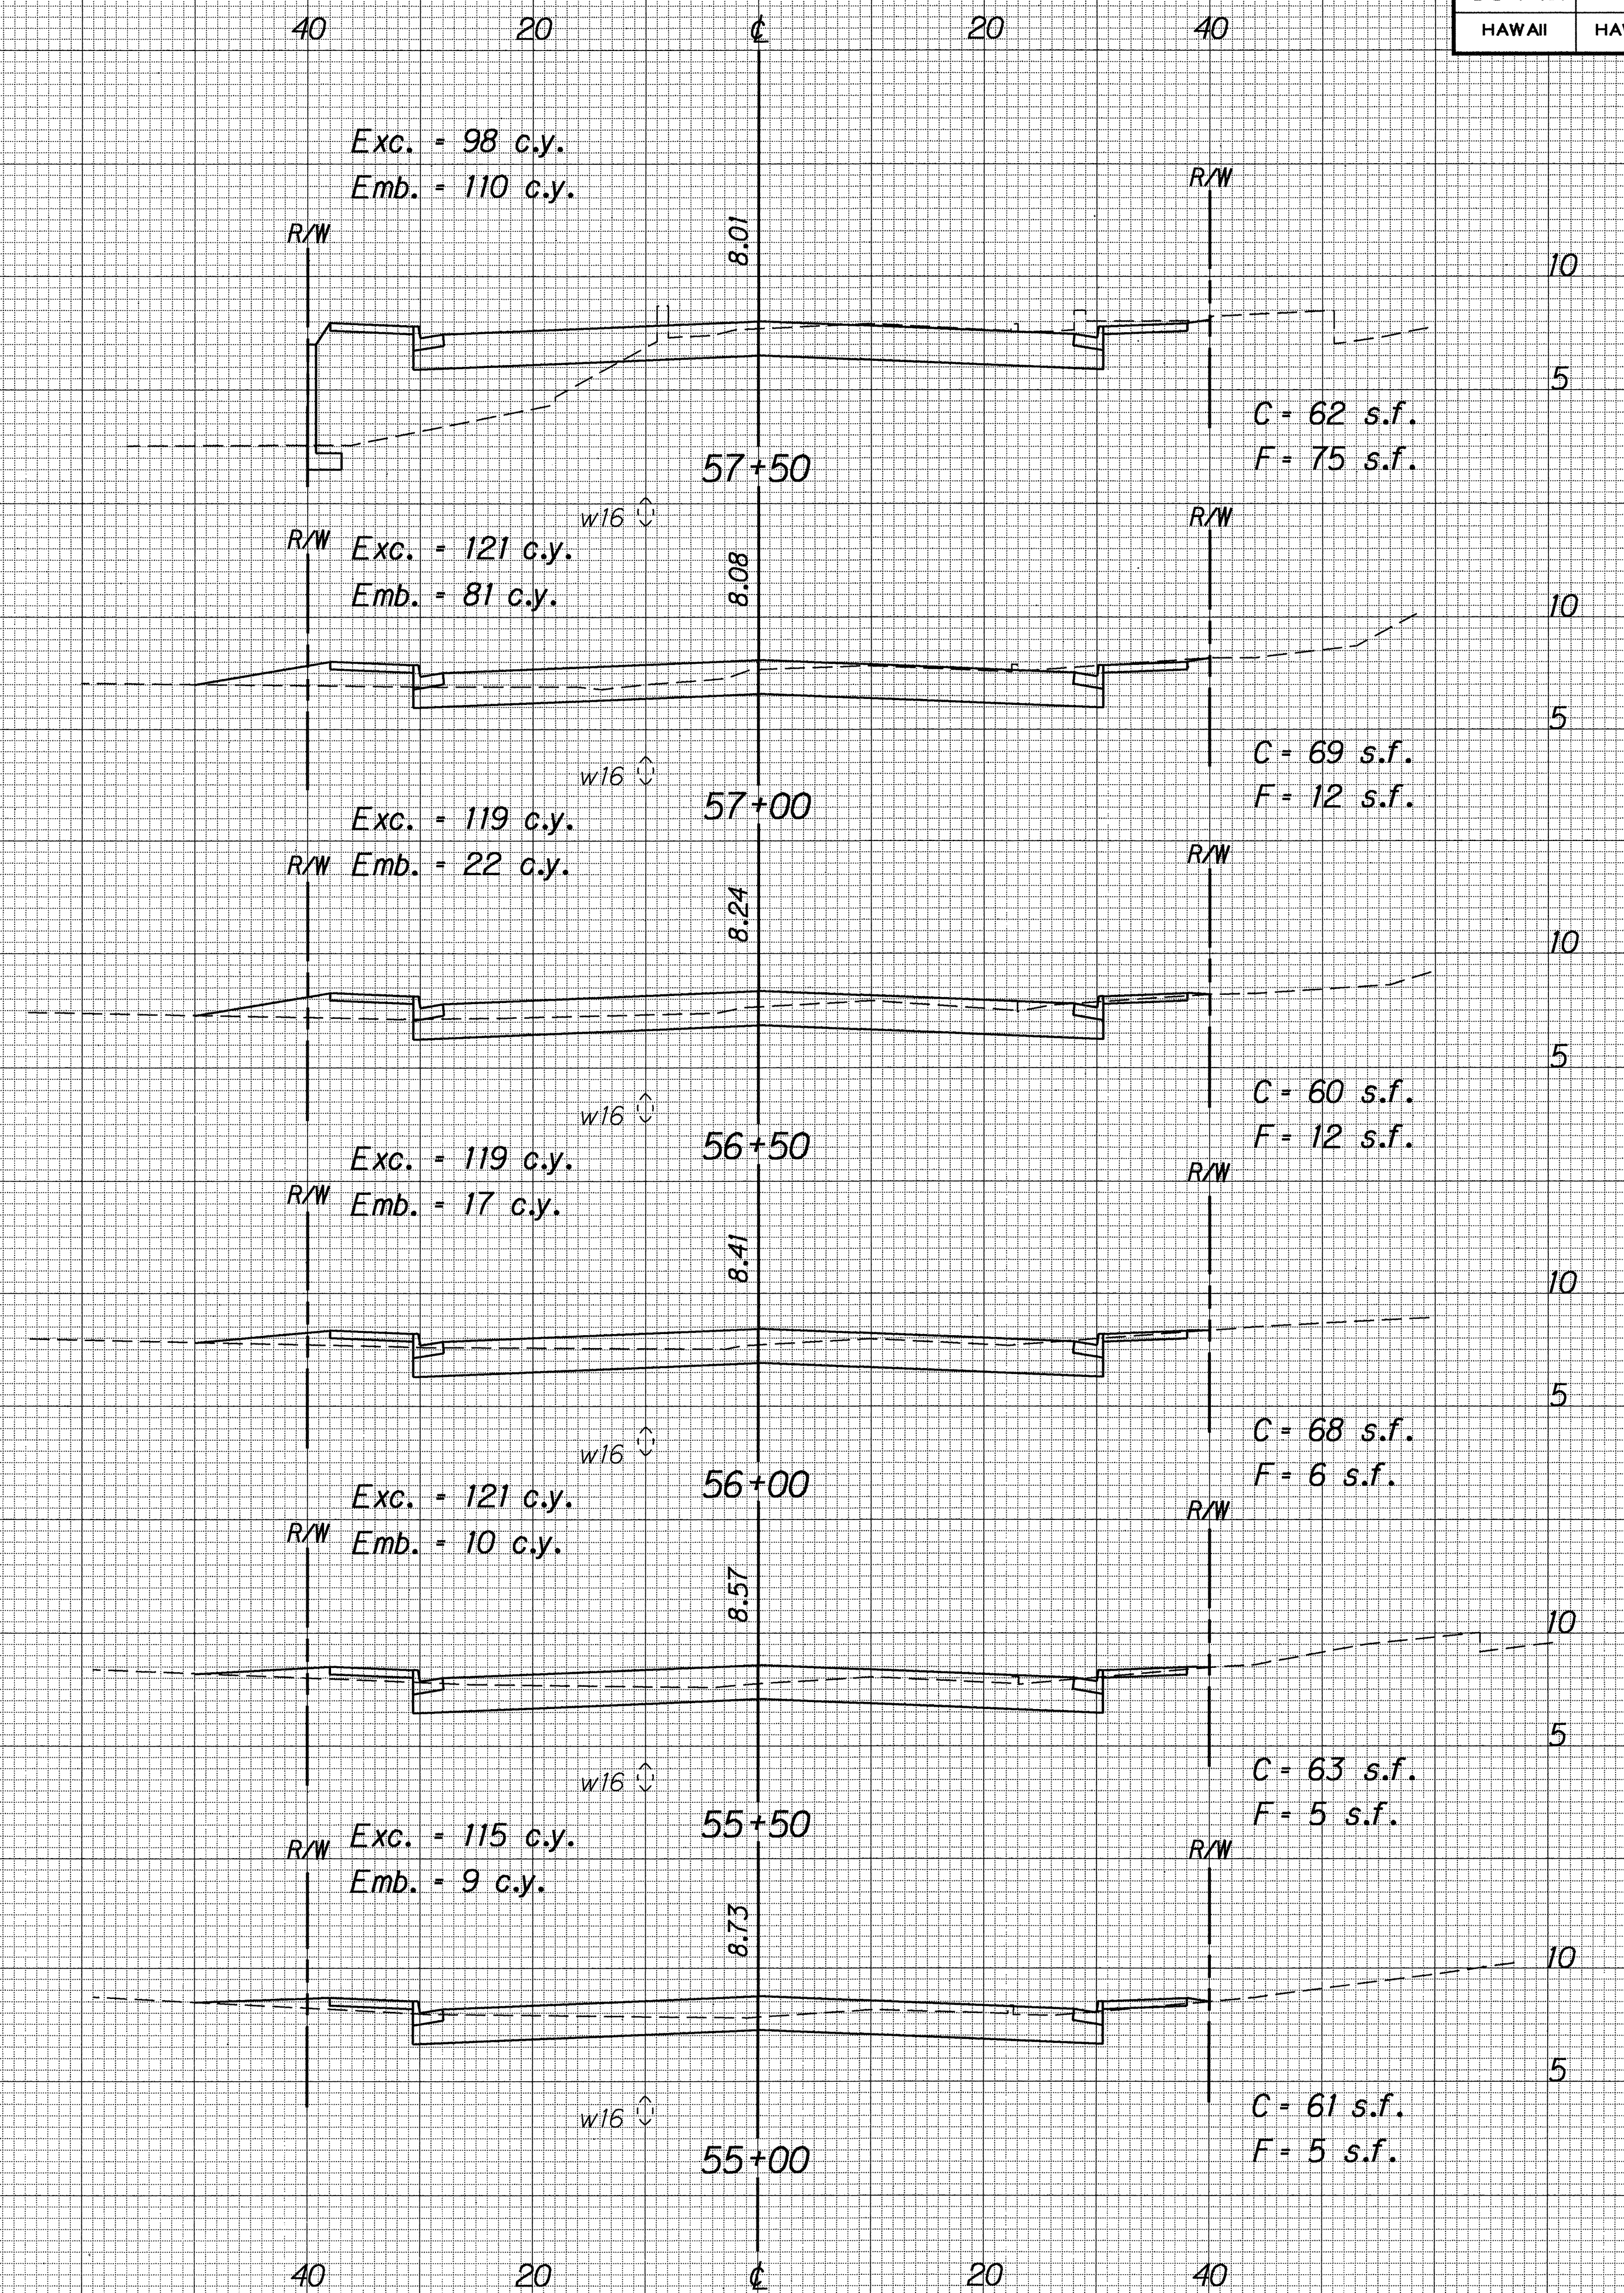


FED. ROAD DIST. NO.	STATE	PROJ. NO.	FISCAL YEAR	SHEET NO.	TOTAL SHEETS
HAWAII	HAW.	93B-02-91	1994	116	122

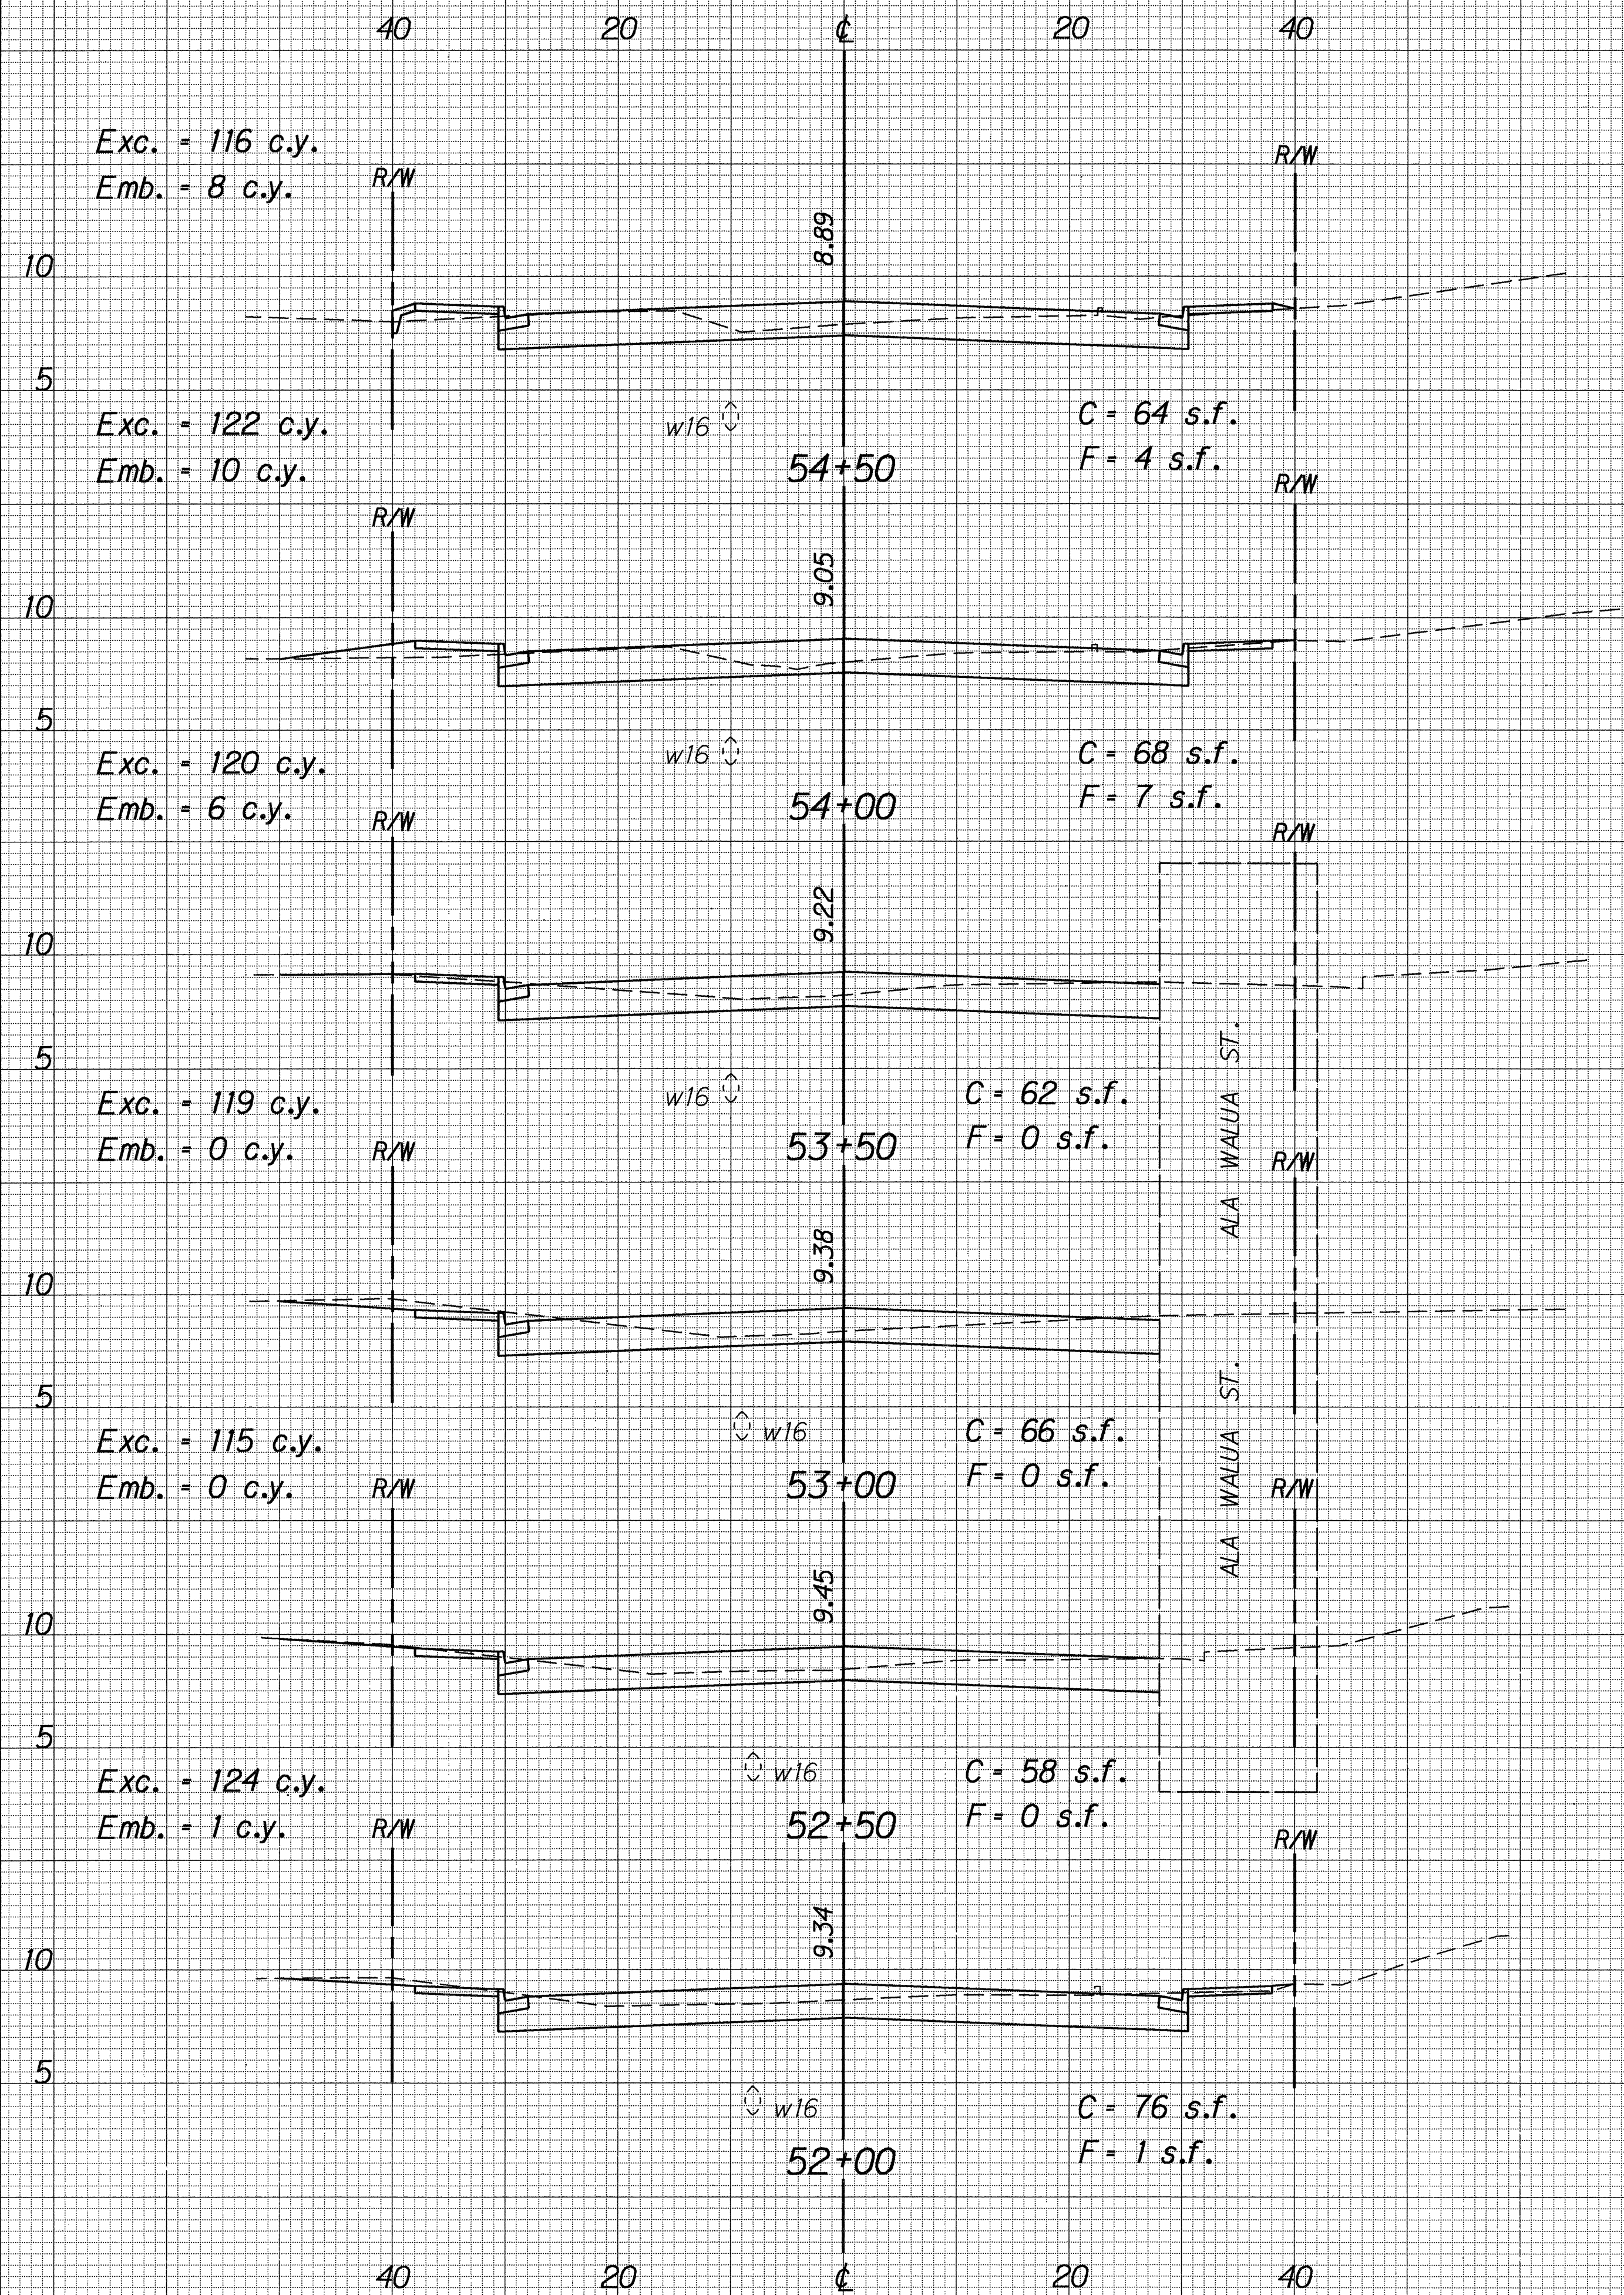

SCALES
HOR. 1"=10'
VERT. 1"=5'


FED. ROAD DIST. NO.	STATE	PROJ. NO.	FISCAL YEAR	SHEET NO.	TOTAL SHEETS
HAWAII	HAW.	93B-02-91	1994	117	122

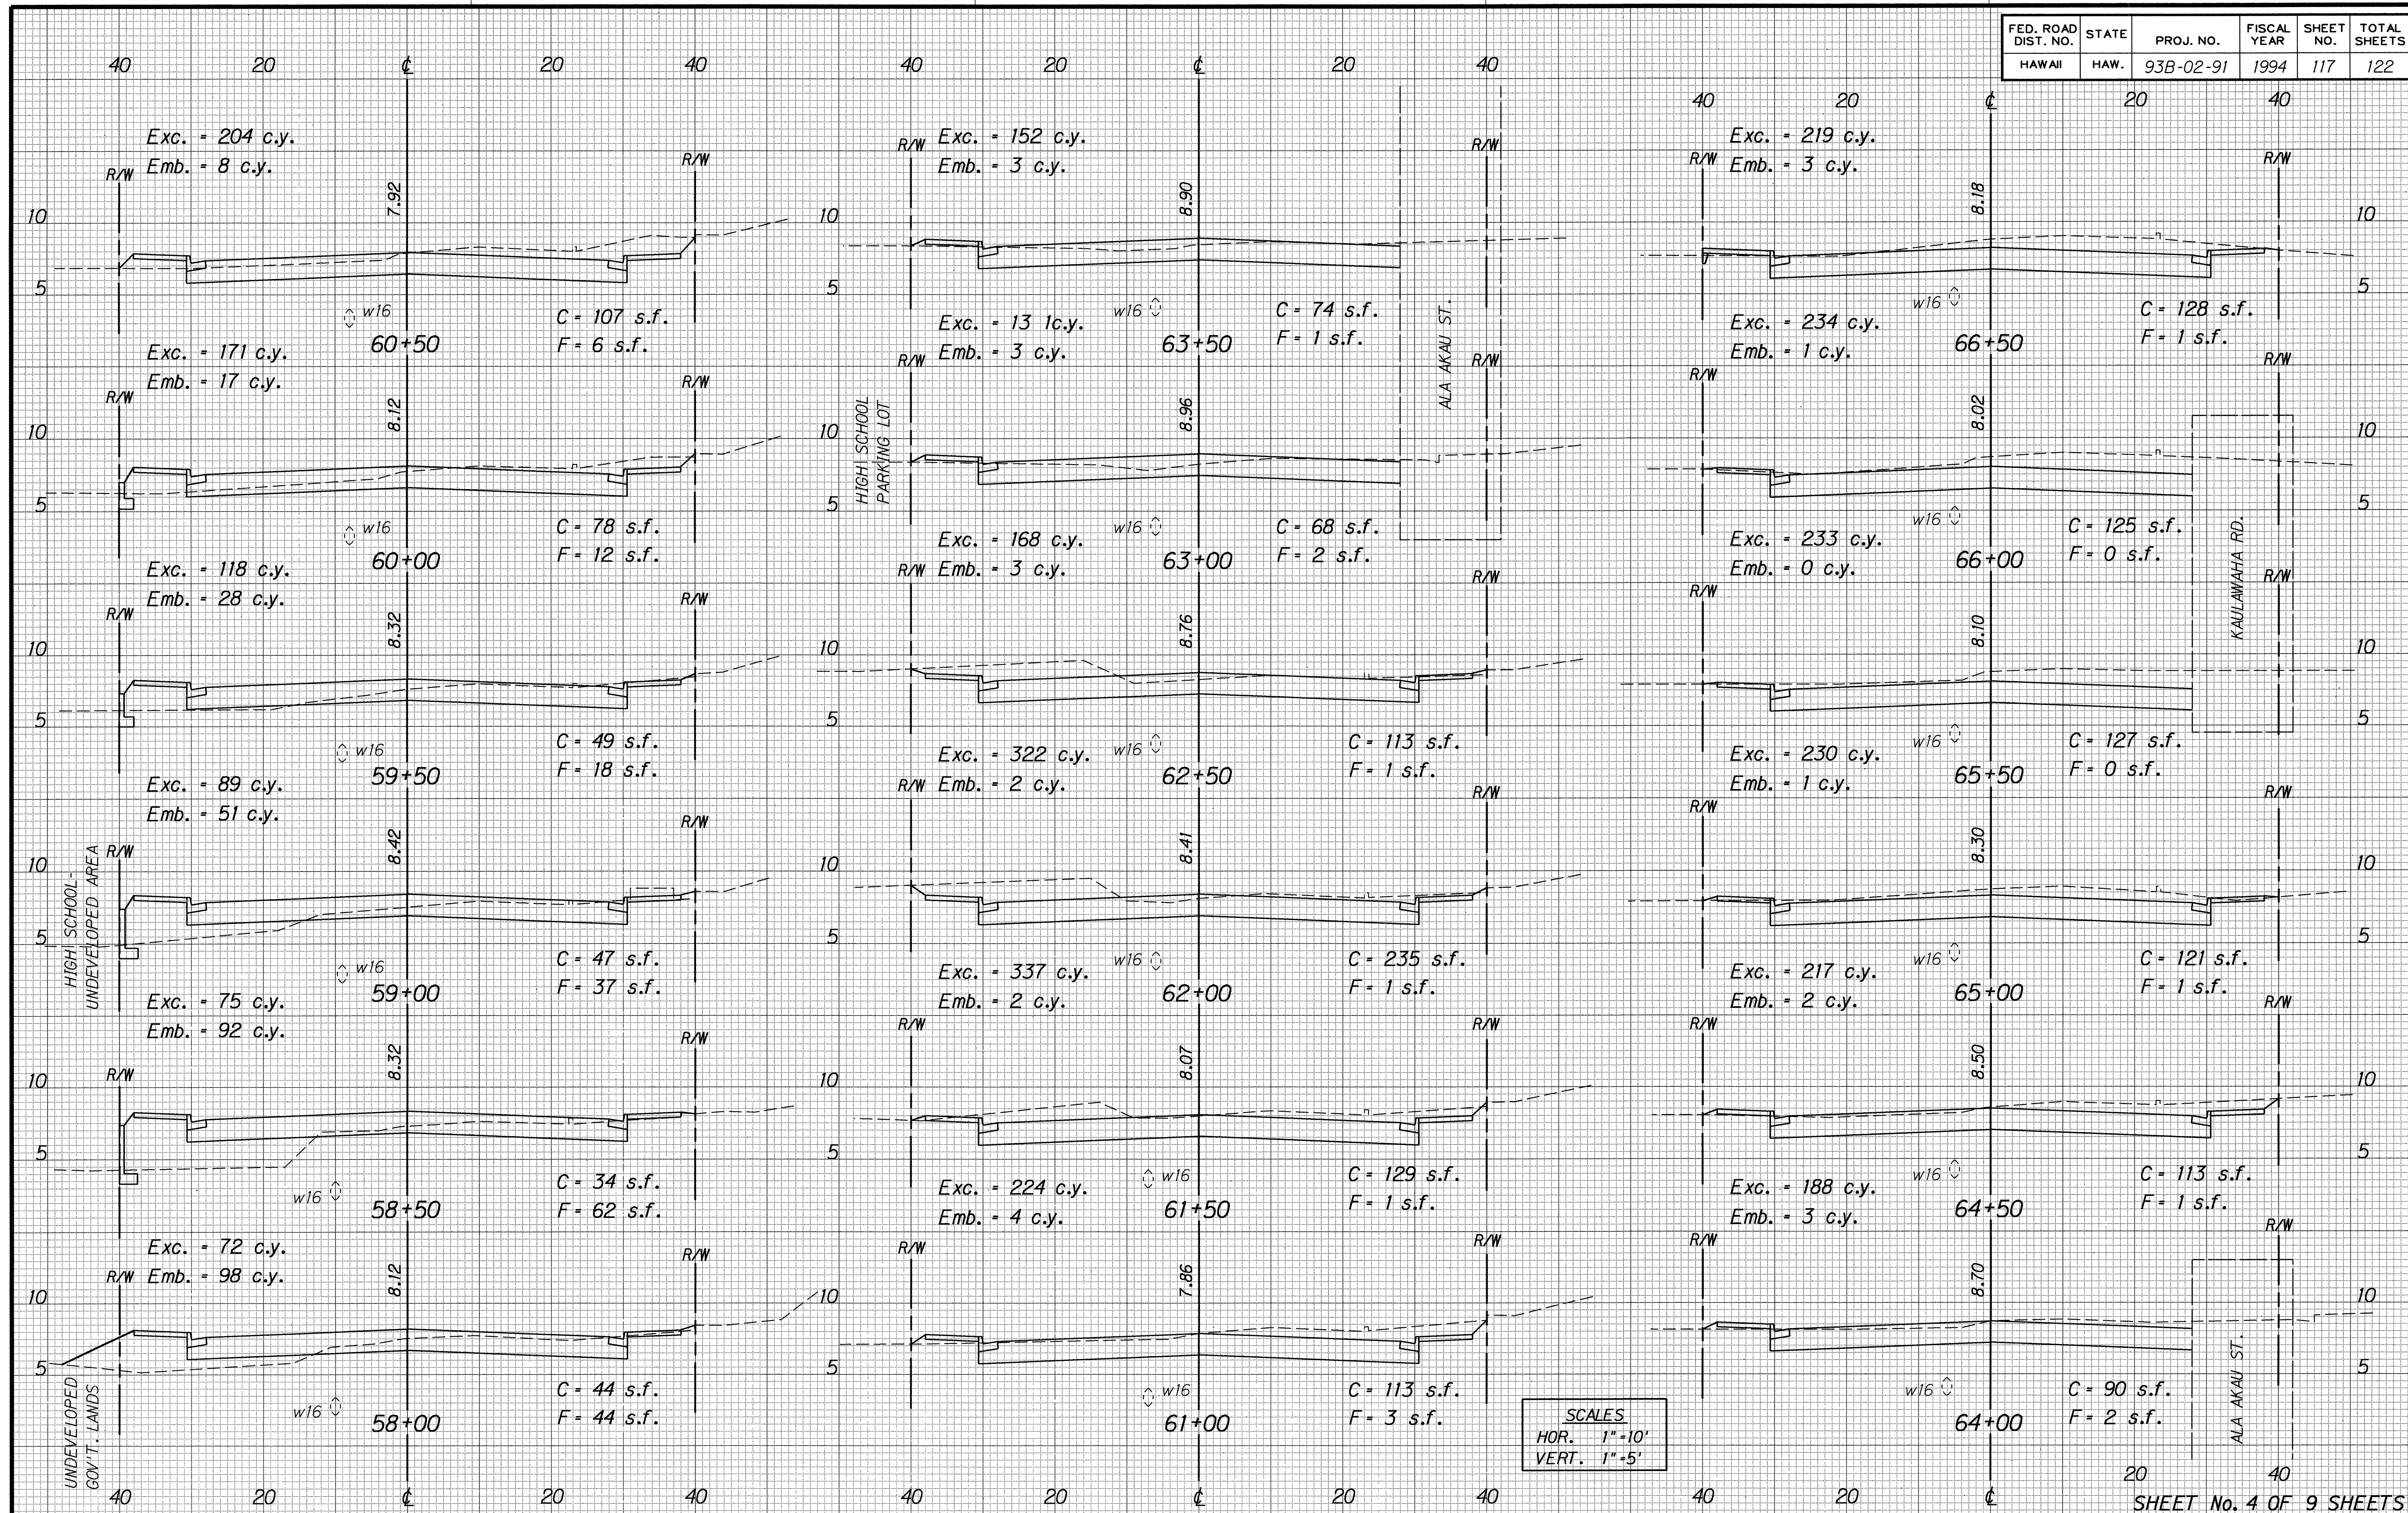

SCALES
HOR. 1"=10'
VERT. 1"=5'




ORIGINAL PLAN
DATE 12-1-94
DESIGNED BY Unit C
CHECKED BY
NOTES: 1. All quantities are for the full width of the road.
2. All quantities are for the full width of the road.
3. All quantities are for the full width of the road.

FED. ROAD DIST. NO.	STATE	PROJ. NO.	FISCAL YEAR	SHEET NO.	TOTAL SHEETS
HAWAII	HAW.	93B-02-91	1994	118	122

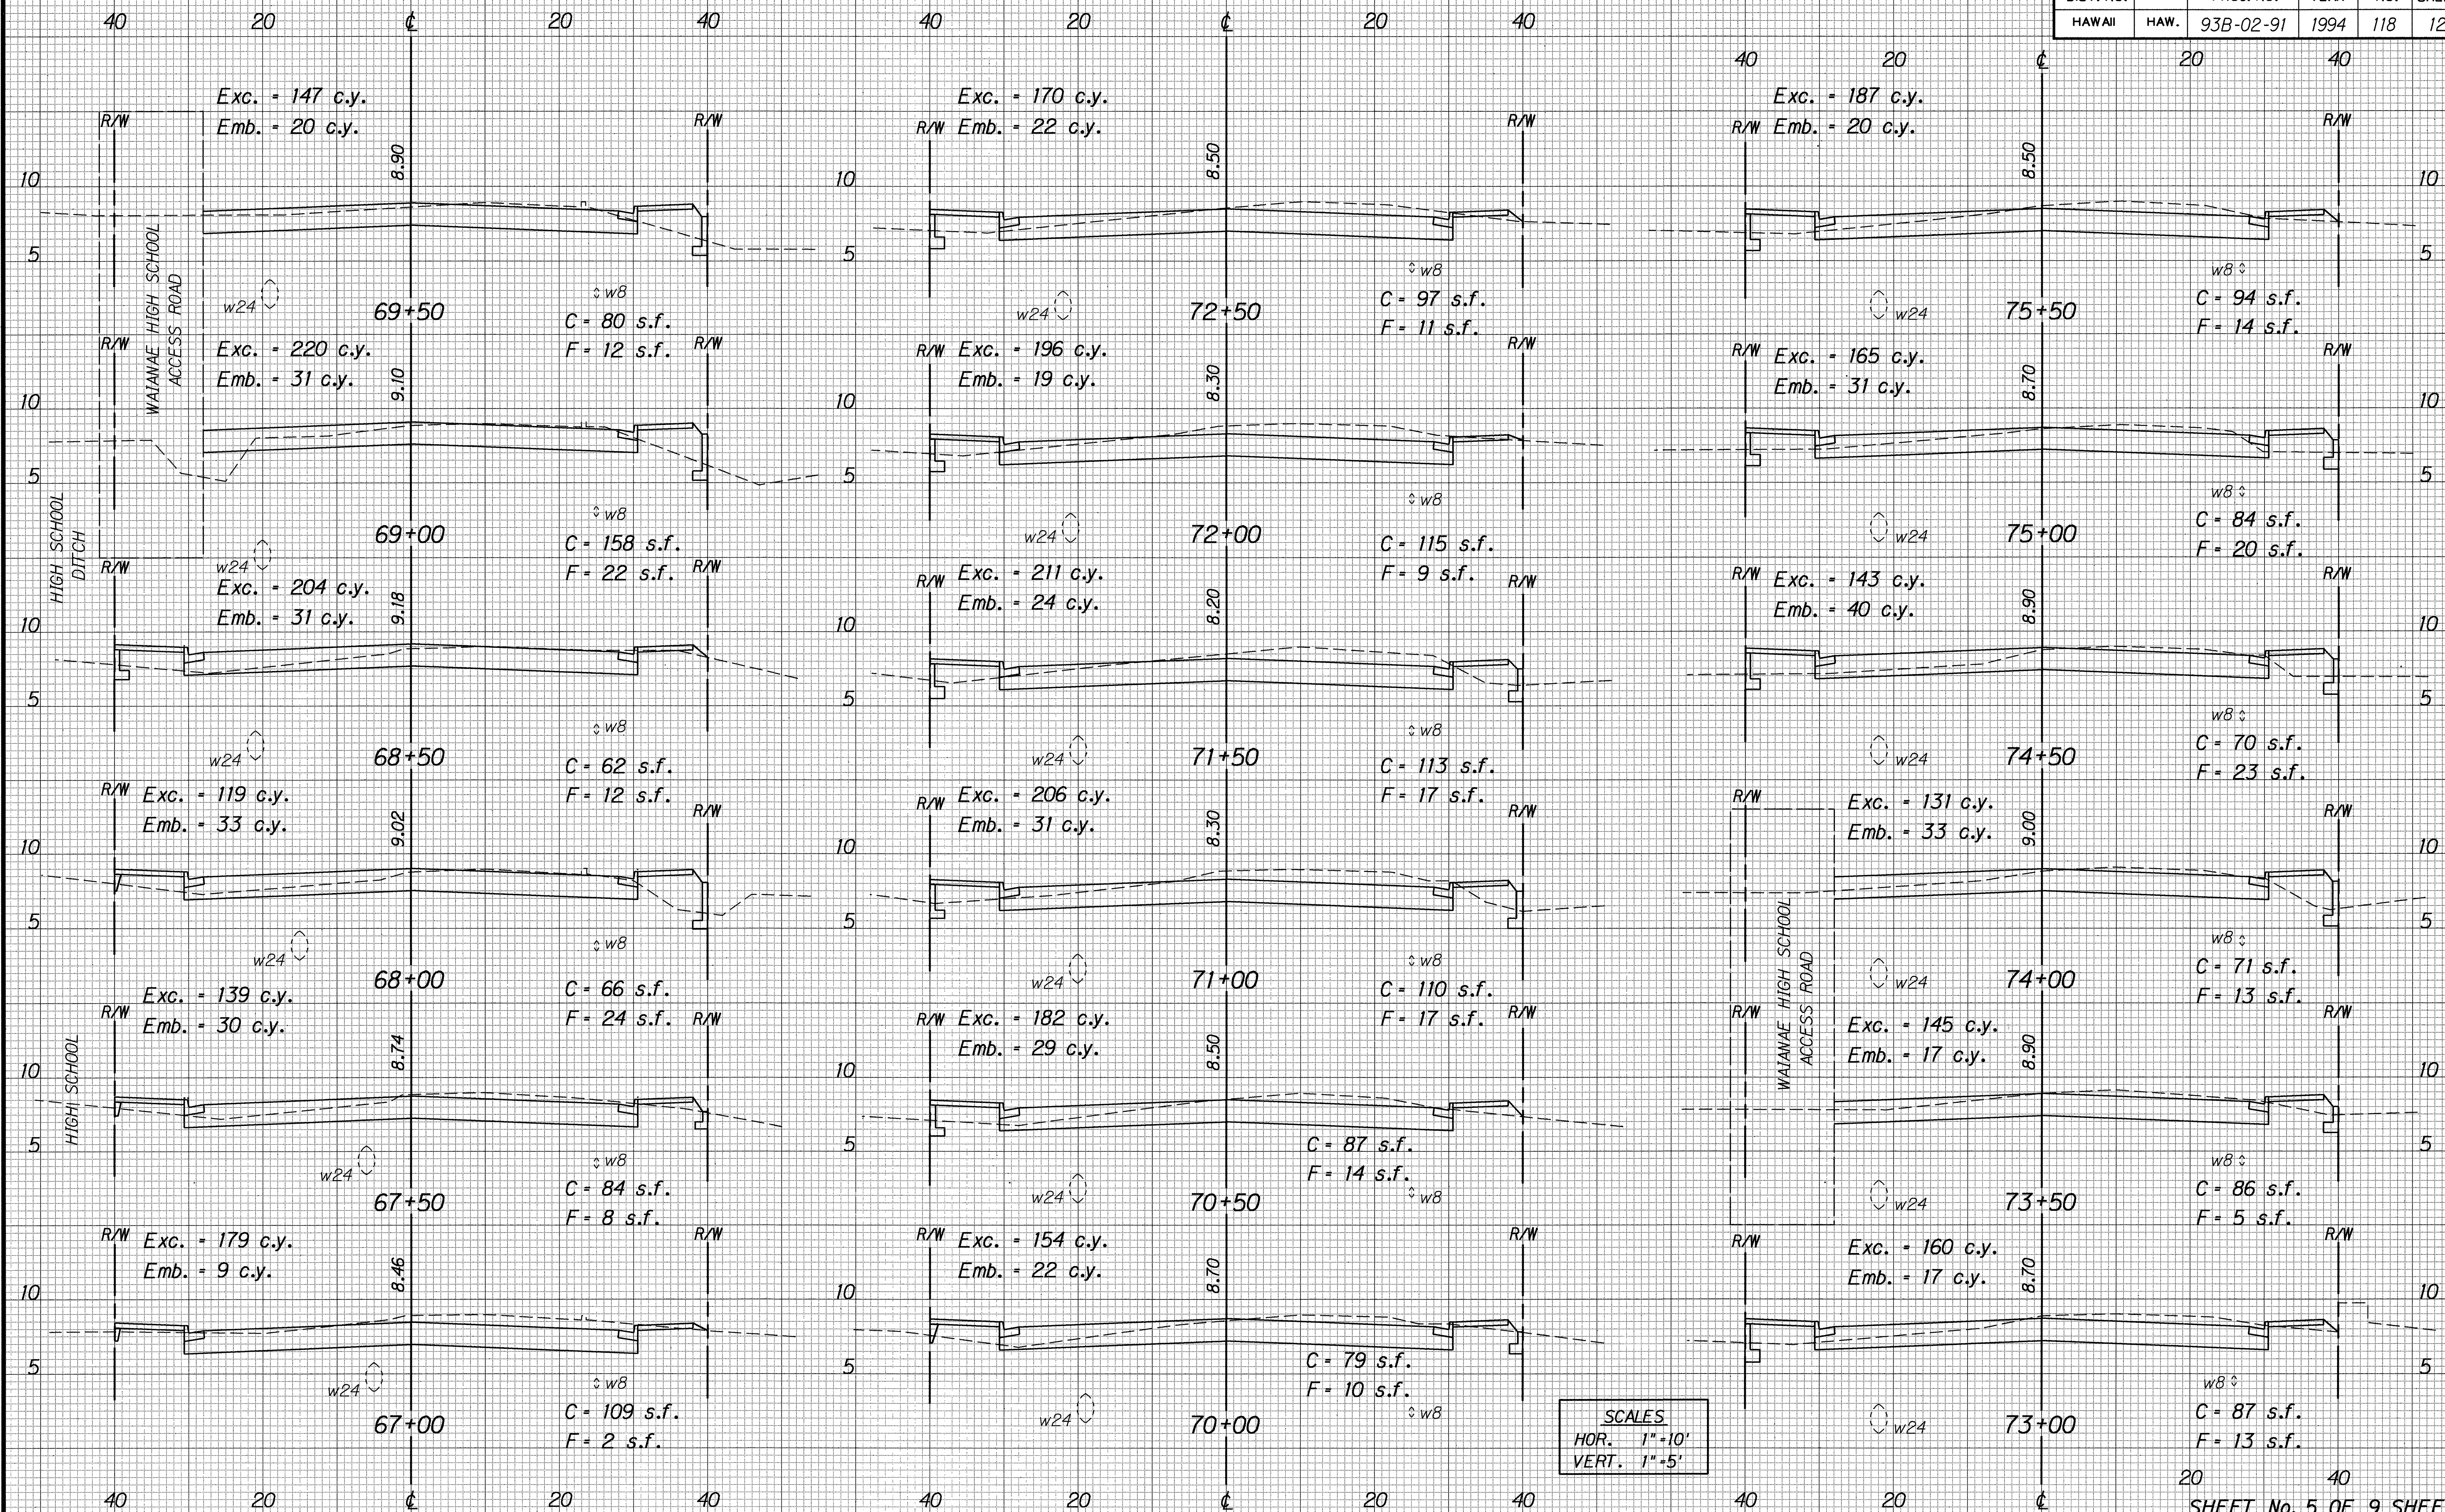


SHEET No. 5 OF 9 SHEETS

FED. ROAD DIST. NO.	STATE	PROJ. NO.	FISCAL YEAR	SHEET NO.	TOTAL SHEETS
HAWAII	HAW.	93B-02-91	1994	119	122

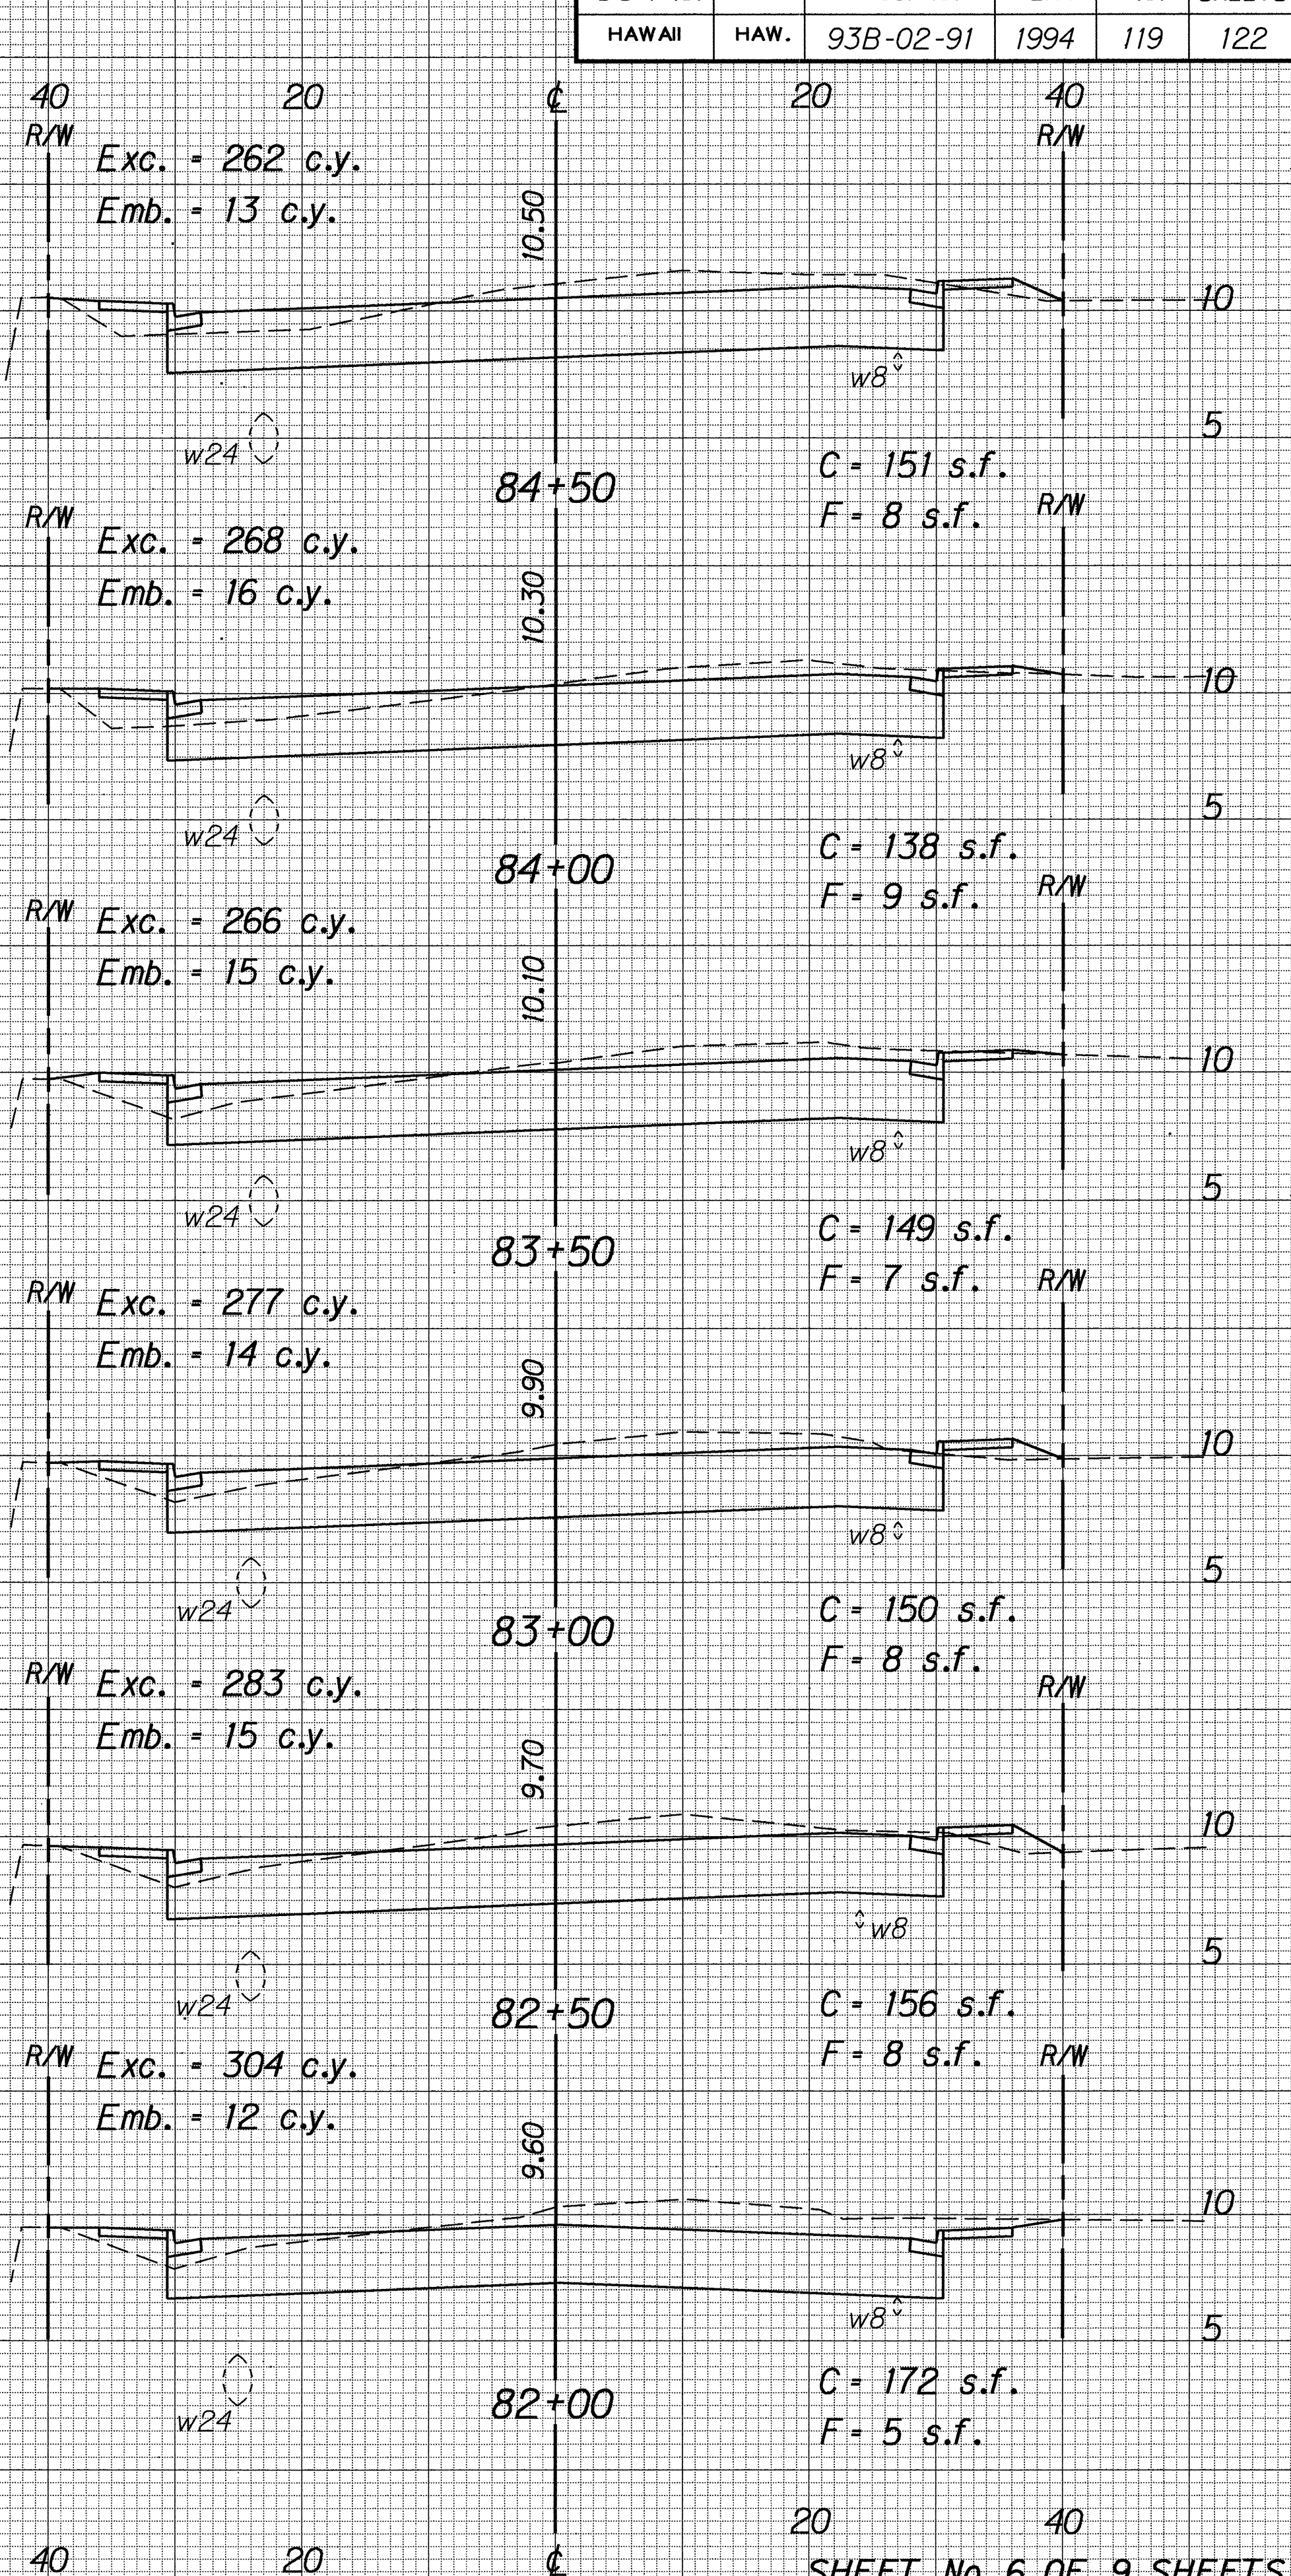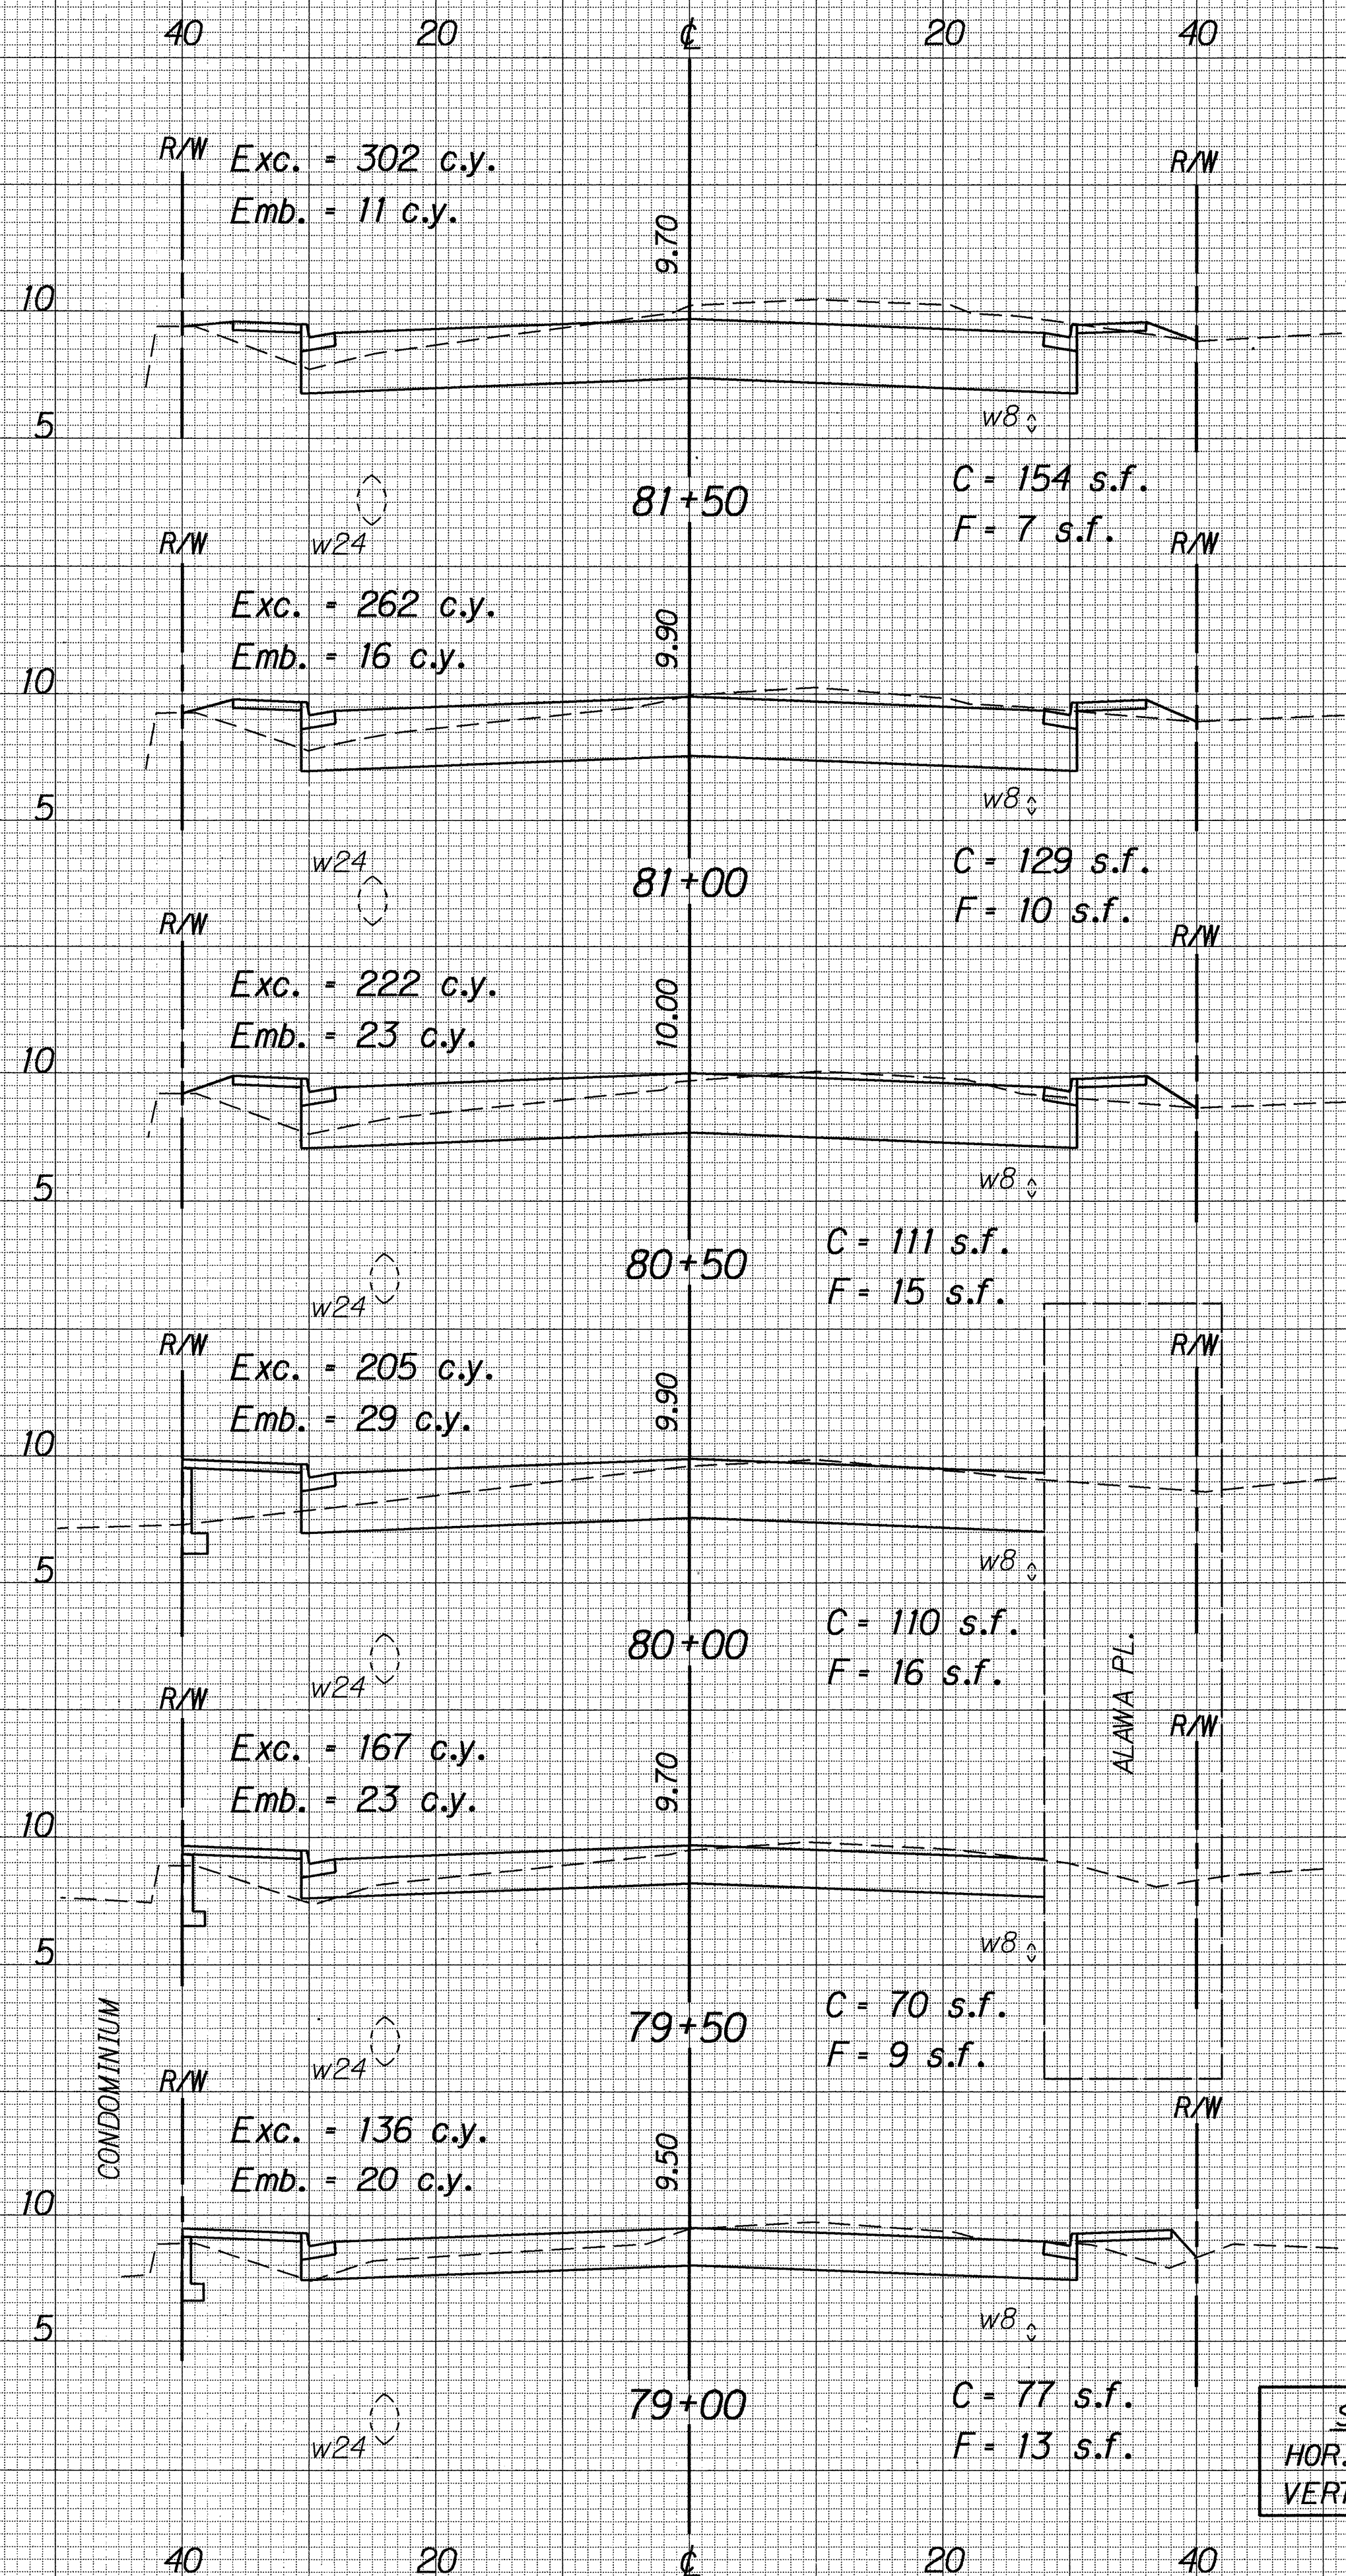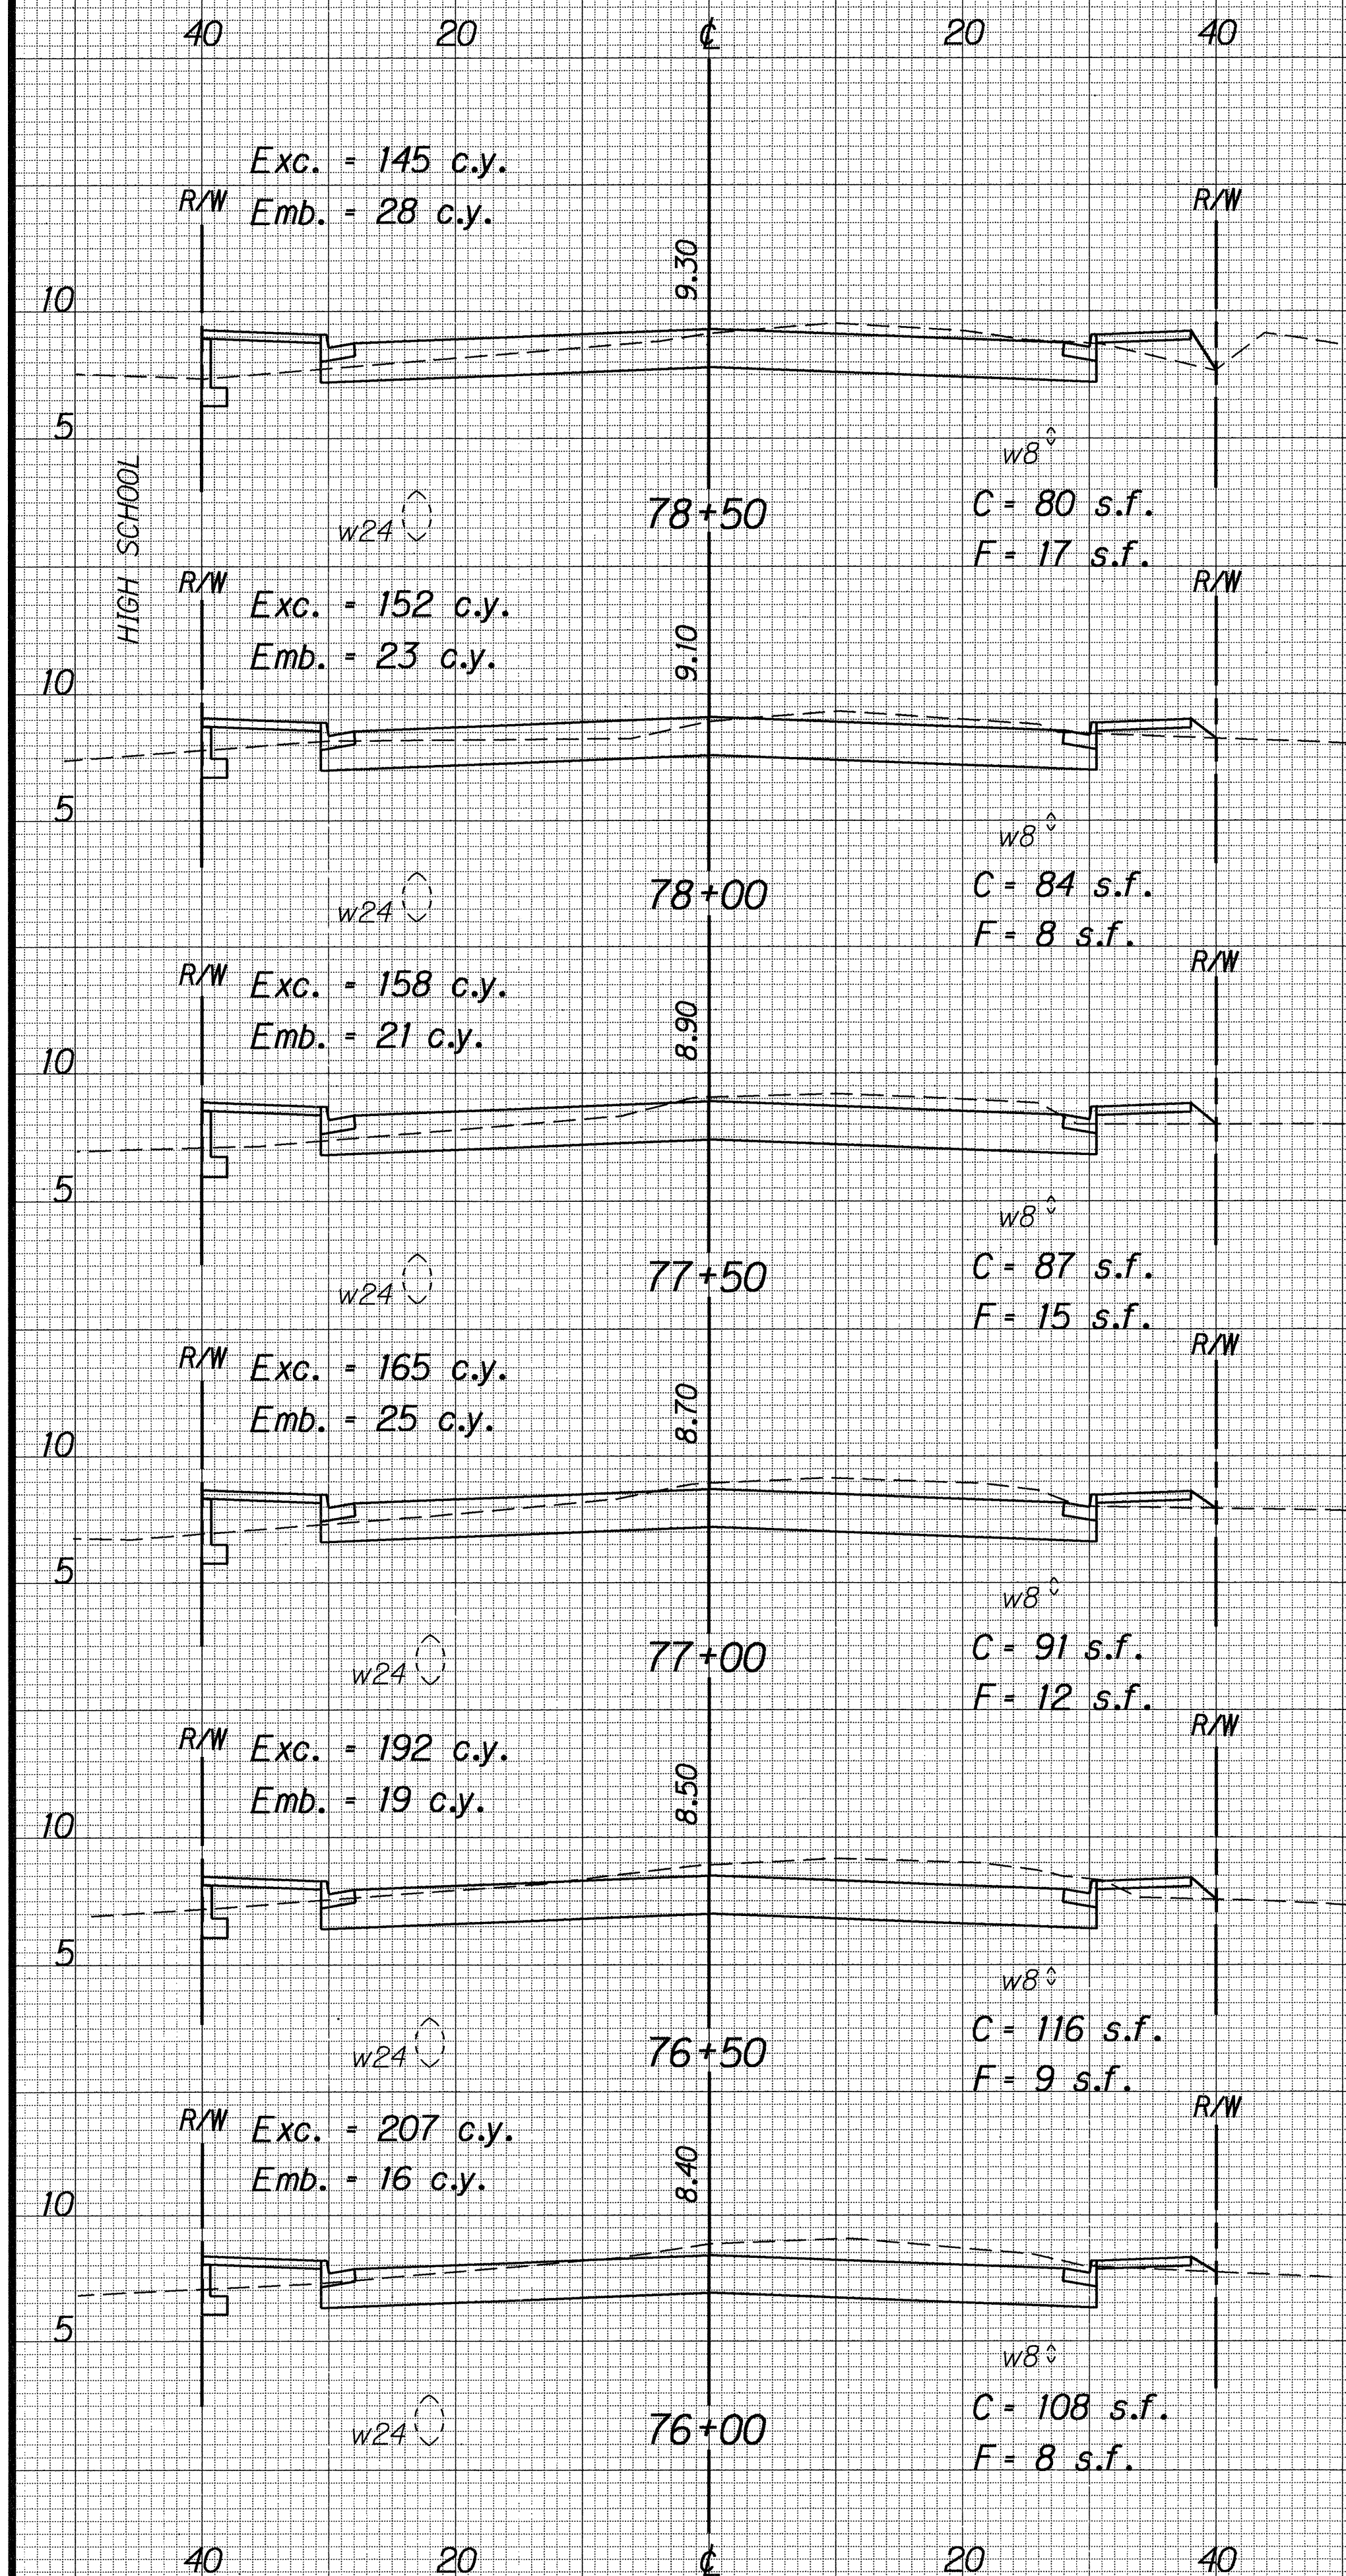


SCALES
HOR. 1"=10'
VERT. 1"=5'

FED. ROAD DIST. NO.	STATE	PROJ. NO.	FISCAL YEAR	SHEET NO.	TOTAL SHEETS
HAWAII	HAW.	93B-02-91	1994	120	122

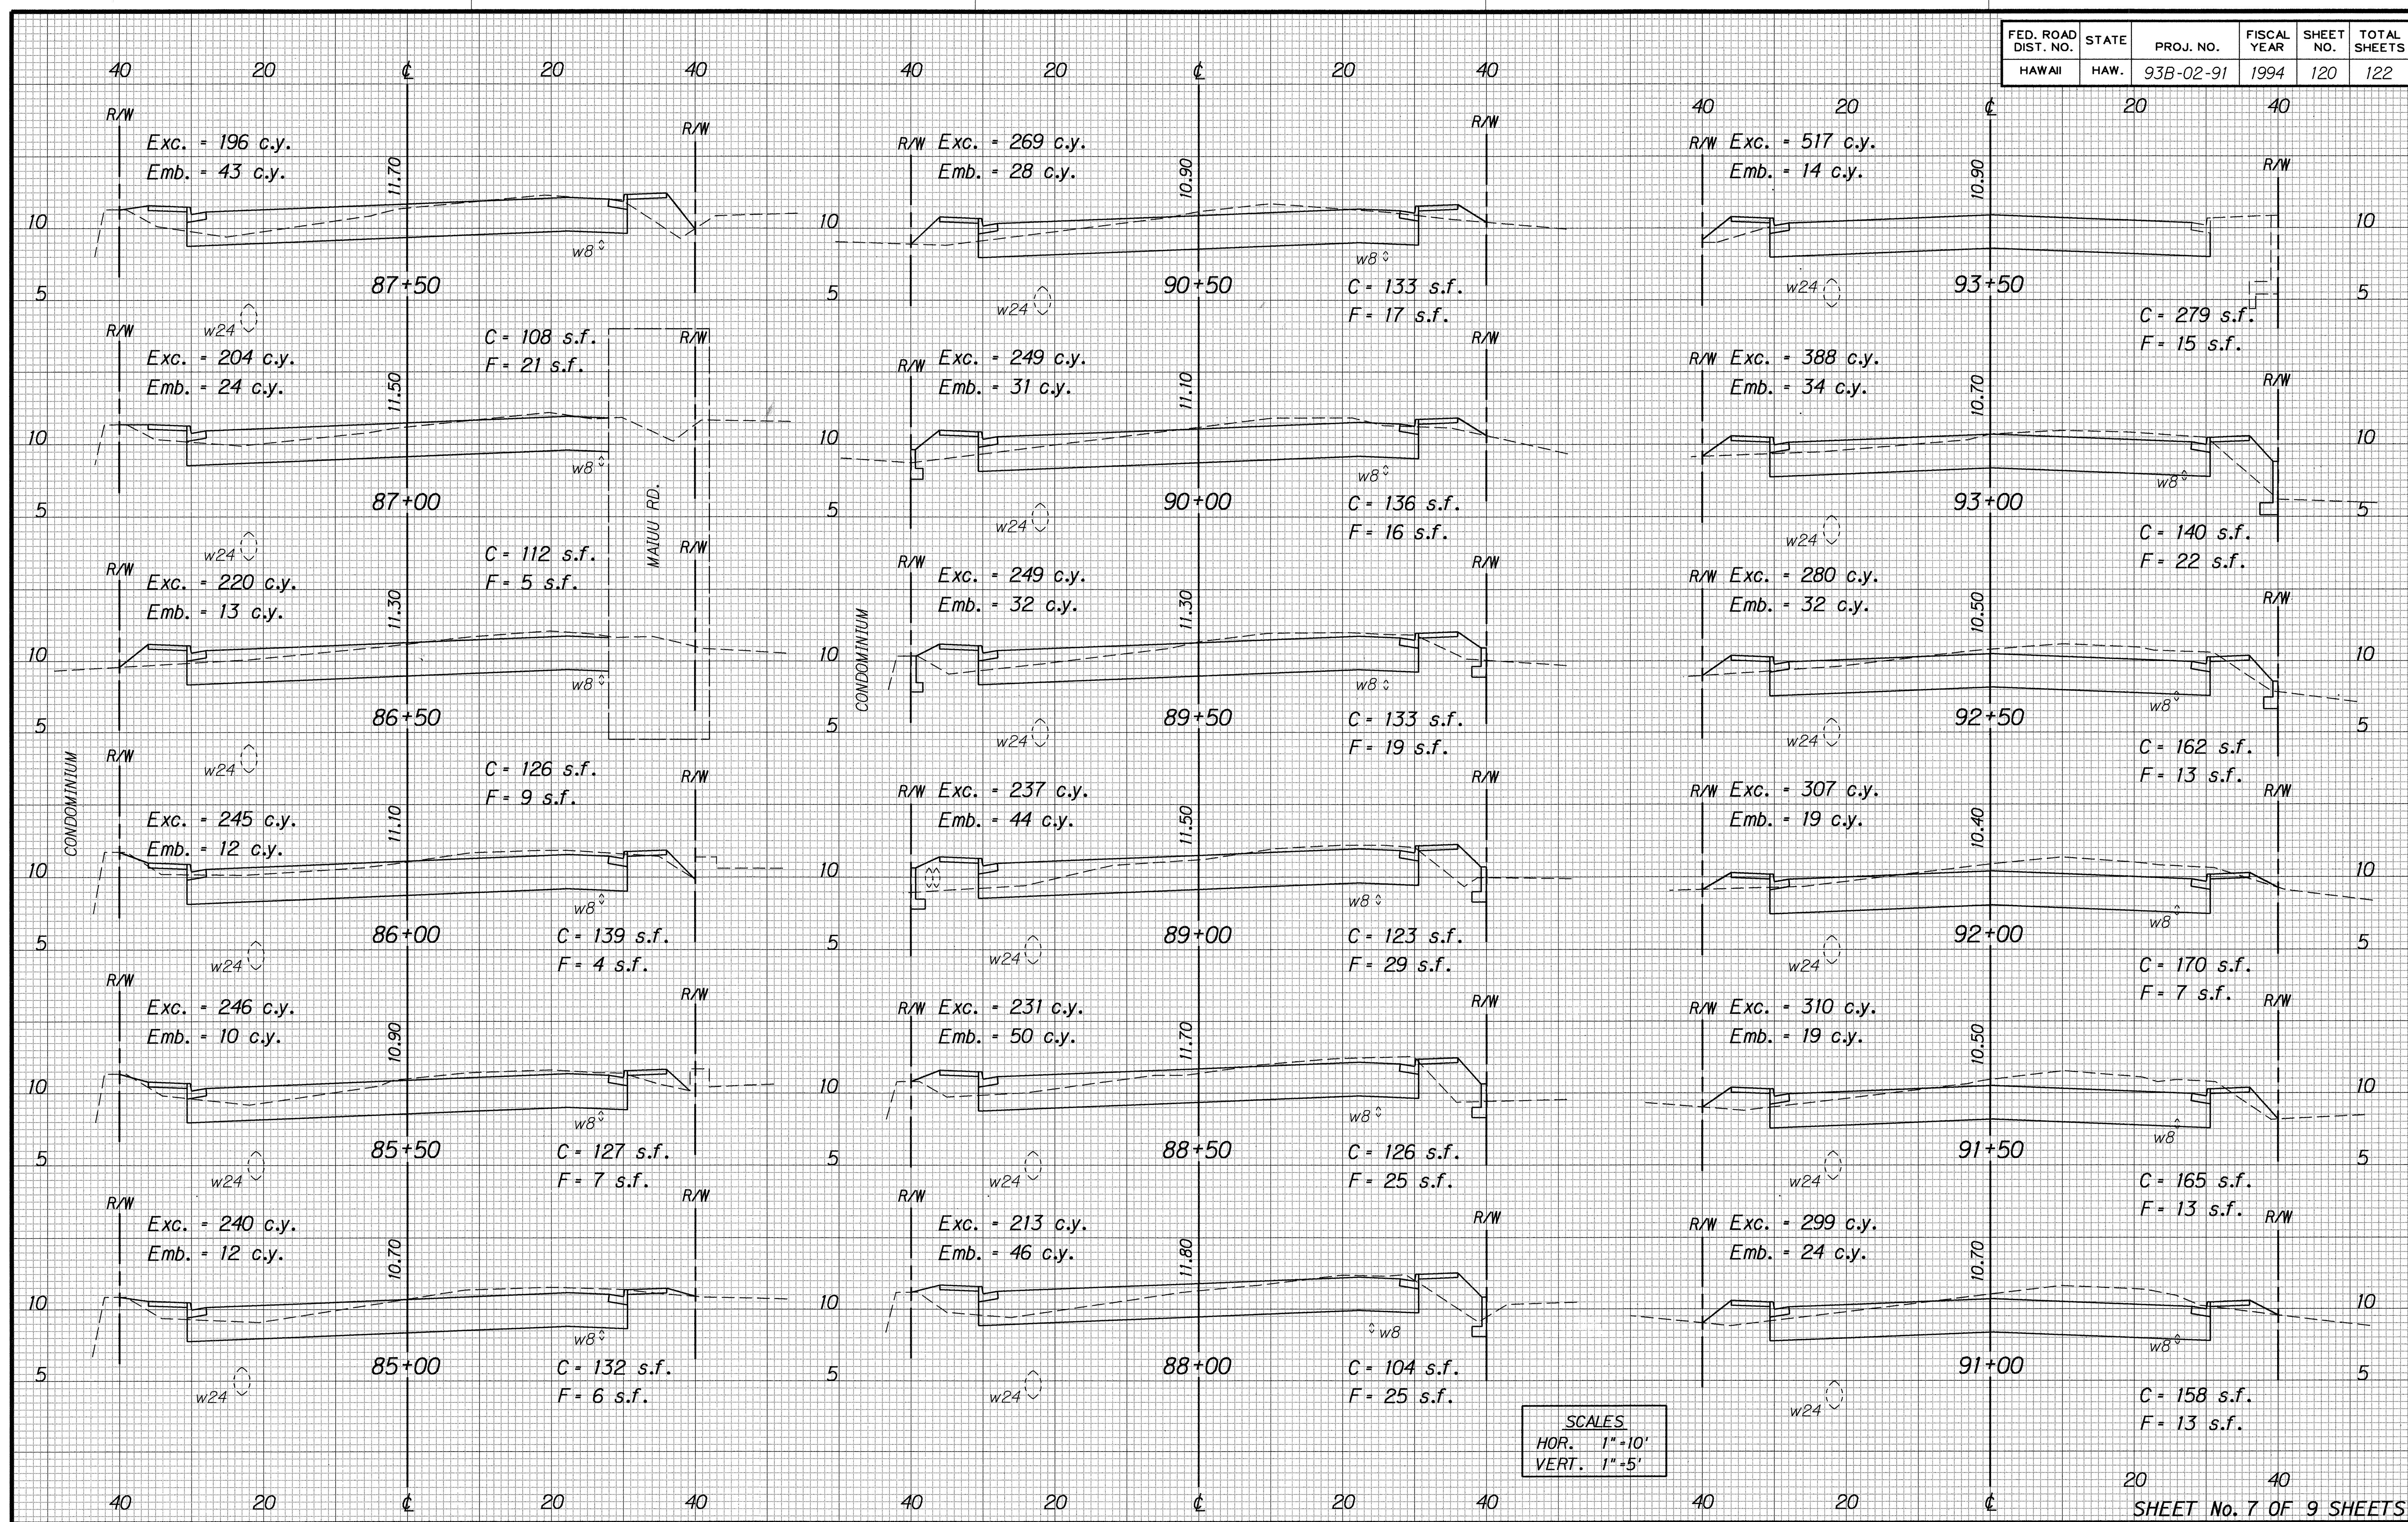


ORIGINAL
PLAN
DATE 12-4-94
DESIGNED BY
CHECKED BY
NOTED BY
QUANTITIES BY

FED. ROAD DIST. NO.	STATE	PROJ. NO.	FISCAL YEAR	SHEET NO.	TOTAL SHEETS
HAWAII	HAW.	93B-02-91	1994	121	122

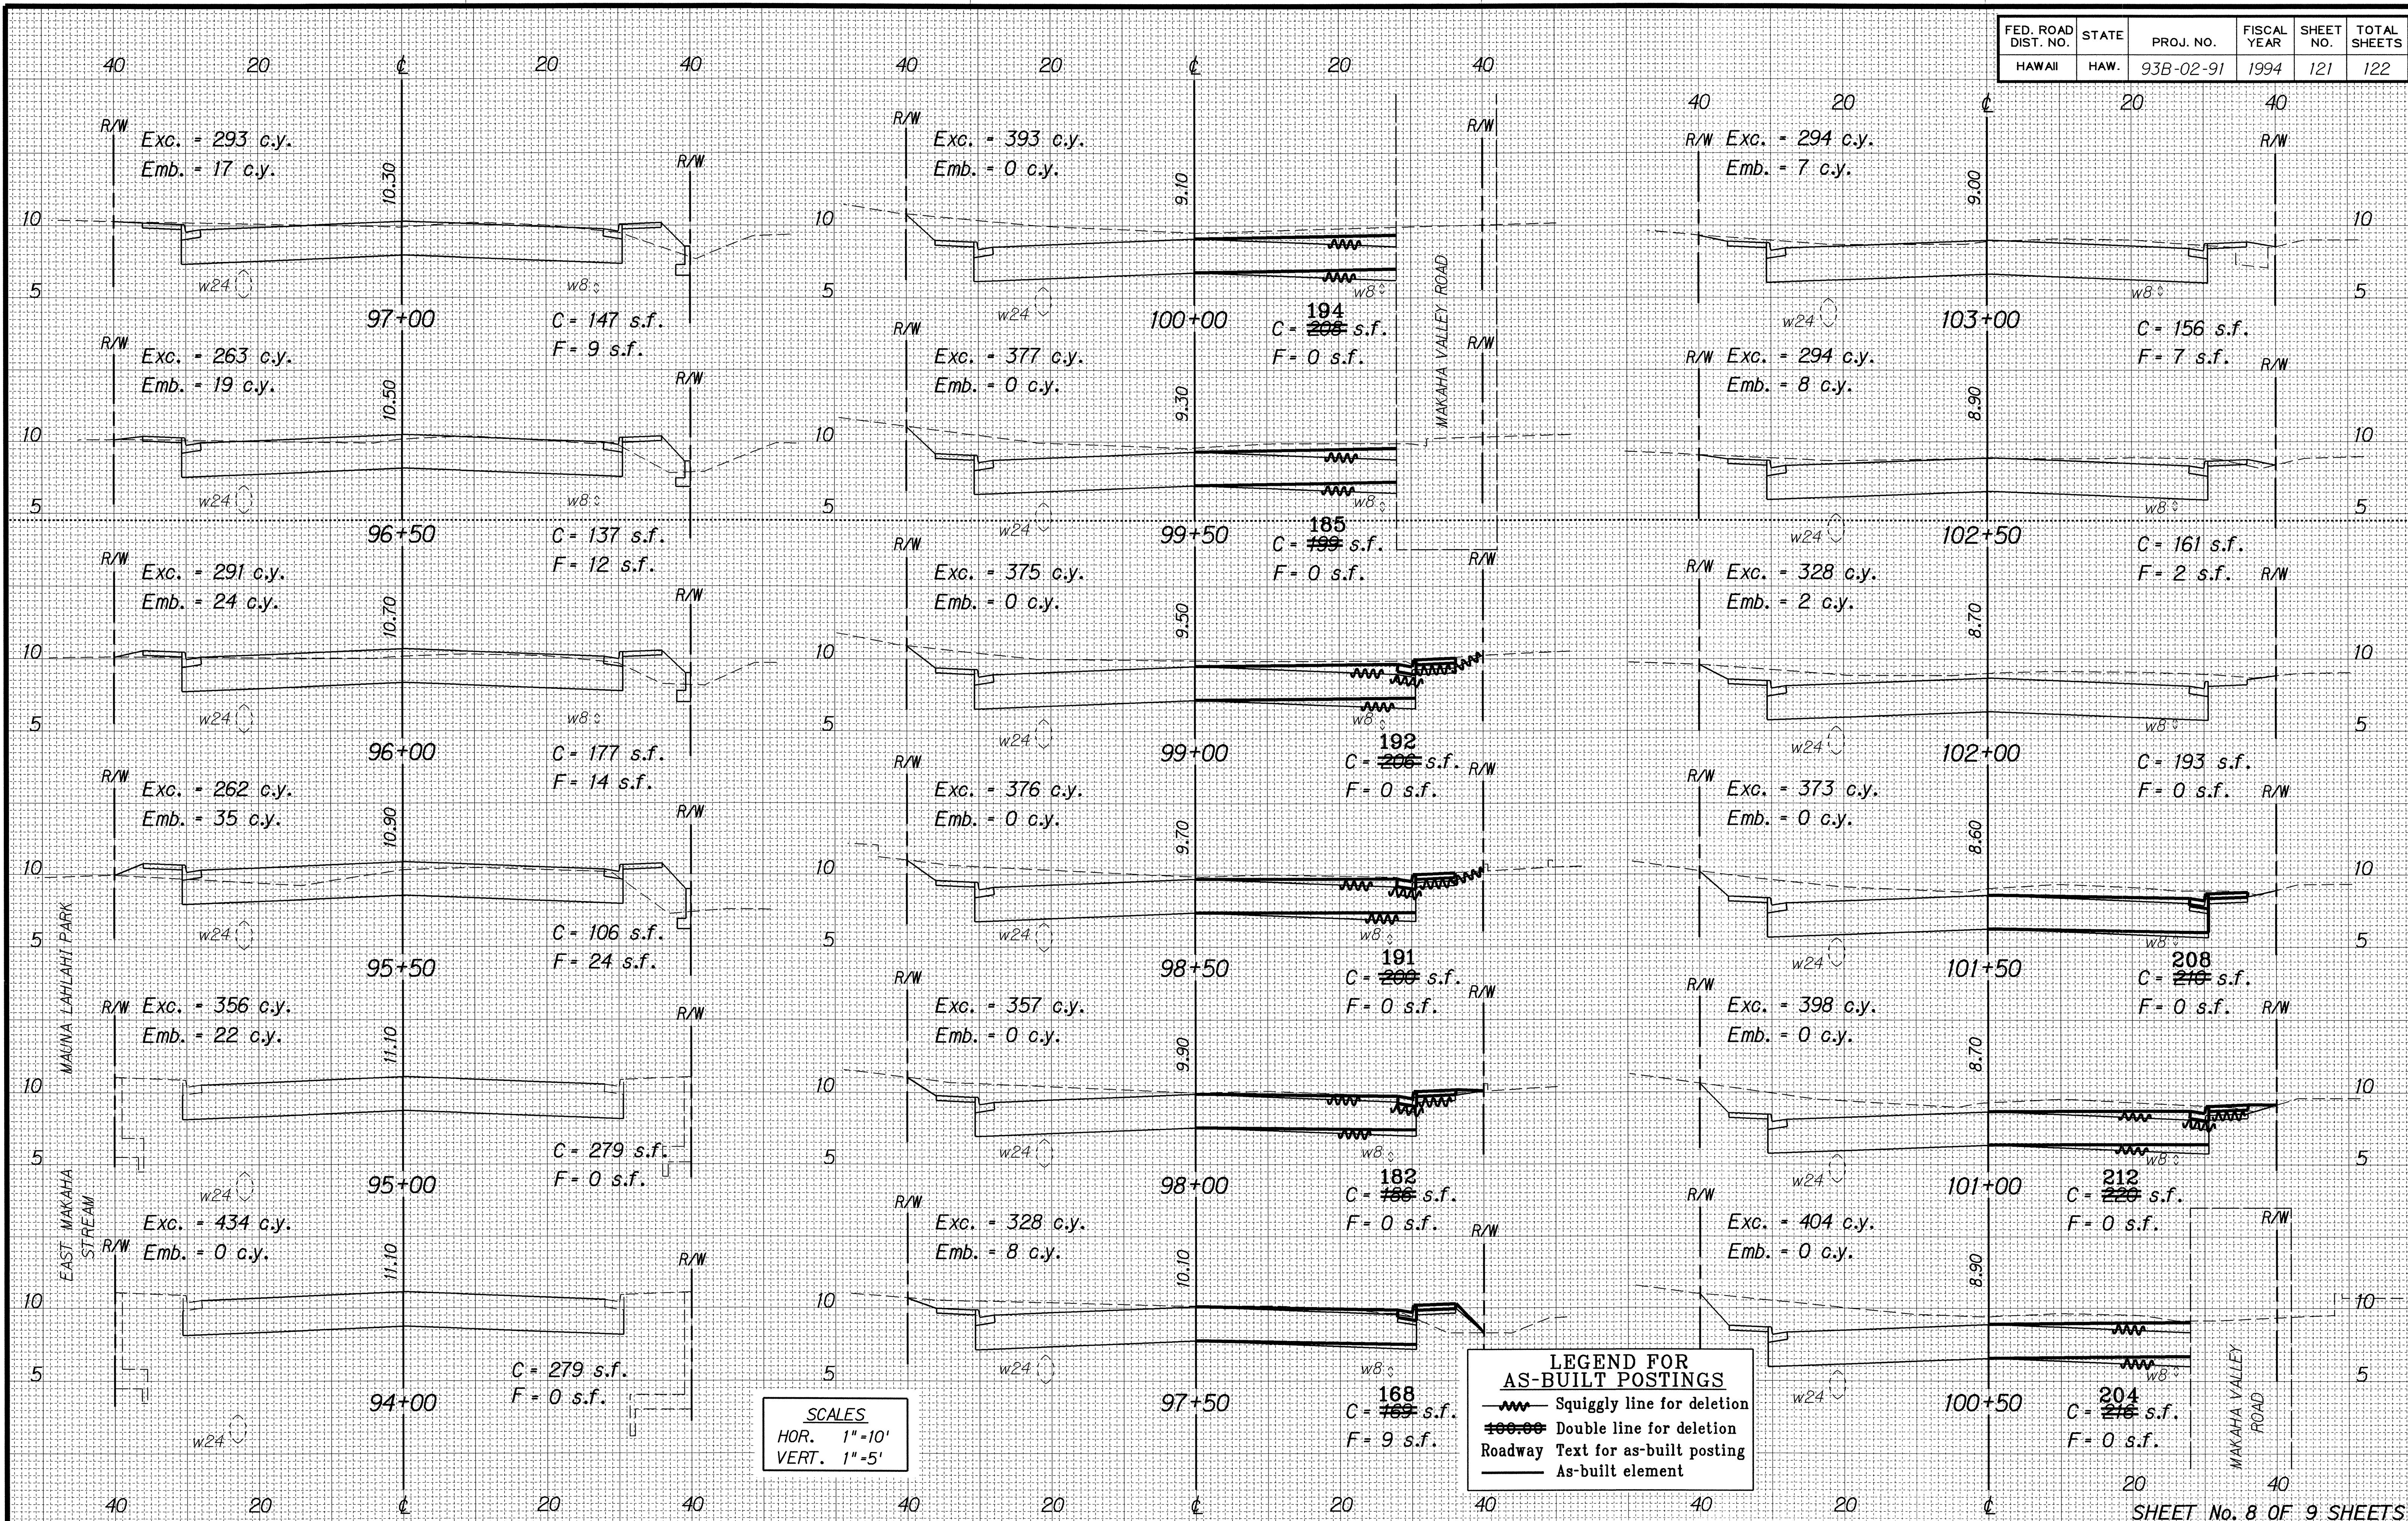

"AS-BUILT"

FED. ROAD DIST. NO.	STATE	PROJ. NO.	FISCAL YEAR	SHEET NO.	TOTAL SHEETS
HAWAII	HAW.	93B-02-91	1994	122	122

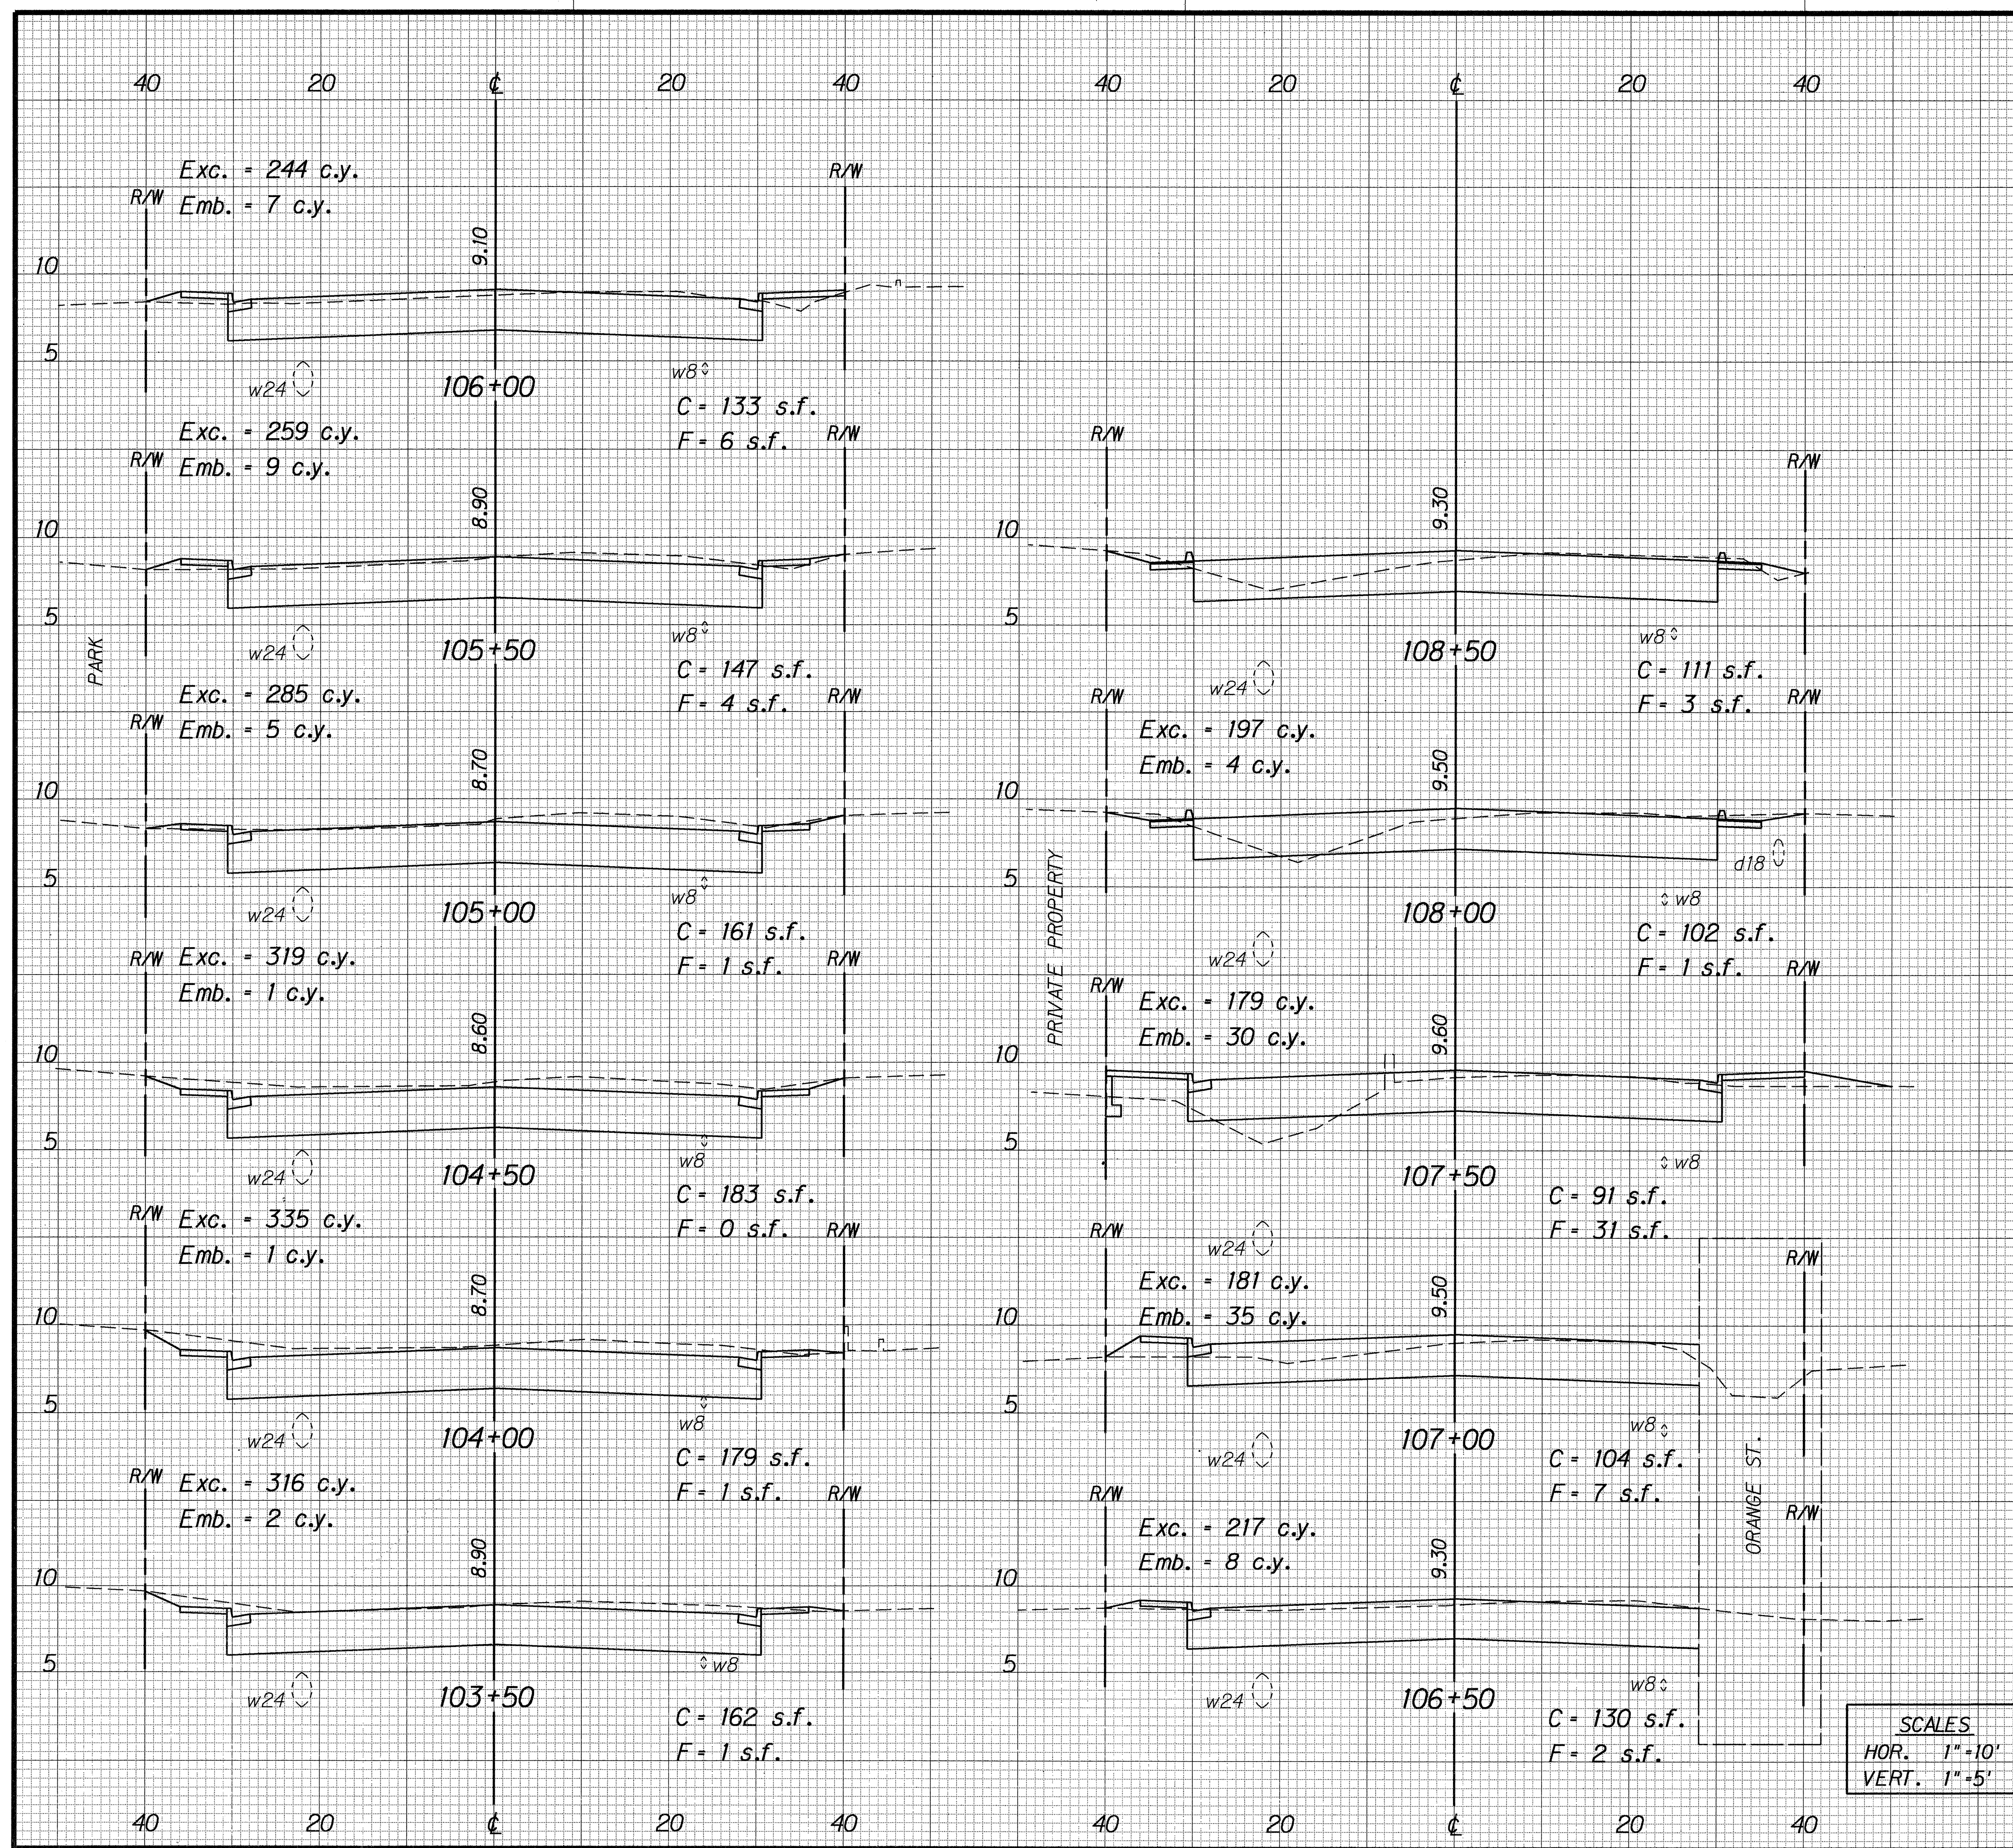

SCALES
HOR. 1"=10'
VERT. 1"=5'

ORIGINAL PLAN
DATE 12-1-94
SURVEY PLOTTED BY
DESIGNED BY
CHECKED BY
NOTE BOOK
007198098
QUANTITIES BY
N. G. GUST