



FED. ROAD DIST. NO.	STATE	PROJ. NO.	FISCAL YEAR	SHEET NO.	TOTAL SHEETS
HAWAII	HAW.	93B-02-91	1994	10	122

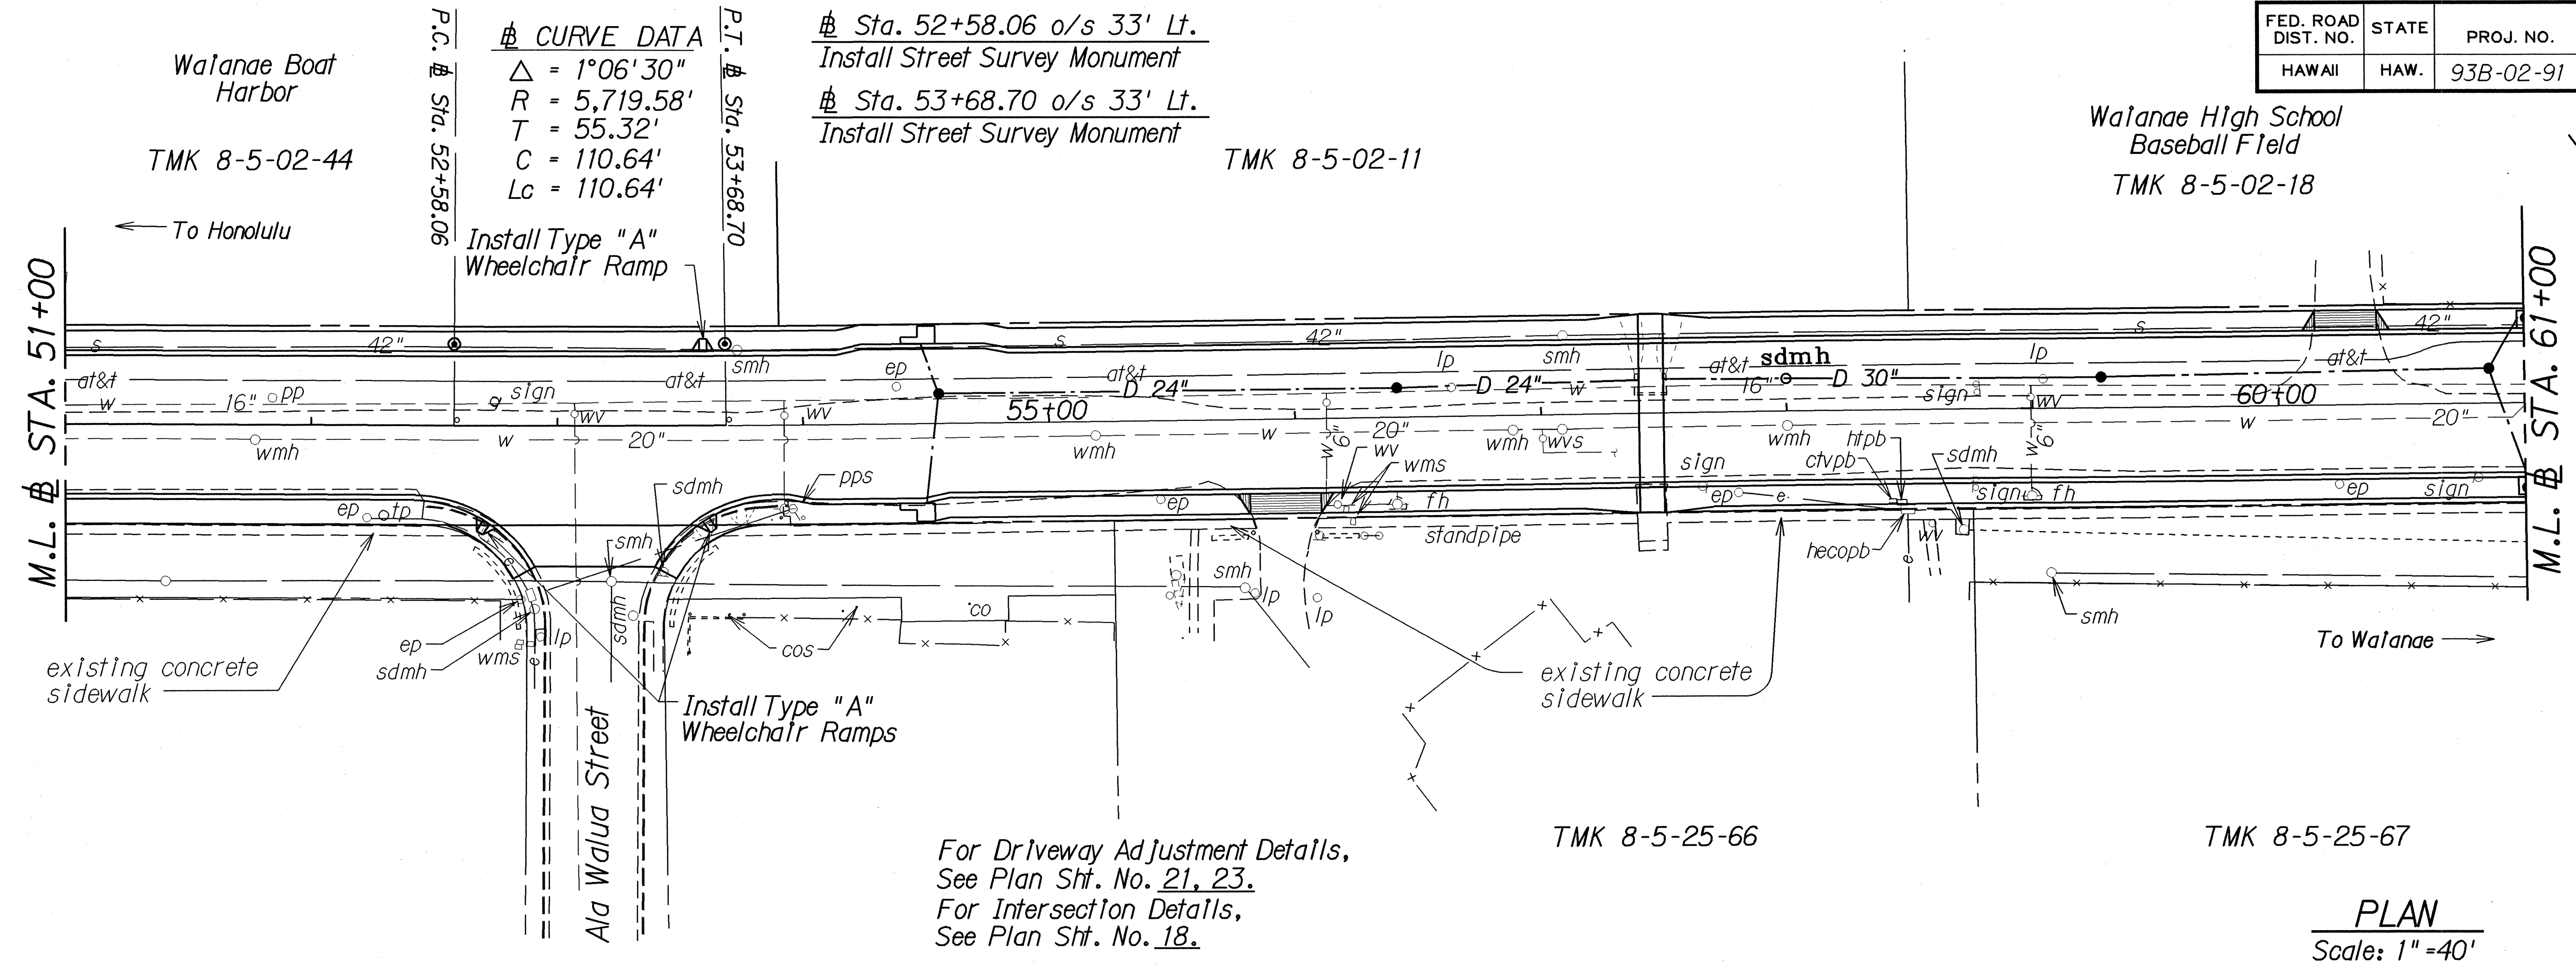

For Driveway Adjustment Details,
See Plan Sht. No. 21, 23.
For Intersection Details,
See Plan Sht. No. 18.

PLAN
Scale: 1"=40'

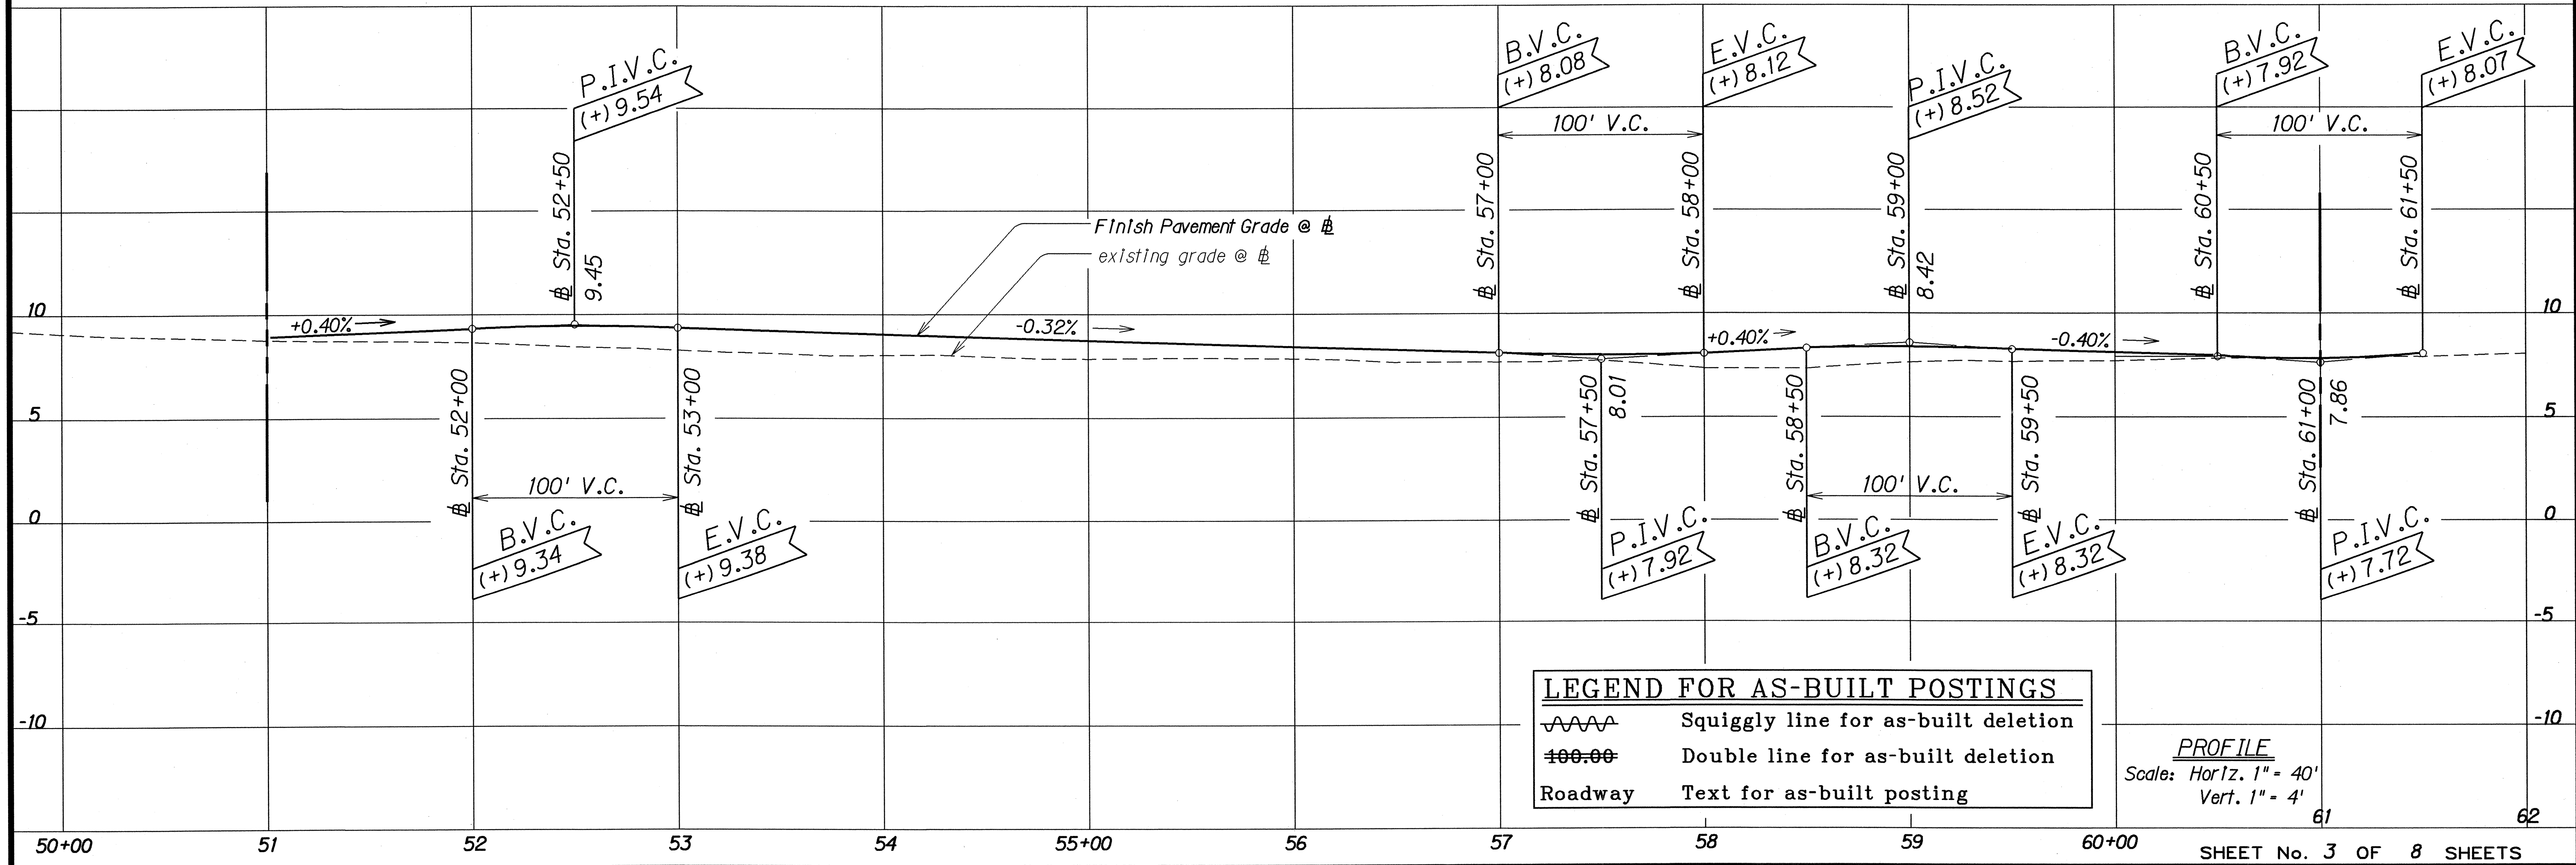



LEGEND FOR AS-BUILT POSTINGS	
	Squiggly line for as-built deletion
	Double line for as-built deletion
	Text for as-built posting

PROFILE
Scale: Horiz. 1"= 40'
Vert. 1"= 4'

ORIGINAL PLAN	DATE: 12-1-94
DESIGNED BY: R. Hironaka	
CHECKED BY: N. [illegible]	



"AS-BUILT"

FED. ROAD DIST. NO.	STATE	PROJ. NO.	FISCAL YEAR	SHEET NO.	TOTAL SHEETS
HAWAII	HAW.	93B-02-91	1994	11	122

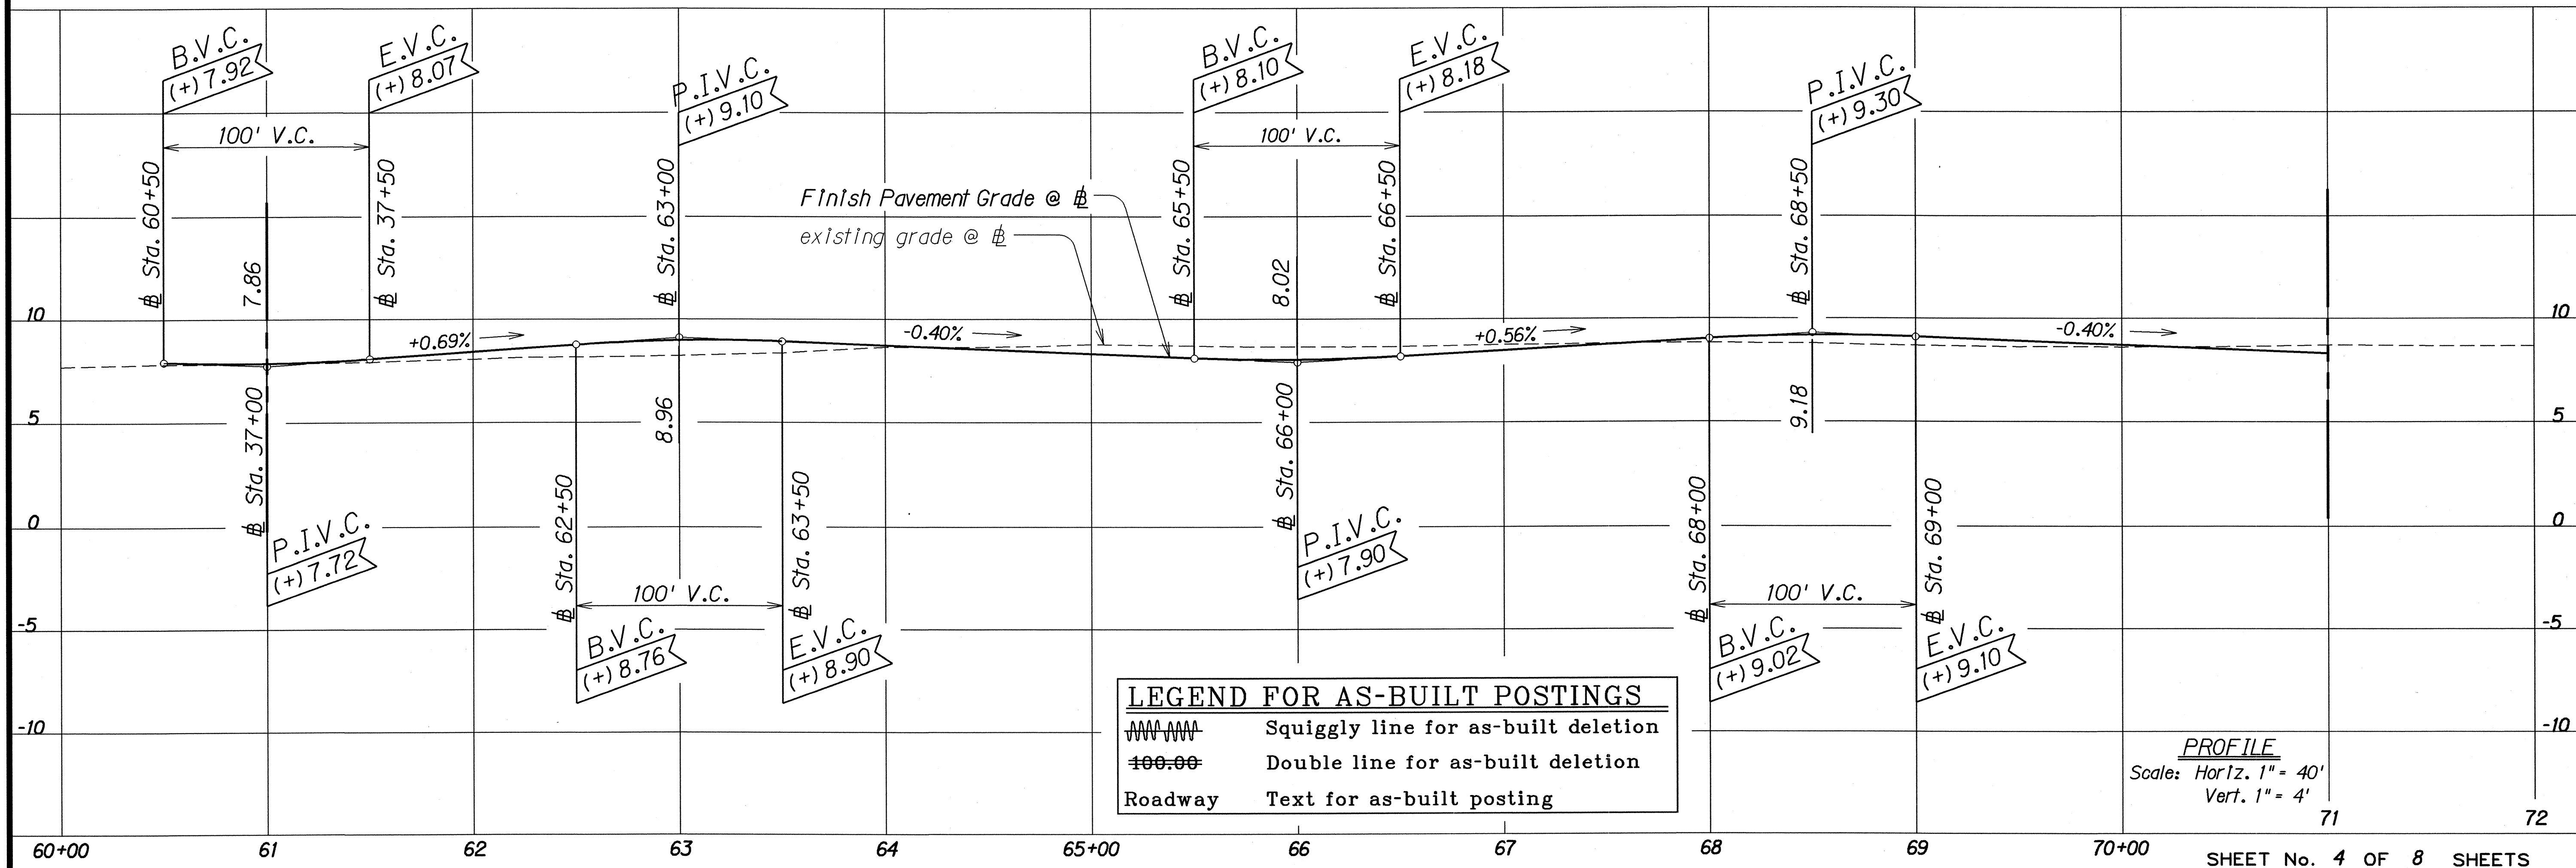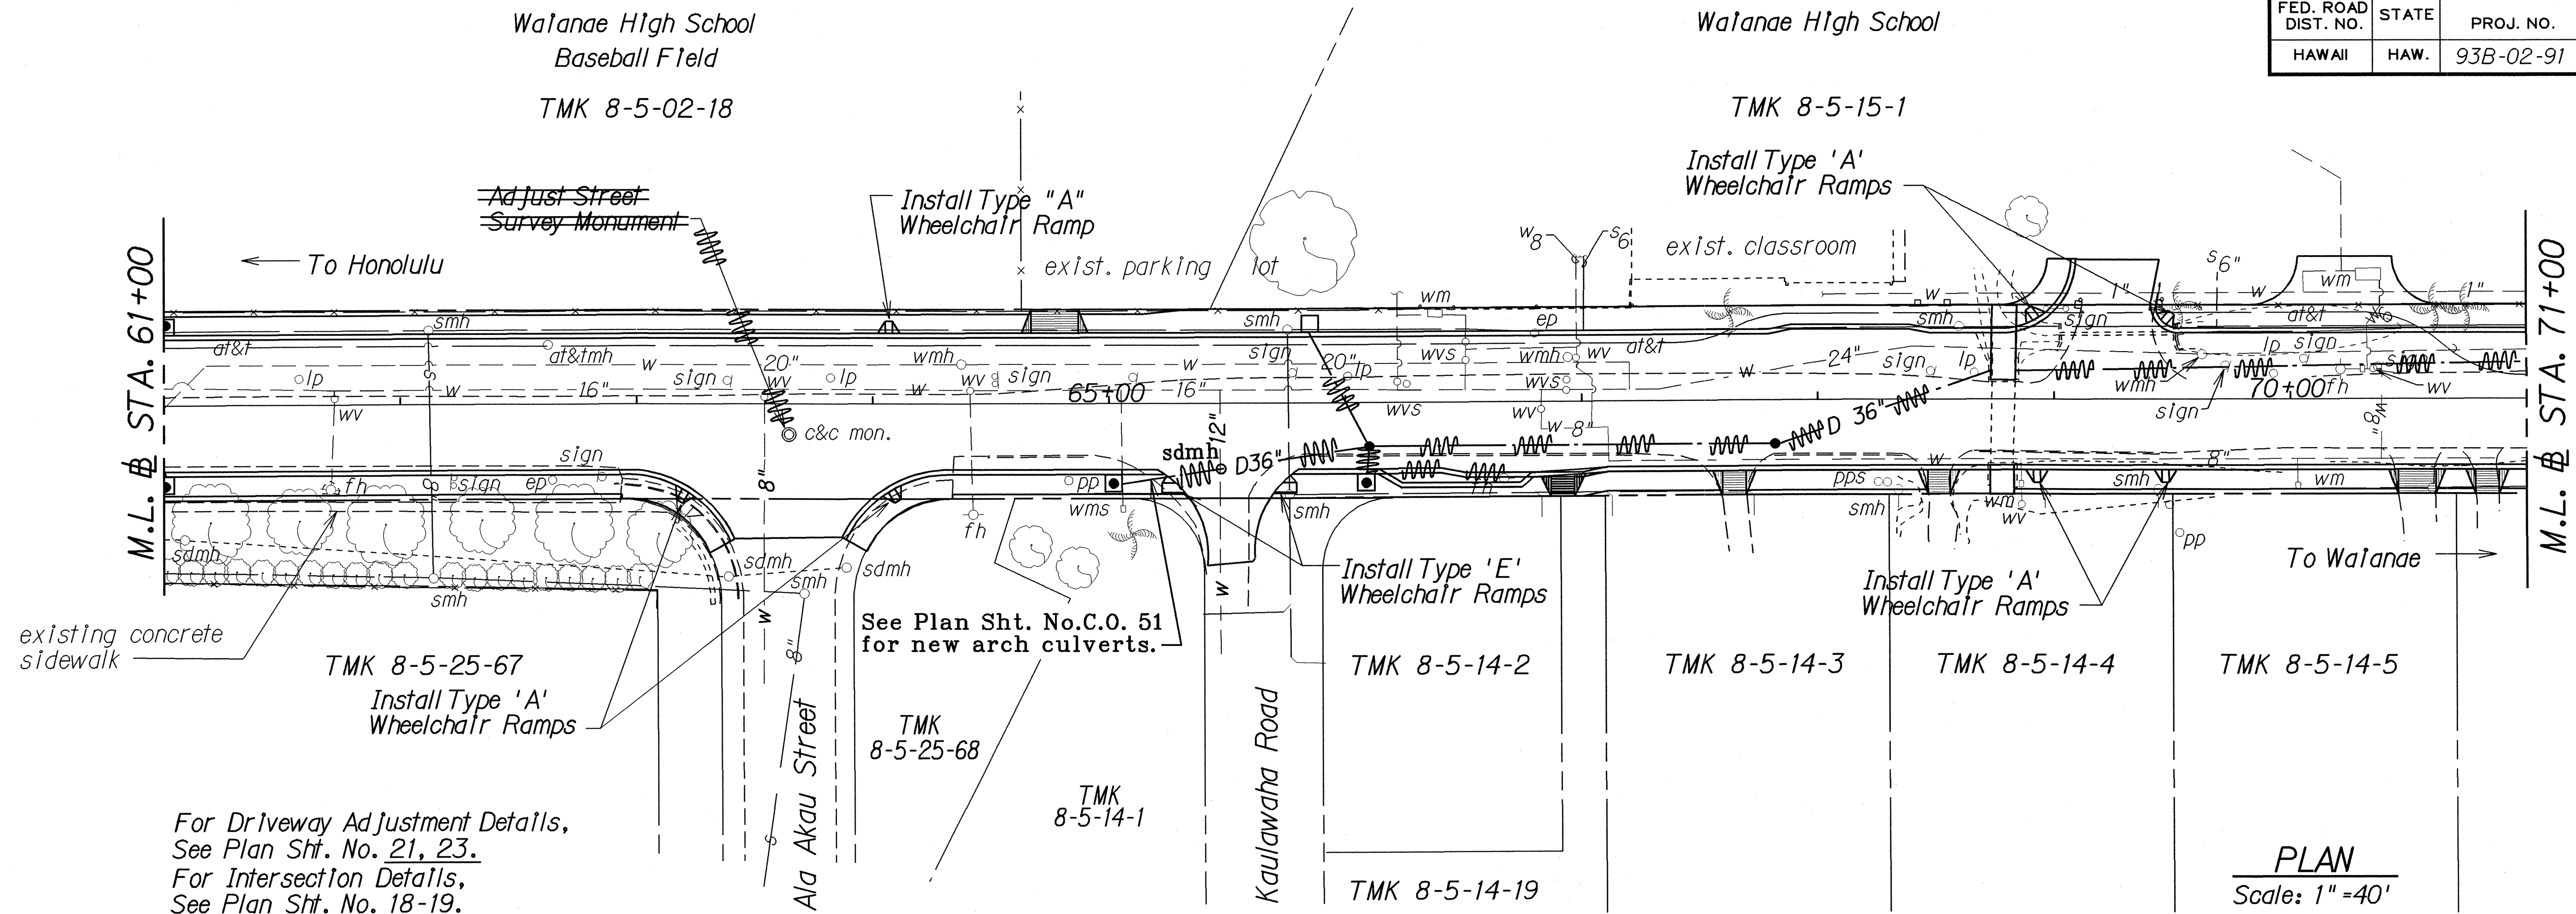

"AS-BUILT"



FED. ROAD DIST. NO.	STATE	PROJ. NO.	FISCAL YEAR	SHEET NO.	TOTAL SHEETS
HAWAII	HAW.	93B-02-91	1994	13	122

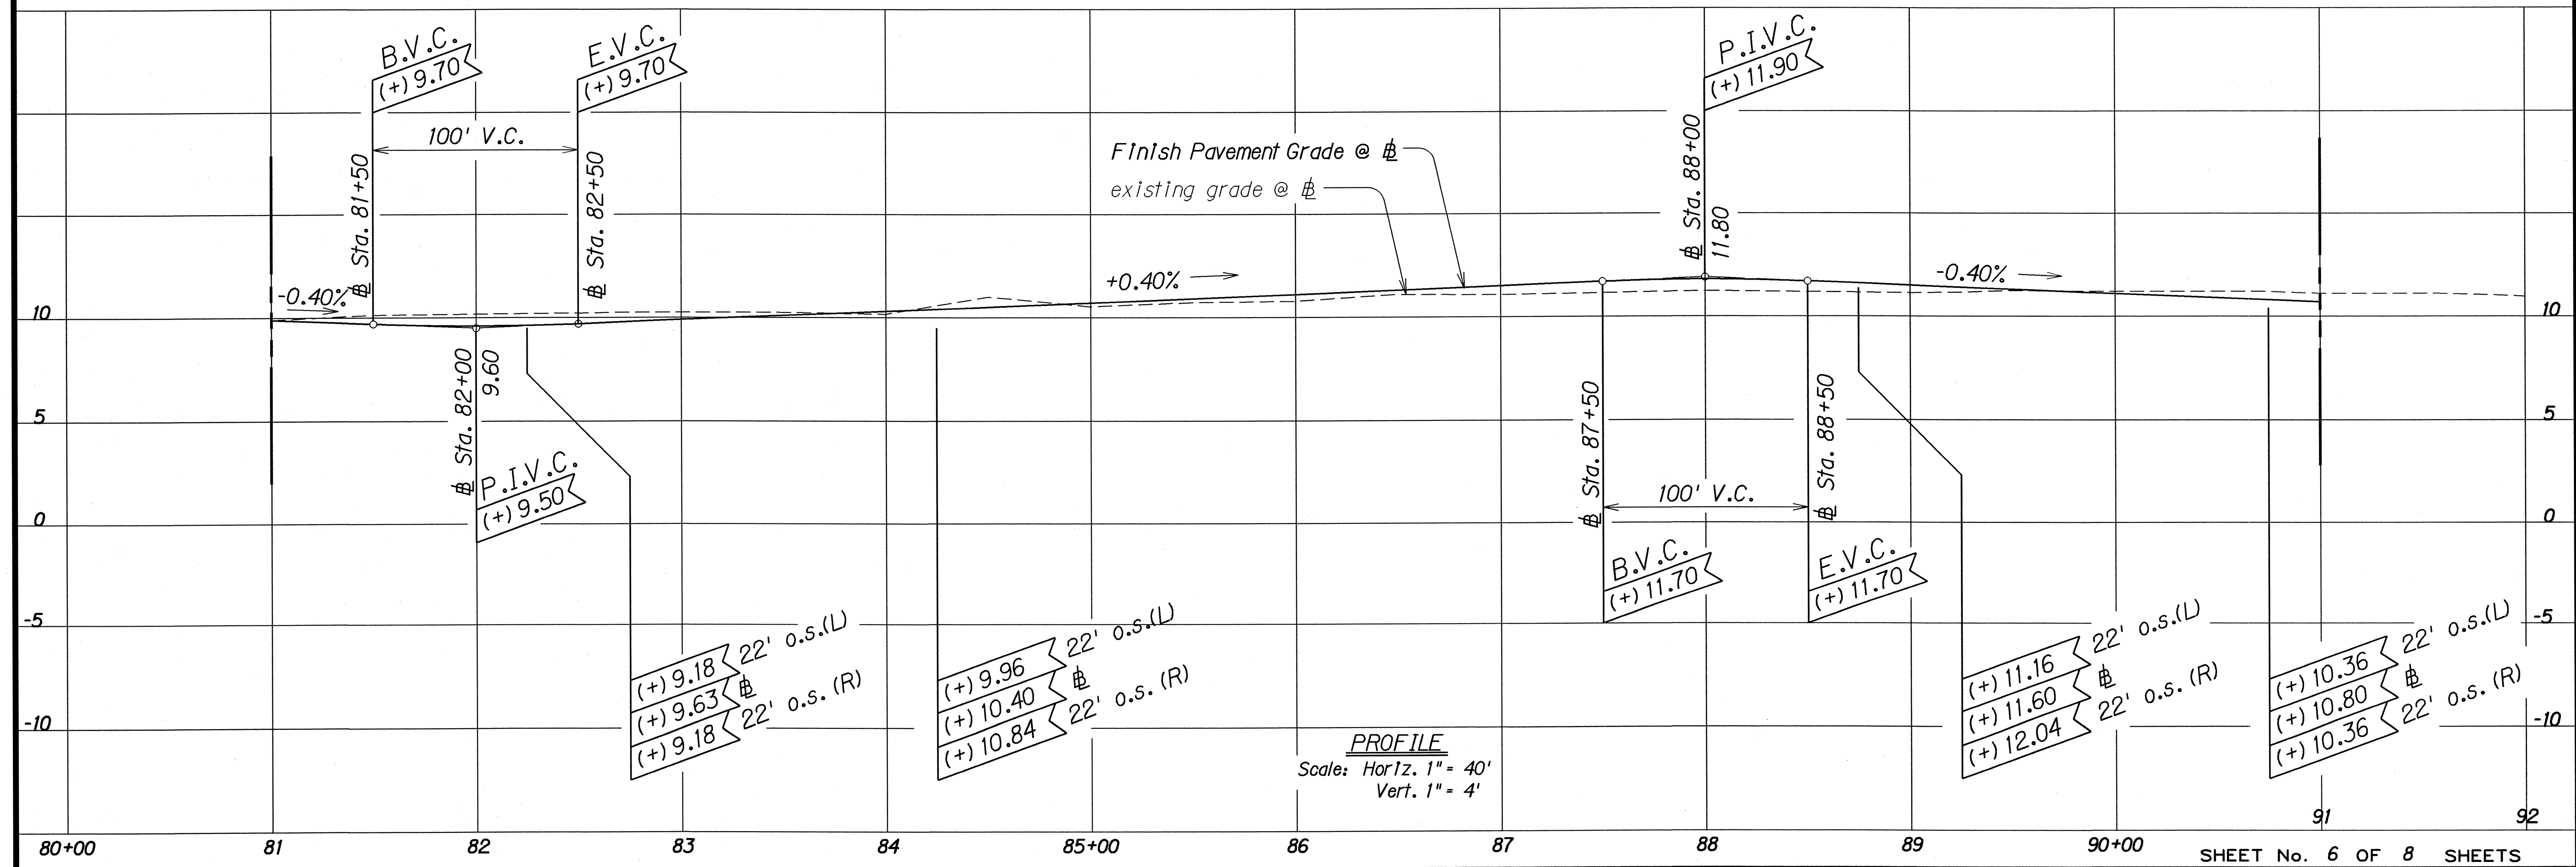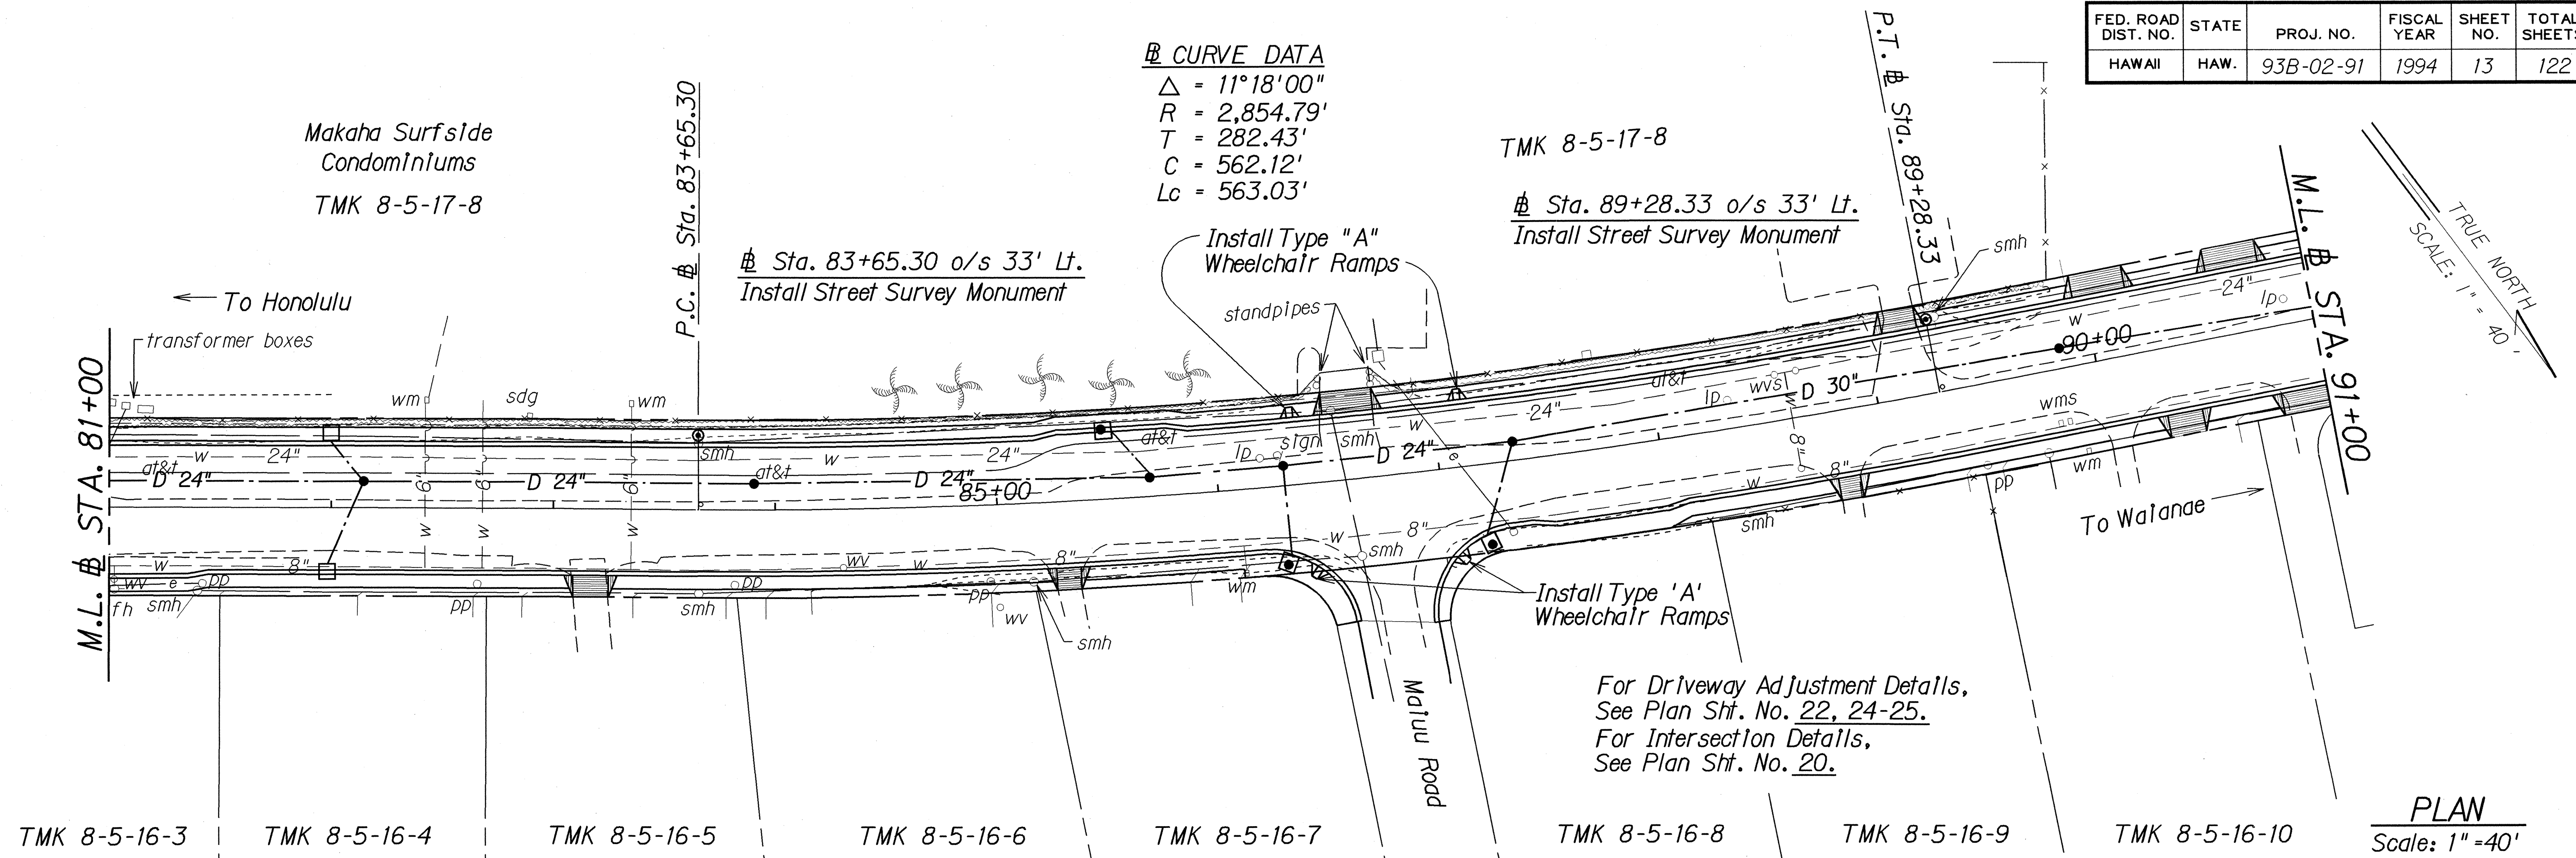

ORIGINAL PLAN	DATE 12-15-94
SURVEY PLOTTED BY	DESIGNED BY
NOTED BY	QUANTITIES BY
CHECKED BY	

SHEET No. 6 OF 8 SHEETS


FED. ROAD DIST. NO.	STATE	PROJ. NO.	FISCAL YEAR	SHEET NO.	TOTAL SHEETS
HAWAII	HAW.	93B-02-91	1994	14	122

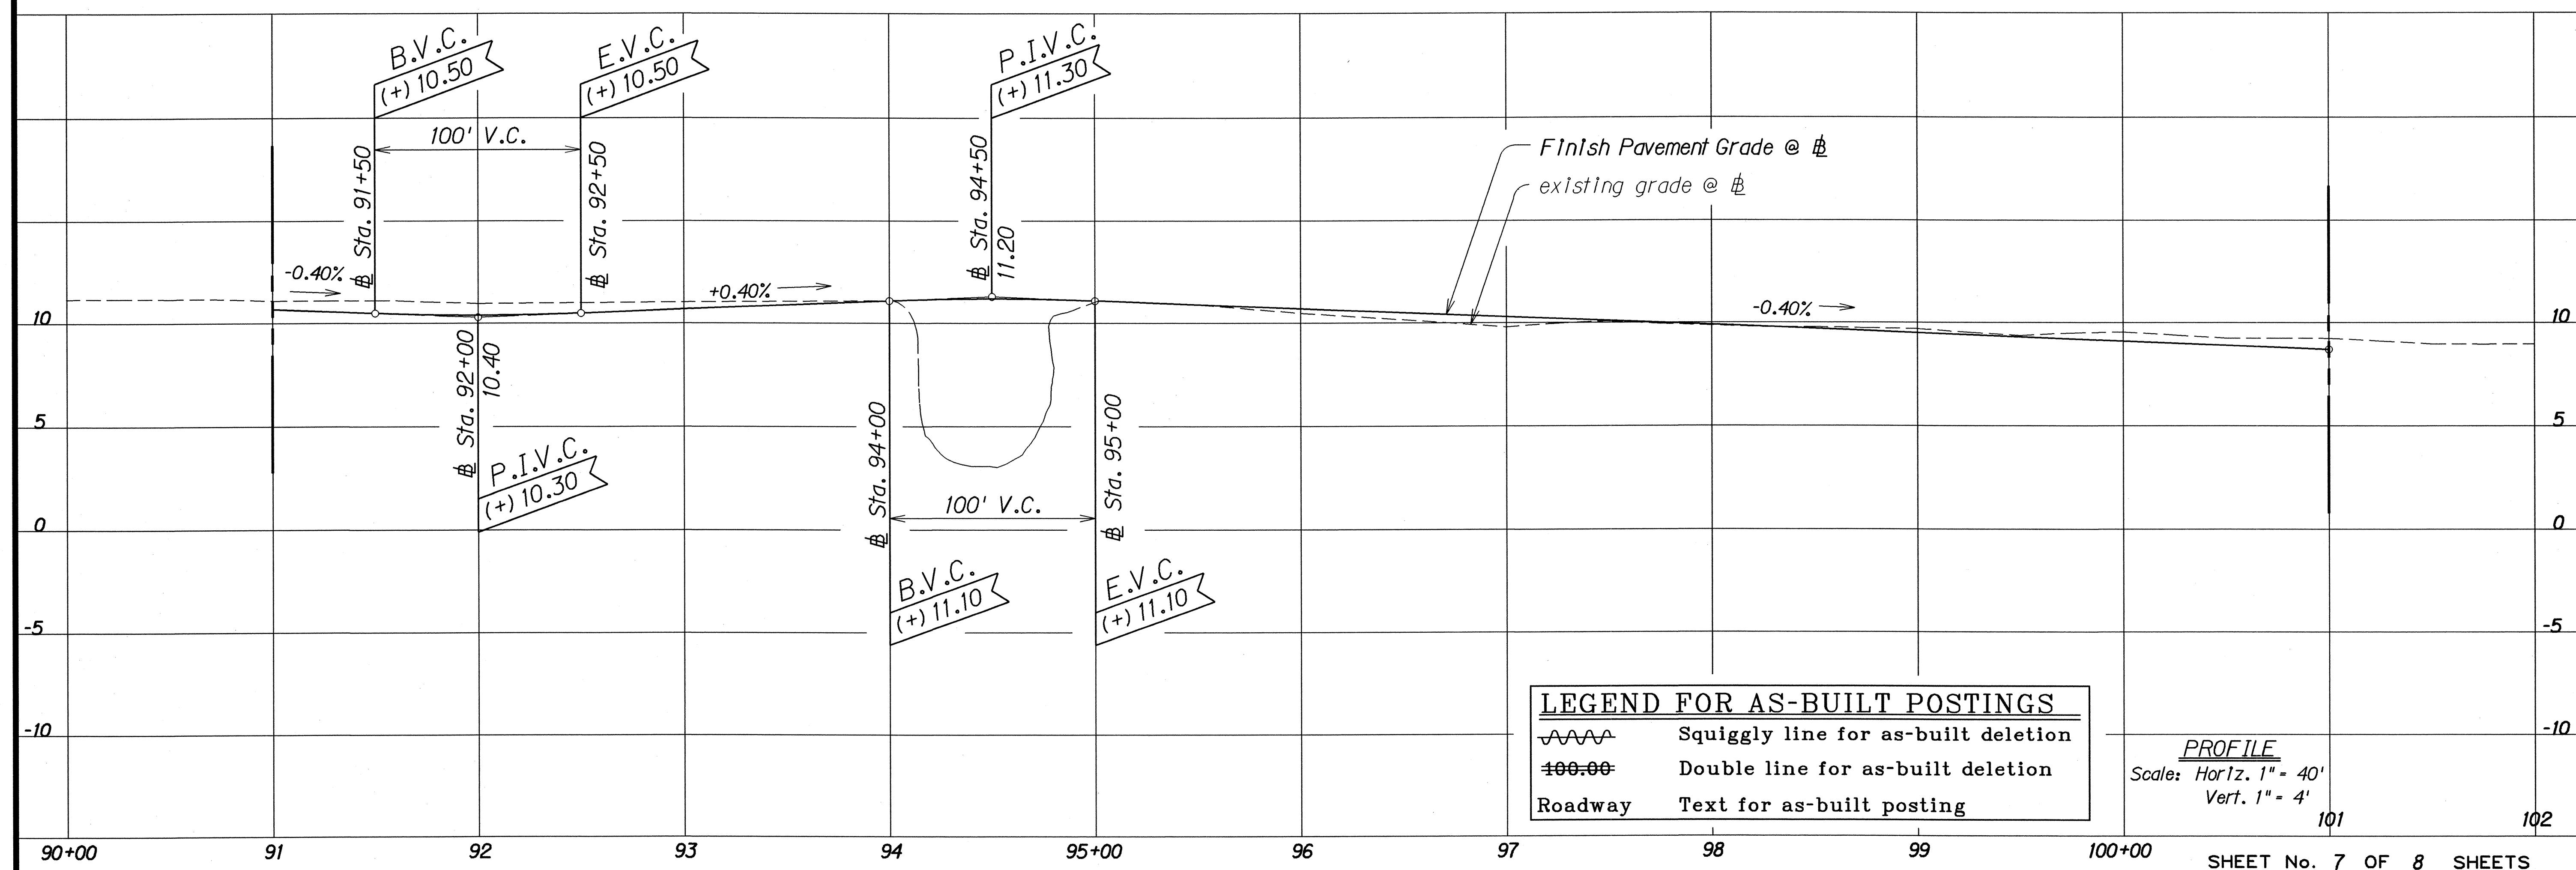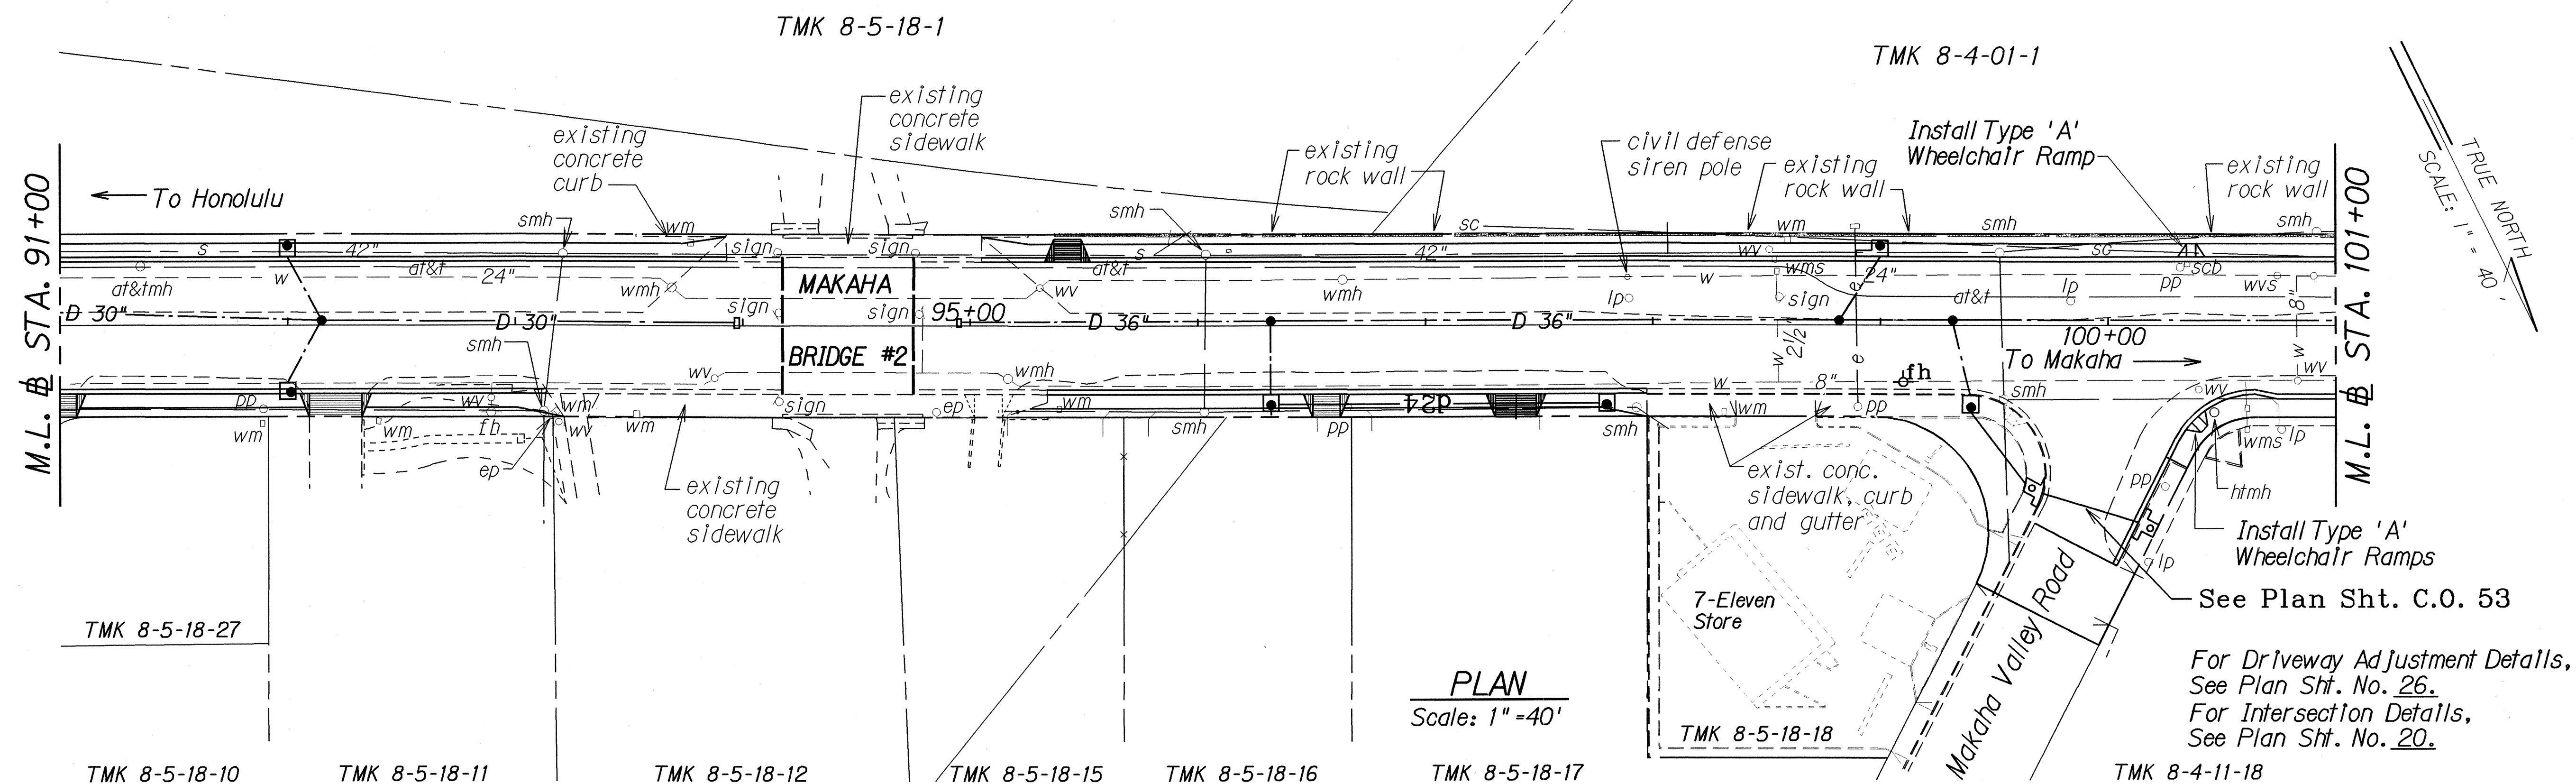


ORIGINAL PLAN	DATE
SURVEY PLOTTED BY	
DESIGNED BY	
QUANTITIES BY	
CHECKED BY	

"AS-BUILT"

FED. ROAD DIST. NO.	STATE	PROJ. NO.	FISCAL YEAR	SHEET NO.	TOTAL SHEETS
HAWAII	HAW.	93B-02-91	1994	15	122

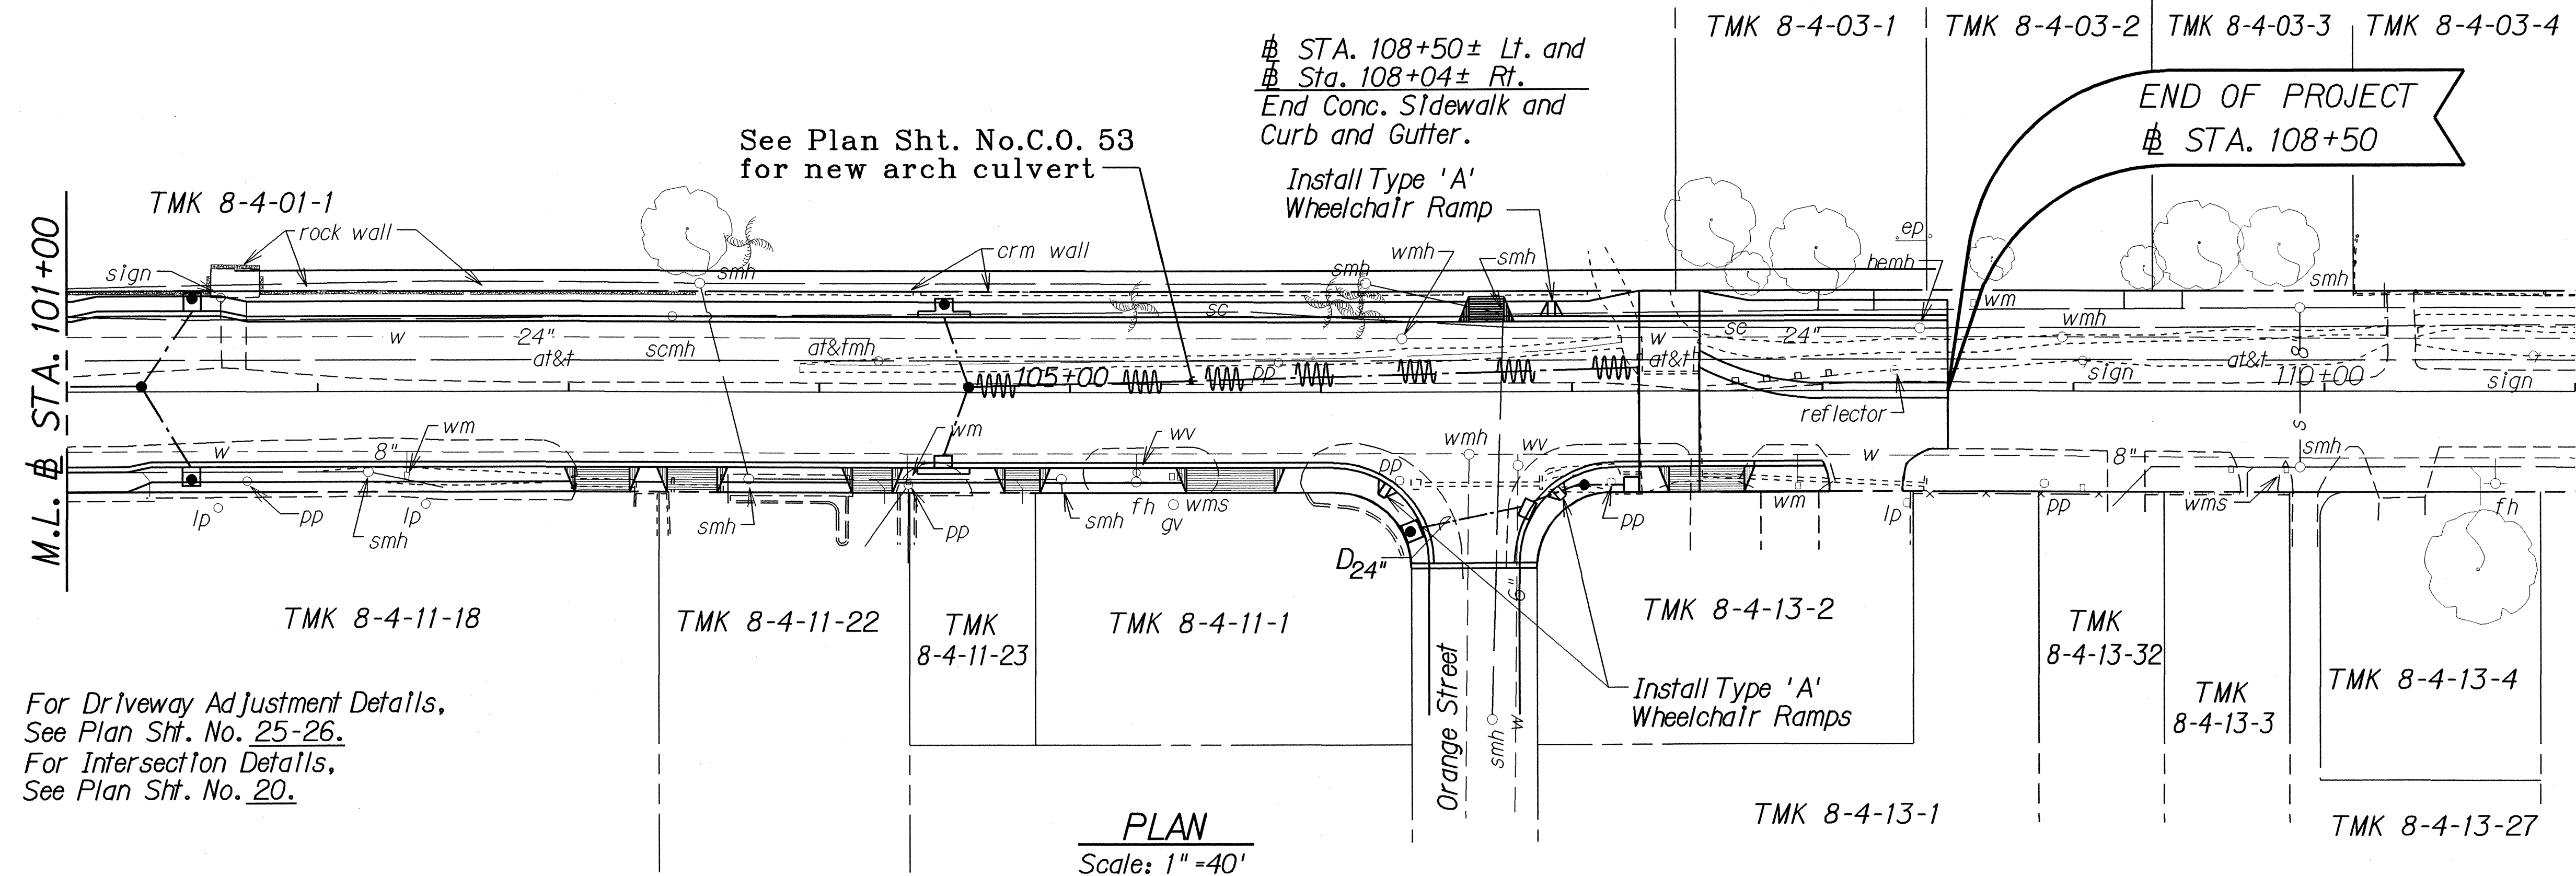

For Driveway Adjustment Details,
See Plan Sht. No. 25-26.
For Intersection Details,
See Plan Sht. No. 20.

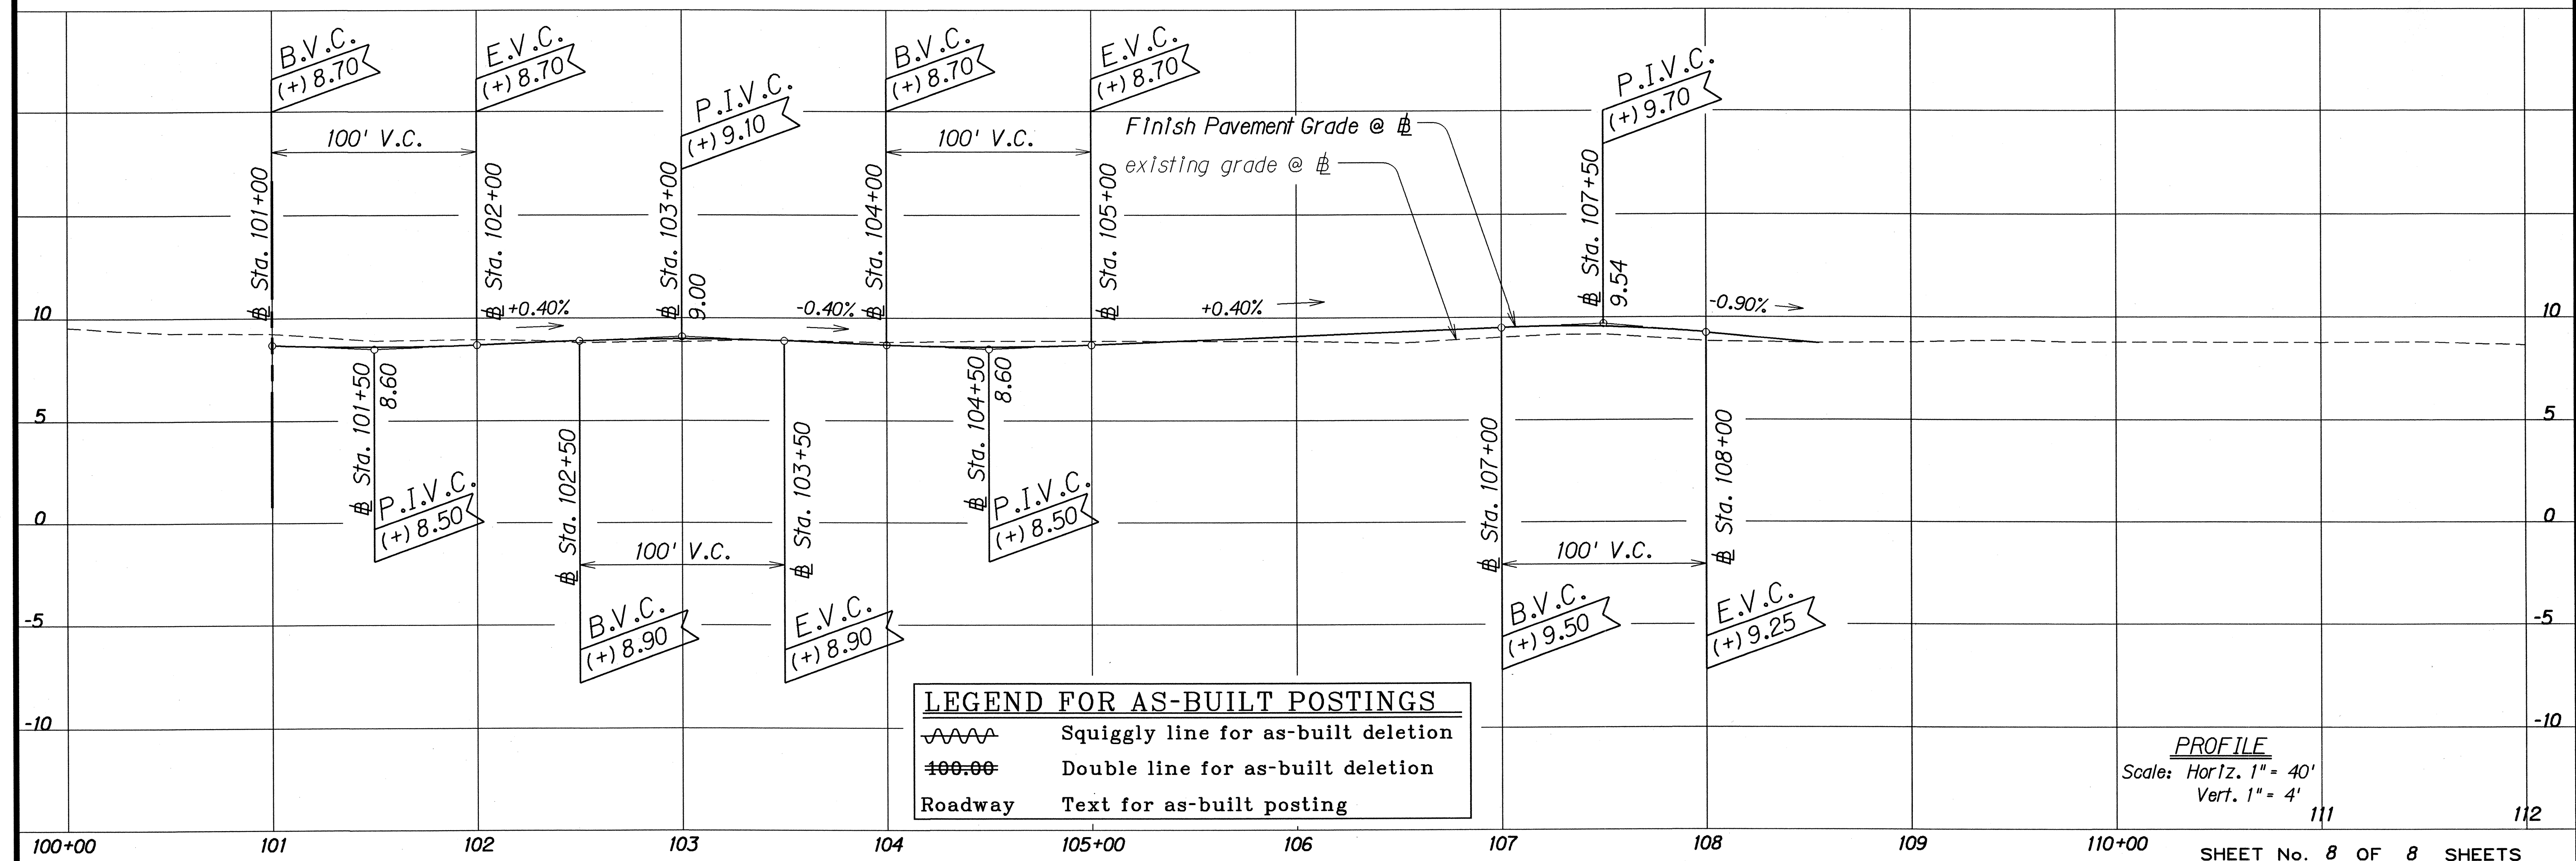

"AS-BUILT"