

FED. ROAD DIST. NO.	STATE	PROJ. NO.	FISCAL YEAR	SHEET NO.	TOTAL SHEETS
HAWAII	HAW.	93B-02-91	1994	106	122

TRAFFIC SIGNAL NOTES

- All traffic signal controller equipment shall be completely wired in the cabinet and shall control the traffic signals as called for in the plans.
- Signal indications during clearance interval:
 - If a signal is G or <G and will remain G or <G during the next phase, it shall be G or <G during the clearance interval.
 - If a signal is G or <G and will become R or extinguished during the next phase, it shall be Y or <Y during the clearance interval.
 - If a signal is R and will remain R or becomes G during the next phase, it shall remain R during the clearance interval.
- A solid #8 bare copper wire shall be pulled with the traffic control cable for equipment ground. Cost shall be incidental to the installation of the control cable
- Contractor shall install meter socket and breaker on the power pole as shown on the plans in accordance with HECO requirements. Meter shall be mounted between 5' and 7' above ground. Meter sockets shall be 4-prong, complete with a manual circuit closing device.
- The loop amplifier units furnished for this project shall be capable of operating the loop detector configurations shown on the plans.
- Detector assignment shall be per California Department of Transportation "Traffic Signal Control Local Intersection Program", July 1978.
- The Contractor shall furnish 50 amp circuit breakers.


LEGEND

(Note: Existing shown as dashed on-plan)

- | | |
|--|--|
| | Controller Cabinet |
| | Type "A" Pullbox |
| | Type "B" Pullbox |
| | Type "Z" Pullbox |
| | Traffic Signal Standard |
| | Traffic Signal Heads Mounted on Type II Signal Standard, Arm Spread Shown is 30' and Distance Between Signal Head is 12' |
| | Standard Traffic and Pedestrian Signal Heads Mounted on Type I Signal Height - 10' |
| | |

CONSTRUCTION NOTES


- Locations of existing underground structures and utilities such as pipelines, conduits, cables, etc. shown on plans are approximate only. It is not the intent of these plans to show the exact location of all underground utilities and structures. It is the responsibility of the Contractor to verify the locations of all existing utilities with the respective owners. Existing utilities damaged by the Contractor shall be repaired by the Contractor at his own cost.
- The locations of the traffic signal standards, traffic signal standards with mast-arm, pedestrian push buttons, traffic controller, pullboxes, conduits and loop detectors shall be staked out in the field by the Contractor and approval of the locations shall be obtained from the Engineer prior to construction and installation.
- All traffic signal work shall conform to the requirements of the "Manual On Uniform Traffic Control Devices For Streets And Highways", Federal Highway Administration (1984) and Amendments.
- Locations of traffic markings and markers (lane lines, stop lines, crosswalk, etc.) shown on the plans shall be verified with the Engineer prior to the installation of the traffic signal system.
- Maintenance of traffic through the construction area shall be in accordance with part VI of the "Manual On Uniform Traffic Control Devices For Streets And Highways", Federal Highway Administration (1984) and as specified in the special provisions. The Contractor shall furnish and maintain adequate barricades, blinkers, construction signs, etc., for the safety of the motoring public.
- Department of Transportation Services, City and County of Honolulu, will assist the Engineer in construction inspection for the traffic signal system.
- Where required by the plans, signs and/or posts shall be removed. Costs shall be incidental to other items of work.

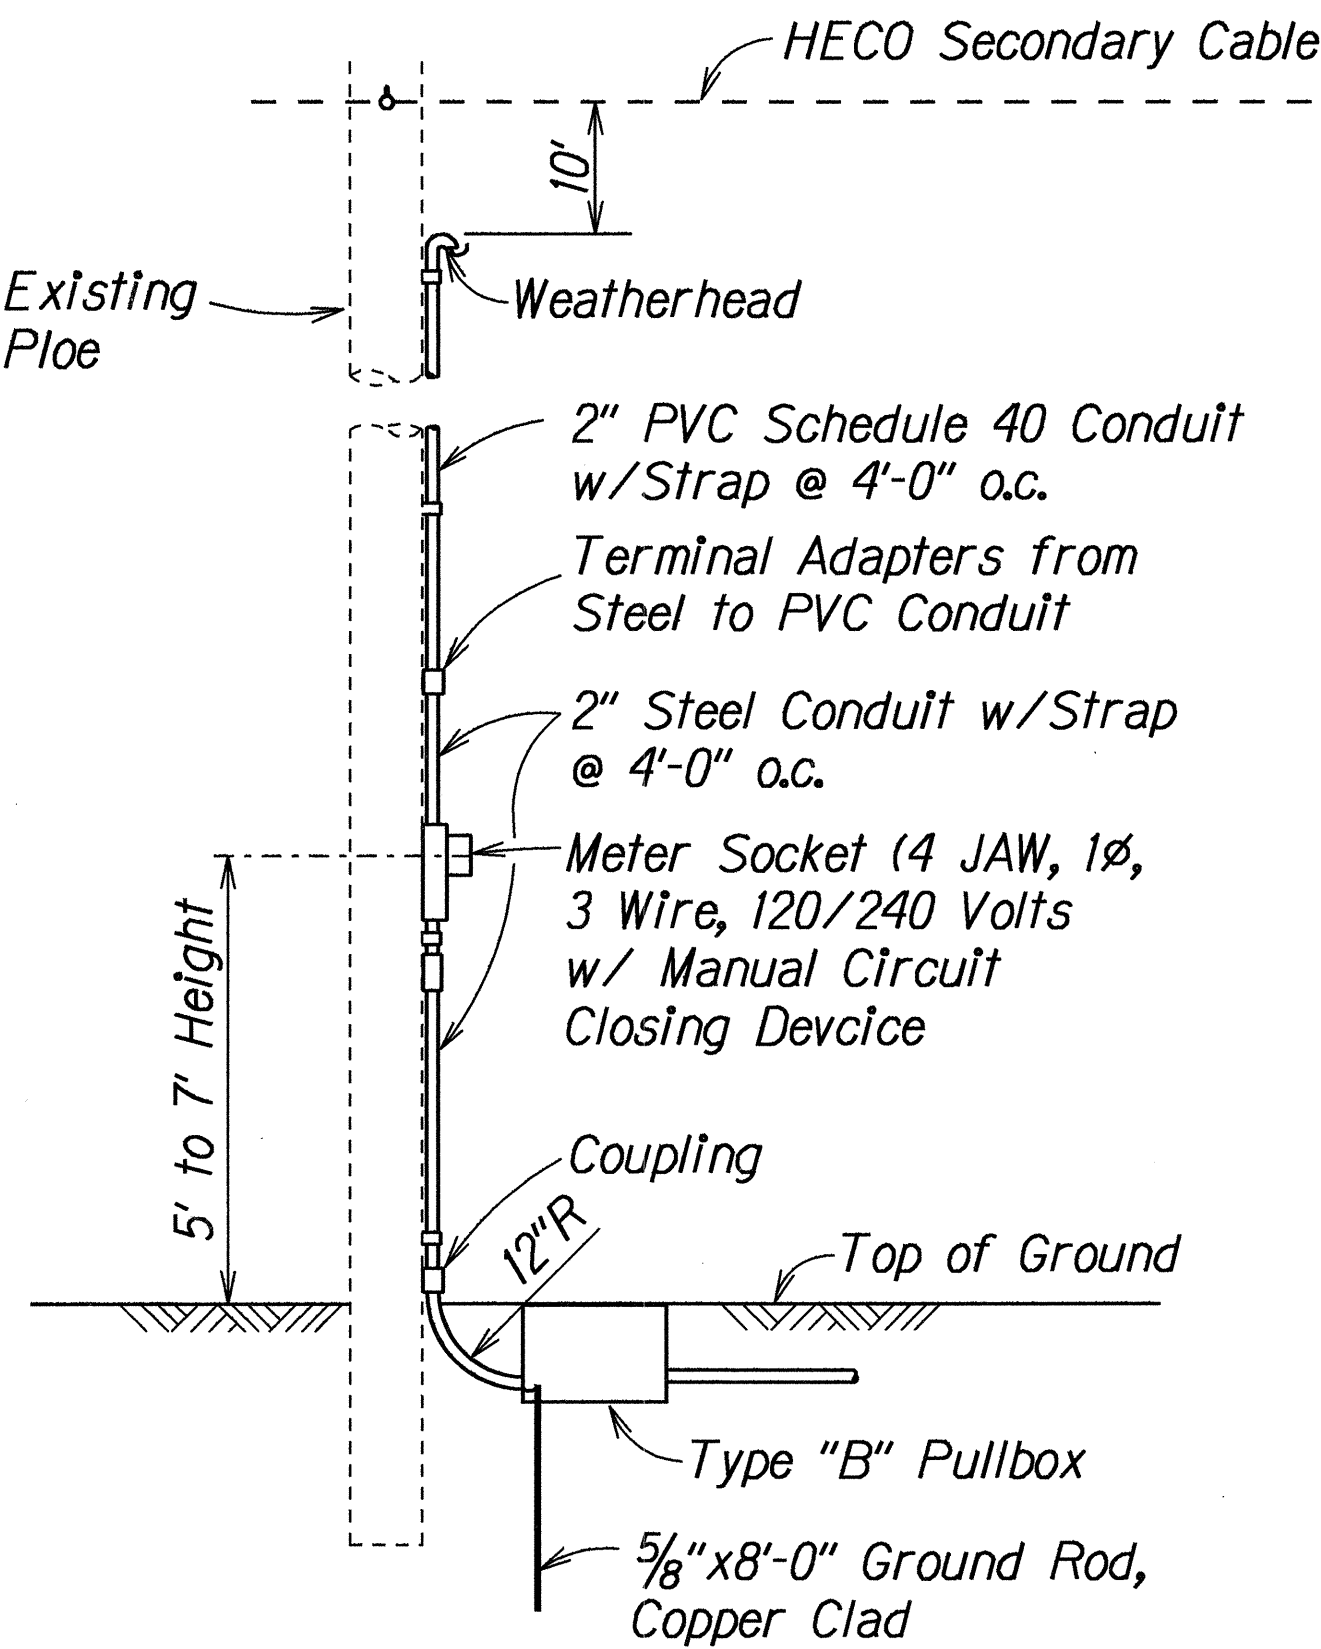


SERVICE POLE DETAIL

Not to Scale

NOTE:
Cost of concrete filled galvanized posts shall be incidental to other items of work.

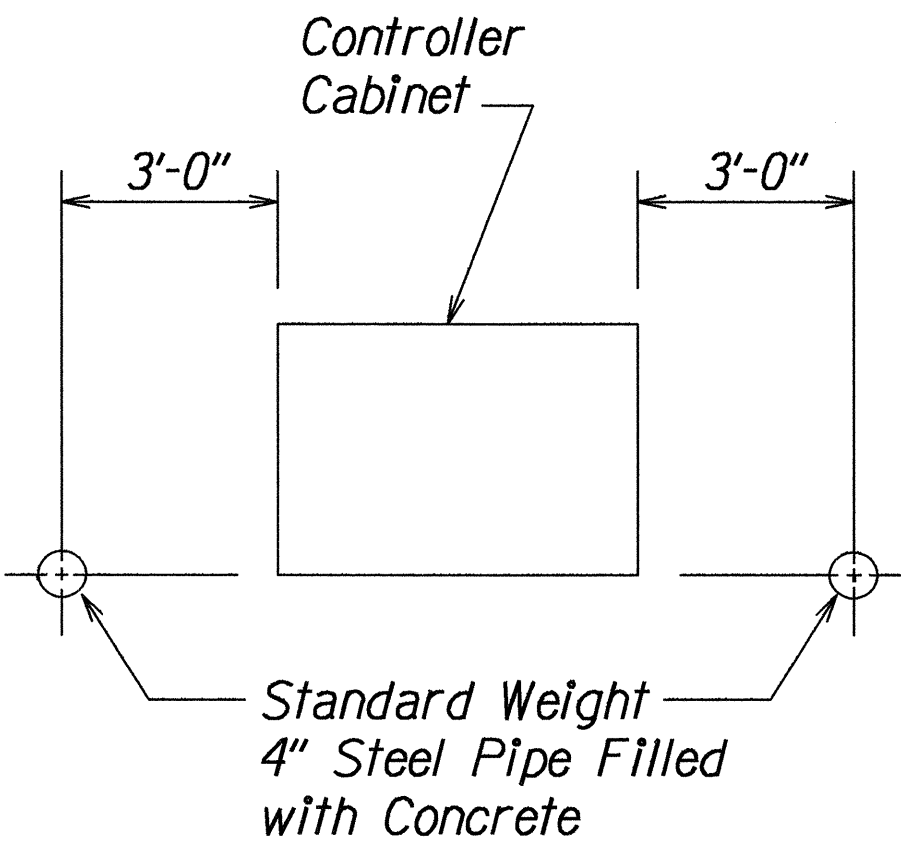


PLAN

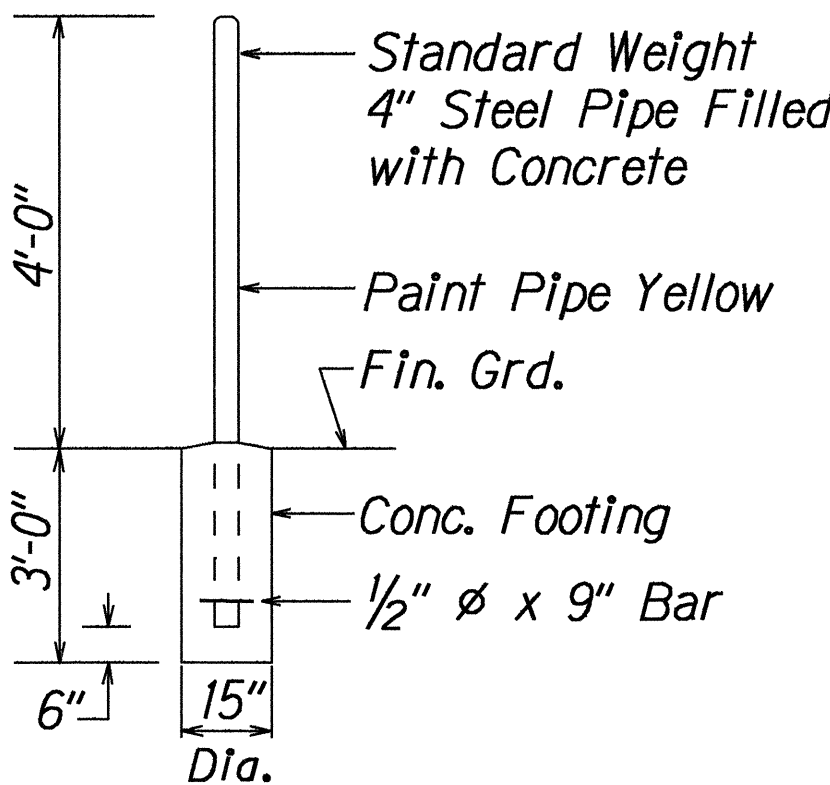

TYP. ELEVATION

PIPE GUARD DETAIL

Not to Scale

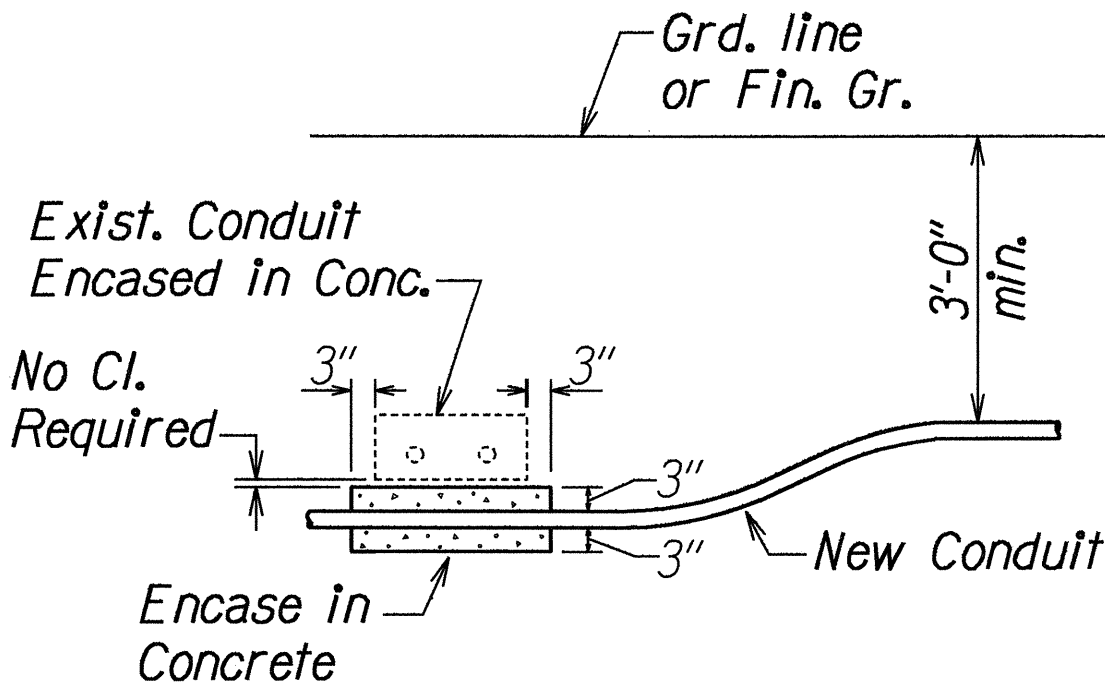

CONDUIT BY-PASS DETAIL

Not to Scale


STATE OF HAWAII
DEPARTMENT OF TRANSPORTATION
HIGHWAYS DIVISION

**TRAFFIC SIGNAL
LEGEND, DETAILS & NOTES**


FARRINGTON HIGHWAY WIDENING
Ala Hema Street to Jade Street
Project No. 93B-02-91

Scale: As noted Date: Jan., 1994
SHEET No. TS-1 OF 4 SHEETS


FED. ROAD DIST. NO.	STATE	PROJ. NO.	FISCAL YEAR	SHEET NO.	TOTAL SHEETS
HAWAII	HAW.	93B-02-91	1994	C.O. 107	122

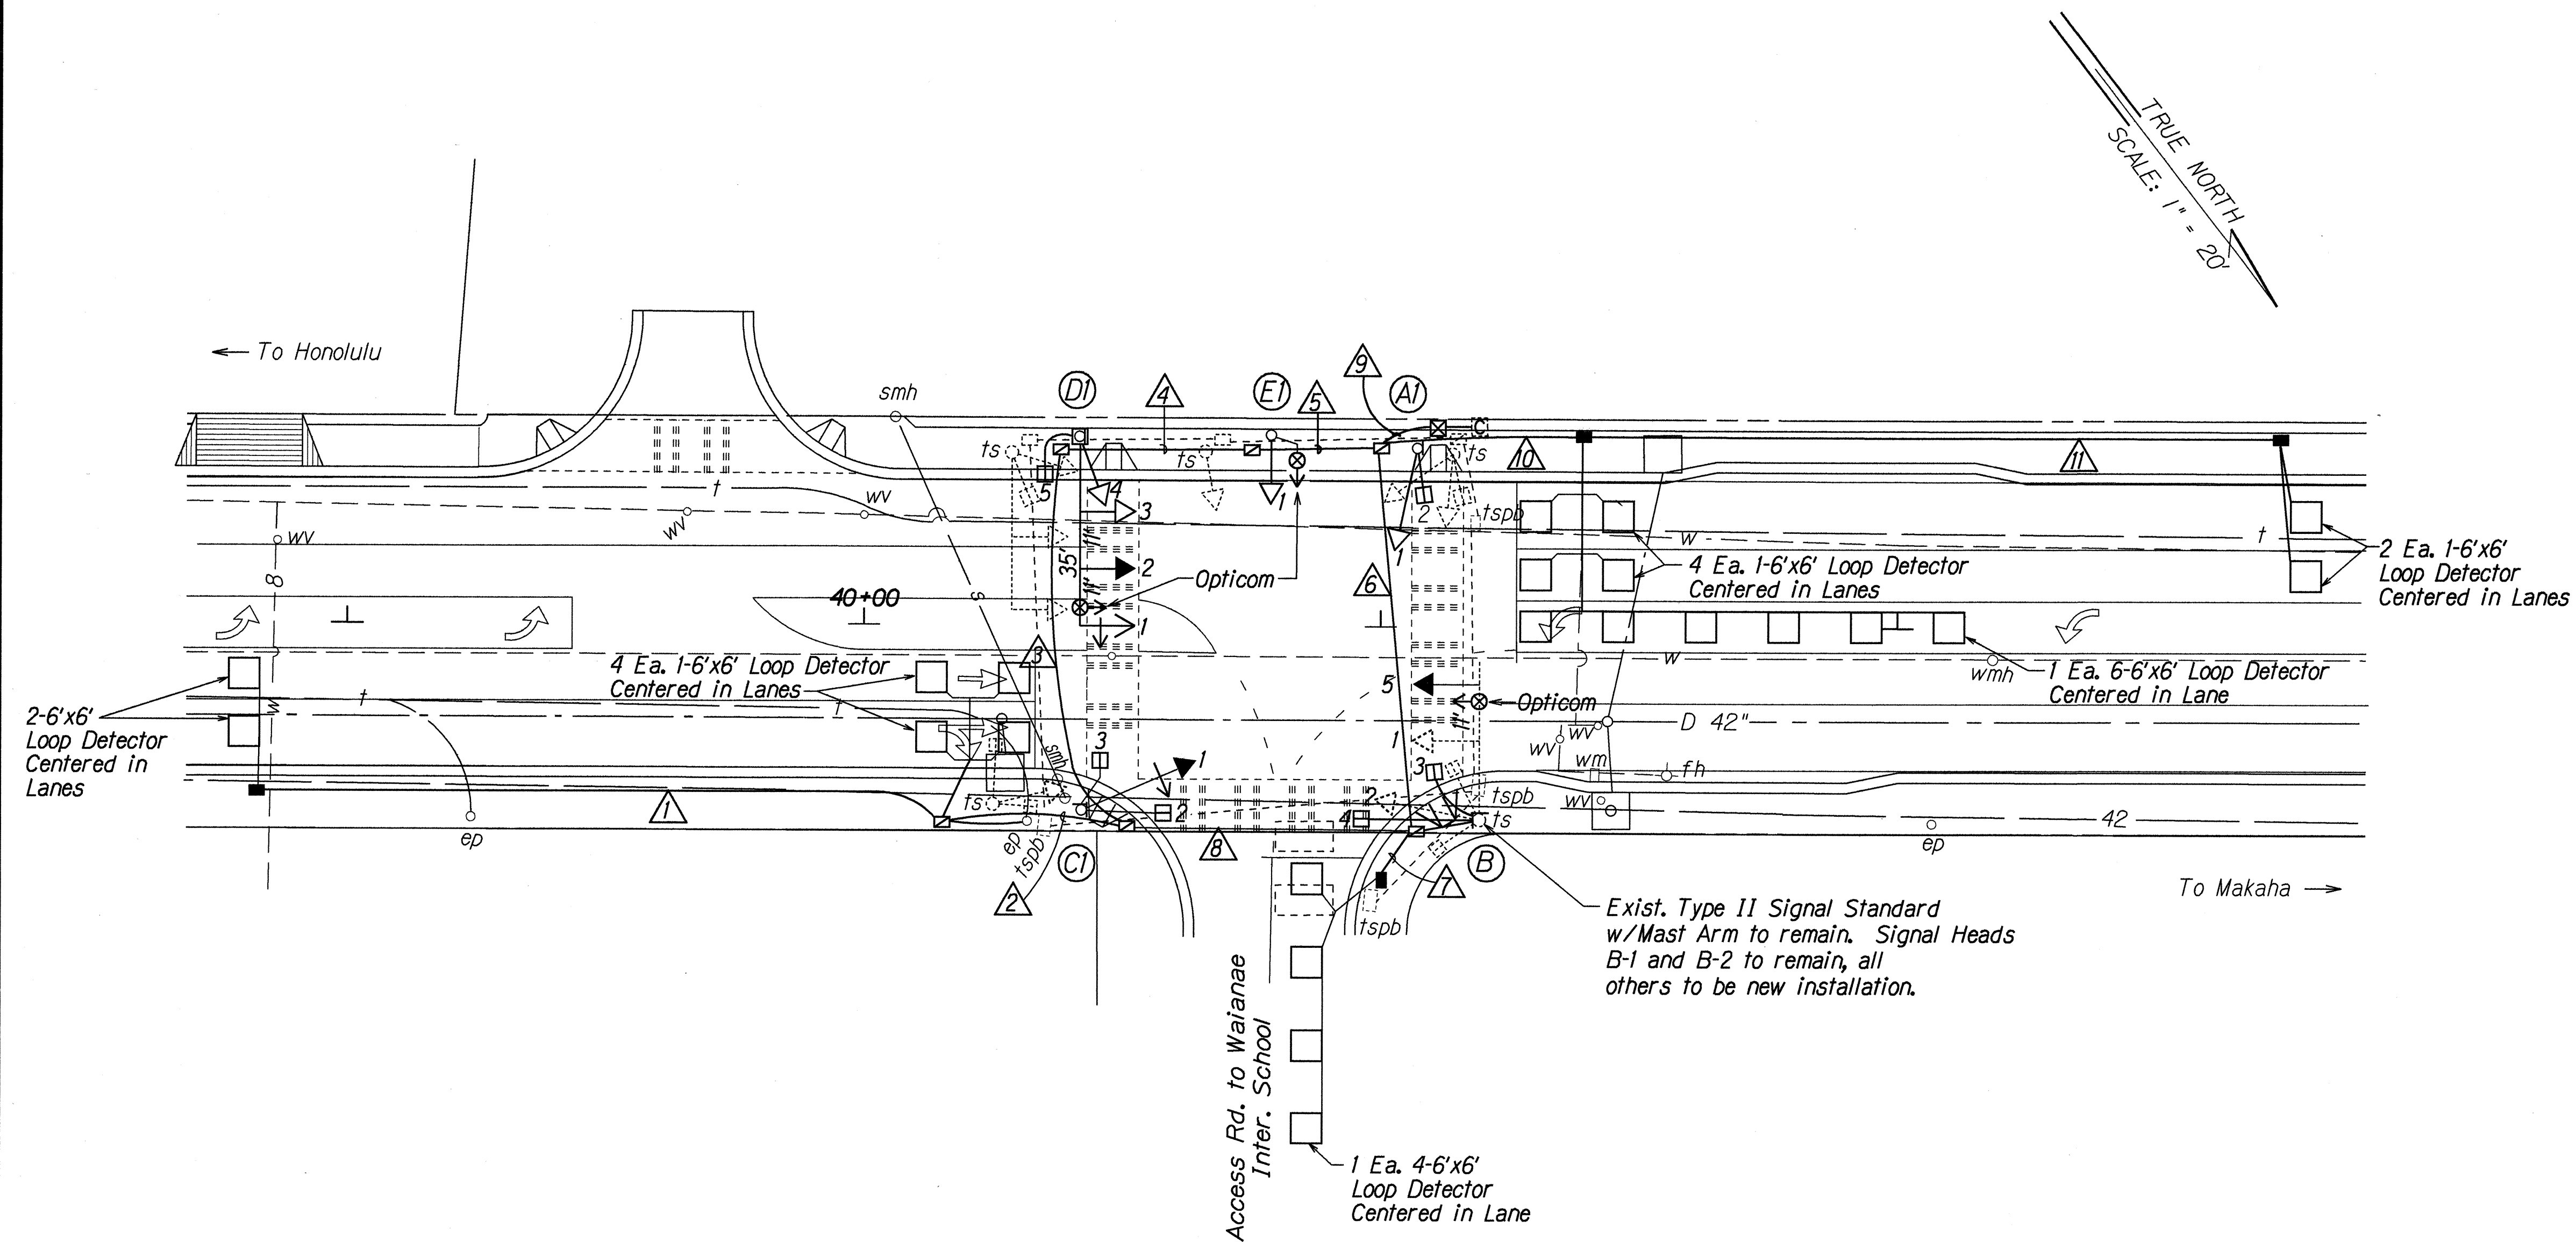


CONDUIT & CABLE SCHEDULE		
Δ	CONDUIT	CABLE
1	1-2"	1 - 2c #14
2	2-2"	2 - 2c #14 1 - 3c #6
3	3-2"	1 - 26c #14 4 - 2c #14 1 - 3c #6
4	3-2"	1 - 26c #14 4 - 2c #14 1 - 3c #6
5	3-2"	1 - 26c #14 4 - 2c #14 1 - 3c #6
6	2-2"	1 - 2c #14 3 - 2c #14
7	1-2"	1 - 2c #14
8	2-2"	1 - 26c #14 Spare
9	5-2"	1 - 26c #14 1 - 2c #14 5 - 2c #14 5 - 2c #14 1 - 3c #6
10	1-2"	4 - 2c #14
11	1-2"	1 - 2c #14

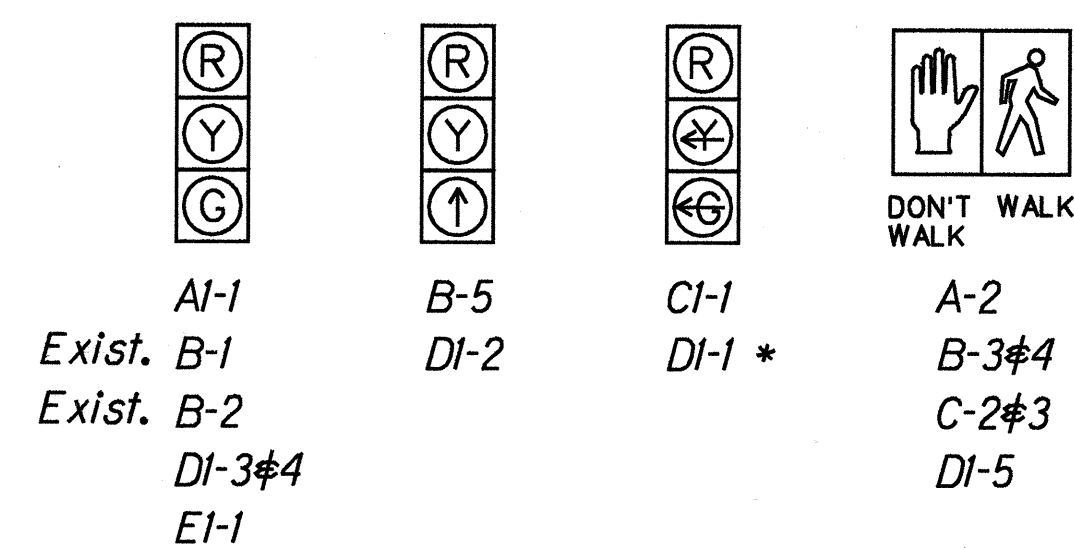


SIGNAL INDICATIONS

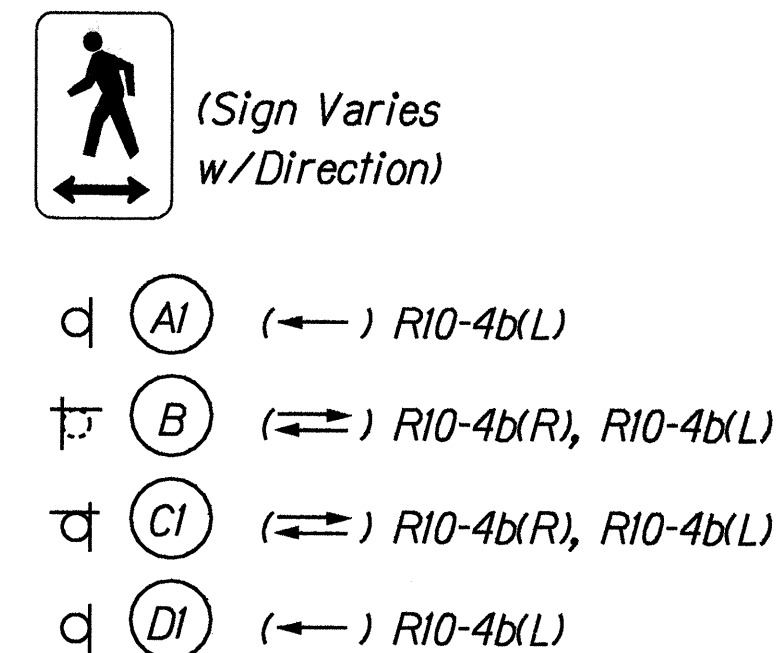

PEDESTRIAN PUSH
BUTTON w/Sign (NEW)

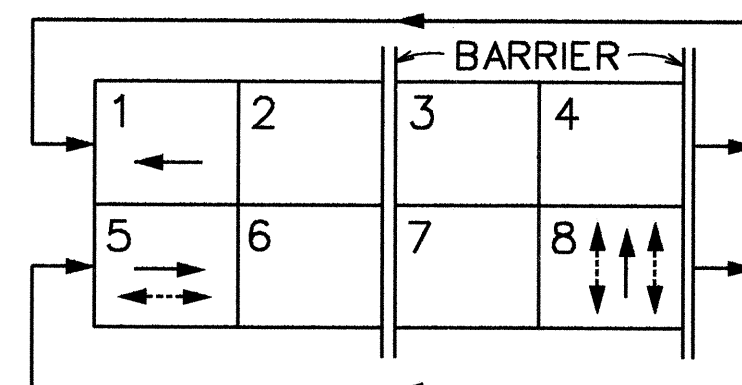

EXISTING PHASE DIAGRAM

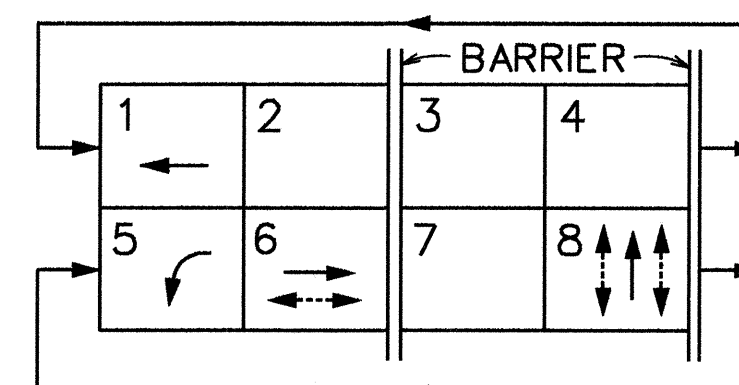

NEW PHASE DIAGRAM

10/7/97 Revised Loop Detector Locations and Additional Loops Added to accomodate revised striping.

DATE REVISION


STATE OF HAWAII
DEPARTMENT OF TRANSPORTATION
HIGHWAYS DIVISION
TRAFFIC SIGNAL PLAN
Access Road to Waianae Inter. School
FARRINGTON HIGHWAY WIDENING
Ala Hema Street to Jade Street
Project No. 93B-02-91

Scale: 1"=20' Date: Jan., 1994

SHEET No. TS-2 OF 4 SHEETS


C.O. 107

FED. ROAD DIST. NO.	STATE	PROJ. NO.	FISCAL YEAR	SHEET NO.	TOTAL SHEETS
HAWAII	HAW.	93B-02-91	1994	C.O. 108	122

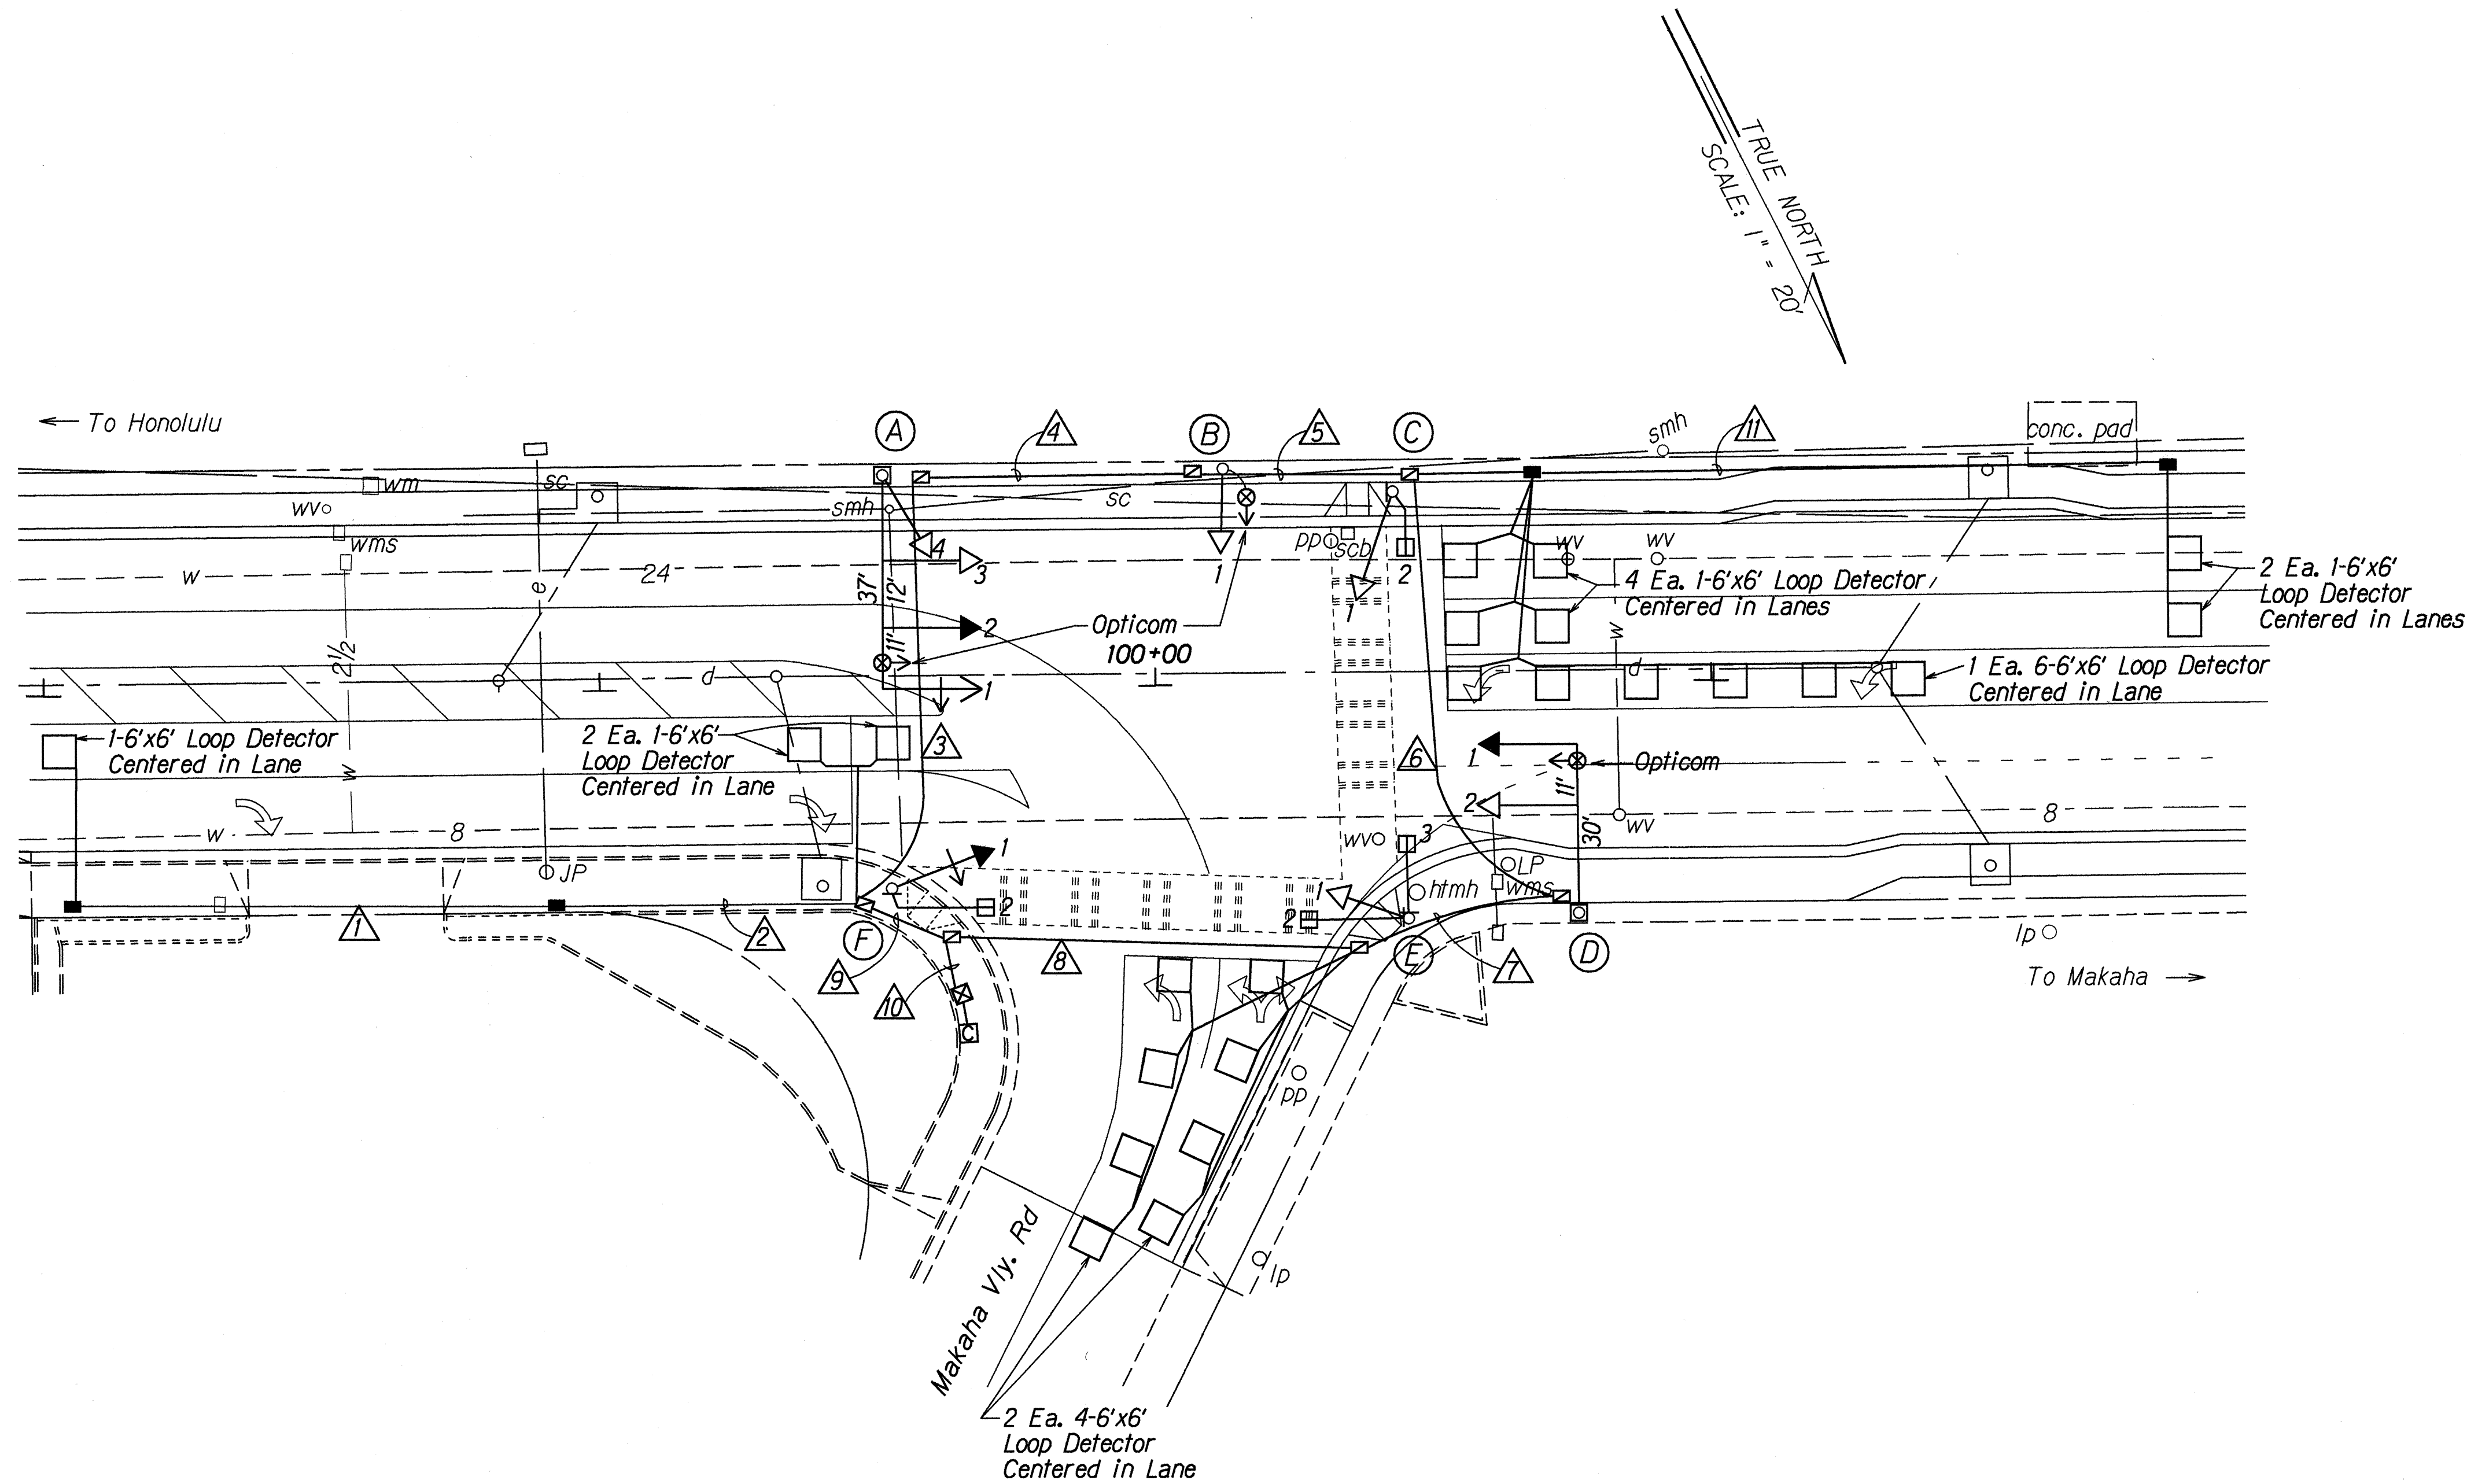


CONDUIT & CABLE SCHEDULE

Δ	CONDUIT	CABLE
1	1-2"	1 - 2c #14
2	2-2"	1 - 2c #14 1 - 3c #6
3	2-2"	1 - 26c #14 Spare
4	2-2"	1 - 26c #14 Spare
5	2-2"	1 - 26c #14 Spare
6	2-2"	1 - 26c #14 4 - 2c #14
7	2-2"	1 - 26c #14 4 - 2c #14
8	3-2"	1 - 26c #14 4 - 2c #14 2 - 2c #14
9	2-2"	1 - 26c #14 3 - 2c #14
10	5-2"	1 - 26c #14 1 - 26c #14 4 - 2c #14 5 - 2c #14 1 - 3c #6
11	1-2"	1 - 2c #14

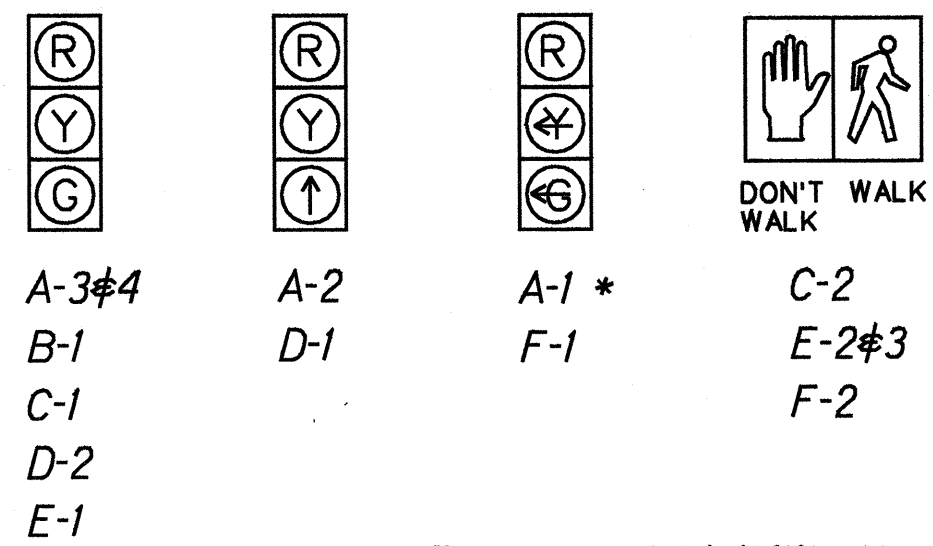

b (C) (→) R10-4b(R)
 p (E) (→) R10-4b(R), R10-4b(L)
 a (F) (→) R10-4b(R)

PEDESTRIAN PUSH
 BUTTON w/Sign (NEW)

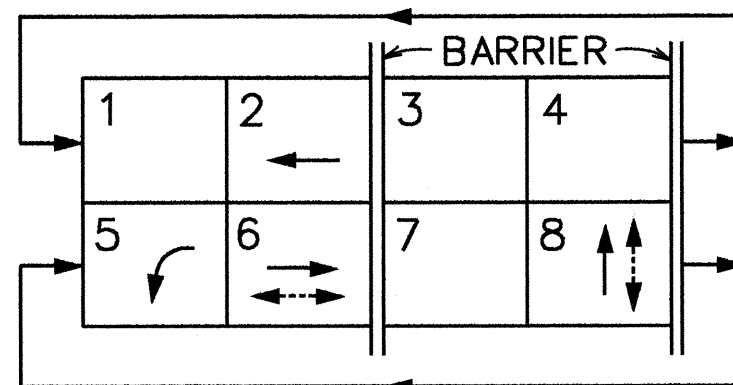



PHASE DIAGRAM

10/7/97 Revised Loop Detector Locations to accomodate revised striping.

DATE REVISION

STATE OF HAWAII
 DEPARTMENT OF TRANSPORTATION
 HIGHWAYS DIVISION
TRAFFIC SIGNAL PLAN
 Makaha Valley Road
 FARRINGTON HIGHWAY WIDENING
 Ala Hema Street to Jade Street
 Project No. 93B-02-91
 Scale: 1"=20' Date: Jan., 1994
 SHEET No. TS-3 OF 4 SHEETS

FED. ROAD DIST. NO.	STATE	PROJ. NO.	FISCAL YEAR	SHEET NO.	TOTAL SHEETS
HAWAII	HAW.	93B-02-91	1994	C.O. 108 S-3	122

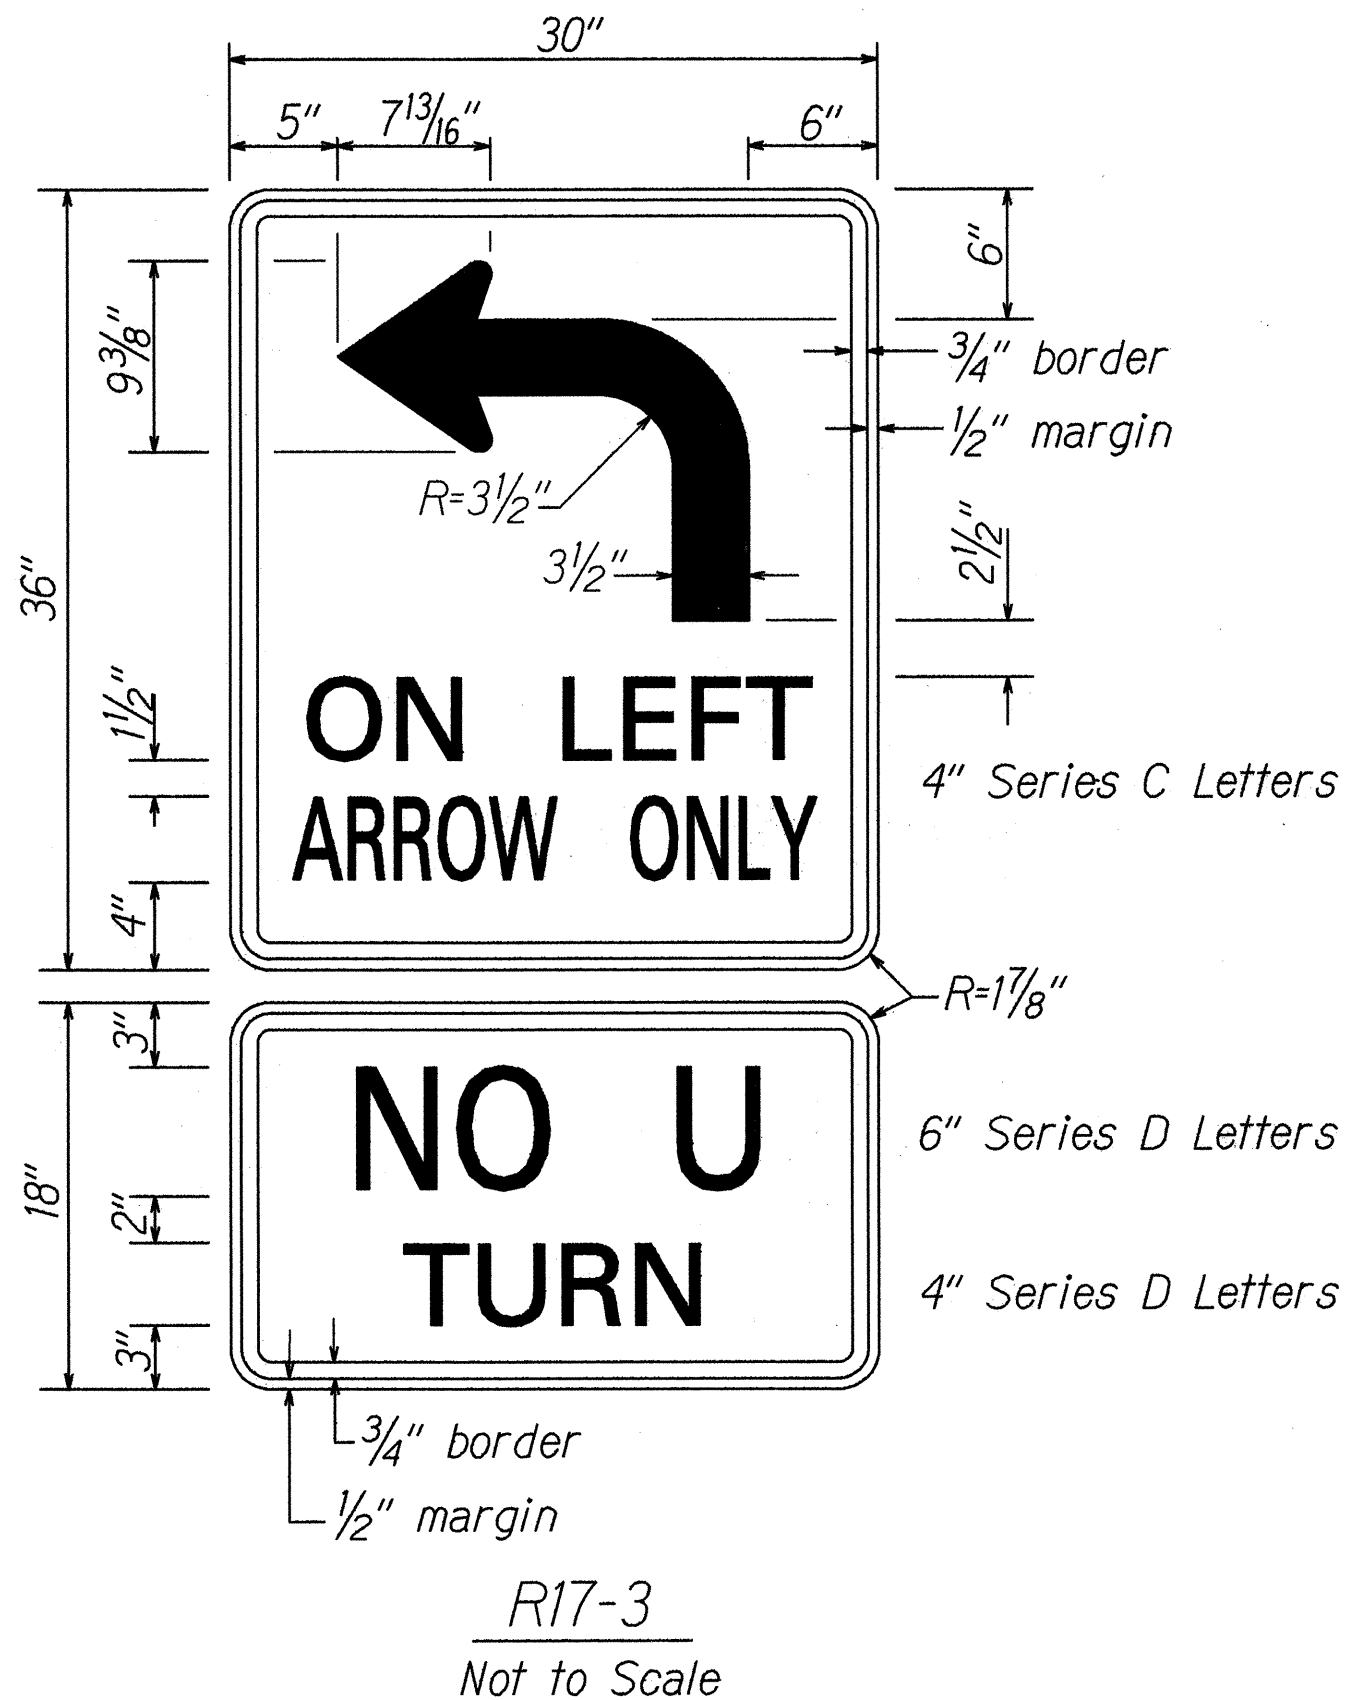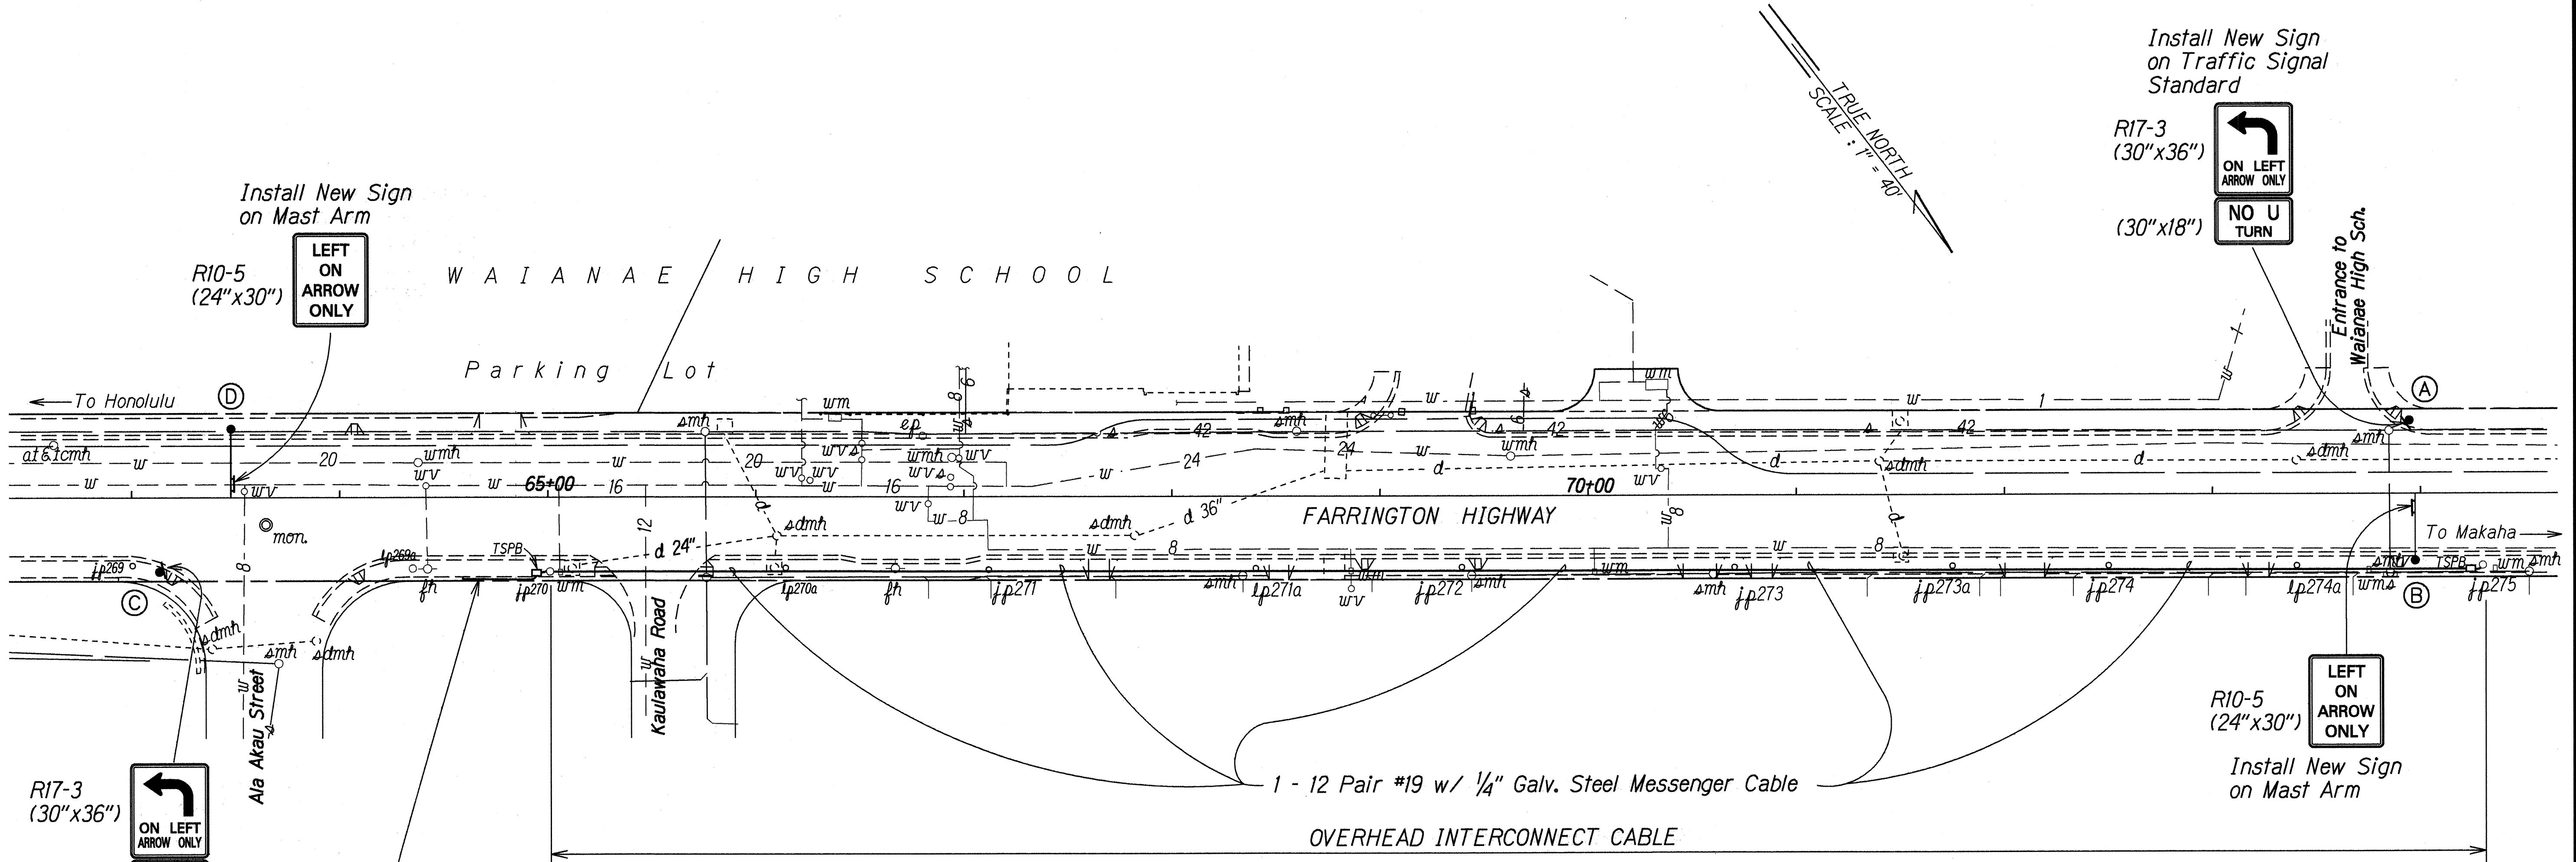


SURVEY PLOTTED BY	DATE
DRAWN BY A. Ahi	2/7/97
DESIGNED BY G. Kawai	
QUANTITIES BY	
CHECKED BY	


2/7/97	Install new overhead interconnect cable and signing for new traffic signal system.
DATE	REVISION
STATE OF HAWAII DEPARTMENT OF TRANSPORTATION HIGHWAYS DIVISION TRAFFIC SIGNAL PLAN Overhead Interconnect Cable & Signing FARRINGTON HIGHWAY WIDENING Ala Hema Street to Jade Street Project No. 93B-02-91 Scale: 1"=40' Date: Feb., 1997	
SHEET No. 75-3 S-3 OF 4	SHEETS

C.O. 108 S-3


FED. ROAD DIST. NO.	STATE	PROJ. NO.	FISCAL YEAR	SHEET NO.	TOTAL SHEETS
HAWAII	HAW.	93B-02-91	1994	109	122

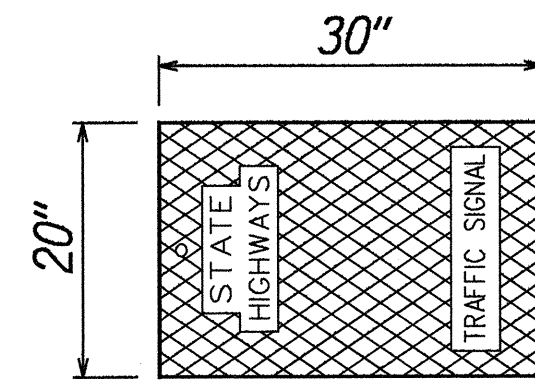


PLAN OF COVER

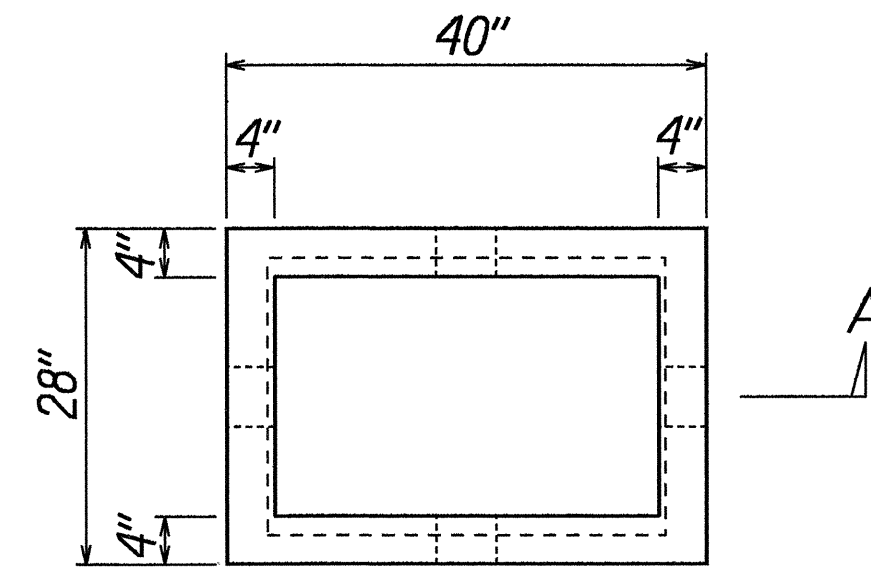


PLAN OF PULLBOX

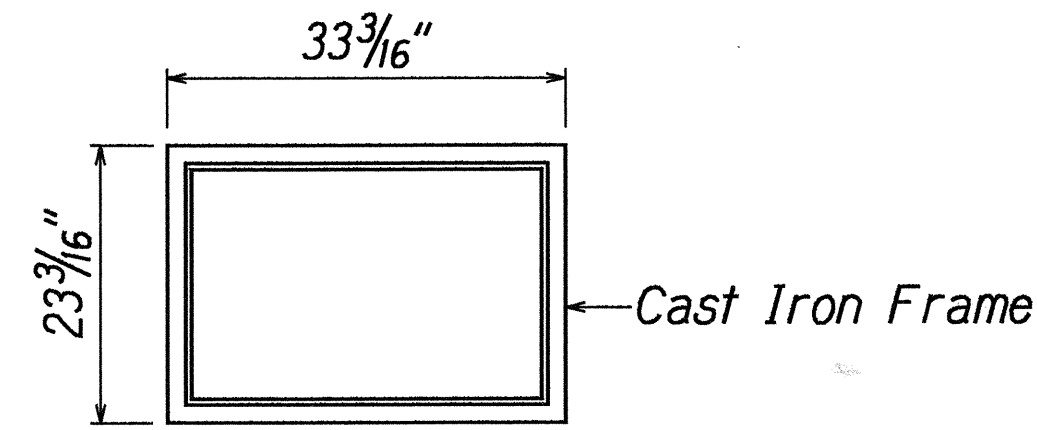


PLAN OF FRAME

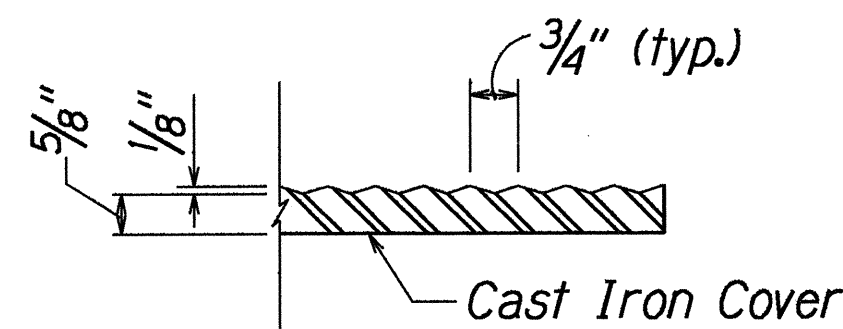

SECTION THROUGH COVER

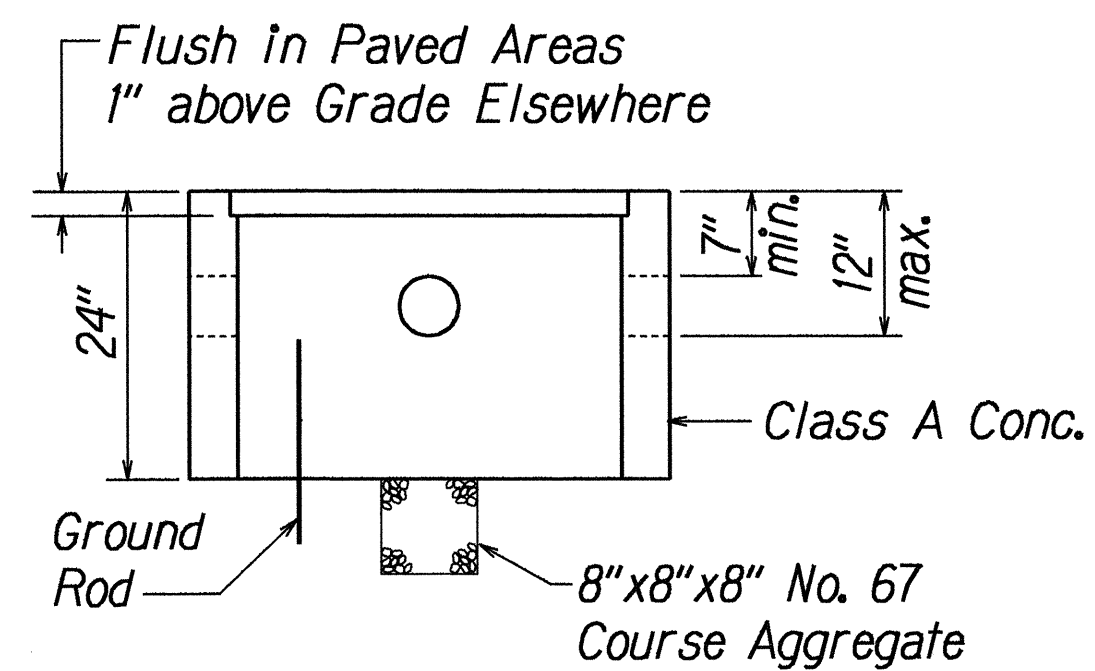


SECTION A-A

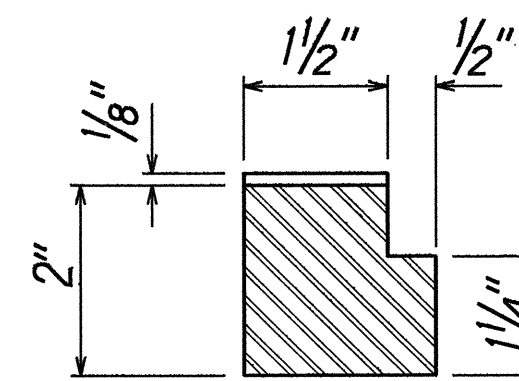

SECTION THROUGH FRAME


TYPICAL PULLBOX TYPE Z

Not to Scale

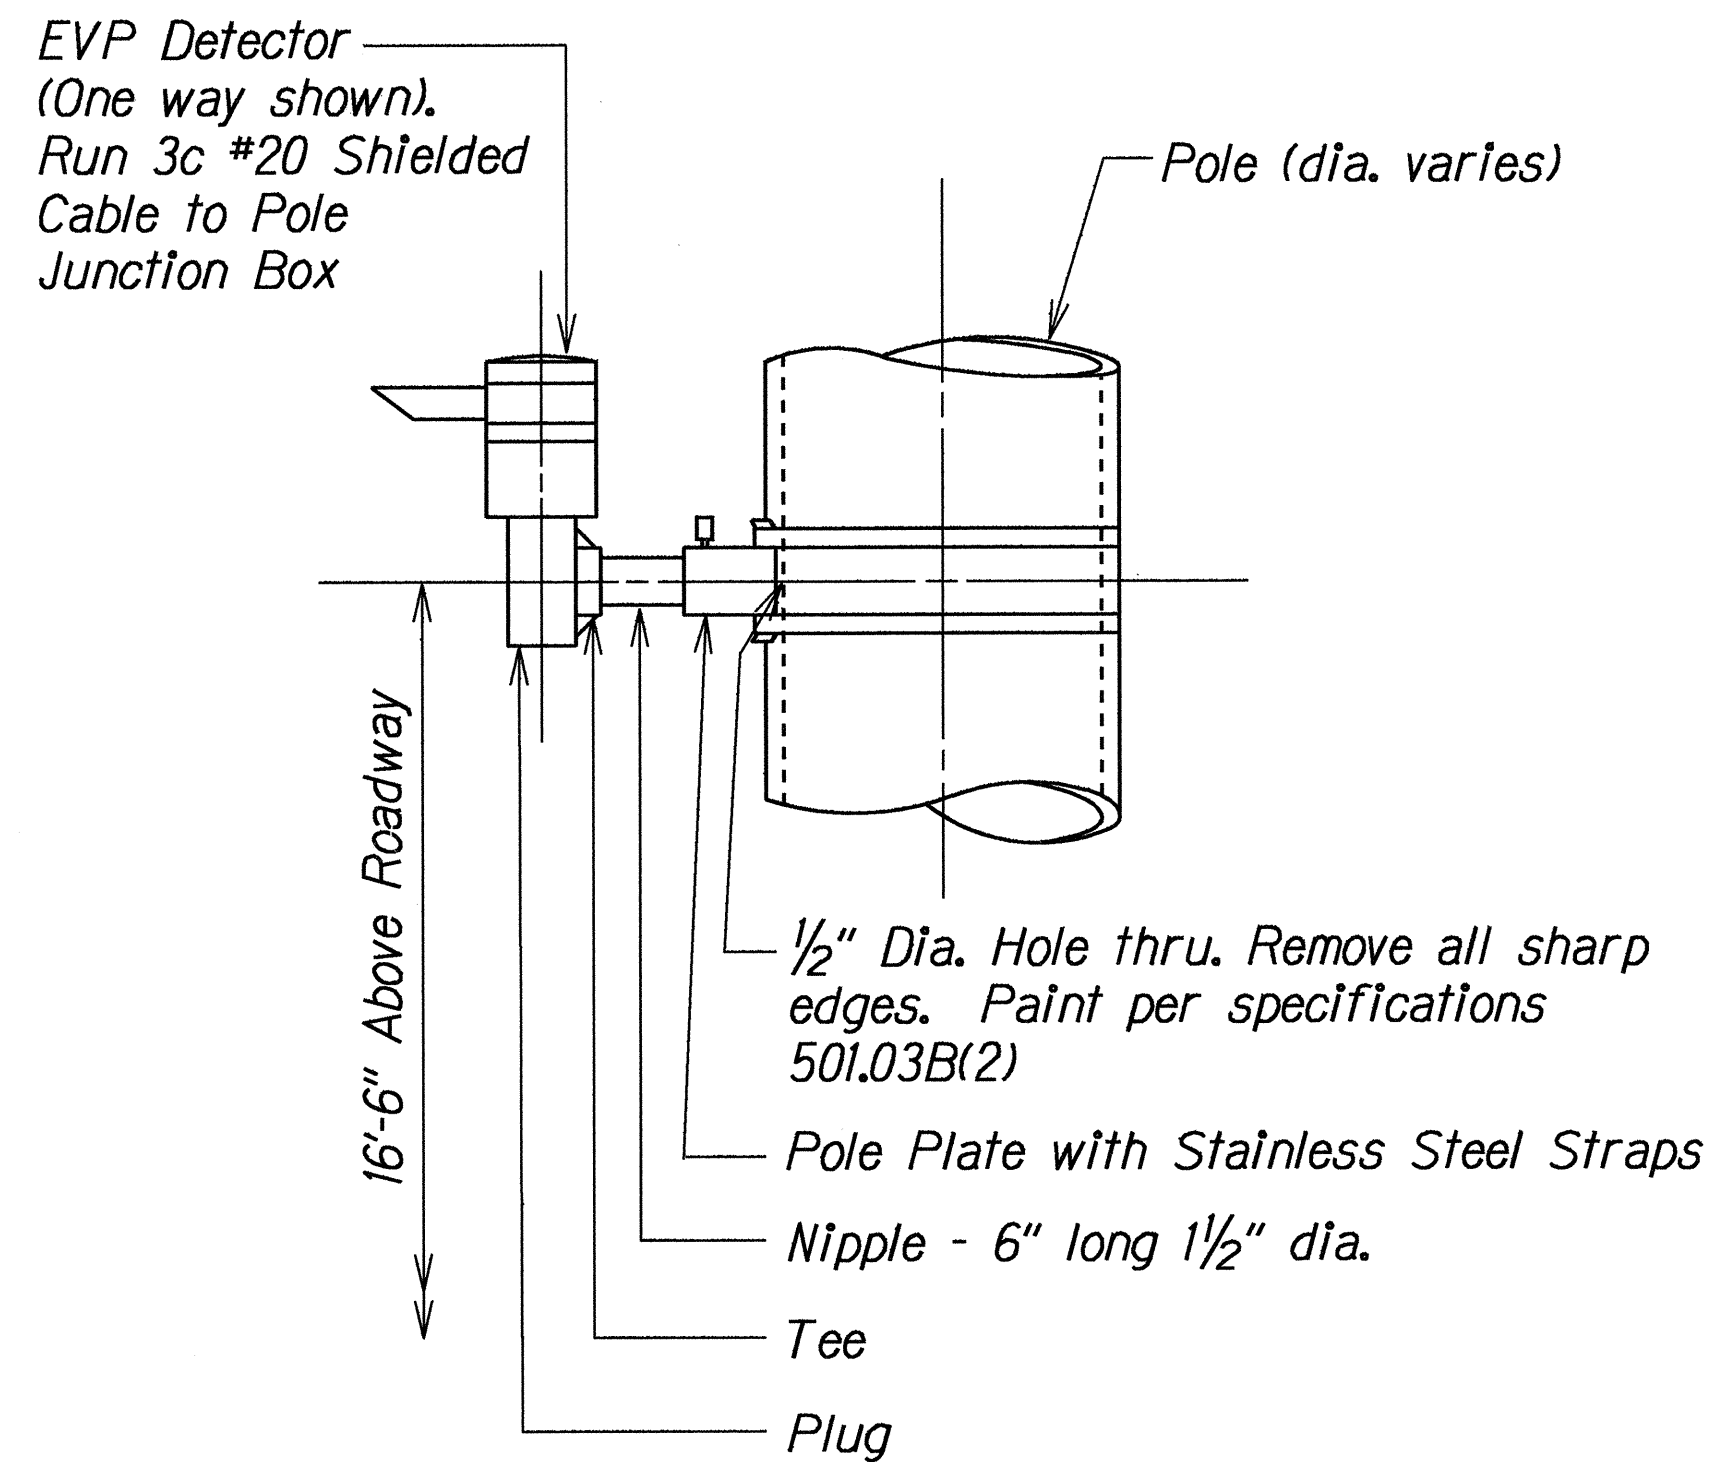

TYPICAL VERTICAL MOUNT OF
EVP DETECTOR

Not to Scale

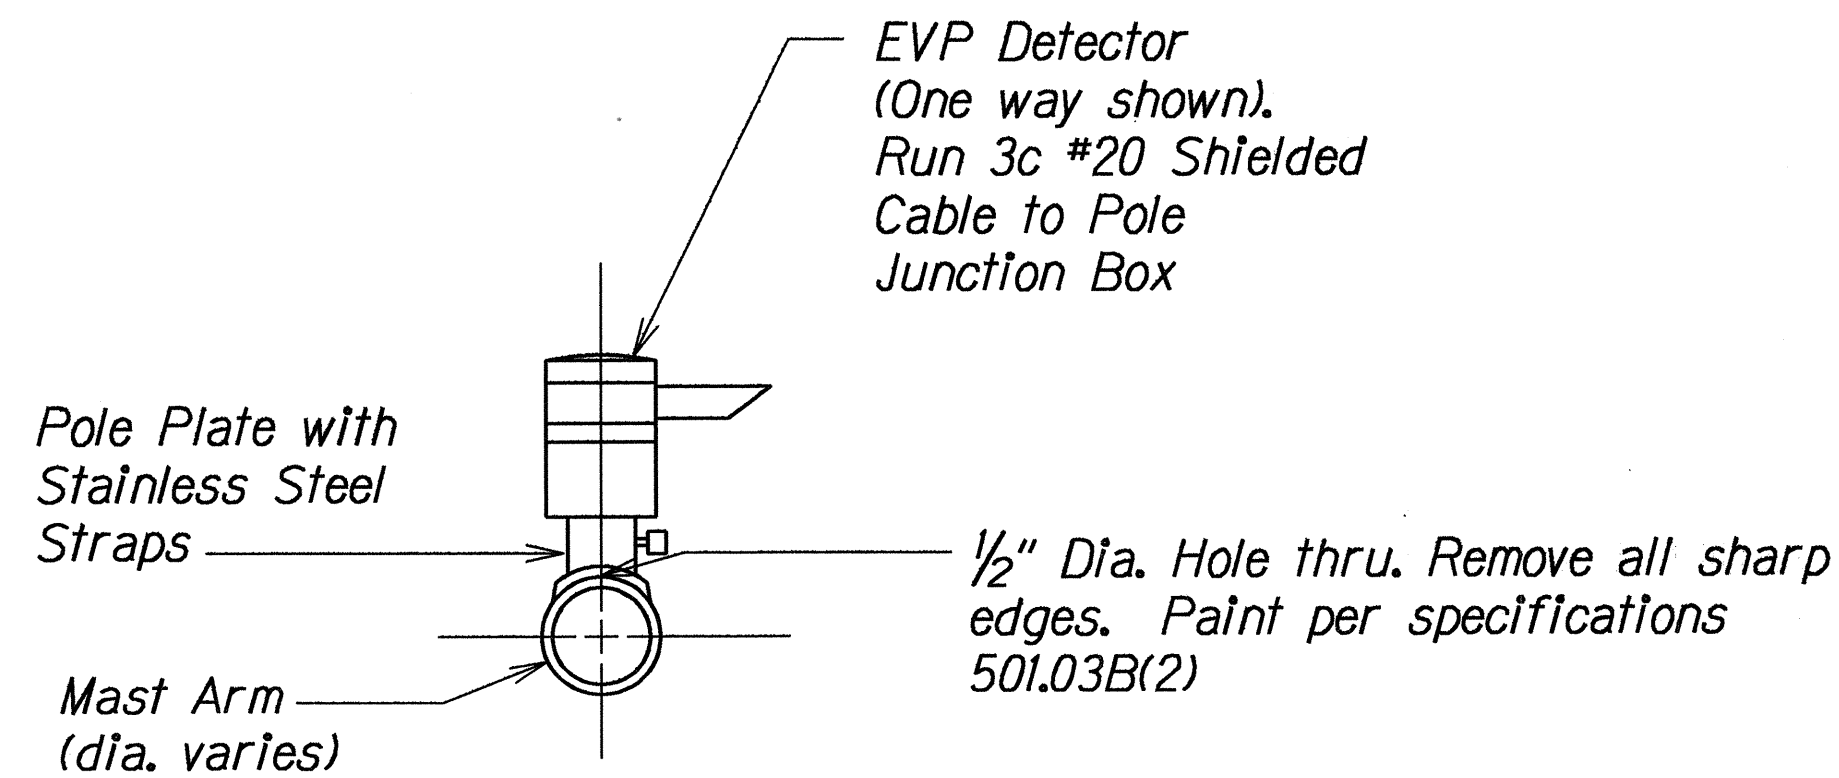

TYPICAL HORIZONTAL MOUNT OF
EVP DETECTOR

Not to Scale

STATE OF HAWAII
DEPARTMENT OF TRANSPORTATION
HIGHWAYS DIVISION

TRAFFIC SIGNAL DETAILS

FARRINGTON HIGHWAY WIDENING
Ala Hema Street to Jade Street
Project No. 93B-02-91


Scale: As Shown Date: Jan., 1994
SHEET No. TS-4 OF 4 SHEETS

GENERAL NOTES

1. The locations of new inductance loops, pullboxes and cabinets/junction boxes shall be staked out in the field by the Contractor and approved by the Engineer prior to installation.
2. The contractor shall inform the Engineer at least one day prior to pouring of the concrete slab/pad, saw-cutting pavement and installing inductance loops.
3. Continuity of inductance loops and lead-in wires shall be tested and warranted for one year from date of acceptance by the Contractor.
4. The Contractor shall restore all affected areas to their original condition. This item of work shall not be paid for separately, but shall be considered incidental to work of other paid items.
5. The Contractor shall verify the locations of the existing utilities and underground structures whether or not shown on plans.
6. The Contractor shall assume that existing underground utilities not shown on the plans may exist, therefore, he shall contact the different utility companies for information and toning.
7. The Contractor shall be held liable for any damages incurred to the existing utilities and underground structures as a result of his operations. All damaged portions shall be replaced in accordance with the standards and specifications of the affected utility company at no cost to the STATE.
8. Changes to the contract plans and specifications shall not be permitted, unless otherwise authorized by the Engineer upon written justification and request for approval by the Contractor.

LOOP LAYOUT NOTES


1. Detector loop shall consist of three turns of 1/C 14 AWG RHW-USE-XLP wire or equivalent embedded in a 3/8" minimum saw cut, except as noted.
2. Loop and lead-in to the first pullbox shall be one continuous wire. Lead-in wires from the same loop shall be twisted in pairs, two turns per foot. DO NOT twist one loop-pairs with another loop-pairs.
3. All lead-in wires shall be crimped with open end lugs that will fit into the terminal board slots snugly.
4. Stagger traffic loops on roadway less than 12 foot lane width.
5. The Contractor shall connect the inductance wires on each terminal slot.
6. The left lane in the direction of traffic flow is designated as lane 1, and the lane next to its right as lane 2 and so on as indicated on plans.
7. Clean sawcut thoroughly before filling with epoxy sealant.
8. All loop lead-in wires in all enclosures including pullboxes shall be identified and labeled by direction of traffic flow and lane numbers as shown on plans.
9. All cables and wires terminated within an enclosure shall have a minimum 12" additional slack.

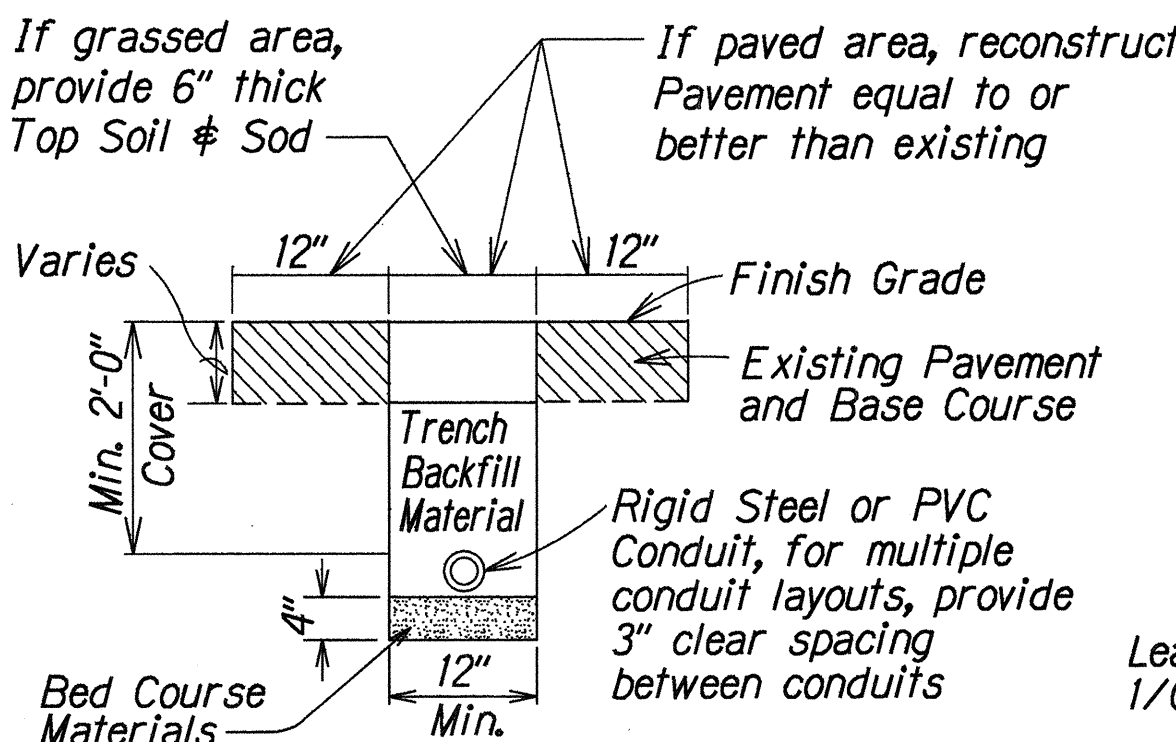

TYPICAL TRENCH SECTION FOR CONDUIT


Not to Scale

FED. ROAD DIST. NO.	STATE	FED. AID PROJ. NO.	FISCAL YEAR	SHEET NO.	TOTAL SHEETS
HAWAII	HAW.	93B-02-91	1994	109 S-1	122

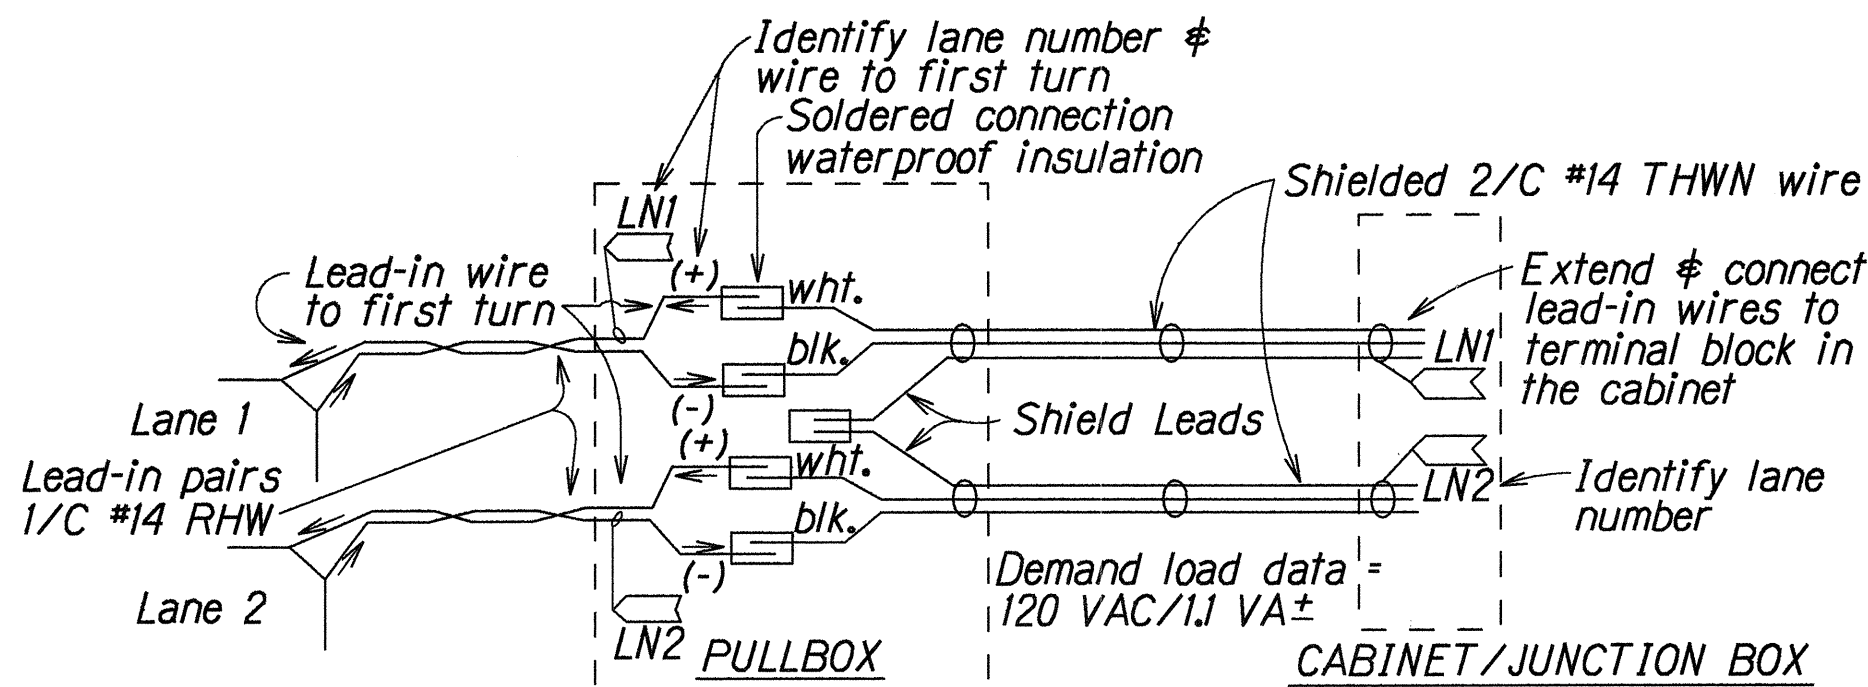

DETECTOR LOOP LEAD-IN WIRING AND IDENTIFICATION IN PULLBOX AND CABINET

Not to Scale

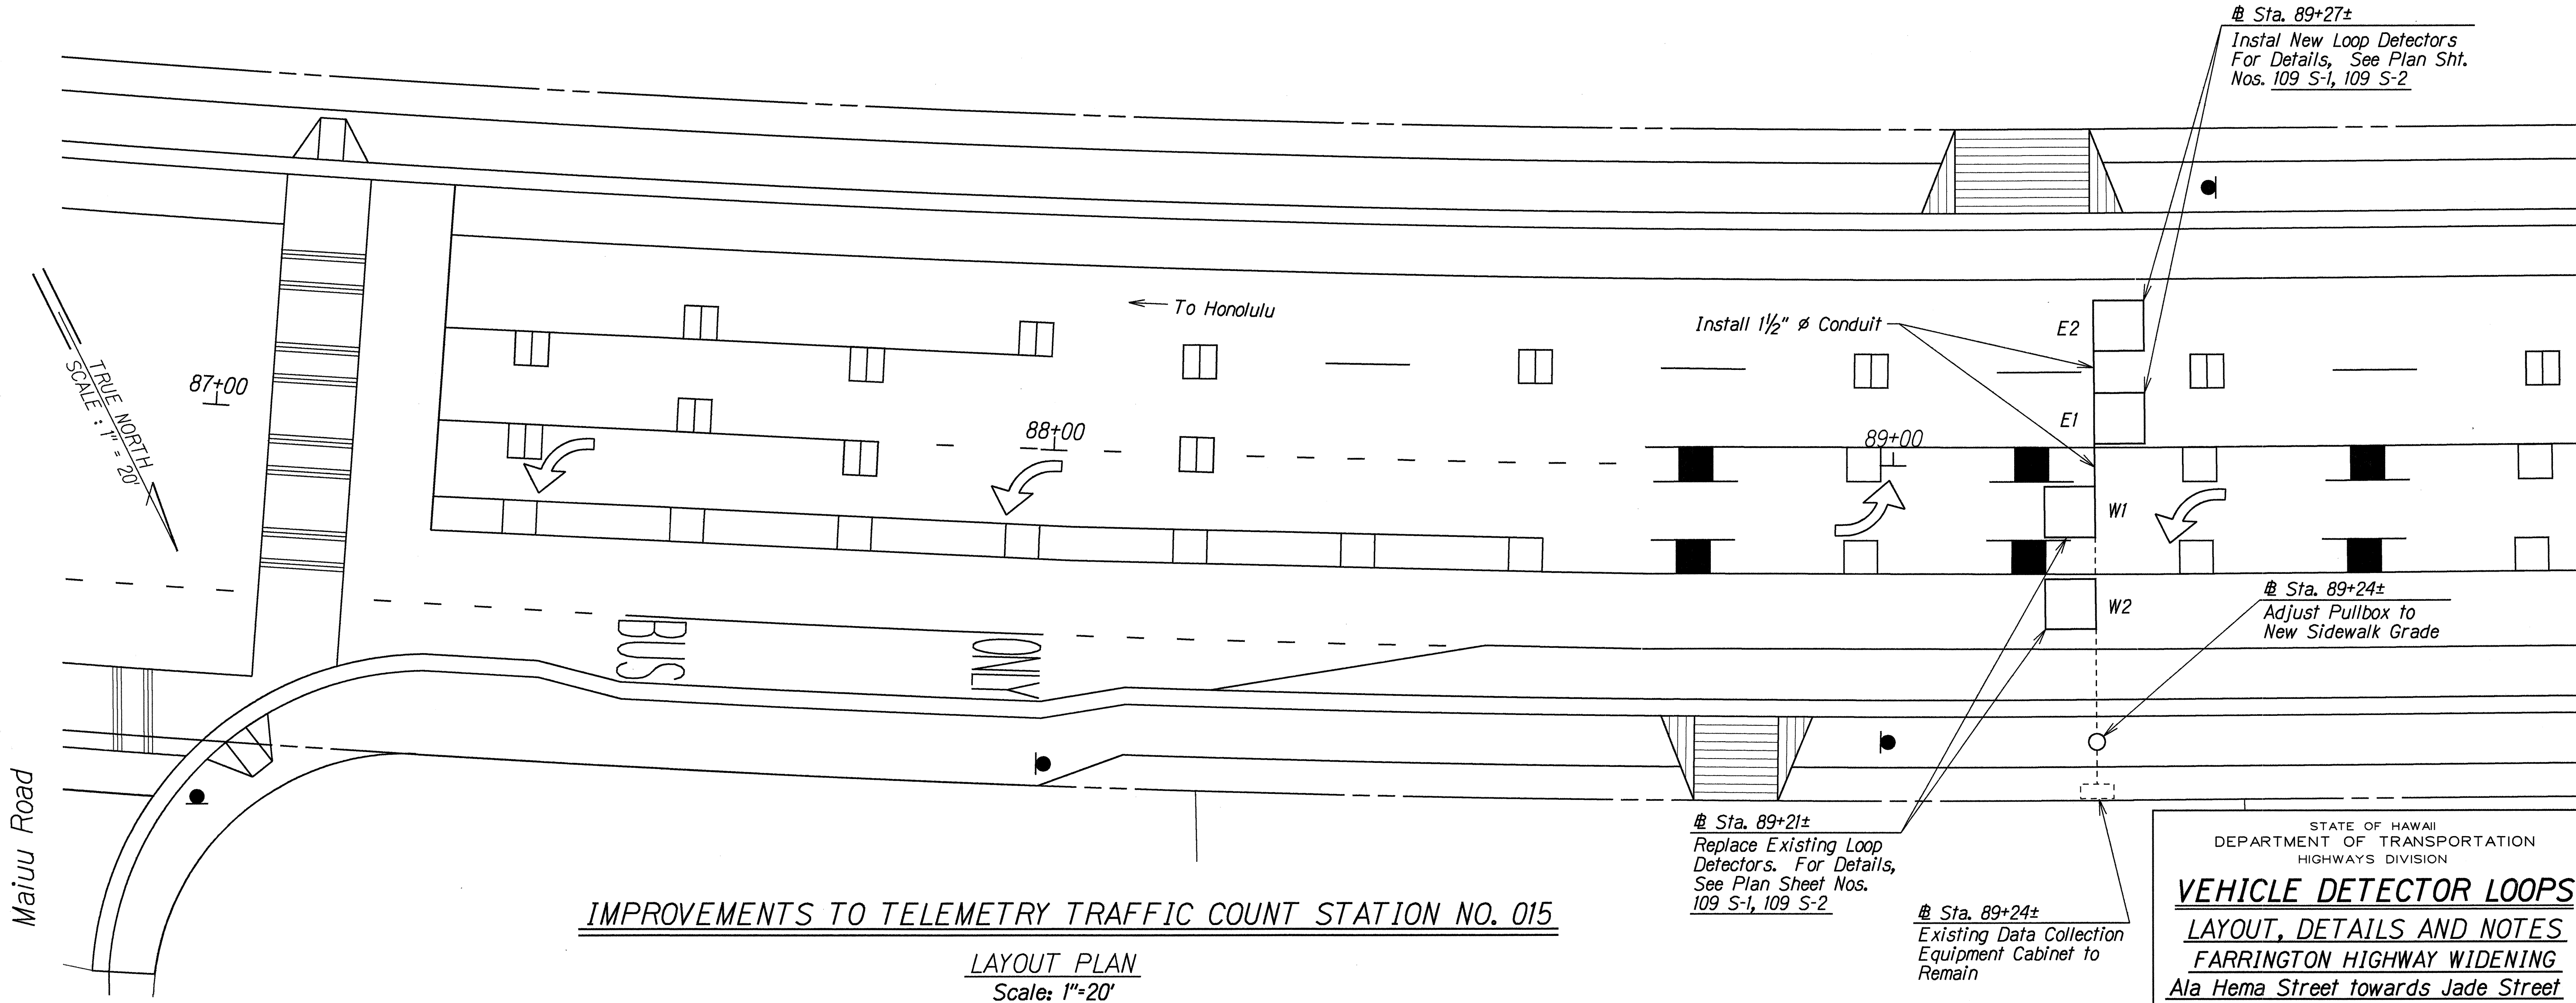


ORIGINAL PLAN	DATE	11/95
SURVEY PLOTTED BY		
DRAWN BY		
TRACED BY		
CHECKED BY		
NOTED BY		
REVISIONS		
BY		
DATE		
REASON		

STATE OF HAWAII DEPARTMENT OF TRANSPORTATION HIGHWAYS DIVISION
VEHICLE DETECTOR LOOPS
LAYOUT, DETAILS AND NOTES
FARRINGTON HIGHWAY WIDENING
Ala Hema Street towards Jade Street
Project No. 93B-02-91
Scale: As Shown Date: Jan., 1995
SHEET NO. 1 OF 2 SHEETS

1-9-95	Sheet Added to Contract Plan Set
DATE	REVISION


C.O. 109 S-1

FED. ROAD DIST. NO.	STATE	FED. AID PROJ. NO.	FISCAL YEAR	SHEET NO.	TOTAL SHEETS
HAWAII	HAW.	93B-02-91	1994	109 S-2	122

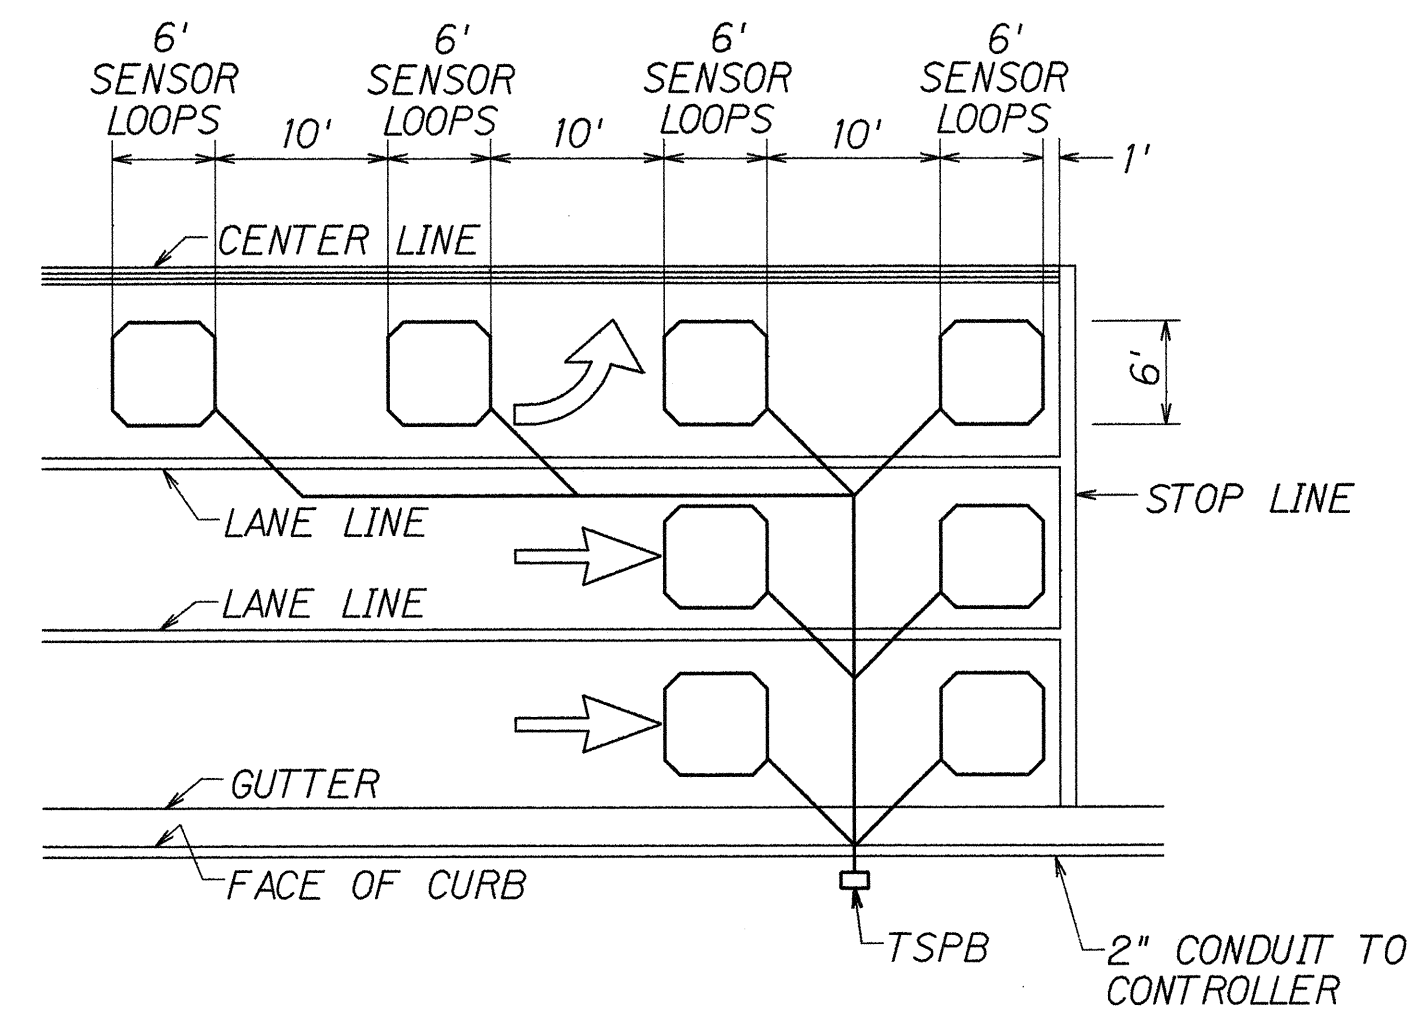


- NOTES:
1. Center sensor loops in lanes.
 2. Collector cables shall be twisted 2 turns per foot.
 3. Number of loops and locations vary. See project plans.
 4. Number and locations of collector sawcuts may be varied in the field to suit.


TYPICAL SENSOR LOOP LAYOUT

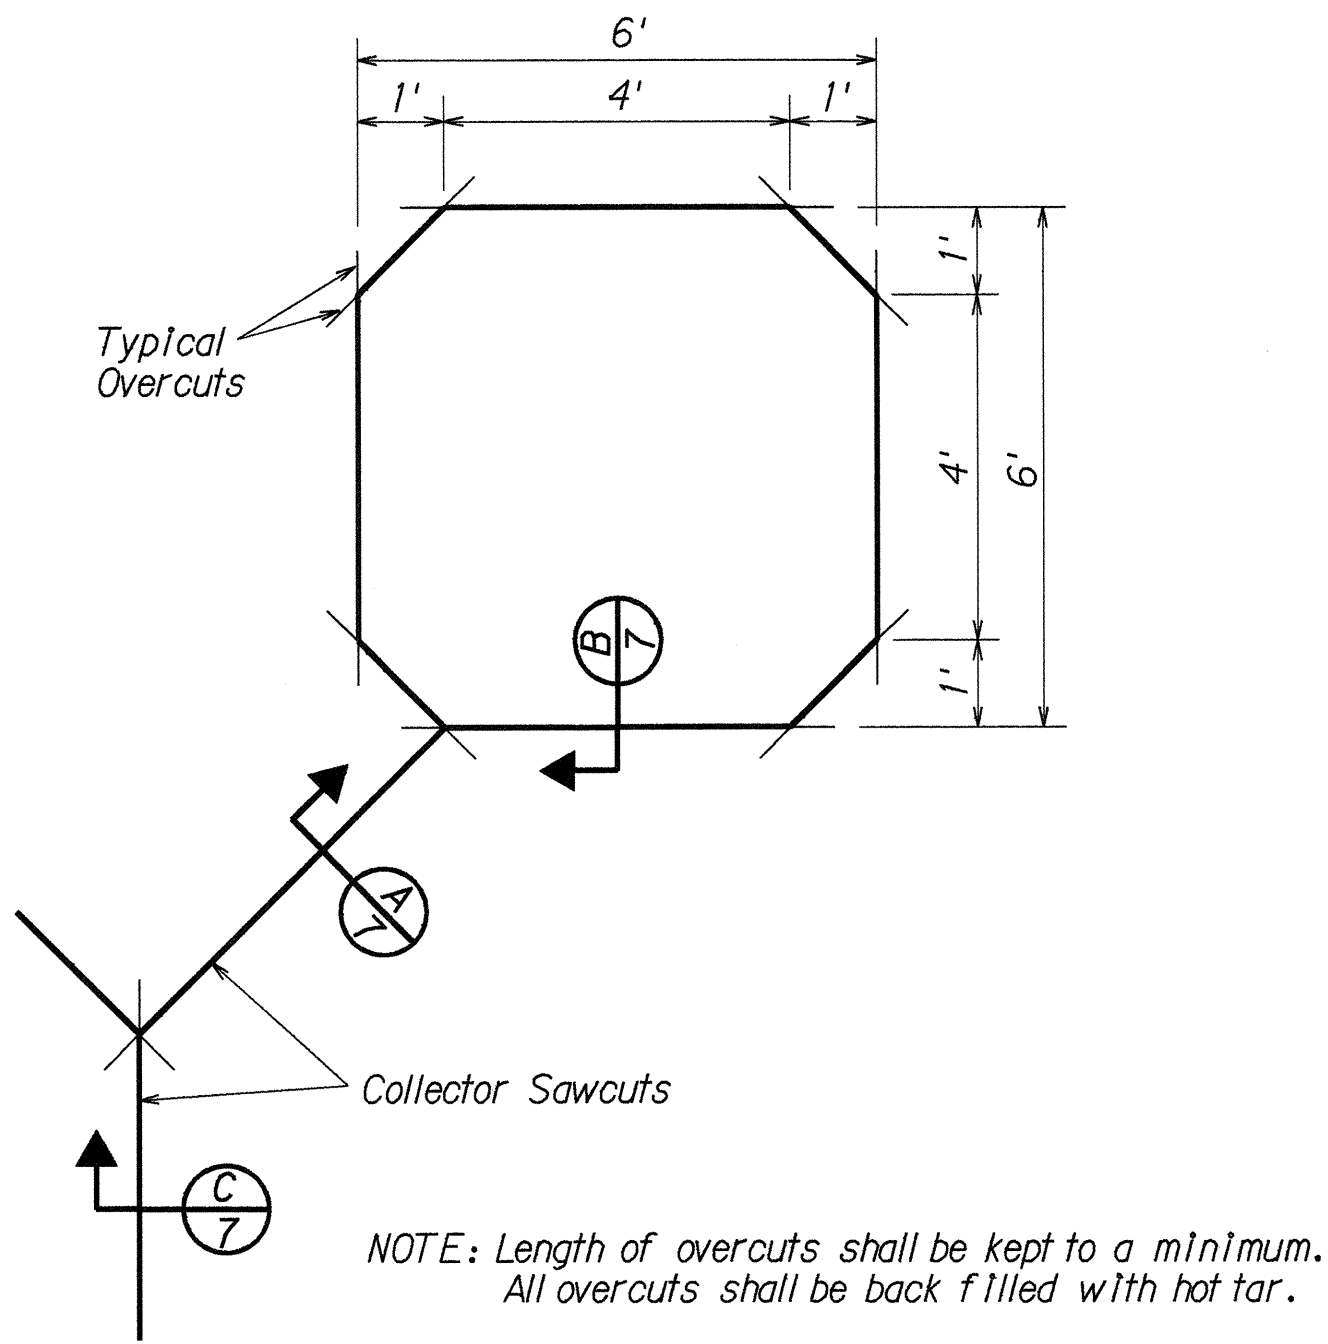

TYPICAL SENSOR LOOP SAWCUT DETAIL

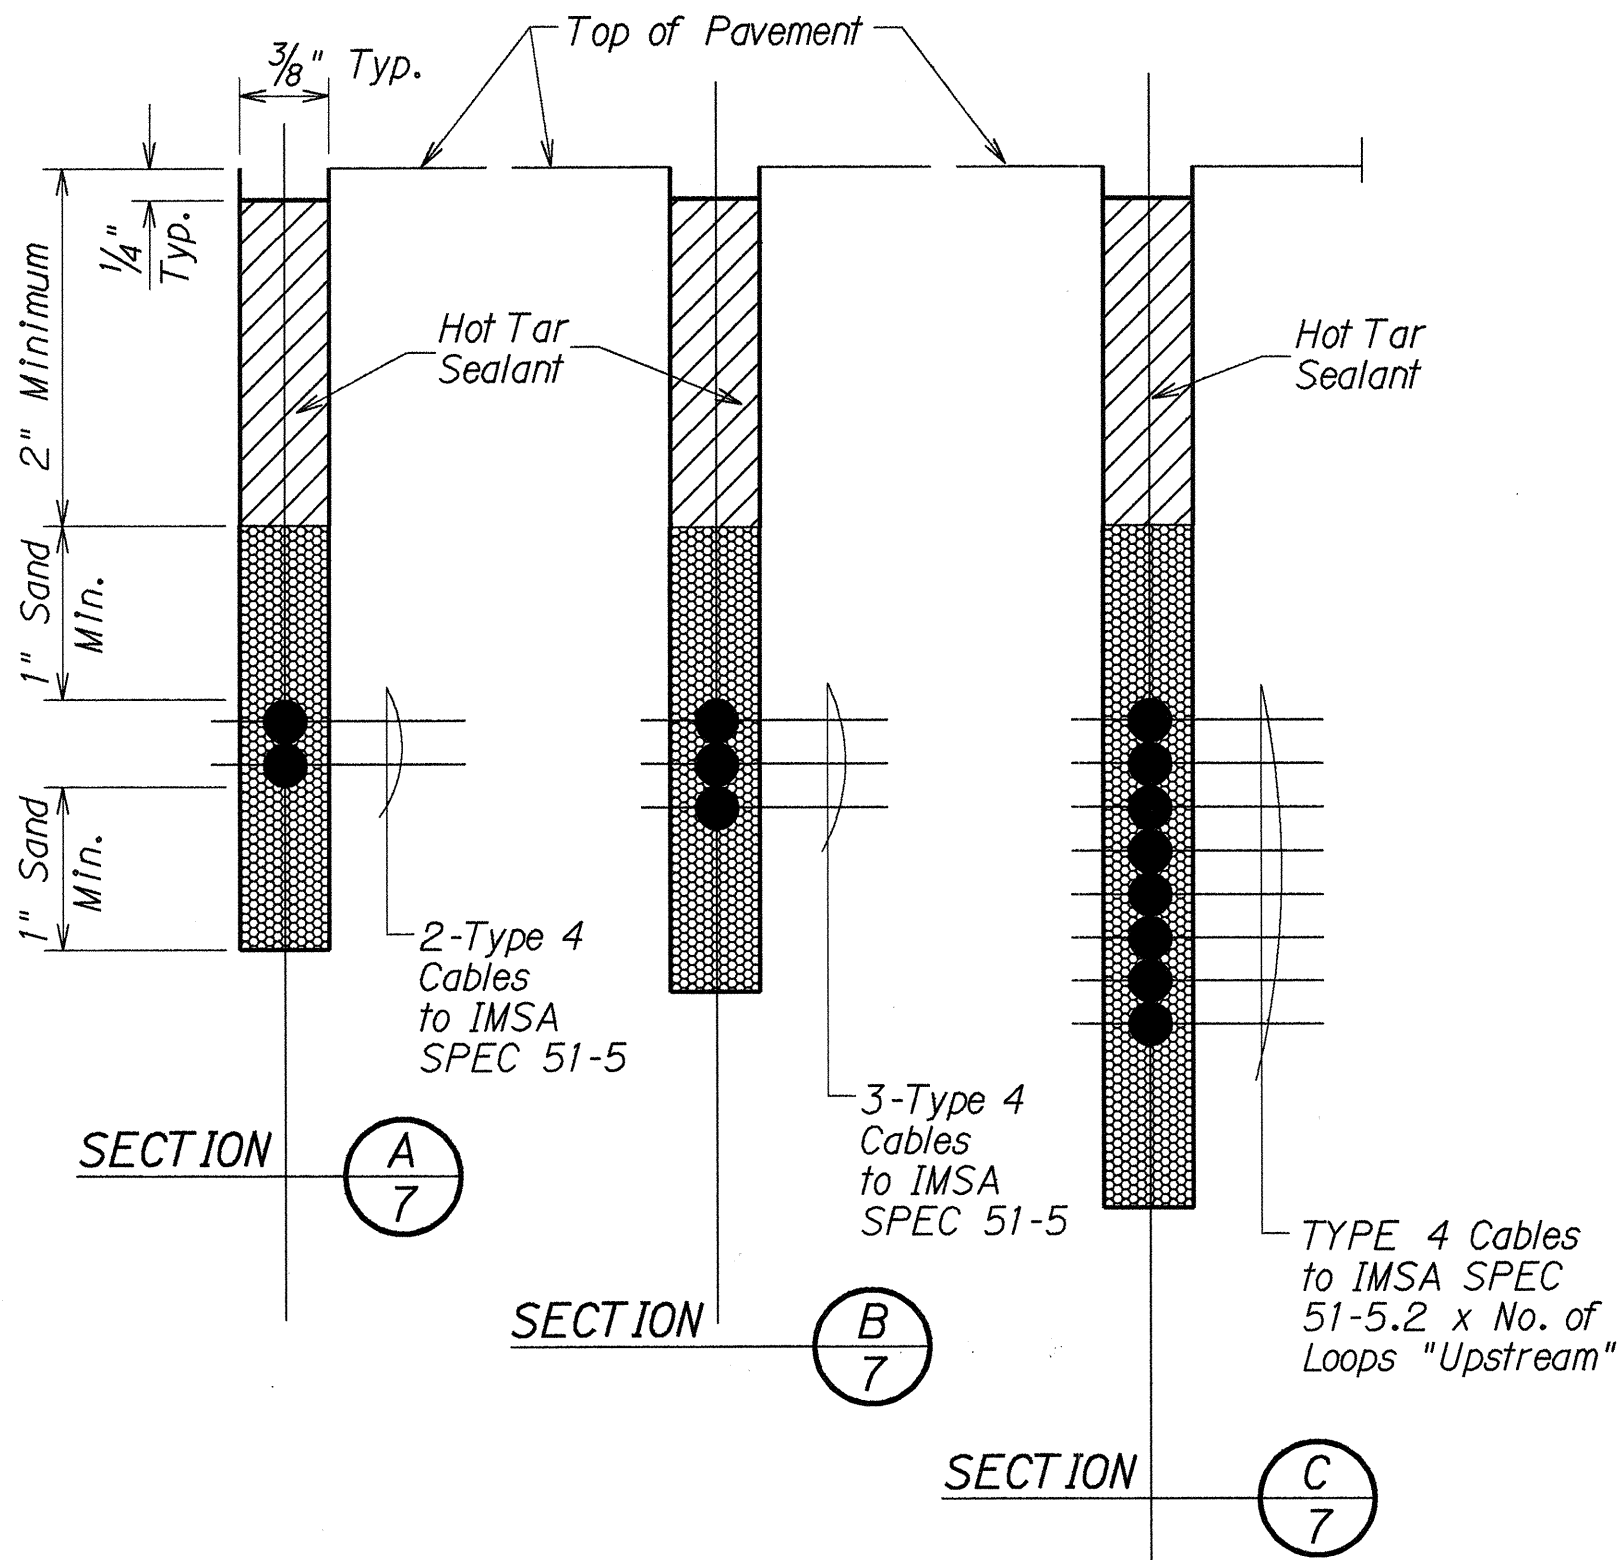


TYPICAL SECTION THROUGH SENSOR LOOP

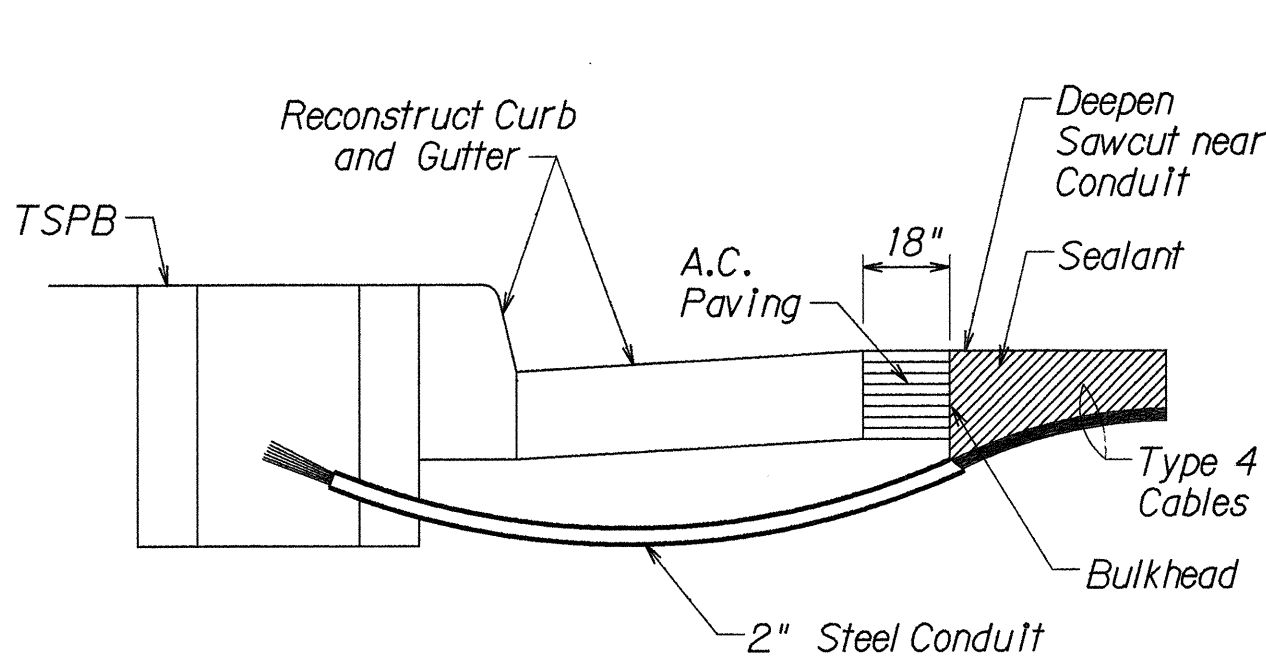

- NOTES ON CONSTRUCTION AT END OF SAWCUT
1. Seal roadway end of conduit after installation of conductors.
 2. Install bulkhead across conduit trench.
 3. Place hot tar in sawcut.
 4. Backfill over conduit with new A.C.
 5. Reconstruct curb and gutter as required.

DETAIL OF SENSOR LOOP INSTALLATION
AT EDGE OF ROADWAY

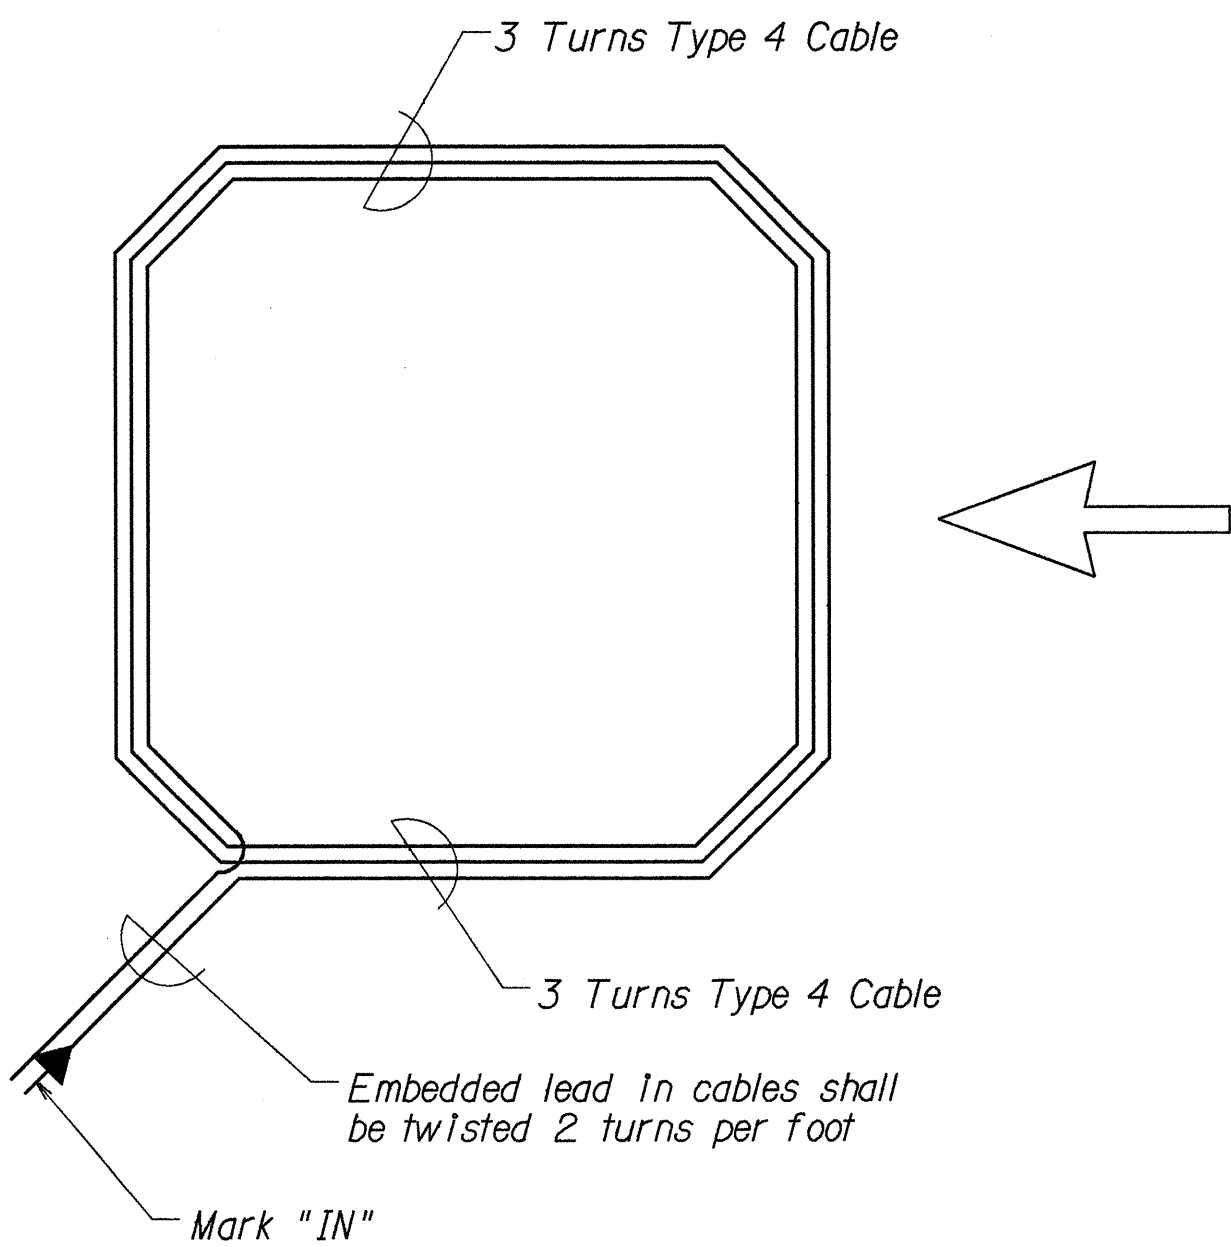

TYPICAL SENSOR LOOP WIRING DIAGRAM

TYPES OF CABLES

- | | |
|--------|---|
| TYPE 1 | Signal Loop Cable: Stranded No. 14, 26 conductors |
| TYPE 2 | Detector Lead-In Cable and Pedestrian Push Button Circuit Cable: Stranded, No. 14, 2 Conductors |
| TYPE 3 | Interconnect Cable: Solid No. 20, 12 Pairs |
| TYPE 4 | Loop Sensor Cable: Solid No. 12, Single Conductor to IMSA SPEC 51-5 |
| TYPE 5 | Cable from Signal Loop to Signal Head: Stranded, No. 14, Single Conductor |
| TYPE 6 | Service Cable: Solid, No. 6, 3 Conductors |

1-9-95	Sheet Added to Contract Plans
DATE	REVISION
STATE OF HAWAII DEPARTMENT OF TRANSPORTATION HIGHWAYS DIVISION VEHICLE DETECTOR LOOPS DETAILS FARRINGTON HIGHWAY WIDENING Ala Hema Street towards Jade Street Project No. 93B-02-91 Not to Scale Date: Jan., 1995	
SHEET No. 2 OF 2 SHEETS	

ORIGINAL PLAN	DATE
1-9-95	
SURVEY PLOTTED BY	
DRAWN BY G. Alvarado	
TRACED BY B. Hironaka	
QUANTITIES BY	
CHECKED BY	
NOTE BOOK	
002280096	
1/24/95	