


FED. ROAD DIST. NO.	STATE	PROJ. NO.	FISCAL YEAR	SHEET NO.	TOTAL SHEETS
HAWAII	HAW.	93A-02-90	1992	4	11

TRUE NORTH
Scale: 1"=20'

Install New Sign w/Posts
END CONSTRUCTION
CG20-2

Install New Type II Object Marker on Exist. Utility Pole

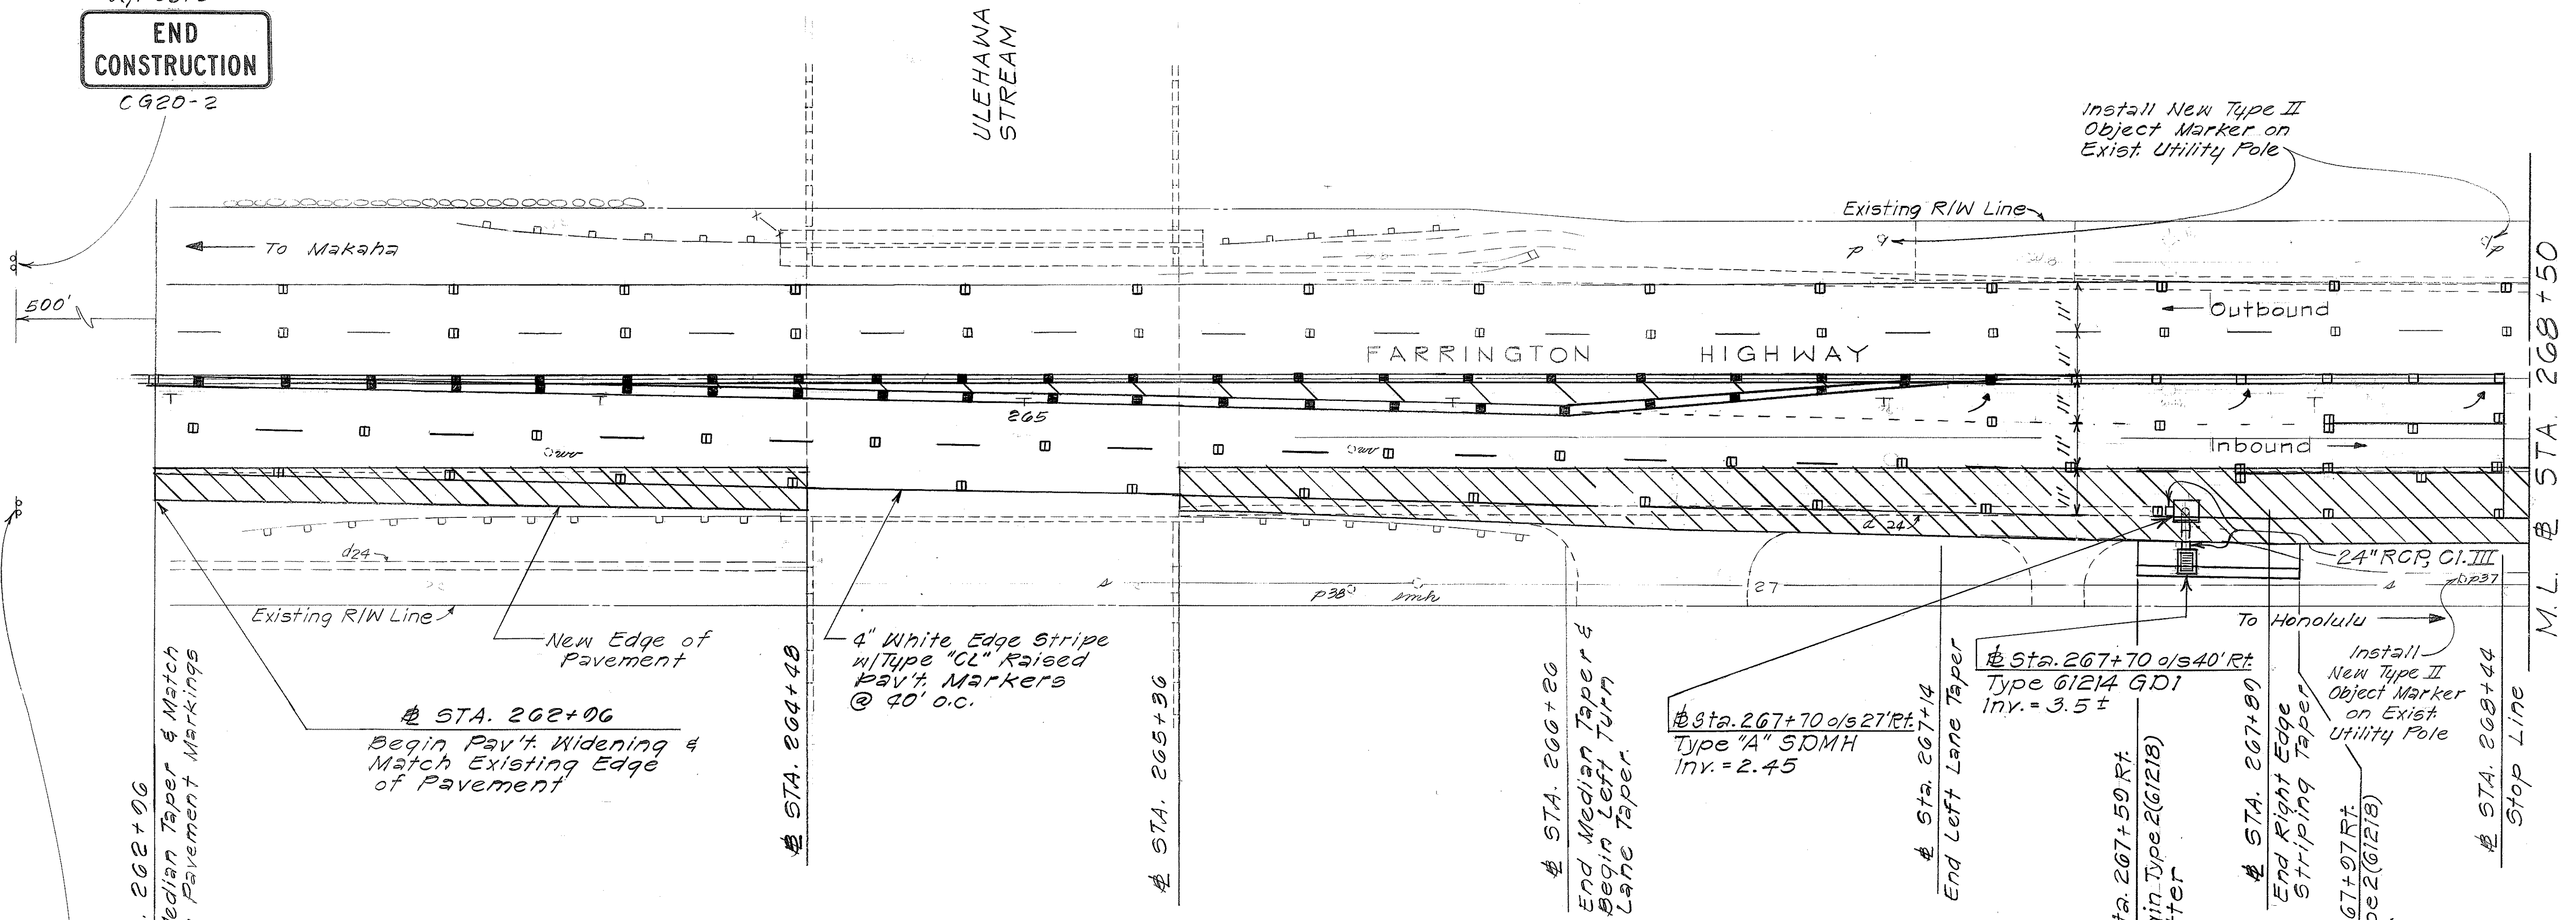

Sta. 267+70 o/s 27' Rt.
Construct: Type "A" SDMH, demolish and remove existing SDMH.
Install: 24" RCP, Cl. III

Estimated Quantities
Type "A" SDMH, 5.00 Ft. to 5.99 Ft. = 1 Ea.
24" RCP, Cl. III = 3 L.F.
Structural Excavation = 3 C.Y.

Sta. 267+70 o/s 40' Rt.
Construct: Type 61214 GDI. Salvage, clean, modify and reuse existing frame and grates
Install: 24" RCP, Cl. III

Estimated Quantities
Type 61214 GDI, 3.00 Ft. to 3.99 Ft. = 1 Ea.
24" RCP, Cl. III = 3 L.F.
Structural Excavation = 2 C.Y.

Construct: Type 2(61218) Gutter
Sta. 267+59 Rt. to Sta. 267+97 Rt.

Estimated Quantities
Type 2(61218) Gutter = 38 L.F.

Install New Type II Object Marker on Exist. Utility Pole

Sta. 267+97 Rt.
End Type 2(61218) Gutter

STATE OF HAWAII
DEPARTMENT OF TRANSPORTATION
HIGHWAYS DIVISION

ROADWAY & STRIPING PLAN

FARRINGTON HIGHWAY
Traffic Signal at Mohihi St.
PROJECT NO. 93A-02-90

Scale: 1"=20' Date: Mar, 1992



SHEET NO. 1 OF 2 SHEETS

SURVEY PLOTTED BY	DATE
DRAWN BY	
CHECKED BY	
NOTED BY	
QUANTITIES BY	
CHECKED BY	
ORIGINAL PLAN	
NOTE BOOK	
No.	

CW20-1d
ROAD CONSTRUCTION AHEAD
Install New Sign w/Posts

FED. ROAD DIST. NO.	STATE	PROJ. NO.	FISCAL YEAR	SHEET NO.	TOTAL SHEETS
HAWAII	HAW.	93A-02-00	1992	5	11

PAYEMENT MARKING SUMMARY	
DESCRIPTION	QUANTITY
PAYEMENT MARKERS	
TYPE A	106 EACH
TYPE CL	125 EACH
TYPE DL	0 EACH
TYPE HL	02 EACH
TAPE - TYPE I OR THERMOPLASTIC EXTRUSION	
8-INCH PAYEMENT STRIPE (WHITE)	155 L.F.
DOUBLE 4-INCH PAYEMENT STRIPE (YELLOW) - PAYEMENT ARROW	150 L.F.
	3 EACH
TAPE - TYPE II OR THERMOPLASTIC EXTRUSION	
4-INCH PAYEMENT STRIPE (WHITE)	2,250 L.F.
12-INCH PAYEMENT STRIPE (YELLOW)	225 L.F.
DOUBLE 4-INCH PAYEMENT STRIPE (YELLOW)	1,020 L.F.
THERMOPLASTIC EXTRUSION	
4-INCH PAYEMENT STRIPE (WHITE)	180 L.F.
4-INCH PAYEMENT STRIPE (YELLOW)	50 L.F.
12-INCH PAYEMENT STRIPE (WHITE)	95 L.F.
CROSSWALK MARKINGS	11 LANES
DOUBLE 4-INCH PAYEMENT STRIPE (YELLOW)	240 L.F.

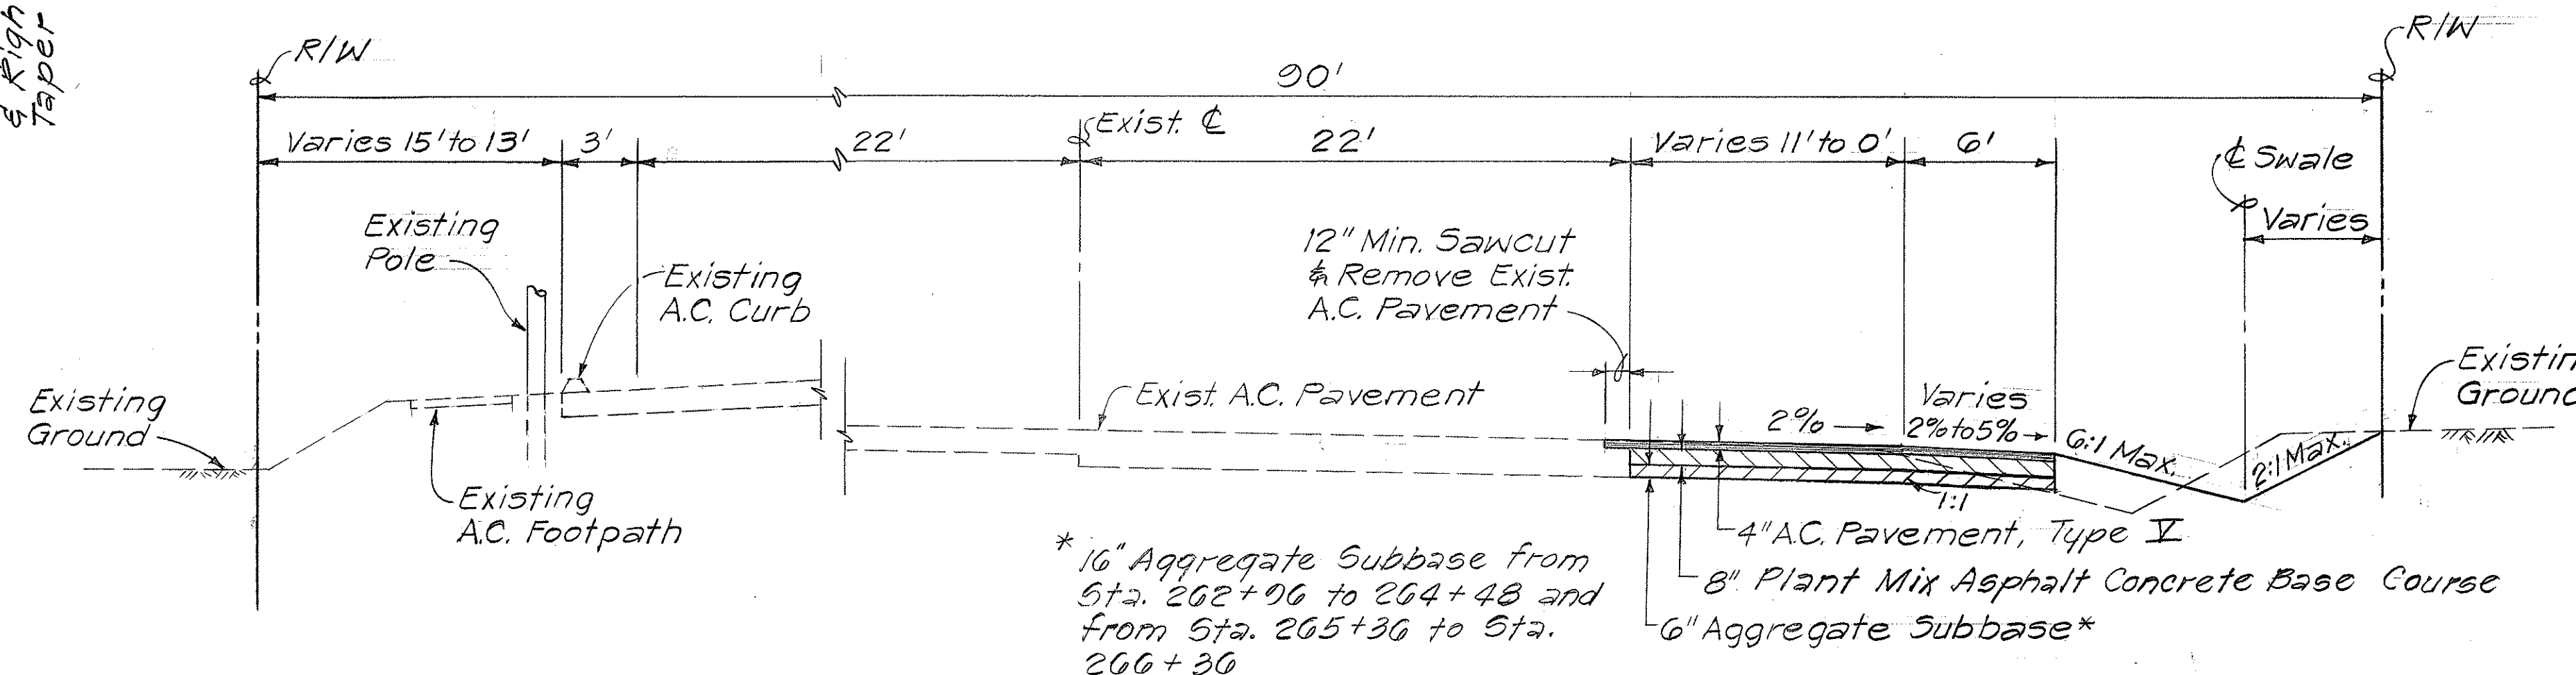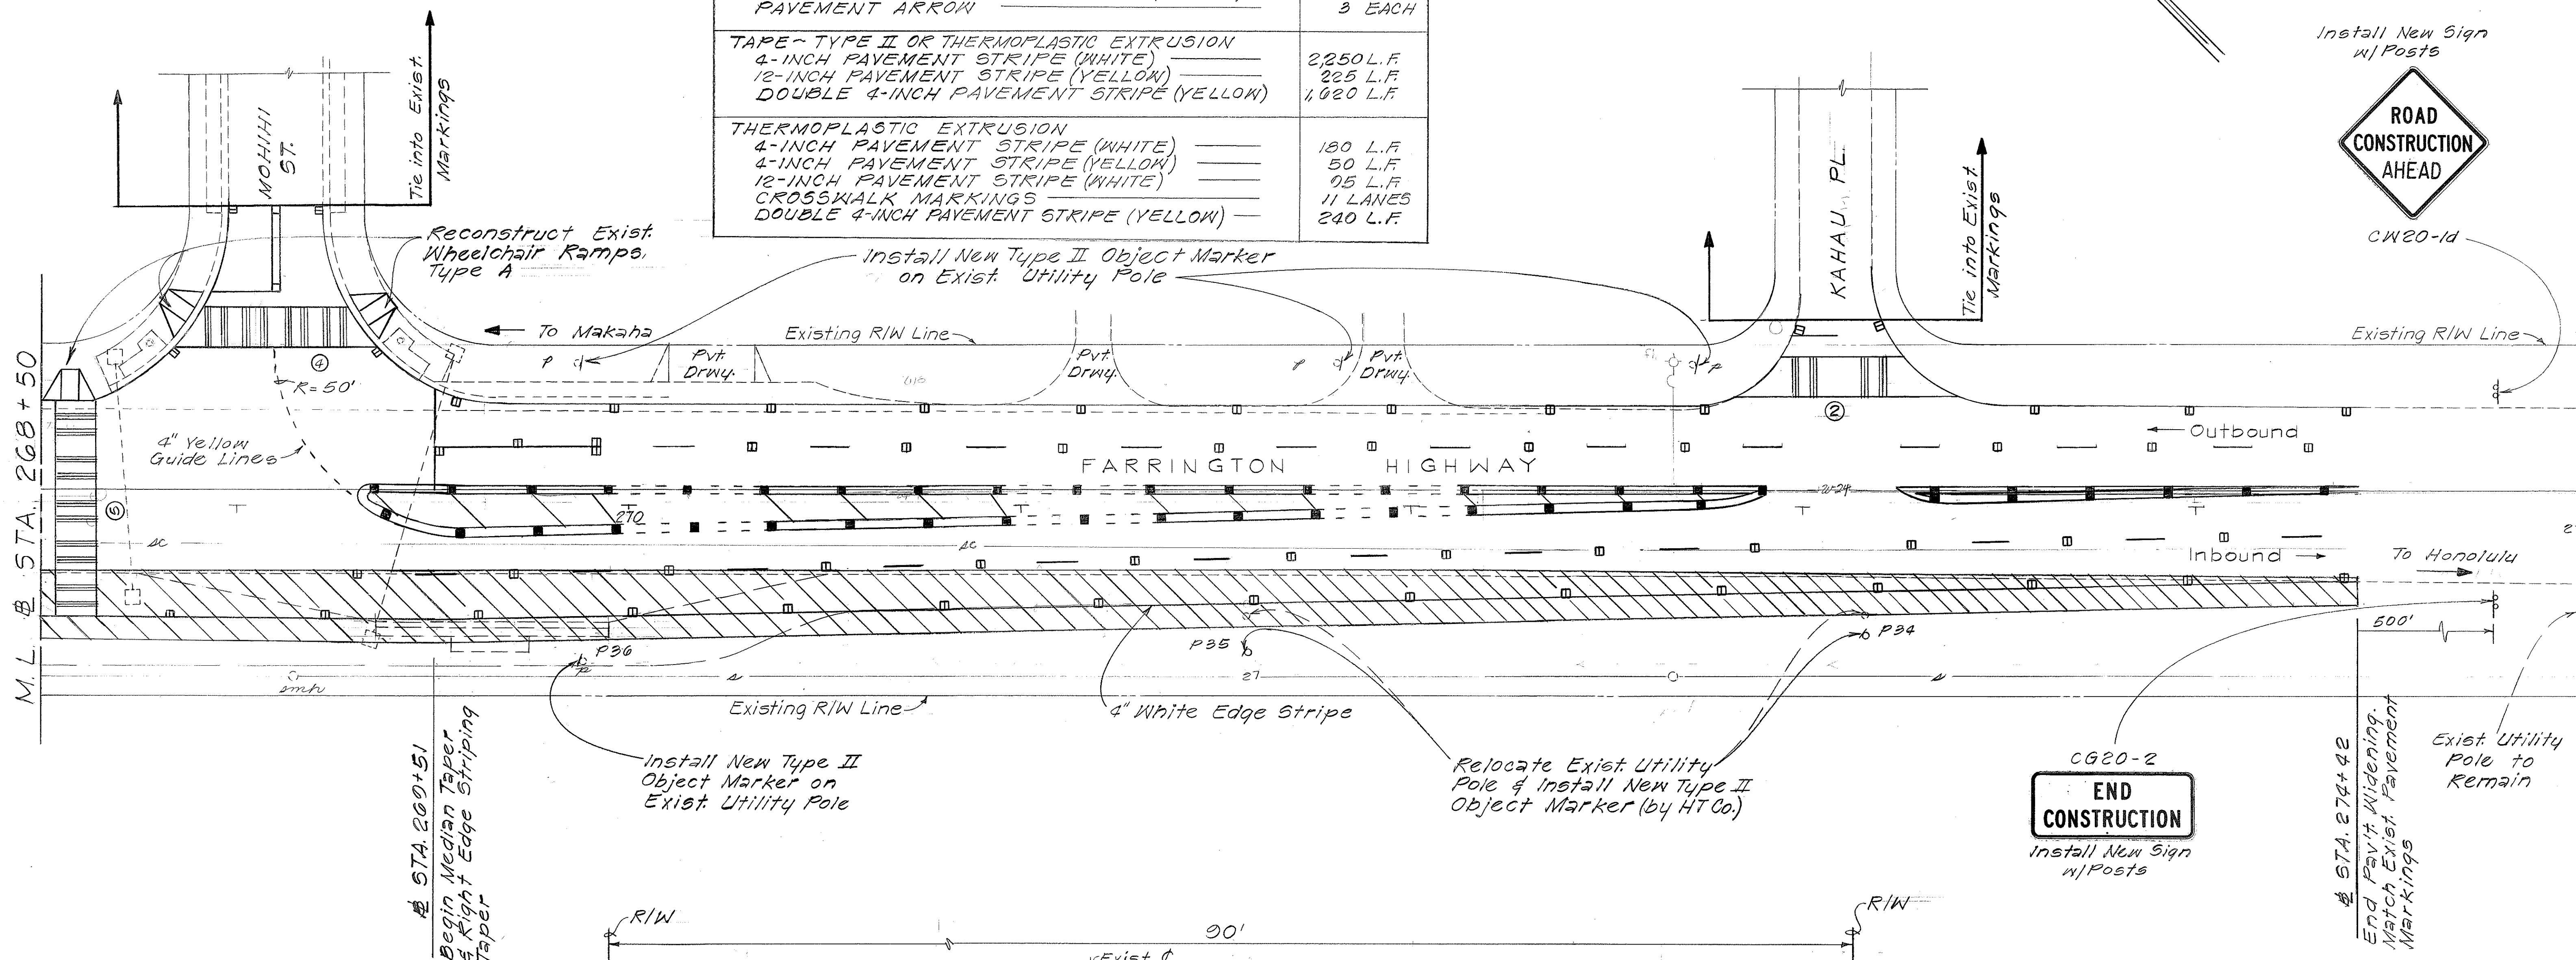

TYPICAL PAVEMENT SECTION - FARRINGTON HWY.
Scale: 3/16" = 1'-0"

10/20/92	Reconstruct Exist. Wheelchair Ramps, Type A
DATE	REVISION
STATE OF HAWAII DEPARTMENT OF TRANSPORTATION HIGHWAYS DIVISION	
ROADWAY & STRIPING PLAN	
FARRINGTON HIGHWAY Traffic Signal at Mohihi St PROJECT NO. 93A-02-00	
Scale: 1" = 20' Date: Mar, 1992	
SHEET NO. 2 OF 2 SHEETS	

C.O.5