

[illegible]

STATE OF HAWAII



DEPARTMENT OF TRANSPORTATION

HIGHWAYS DIVISION

HONOLULU, HAWAII

"AS BUILT"


PLANS FOR

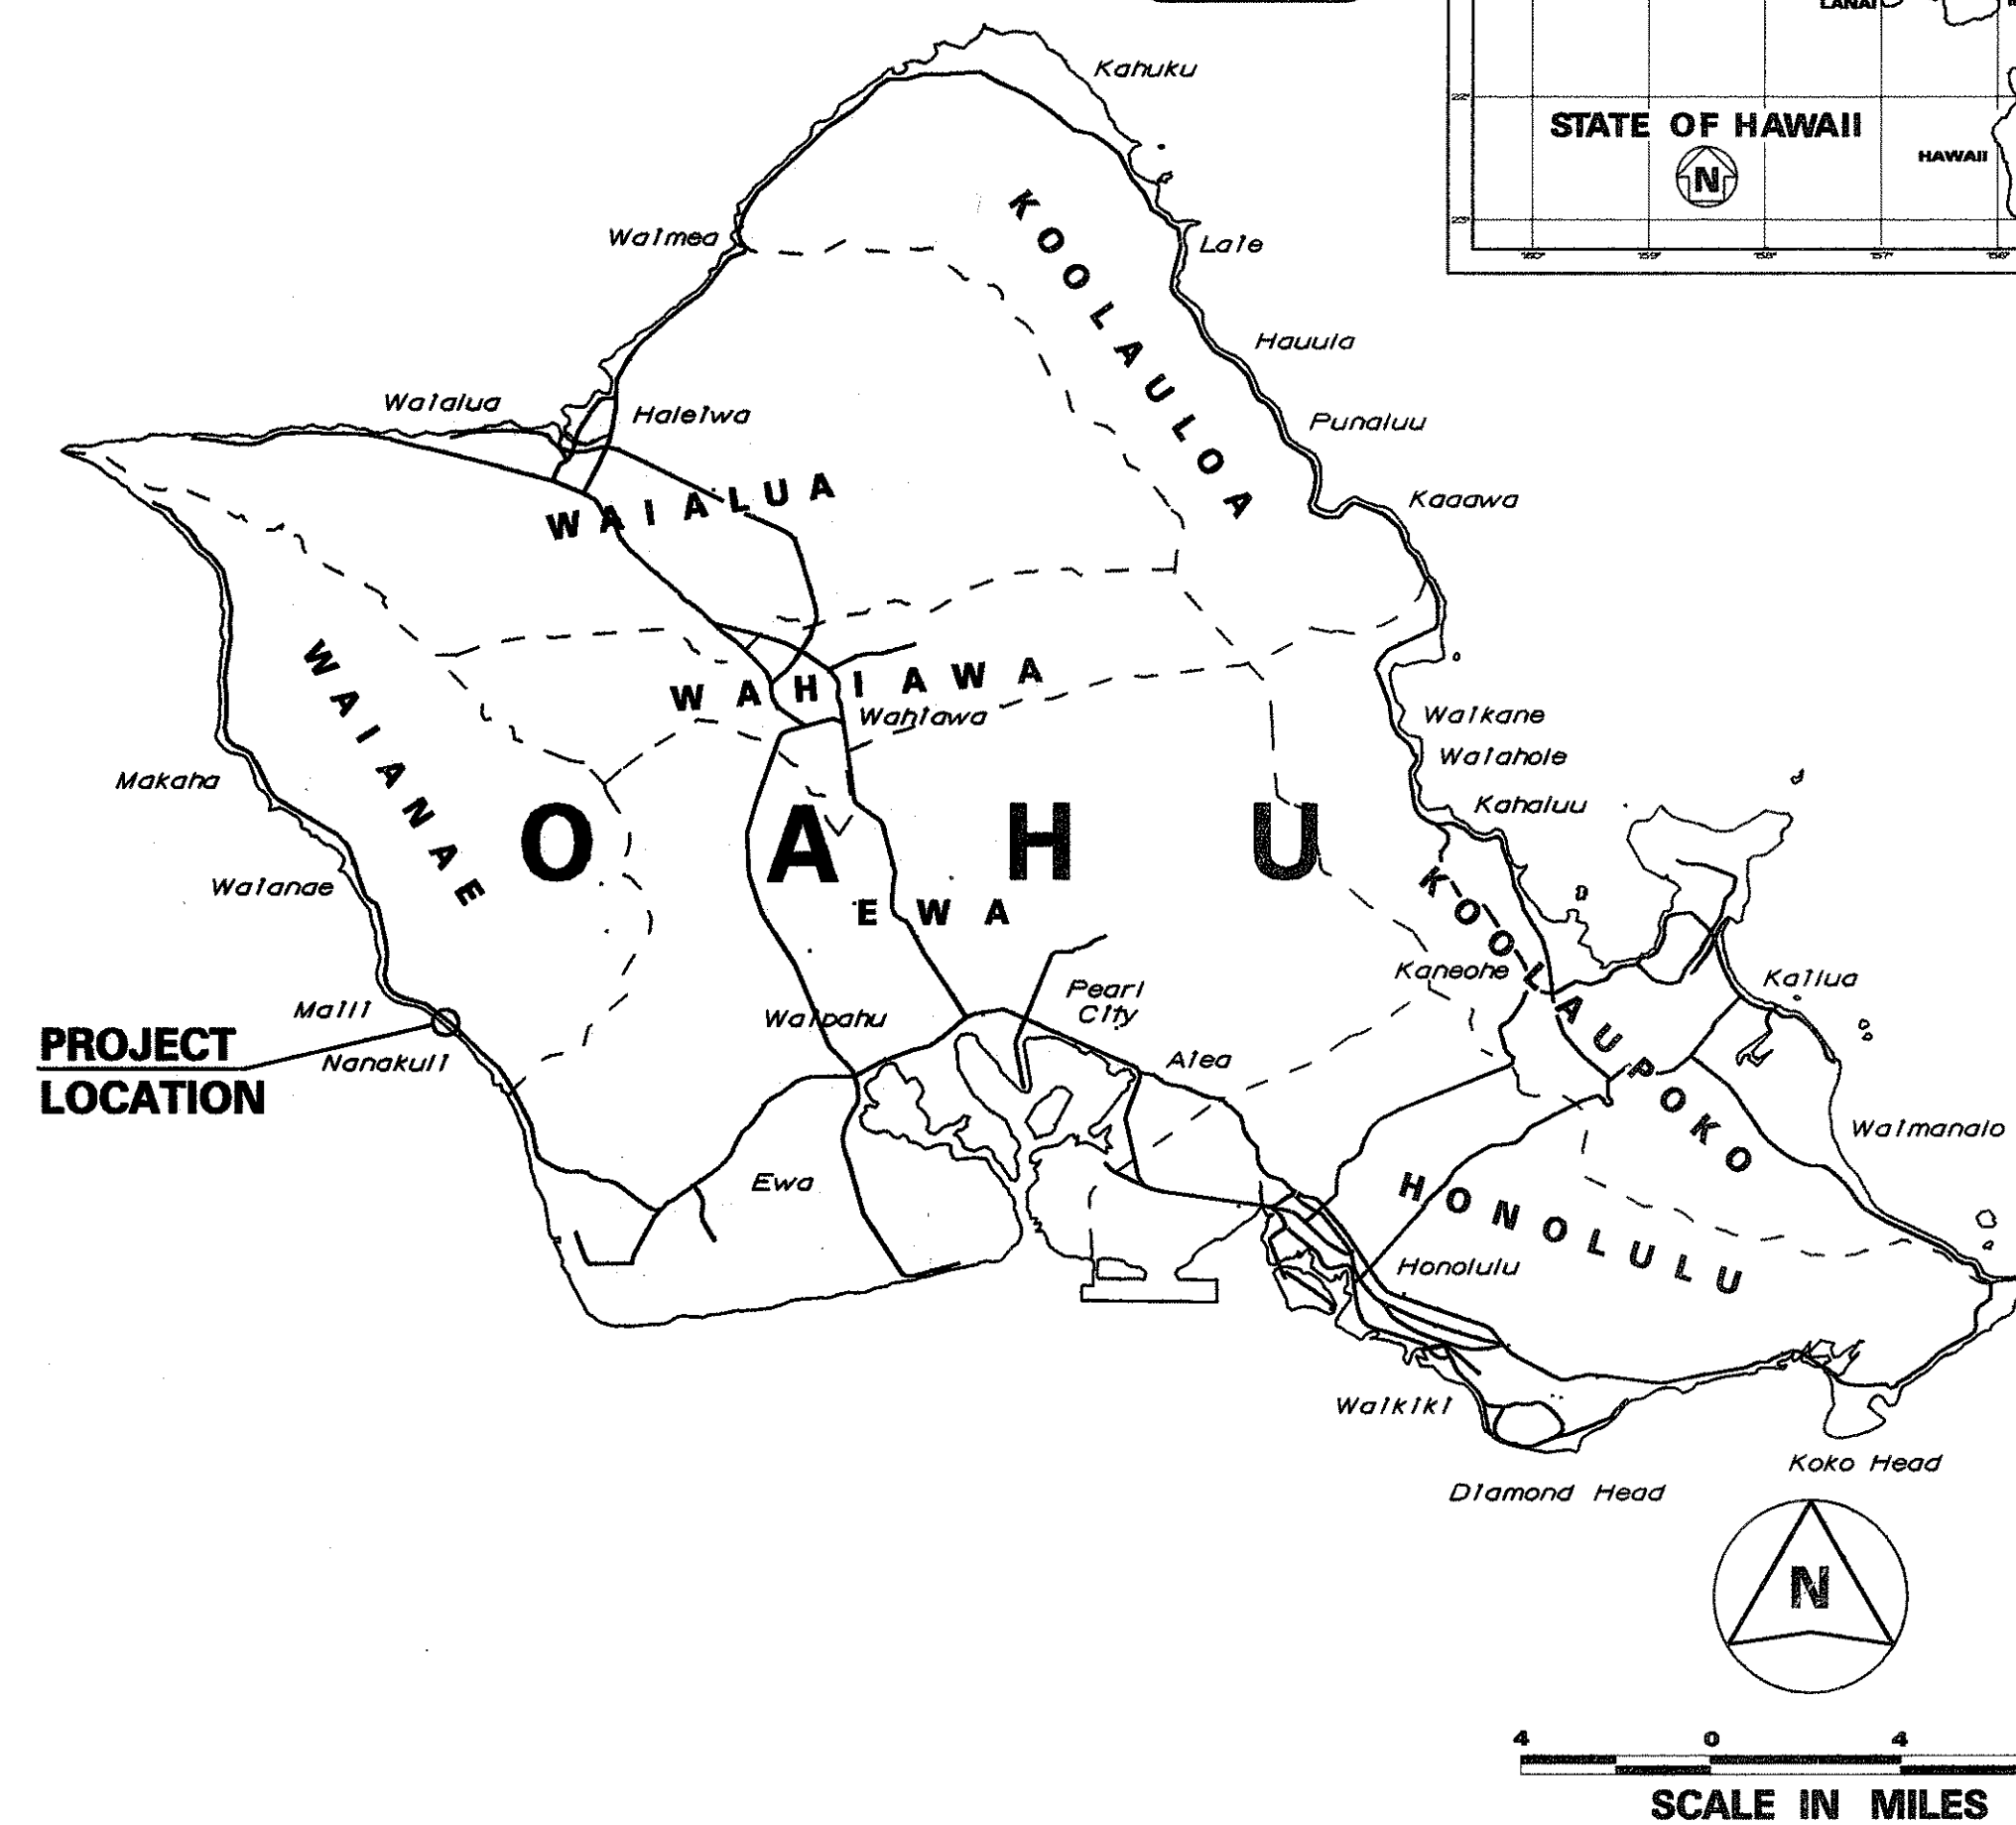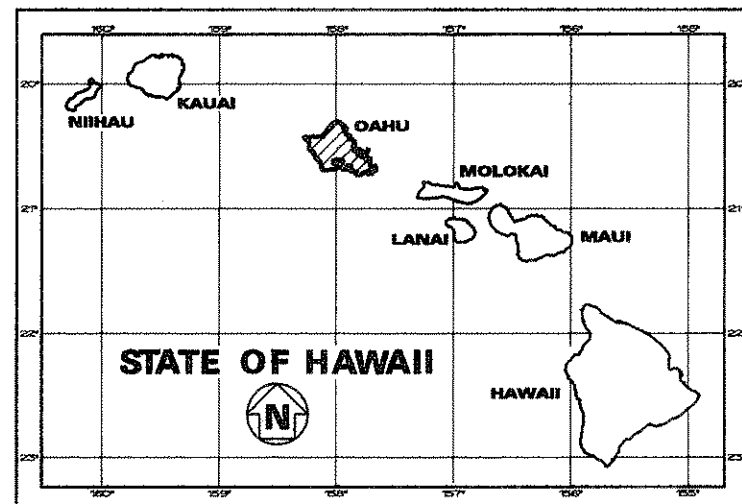


MILE POST 6.23 TO MILE POST 6.45

NO SIGNIFICANT CHANGES WERE MADE DURING
CONSTRUCTION ON THESE PLANS EXCEPT
CHANGES IN THE ORIGINAL THEORETICAL QUANTITIES.
FOR ACTUAL QUANTITIES, REFER TO PROJECT
LEDGER AND/OR COMPUTATION BOOK.

4/6/95
DATE

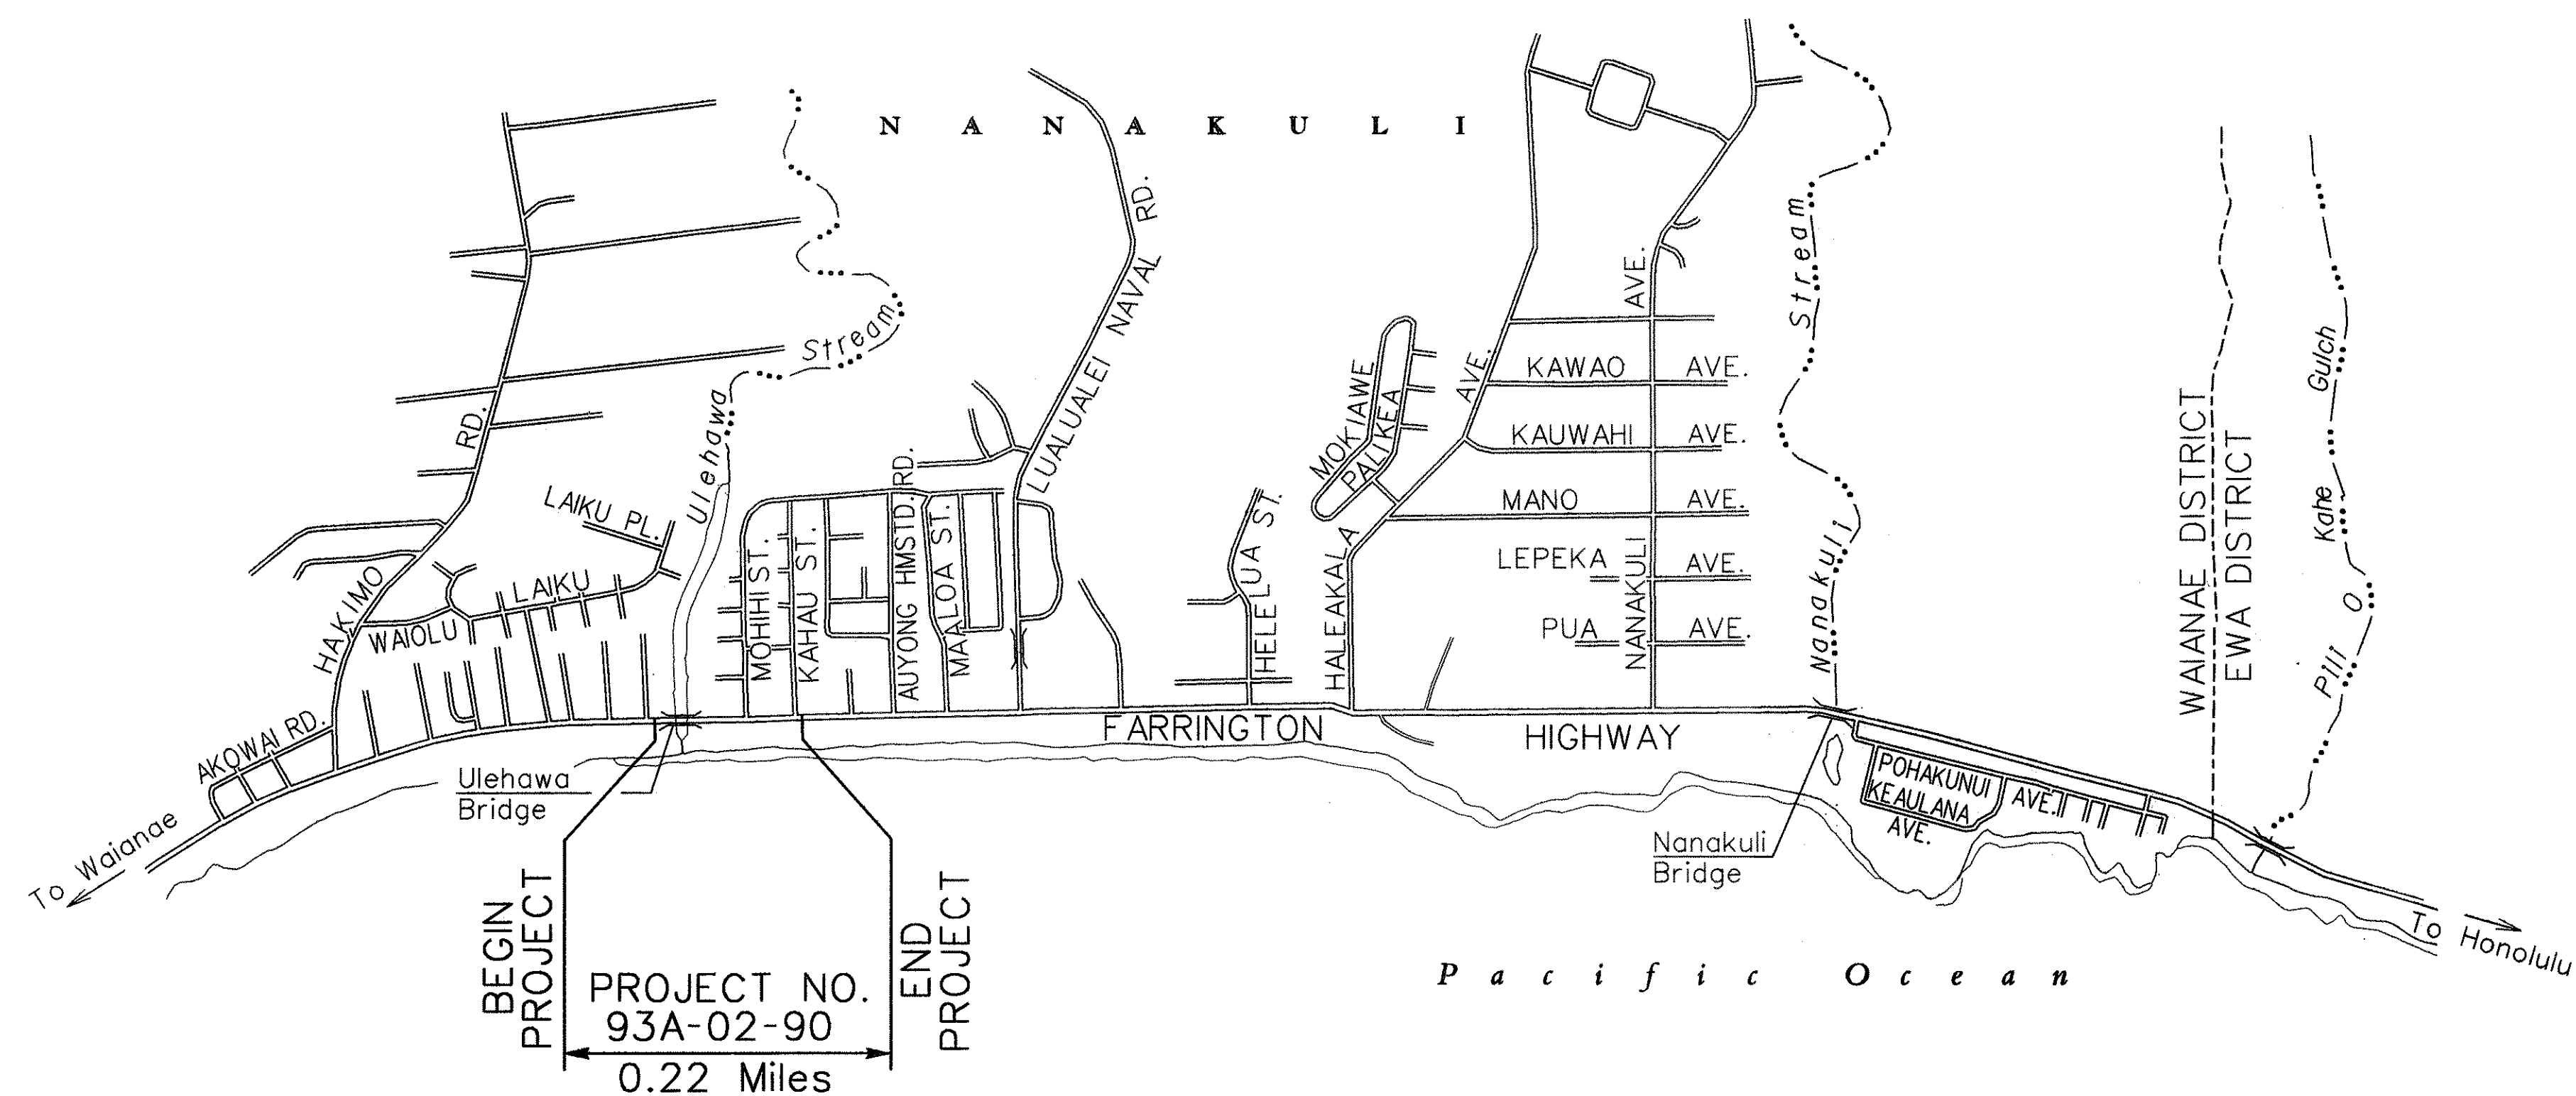

LAYOUT PLAN

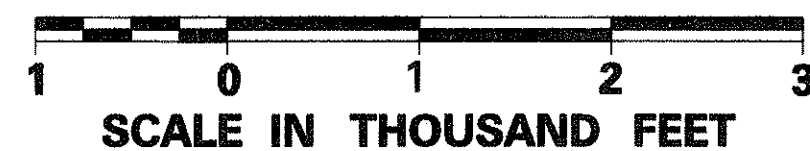

**DEPARTMENT OF TRANSPORTATION
STATE OF HAWAII**

APPROVED:

J. Harano 4/1/91
FOR DIR. OF TRANSPORTATION DATE

HWY-TD	JUNJI KASAMOTO	587-2250	MAR. 1992
DESIGNED BY	P. S. & E. BY	PHONE	DATE