
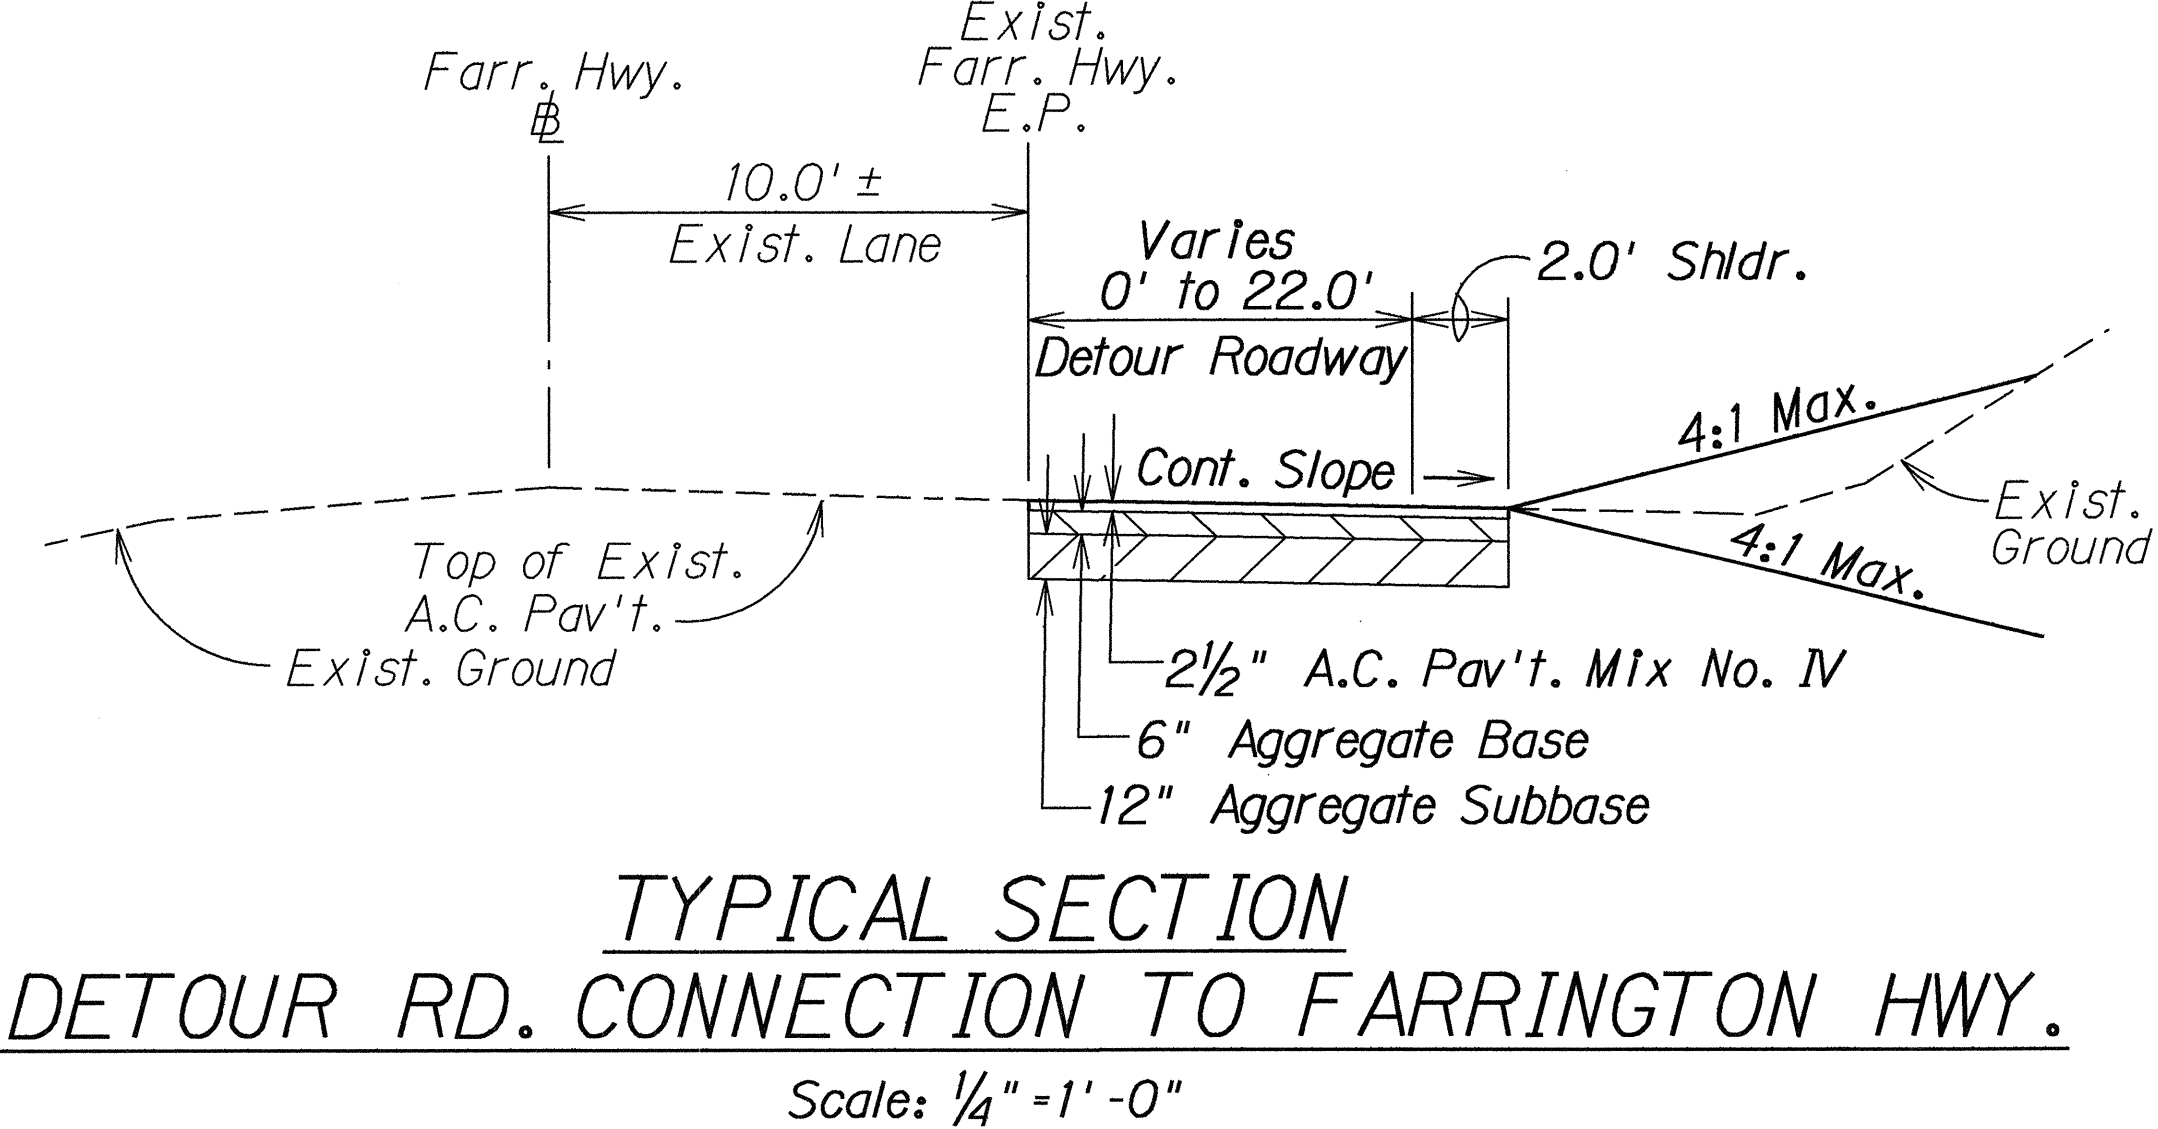
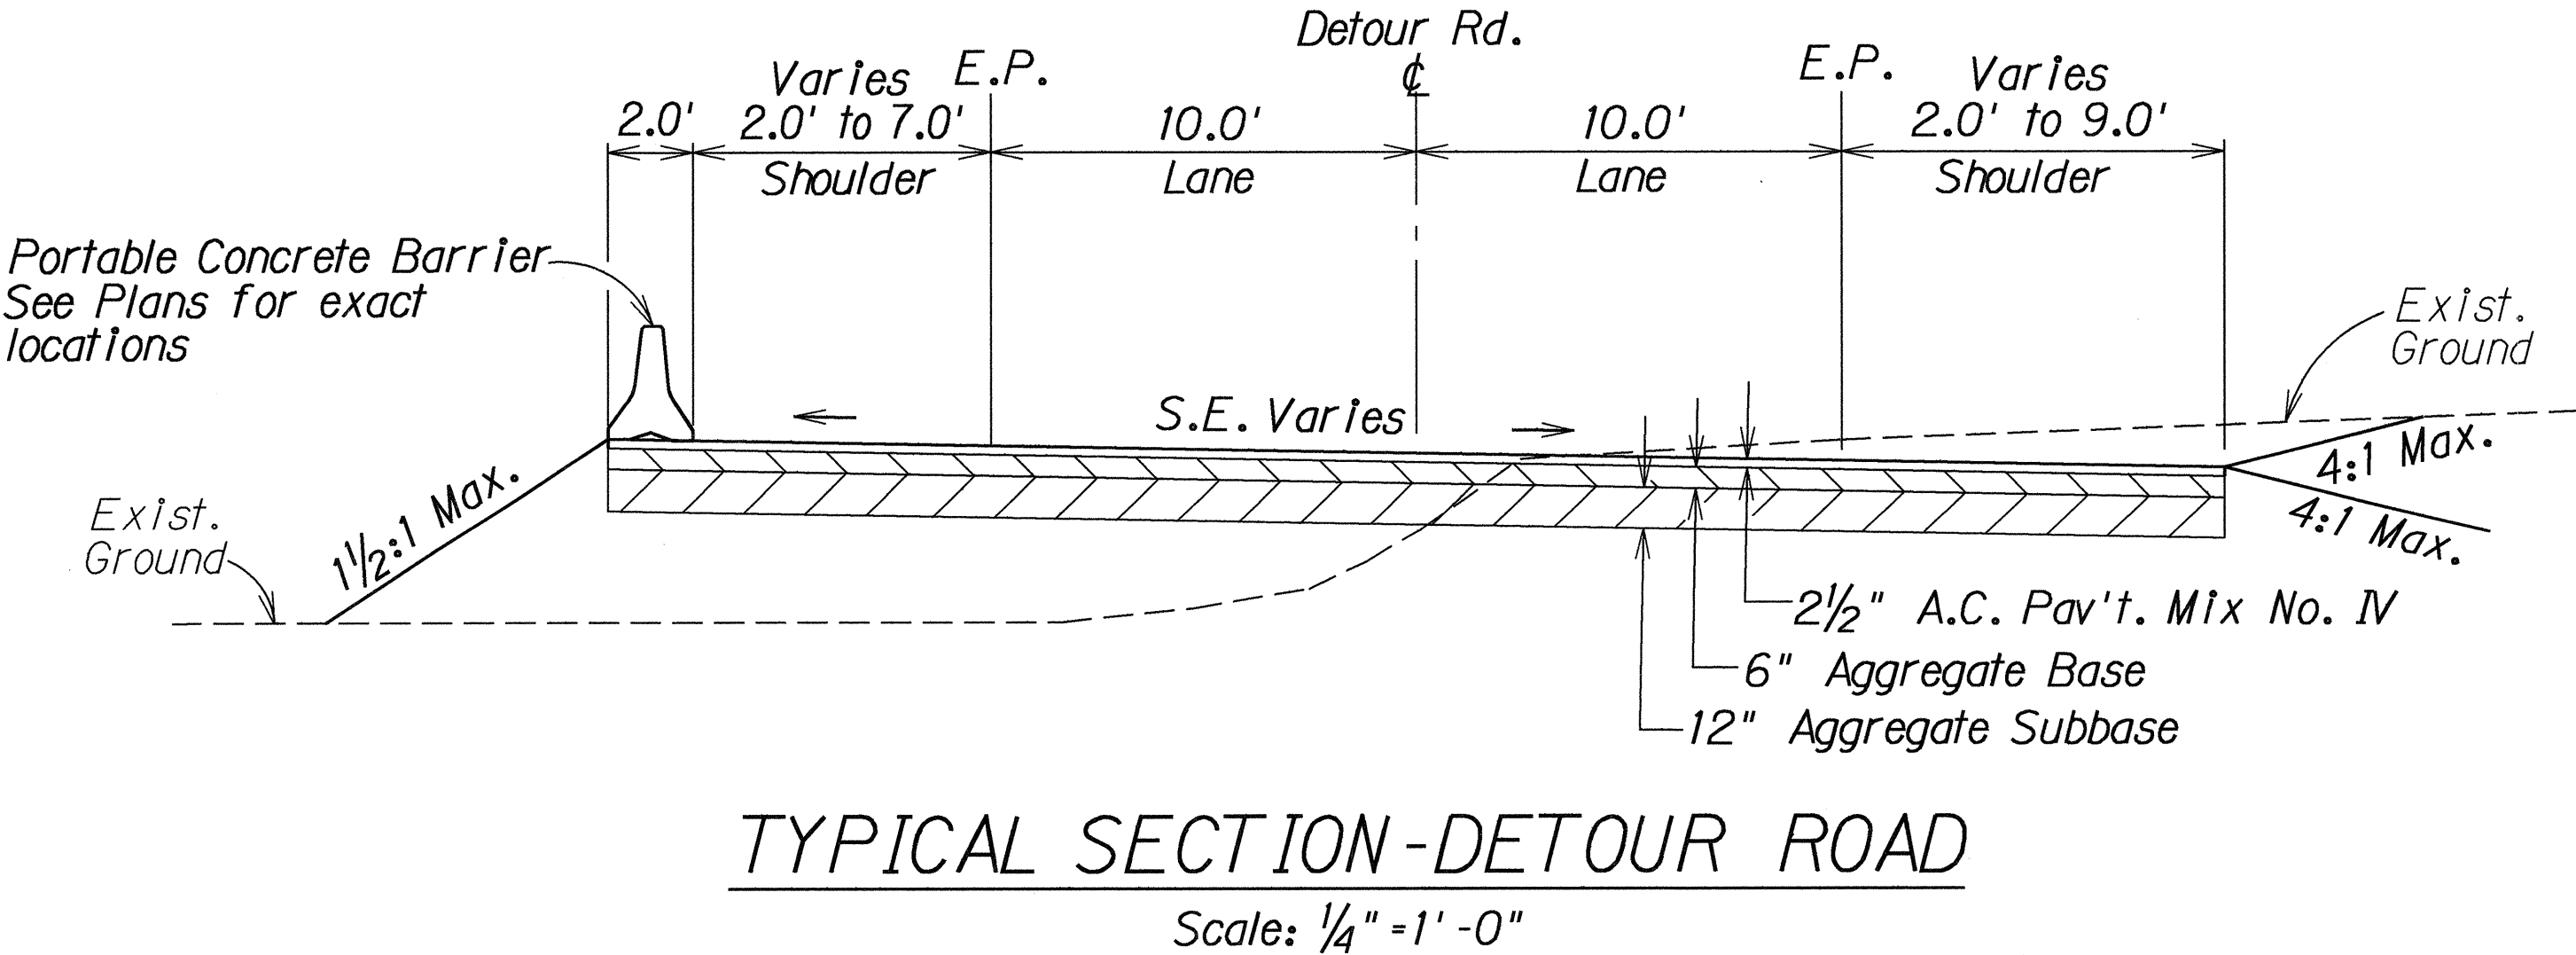
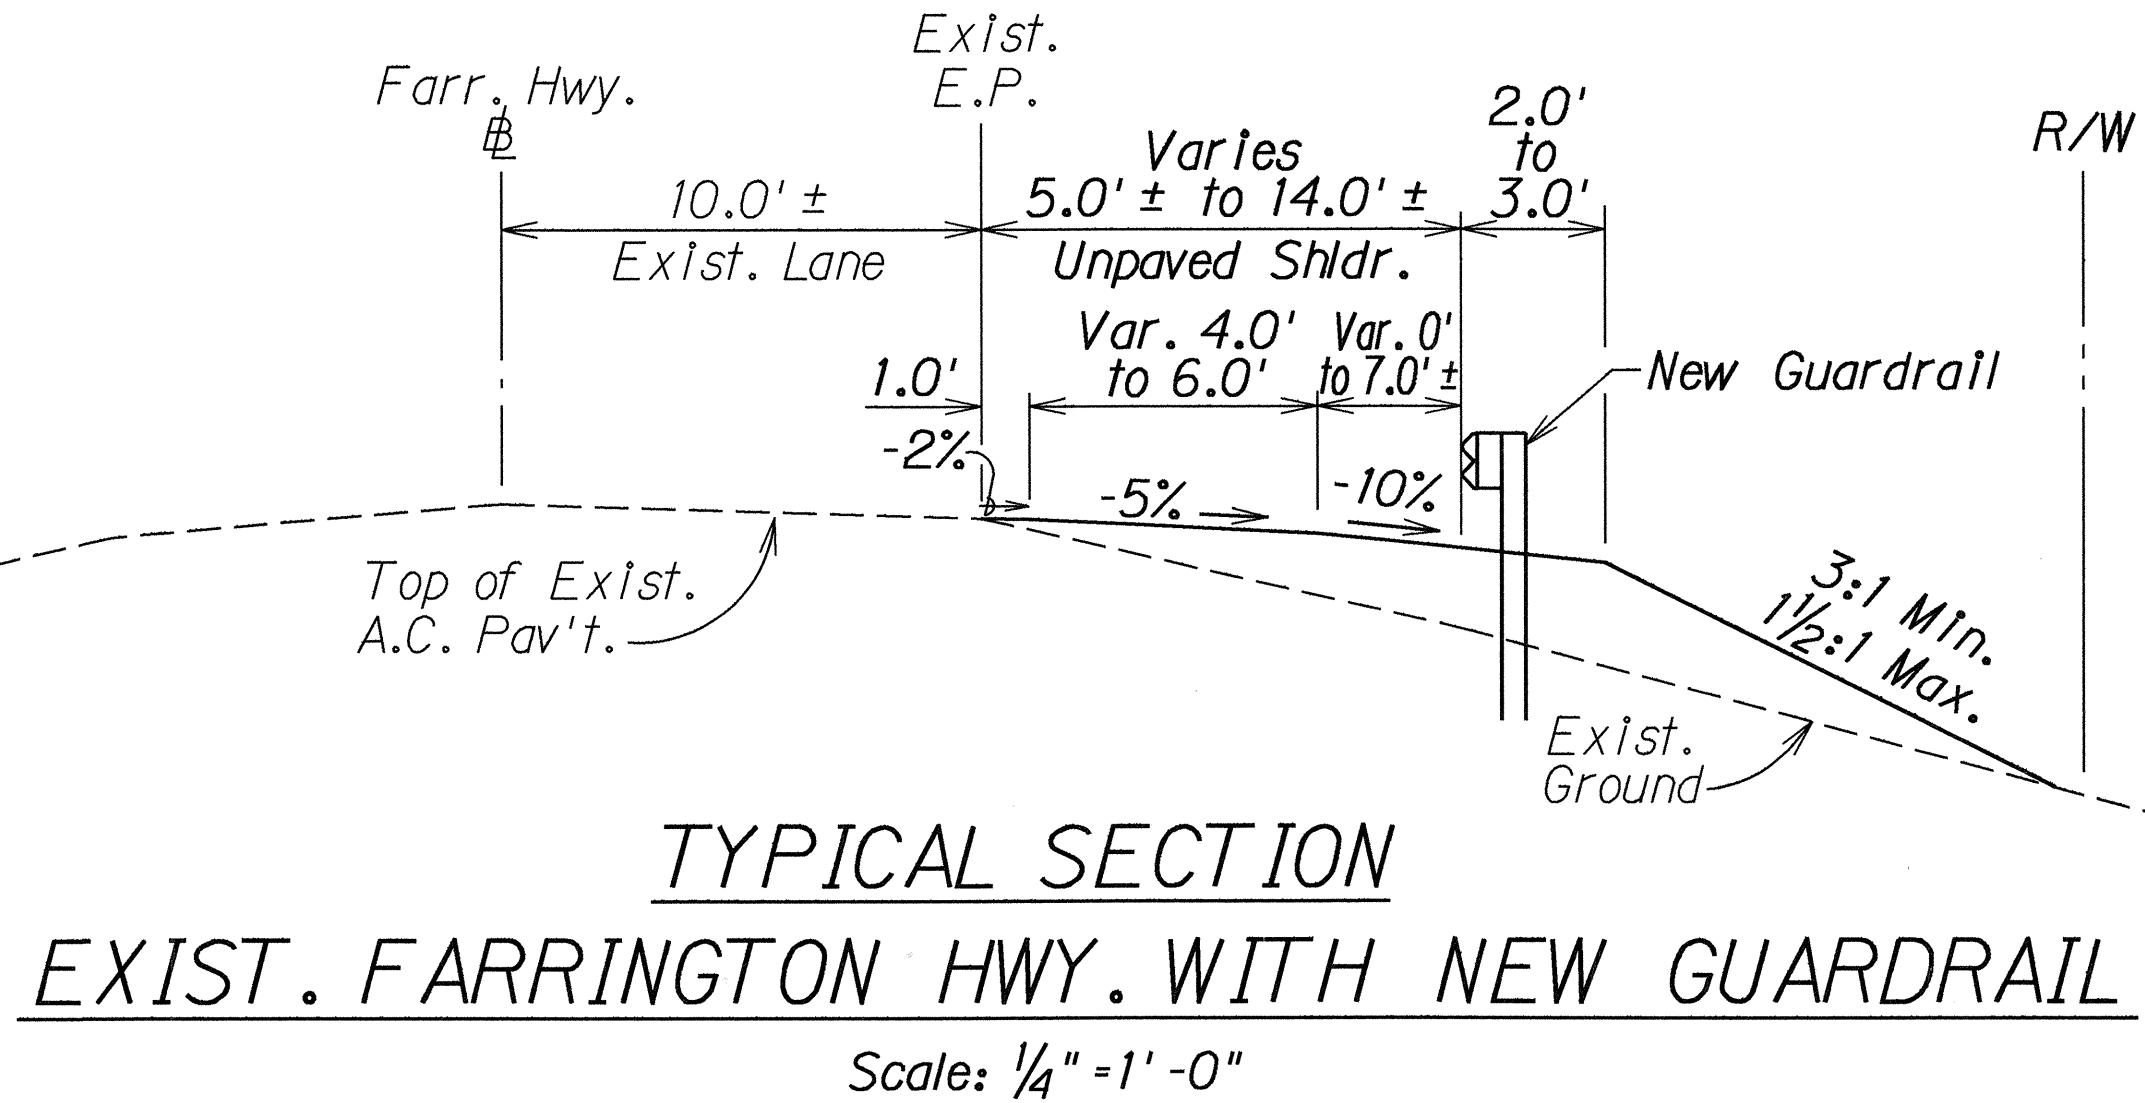
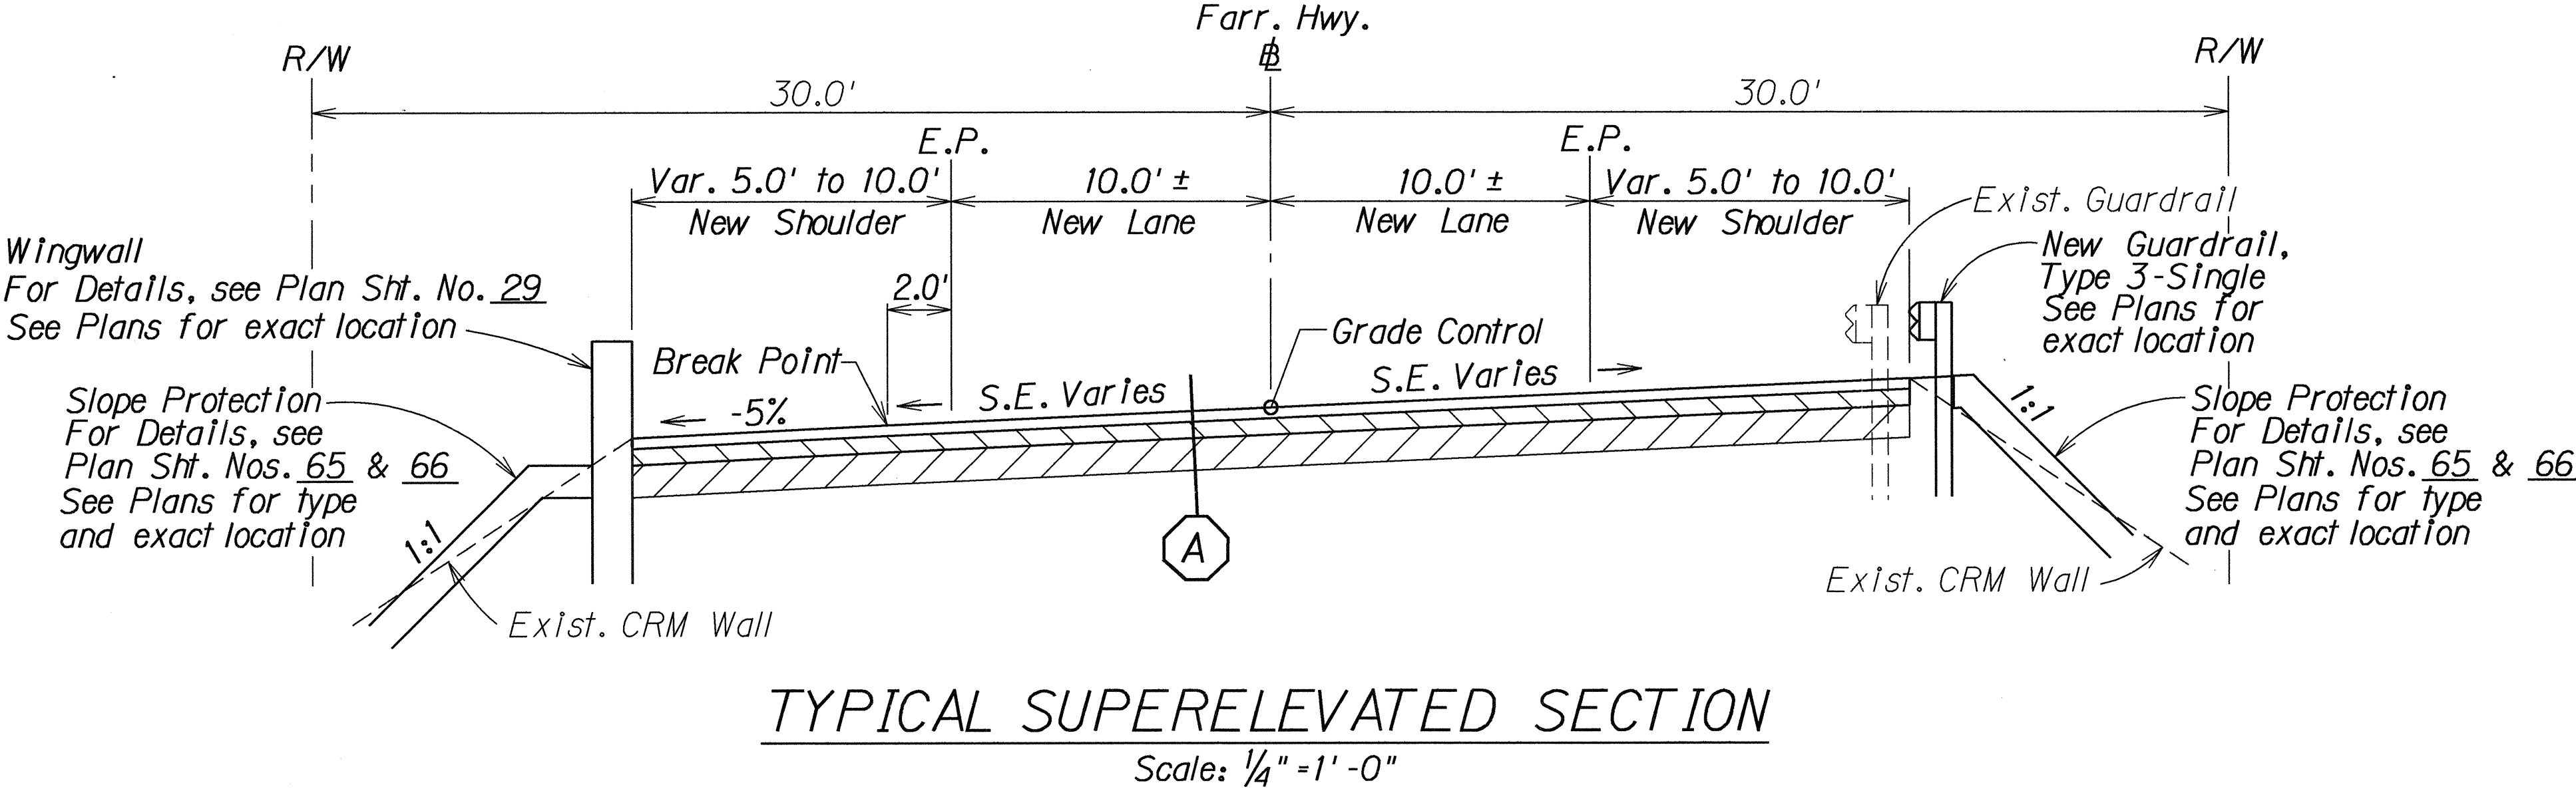


FED. ROAD DIST. NO.	STATE	FED. AID PROJ. NO.	FISCAL YEAR	SHEET NO.	TOTAL SHEETS
HAWAII	HAW.	BR-093-1(11)	1994	4	81

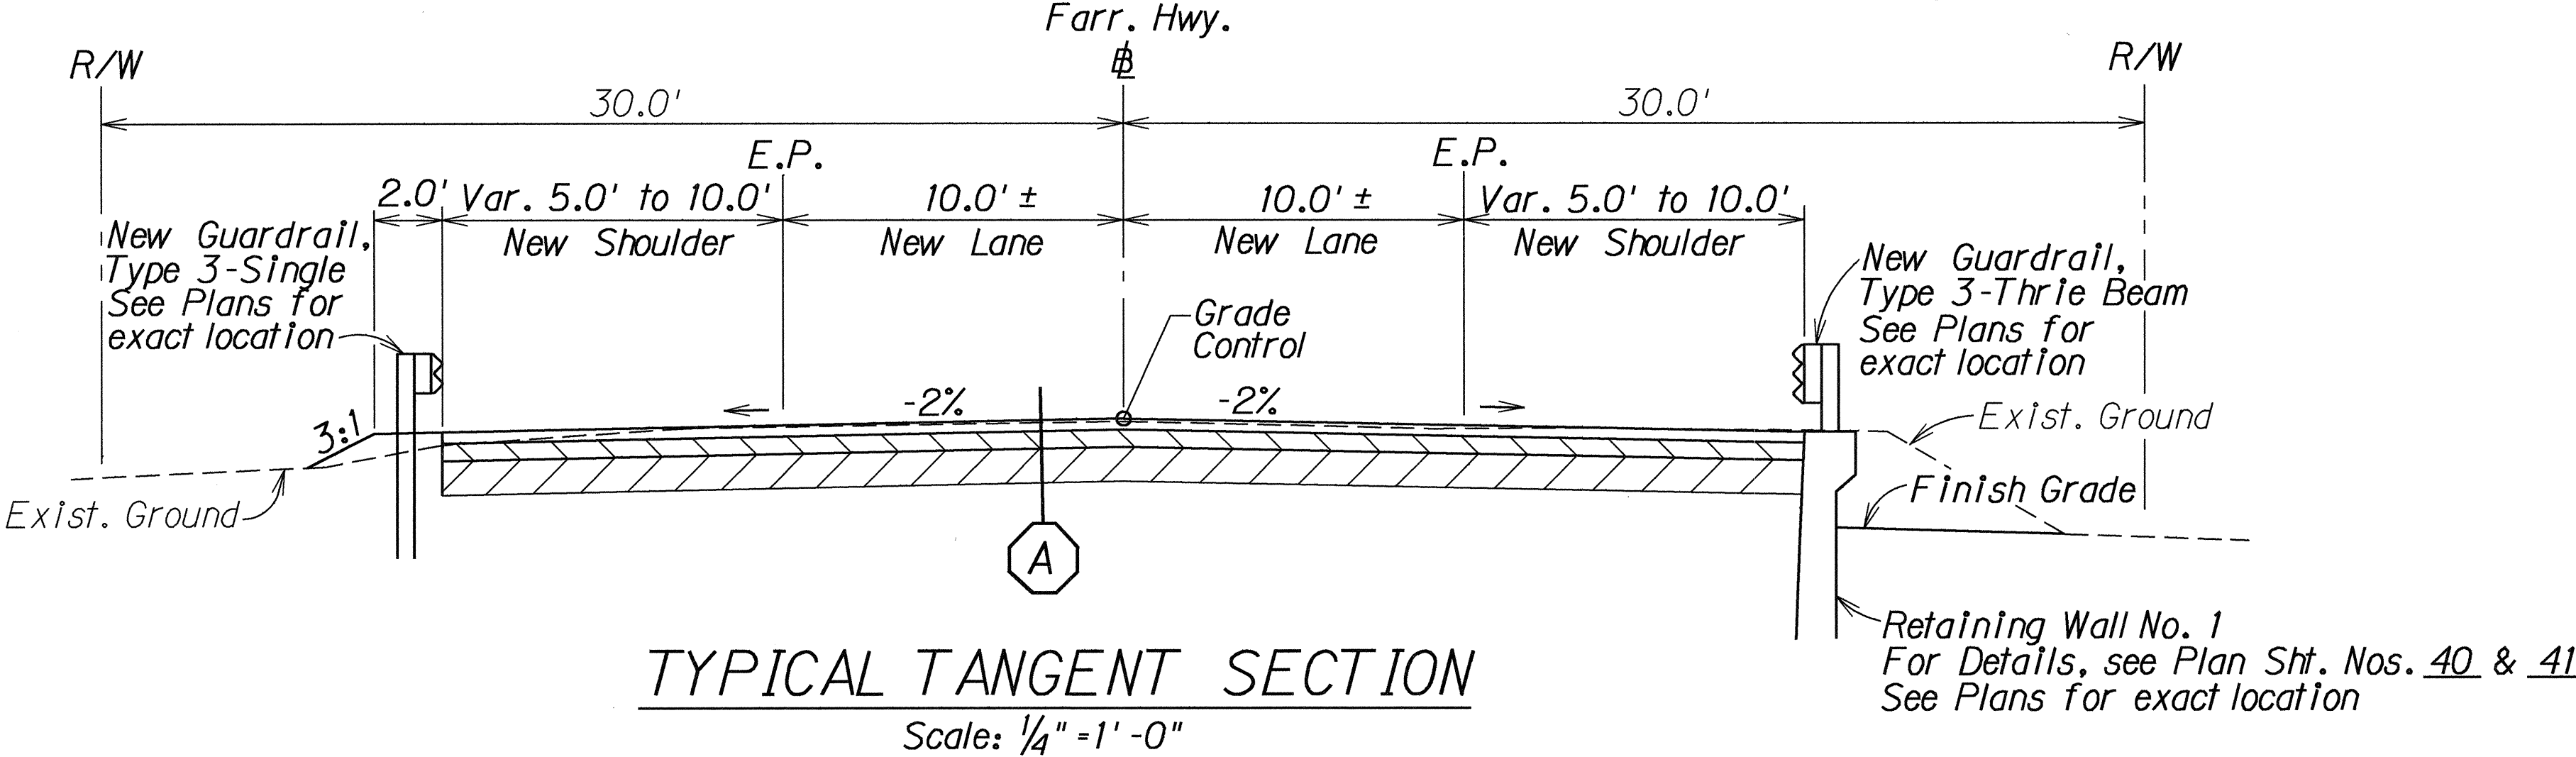

11/17/93	Replaced A.C. Pav't. Mix No. V with A.C. Pav't. Mix No. IV in Typical Sections. Deleted Pavement Structure design (B) as per Addendum No. 1
DATE	REVISION
STATE OF HAWAII DEPARTMENT OF TRANSPORTATION HIGHWAYS DIVISION	
TYPICAL SECTIONS	
FARRINGTON HIGHWAY	
Replacement of Makaha Br. Nos. 3B, 4, 5 & 5A	
F.A. PROJECT NO. BR-093-1(11)	
Scale: As Shown	Date: April, 1993
SHEET No. 1 OF 2 SHEETS	

SURVEY PLOTTED BY	DATE
DRAWN BY	
CHECKED BY	
NOTES	
QUANTITIES BY	
CHECKED BY	