

INDEX TO DRAWINGS	
SHEET NO.	DESCRIPTION
1	TITLE SHEET
2	STANDARD PLANS SUMMARY
3	GENERAL NOTES AND LEGEND
4	UTILITY NOTES
5 - 6	TYPICAL SECTIONS, SCHEDULE AND DETAILS
7 - 15	ROADWAY PLAN
16	GUARDRAIL SCHEDULE
17 - 19	M.E.L.T. DETAILS
20 - 32	STRIPING AND SIGNING PLAN

STATE OF HAWAII

DEPARTMENT OF TRANSPORTATION

HIGHWAYS DIVISION

HONOLULU, HAWAII

"AS-BUILT"

PLANS FOR

FARRINGTON HIGHWAY RESURFACING

ALIINUI DRIVE TO PALAILAI INTERCHANGE,



INCLUDING H-1 ON/OFF RAMP

PROJECT NO. 93A-01-96M



DISTRICT OF EWA

ISLAND OF OAHU

FED. ROAD DIST. NO.	STATE	PROJ. NO.	FISCAL YEAR	SHEET NO.	TOTAL SHEETS
HAWAII	HAW.	93A-01-96M	1996	1	32

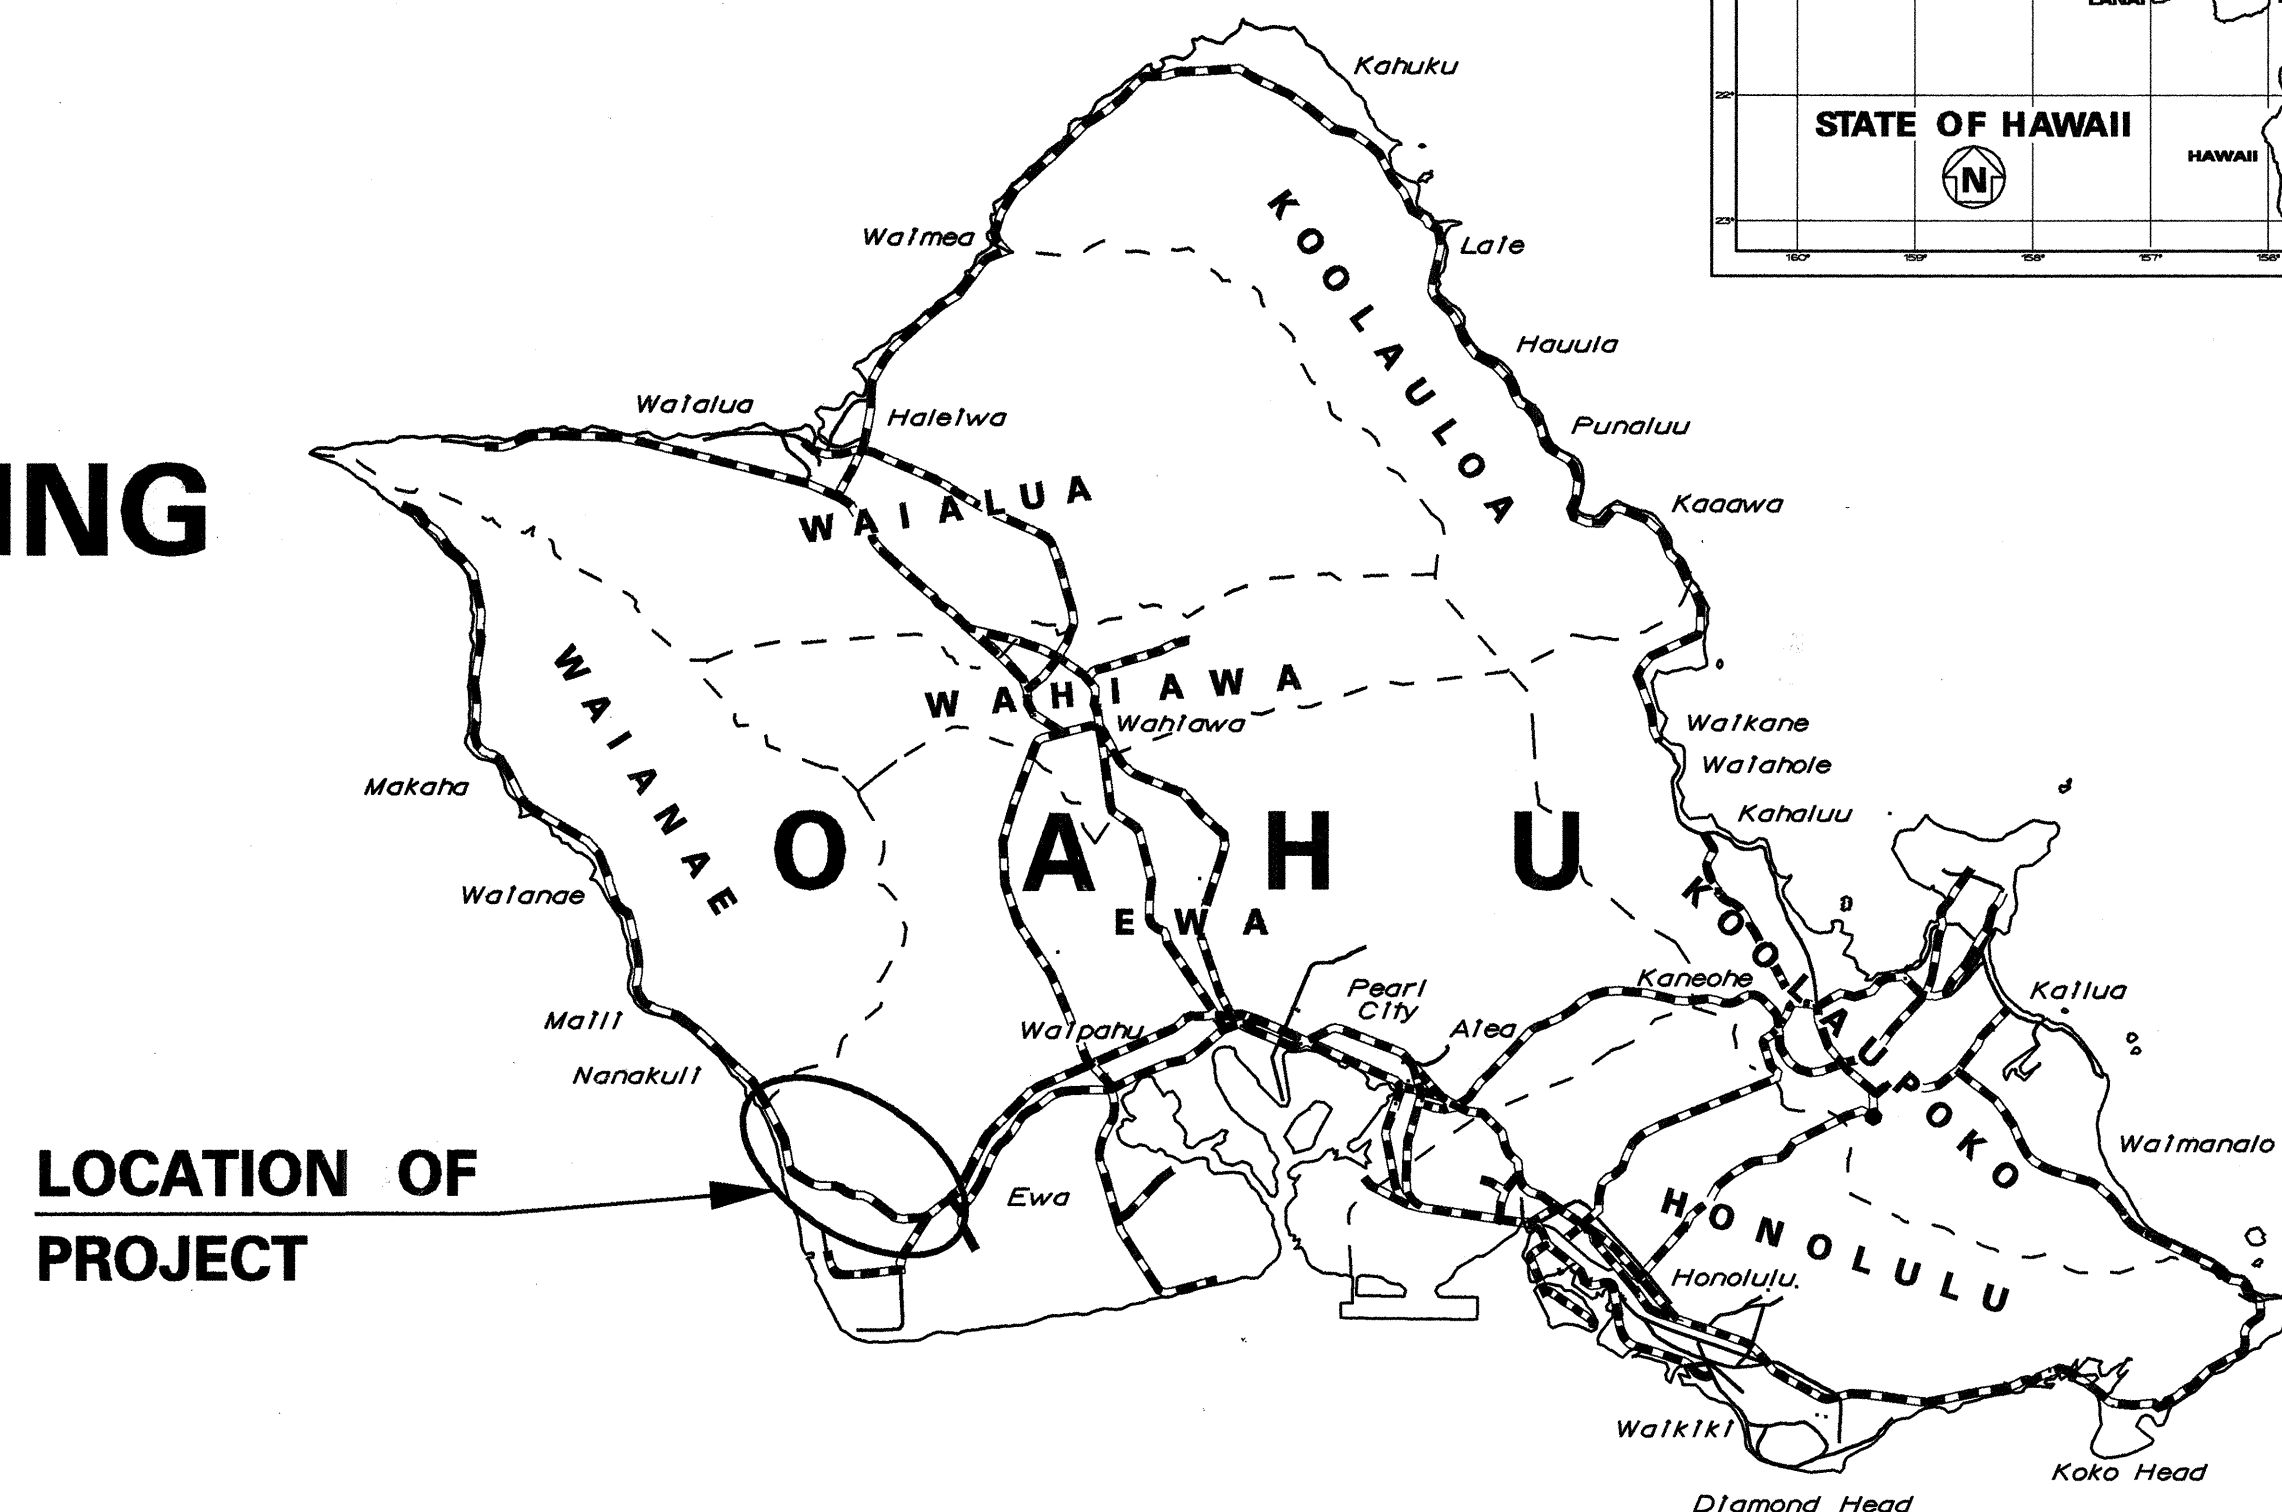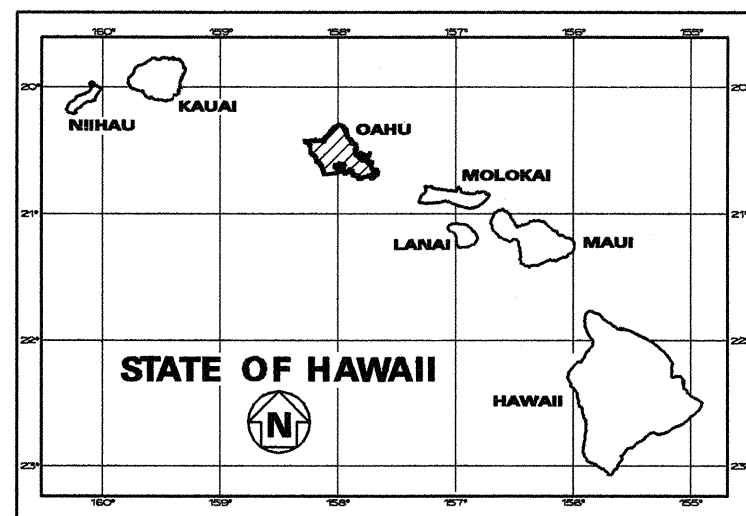


LOCATION OF PROJECT

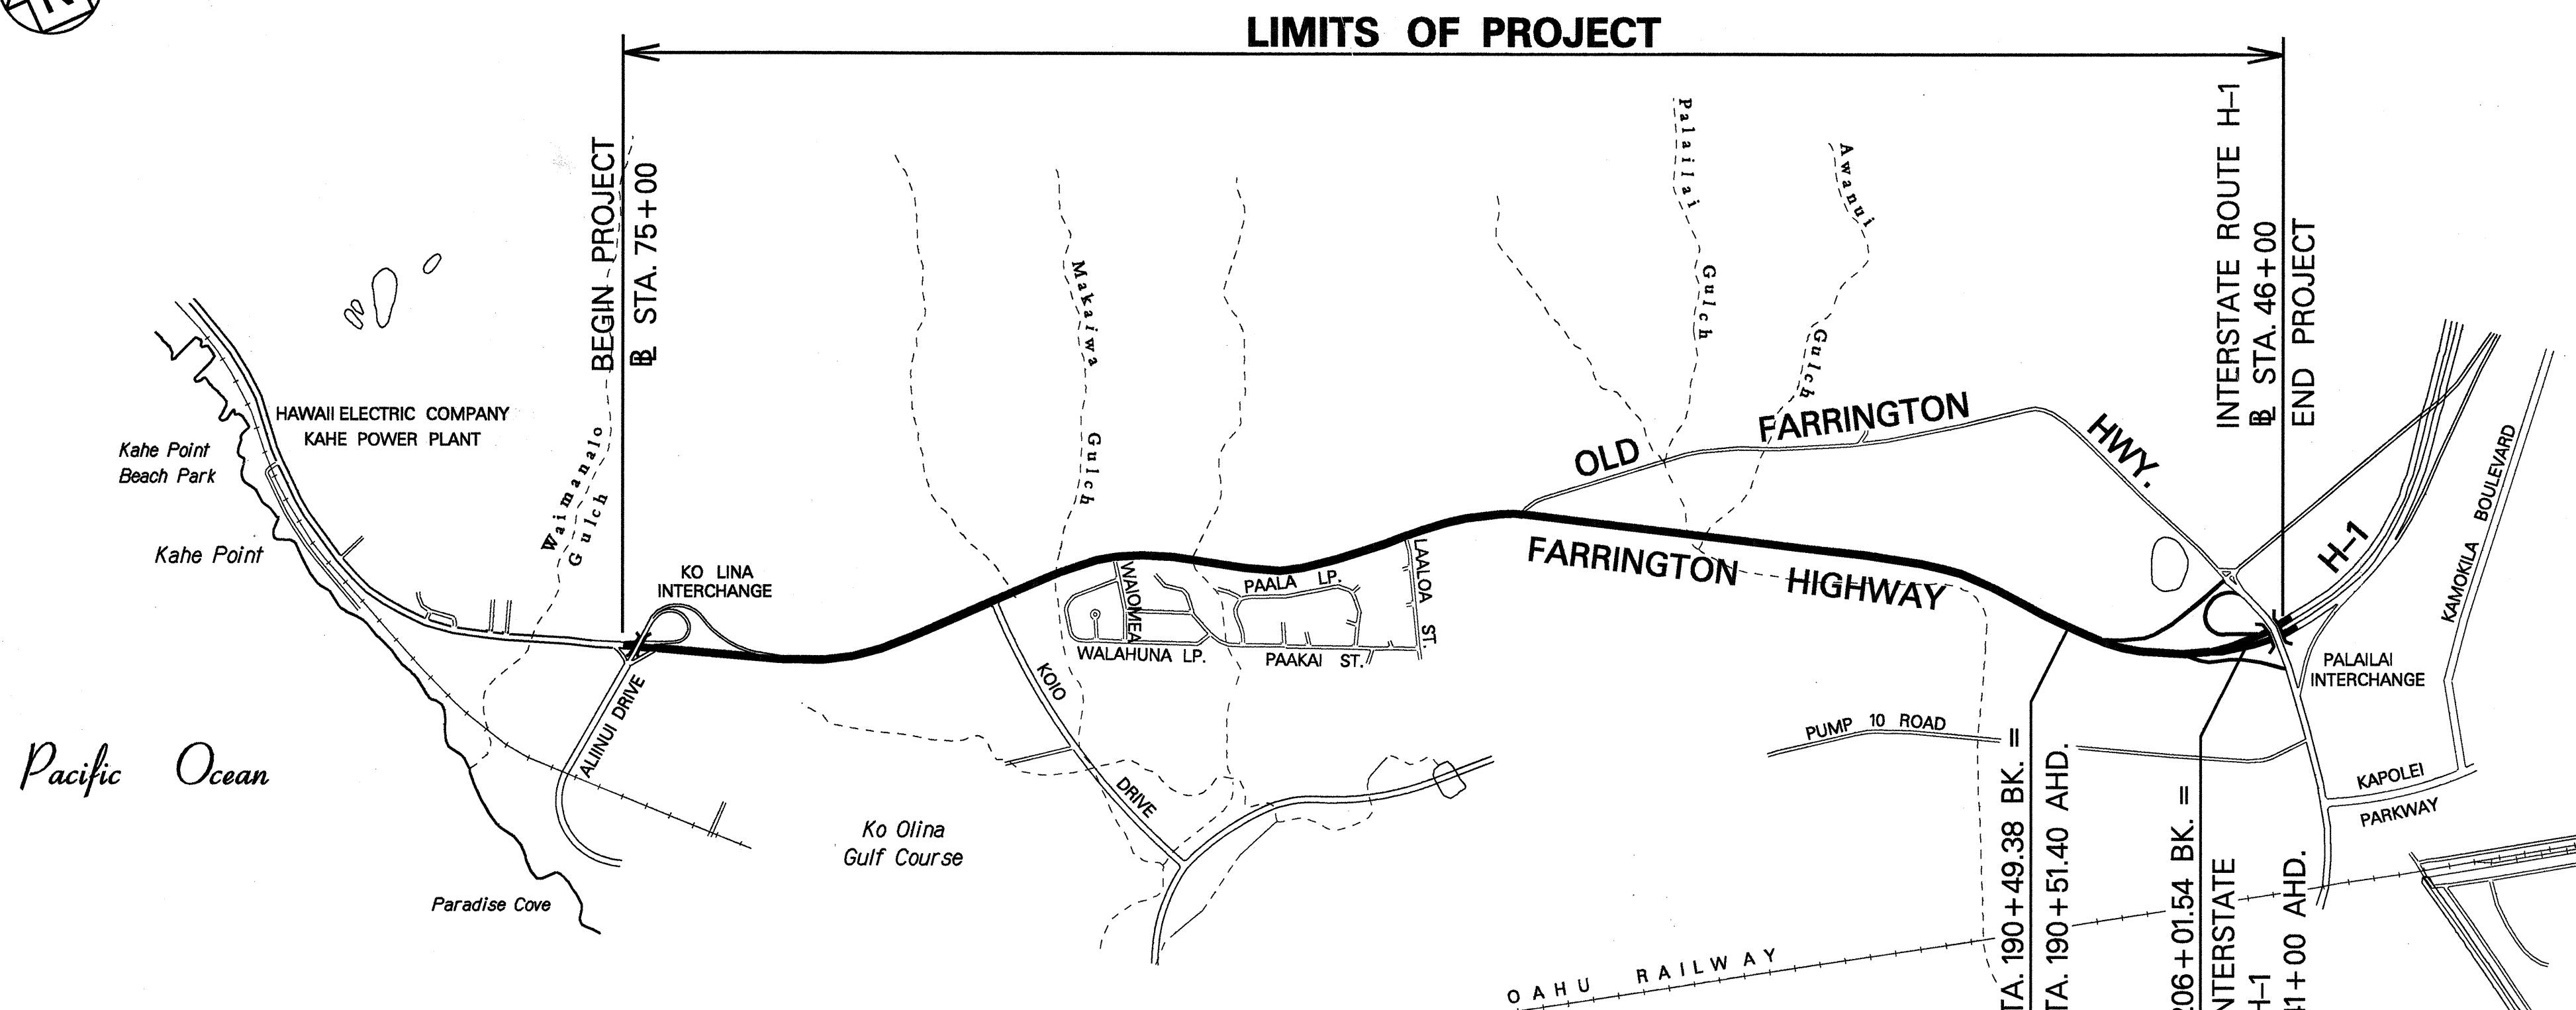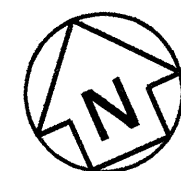

LOCATION PLAN

GROSS LENGTH OF PROJECT..... 2.57 MILES

NET LENGTH OF PROJECT..... 2.57 MILES

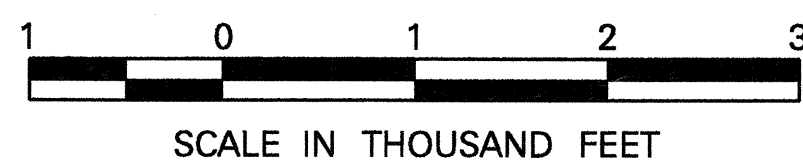

FEDERAL AID PROJECTS PREVIOUSLY CONSTRUCTED OR UNDER CONSTRUCTION

MILE POST 2.570 TO MILE POST 0.000

CHANGES MADE DURING CONSTRUCTION HAVE BEEN INCORPORATED ON THESE PLANS EXCEPT CHANGES IN THE ORIGINAL THEORETICAL QUANTITIES.

RESIDENT ENGINEER

9/21/93

DATE

DEPARTMENT OF TRANSPORTATION STATE OF HAWAII	
APPROVED:	
<i>Kay Hayschick</i>	4/1/96
DIR. OF TRANSPORTATION	DATE

DESIGN UNIT "C" DESIGNED BY

R. HIRONAKA

P.S. & E. BY

587-2250

PHONE

SEPT., 1995

DATE