


FED. ROAD DIST. NO.	STATE	PROJ. NO.	FISCAL YEAR	SHEET NO.	TOTAL SHEETS
HAWAII	HAW.	93A-01-91	1992	4	7

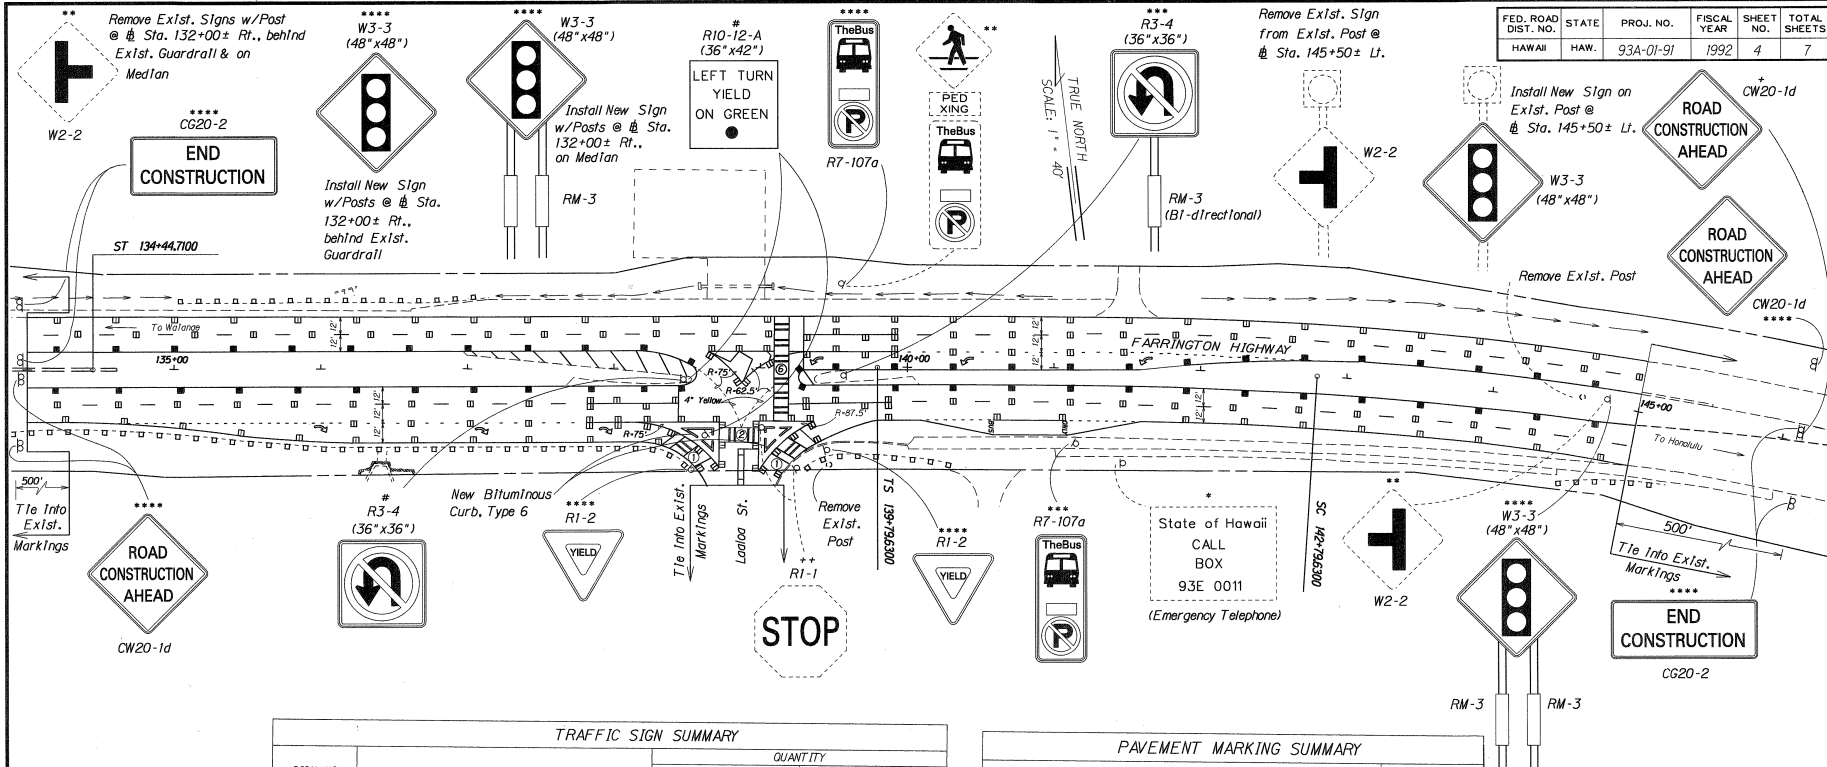

SIGN NO.	MESSAGE	QUANTITY			
		10 SQ. FT. OR LESS W/POST	W/O POST	GREATER THAN 10 SQ. FT. W/POSTS	W/O POST
R-2	YIELD	2			
R7-107a	BUS STOP	2			
R3-4	LEFT TURN YIELD ON GREEN	1	1		
R10-12-A	LEFT TURN YIELD ON GREEN				2
W3-3	ROAD CONSTRUCTION AHEAD			3	1
TOTAL		5	1	3	3

DESCRIPTION	QUANTITY
PAVEMENT MARKERS	
TYPE A	192 EACH
TYPE CL	159 EACH
TYPE DL	2 EACH
TYPE HL	54 EACH
TAPE - TYPE I OR THERMOPLASTIC EXTRUSION	
4-INCH PAVEMENT STRIPE (WHITE)	50 L.F.
8-INCH PAVEMENT STRIPE (WHITE)	305 L.F.
DOUBLE 4-INCH PAVEMENT STRIPE (YELLOW)	20 L.F.
PAVEMENT ARROW	6 EACH
PAVEMENT WORD	2 EACH
TAPE - TYPE II OR THERMOPLASTIC EXTRUSION	
4-INCH PAVEMENT STRIPE (WHITE)	2,170 L.F.
4-INCH PAVEMENT STRIPE (YELLOW)	2,130 L.F.
8-INCH PAVEMENT STRIPE (WHITE)	430 L.F.
12-INCH PAVEMENT STRIPE (WHITE)	70 L.F.
12-INCH PAVEMENT STRIPE (YELLOW)	130 L.F.
THERMOPLASTIC EXTRUSION	
4-INCH PAVEMENT STRIPE (WHITE)	800 L.F.
4-INCH PAVEMENT STRIPE (YELLOW)	90 L.F.
12-INCH PAVEMENT STRIPE (WHITE)	140 L.F.
CROSSWALK MARKINGS	10 LANES

SIGN NO.	MESSAGE	W/POSTS	W/O POST
CG20-2	END CONSTRUCTION	4	0
CG20-2	ROAD CONSTRUCTION AHEAD	3	1
TOTAL		7	1

- KEY:**
- * Exst. Sign(s) & Post(s) to Remain
 - ** Remove Exst. Sign(s) & Post(s)
 - *** Remove Exst. Sign(s) & Post(s) & Install New Sign(s) w/Post(s)
 - **** Install New Sign(s) w/Post(s)
 - # Install New Sign on Traffic Signal Post
 - ## Install New Sign w/Pedestrian Push Button on Traffic Signal Post
 - + Install New Sign(s) on Exst. Post(s)
 - ++ Remove Exst. Sign(s) w/Post(s) after the New Traffic Signal Is operational

10/08/92	Add sign R10-12-A
05/26/92	Remove Striping from Islands. Add New A.C. Curb & Revise Pavement Marking Summary
DATE	REVISION

STATE OF HAWAII
DEPARTMENT OF TRANSPORTATION
HIGHWAYS DIVISION
PAVEMENT MARKING & SIGNING PLAN
FARRINGTON HIGHWAY
Intersection Improvements at Laaloa Street
PROJECT NO. 93A-01-91

Scale: 1"=40' Date: April, 1992
SHEET No. 1 OF 1 SHEETS

C.O. ADD. 4

ORIGINAL PLAN
 CHECKED BY
 DATE
 DESIGNED BY
 DATE
 DRAWN BY
 DATE
 IN CHARGE BY
 DATE