

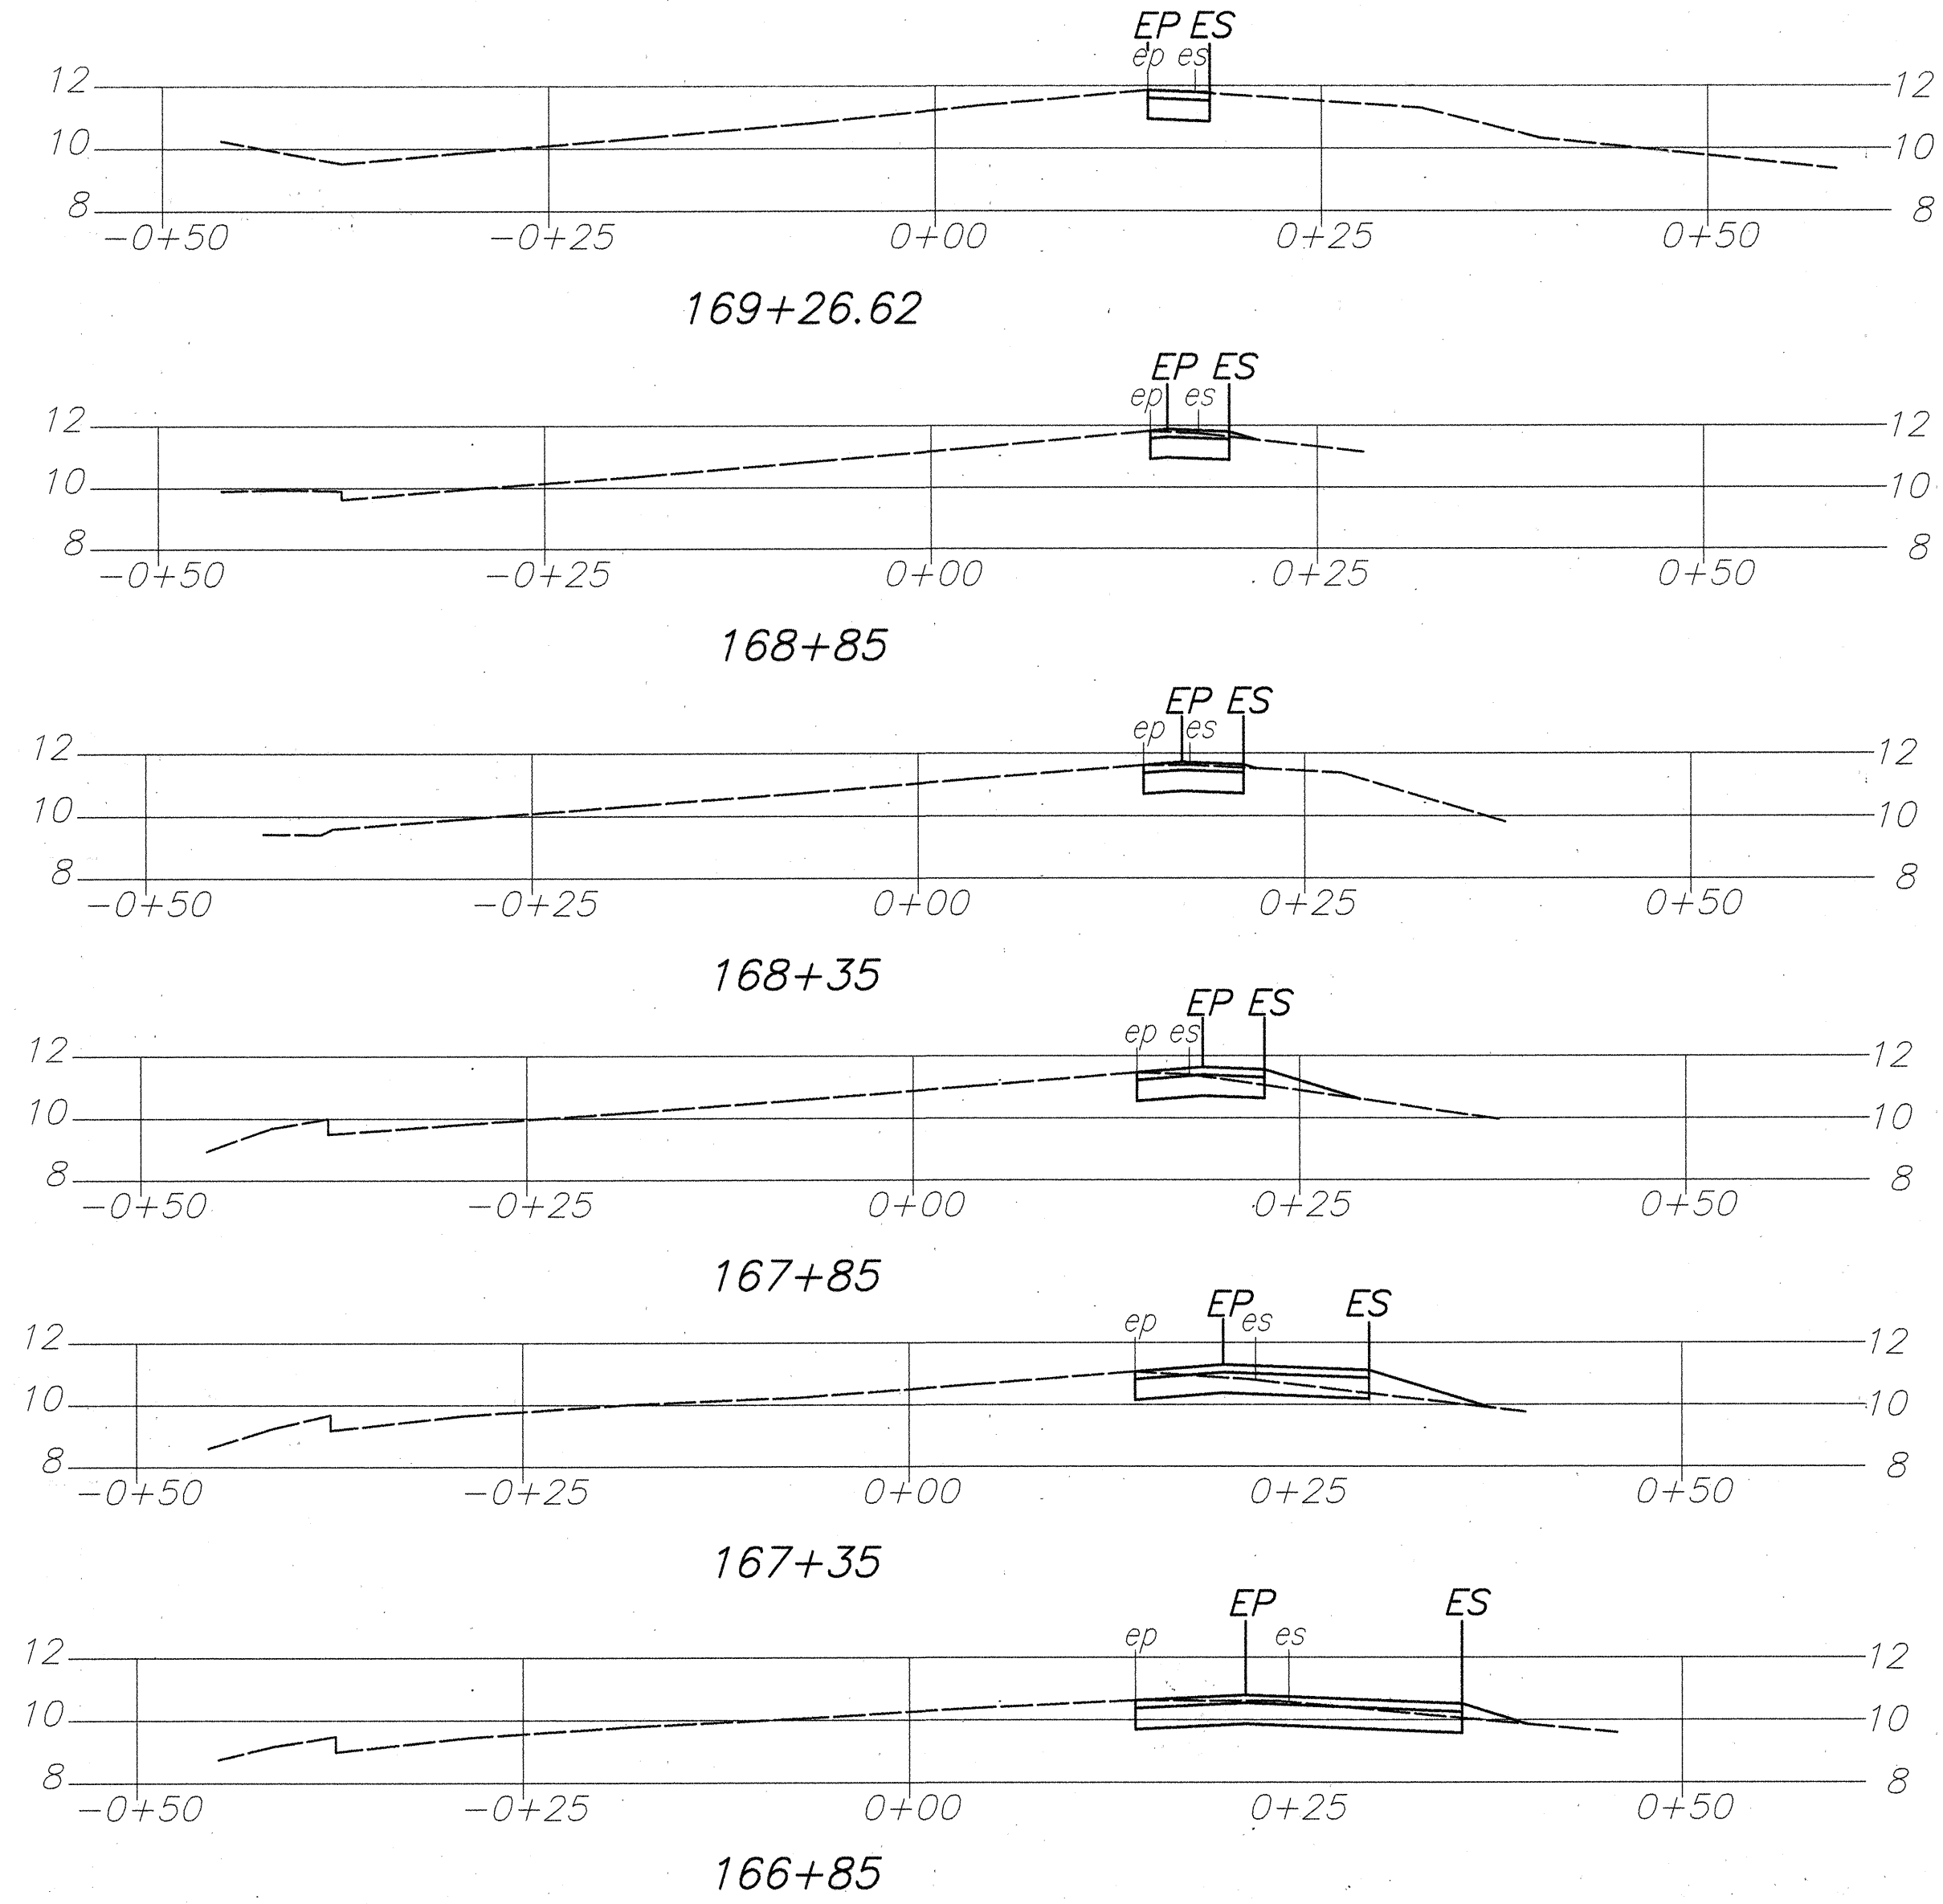


FED. ROAD DIST. NO.	STATE	FED. AID PROJ. NO.	FISCAL YEAR	SHEET NO.	TOTAL SHEETS
HAWAII	HAW.	STP-093-1(16)	1995	15	16

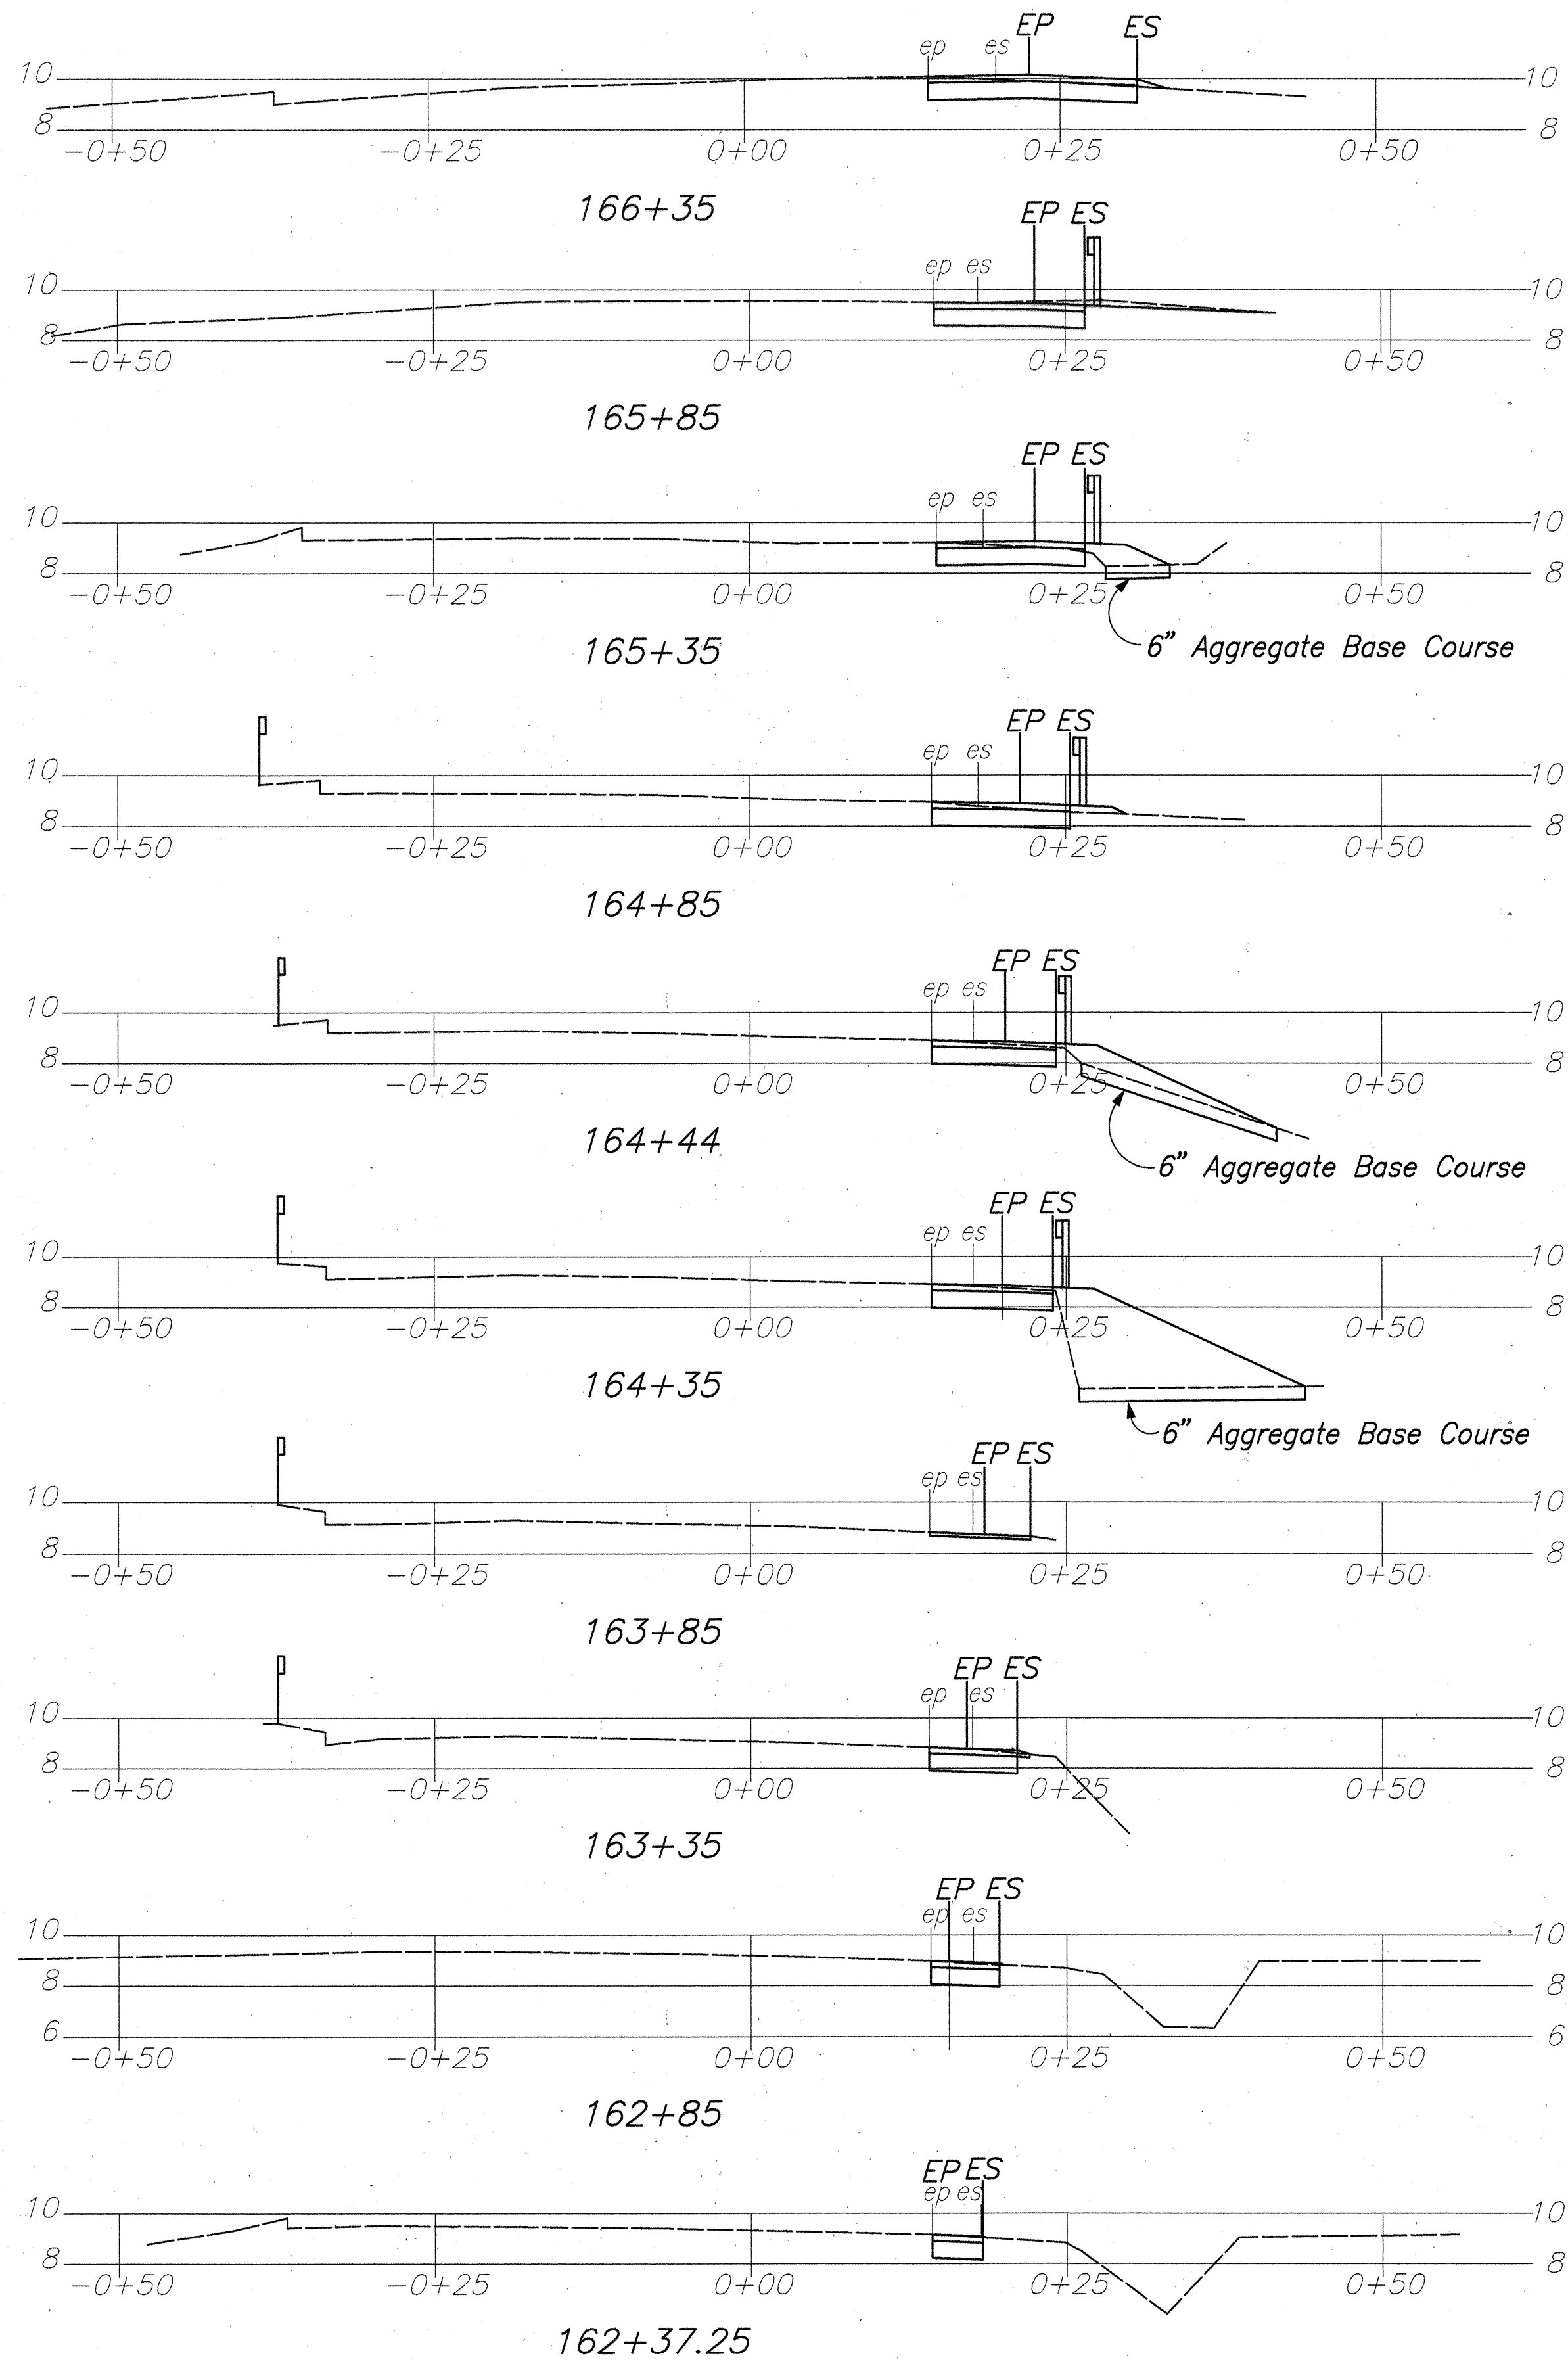

ORIGINAL PLAN	DATE
DESIGNED BY	
TRACED BY	
NOTE BOOK	
QUANTITIES BY	
CHECKED BY	

Scales: Hor. 1" = 10'
Vert. 1" = 5'

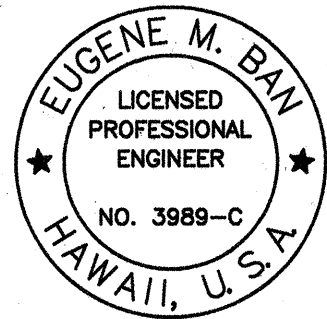

THIS WORK WAS PREPARED BY ME
OR UNDER MY SUPERVISION

STATE OF HAWAII
DEPARTMENT OF TRANSPORTATION
HIGHWAYS DIVISION

CROSS SECTIONS

FARRINGTON HIGHWAY INTERSECTION
IMPROVEMENTS AT MA'IPALAOA ROAD
F.A.P. NO. STP-093-1(16)

SCALE: AS NOTED DATE: April 1966

SHEET No. 1 OF 1 SHEETS