
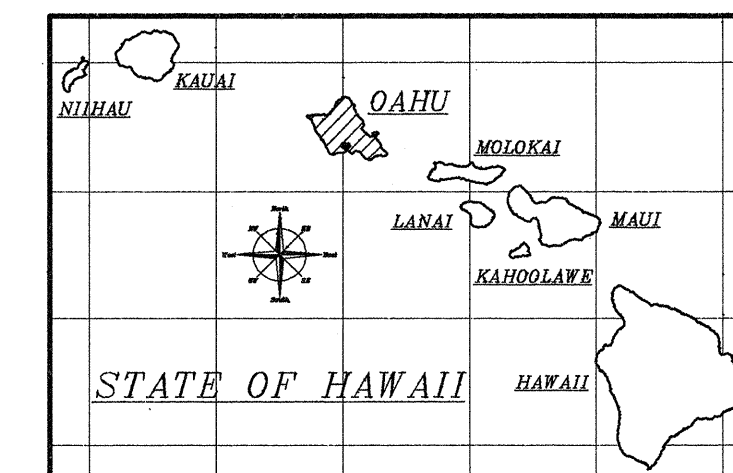




FED. ROAD DIST. NO.	STATE	PROJ. NO.	FISCAL YEAR	SHEET NO.	TOTAL SHEETS
HAWAII	HAW.	93A-02-95	1996	1	13

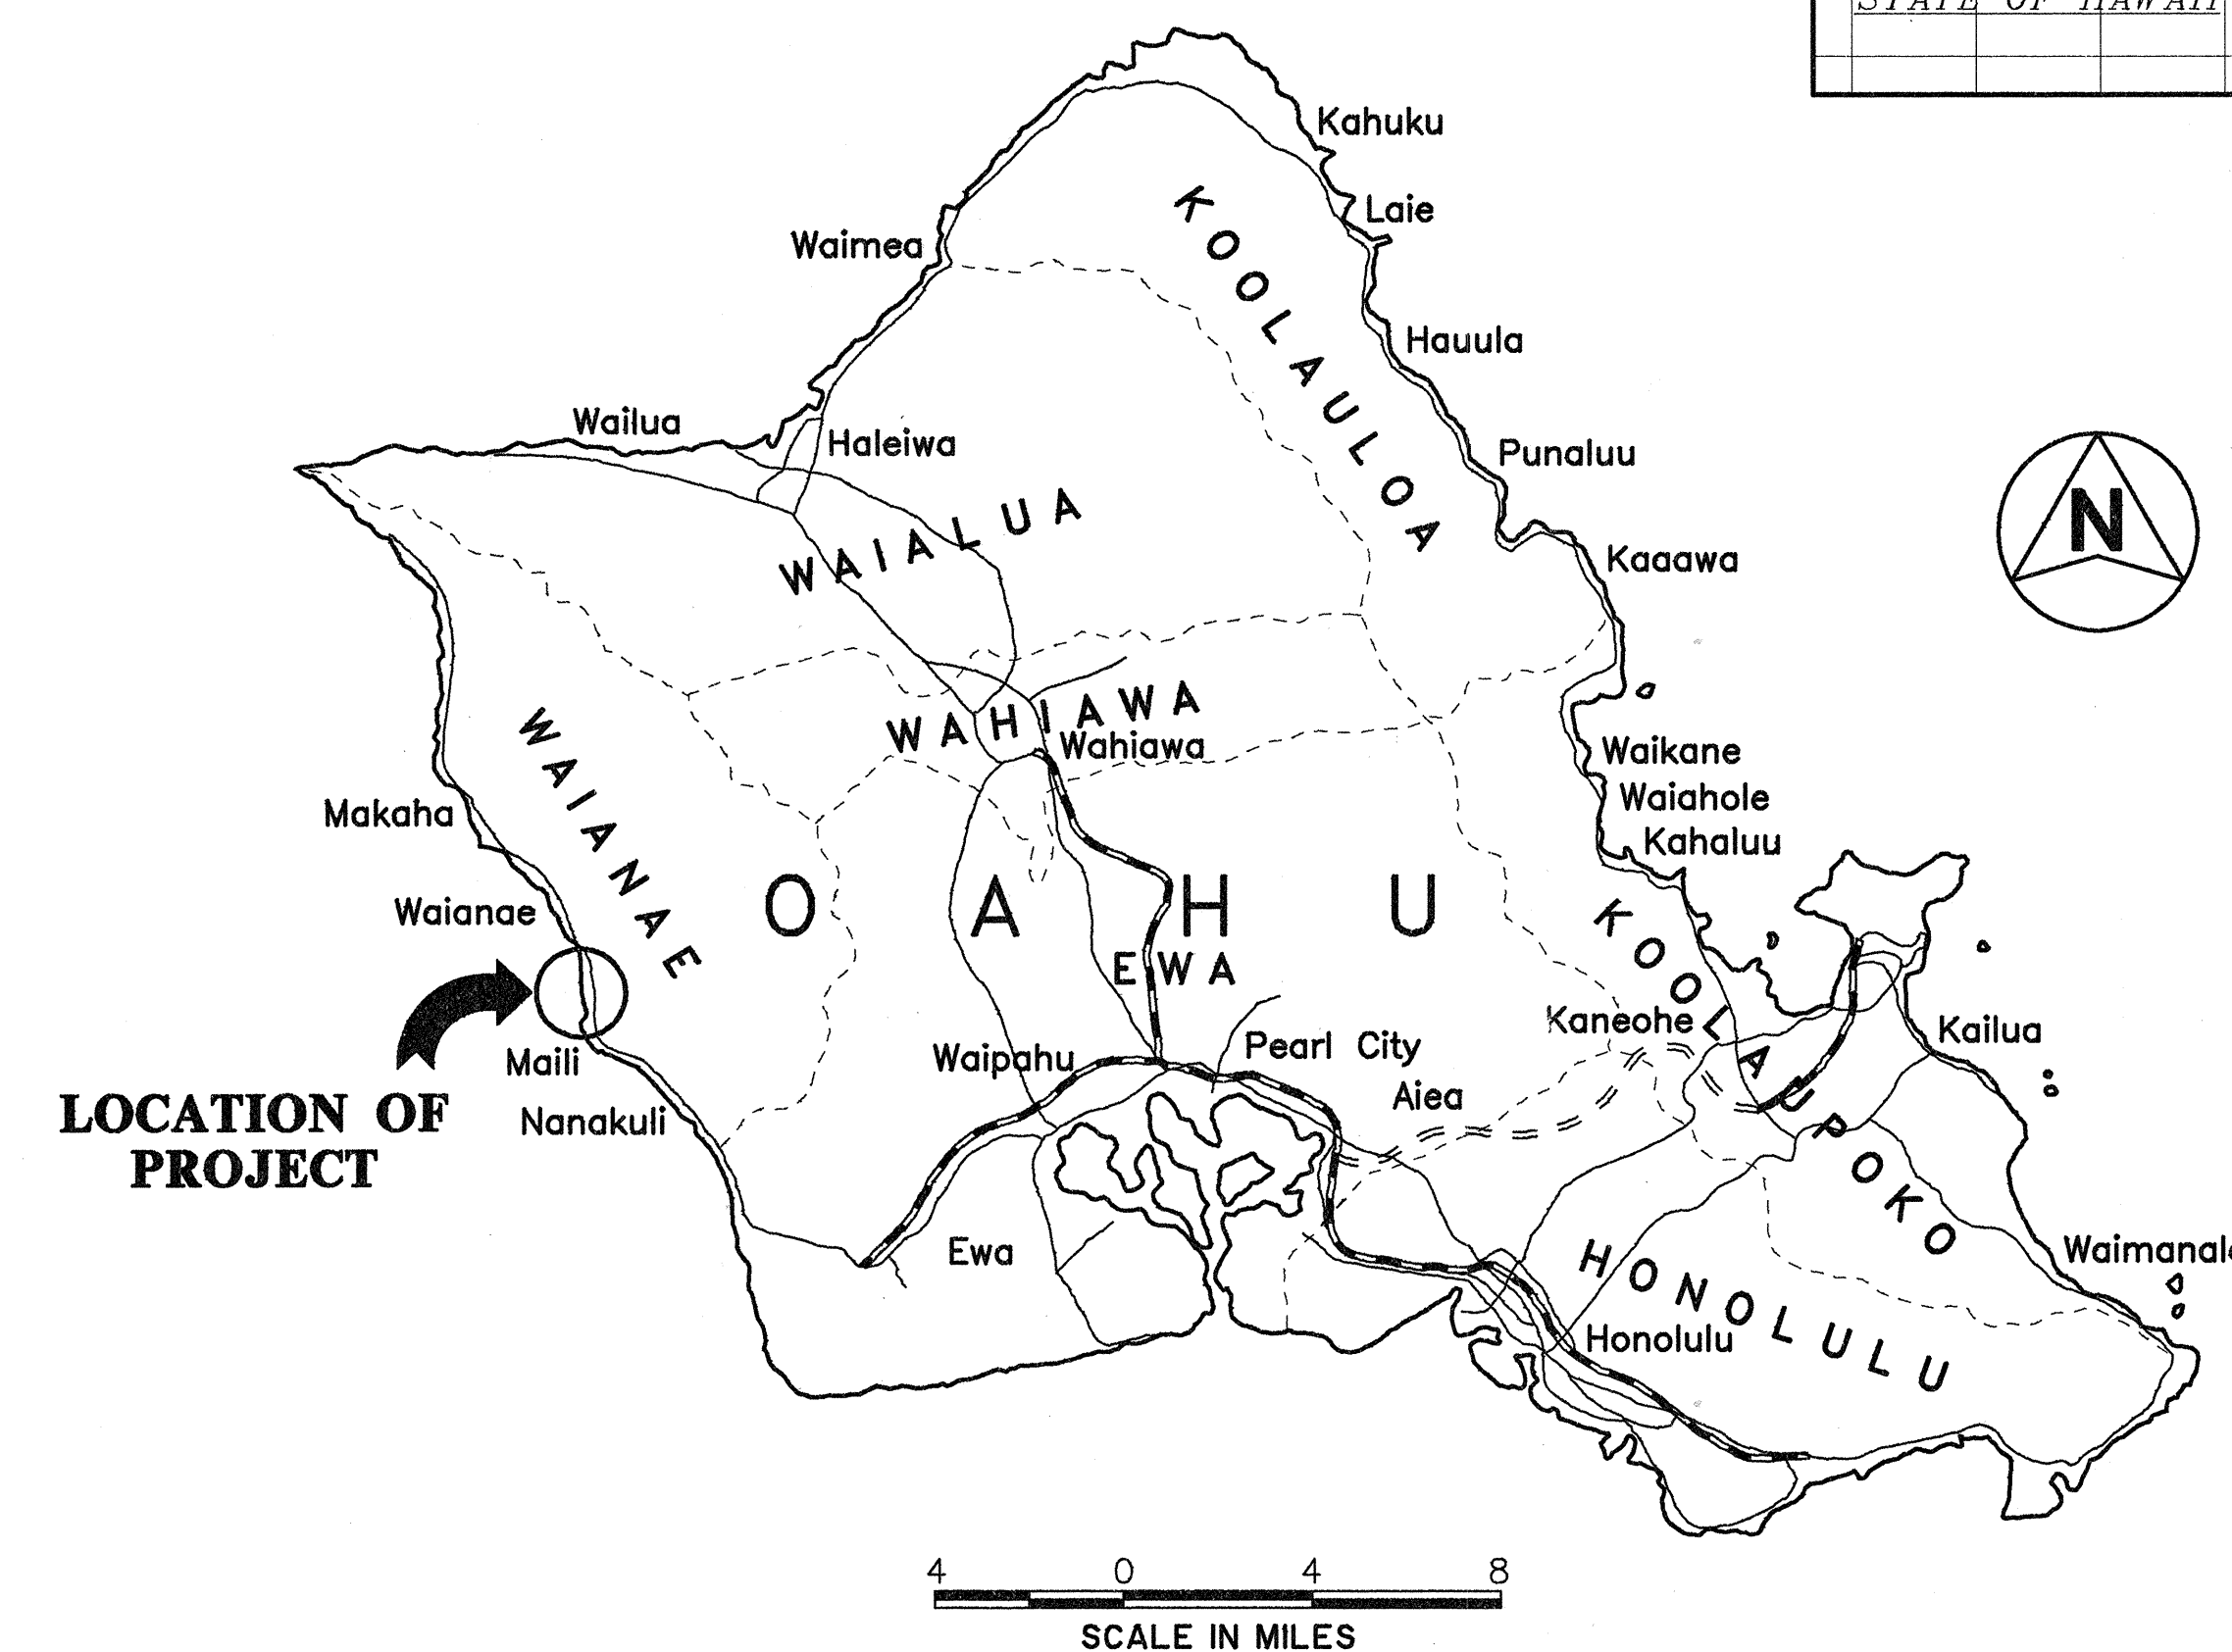

"AS-BUILT" PLANS FOR FARRINGTON HIGHWAY LIGHTING IMPROVEMENTS MAIPELA STREET TO LUALEI PLACE

DISTRICT OF WAIANAE
ISLAND OF OAHU

LOCATION OF PROJECT

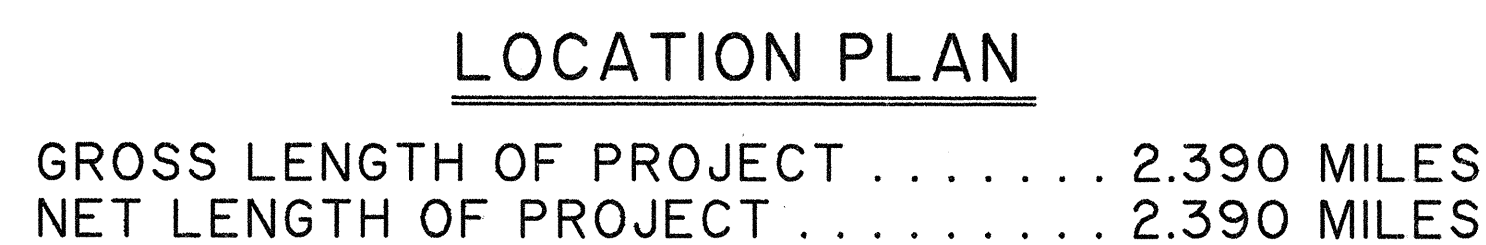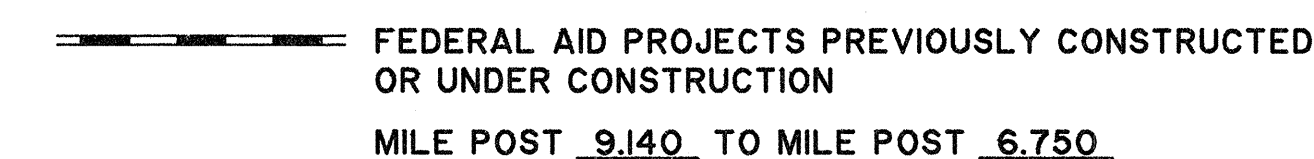

CHANGES MADE DURING CONSTRUCTION HAVE BEEN INCORPORATED ON THESE PLANS EXCEPT CHANGES IN THE ORIGINAL THEORETICAL QUANTITIES. FOR ACTUAL QUANTITIES, REFER TO PROJECT LEDGER AND/OR COMPUTATION BOOK.

Kelvin Akazawa 8-10-99
ACTING RESIDENT ENGINEER DATE

DEPARTMENT OF TRANSPORTATION STATE OF HAWAII	
APPROVED: <i>Kayn Kaganrich</i>	<i>5/28/91</i>
DIR. OF TRANSPORTATION	DATE

SHEET No. 1 OF 13 SHEETS