


INDEX TO DRAWINGS	
SHEET NO.	DESCRIPTION
1	TITLE SHEET
2	STANDARD PLANS SUMMARY
3	GENERAL NOTES
4	NPDES NOTES
5 - 15	TYPICAL SECTIONS
16 - 22	ROADWAY PLANS
23 - 24	DRAINAGE DETAILS
25	PAVEMENT MARKING, LEGEND, DETAILS AND NOTES
26 - 32	PAVEMENT MARKING & STRIPING PLAN
33	SWING SIGN BRACKET DETAIL
34	STREET NAME SIGN LAYOUT AND DETAILS
* 35	LOOP DETECTOR PLAN
36	LOOP DETECTOR DETAILS
37	MISC. TRAFFIC SUMMARIES

* PLAN SHEET NO. 35A IS A SUPPLEMENT SHEET TO THE CONTRACT PLANS. NEW SHEET TOTAL = 38


DESIGN UNIT "E"
DESIGNED BY J. FUJIMOTO
P. S. & E. BY 587-2249
PHONE MAY, 1996
DATE

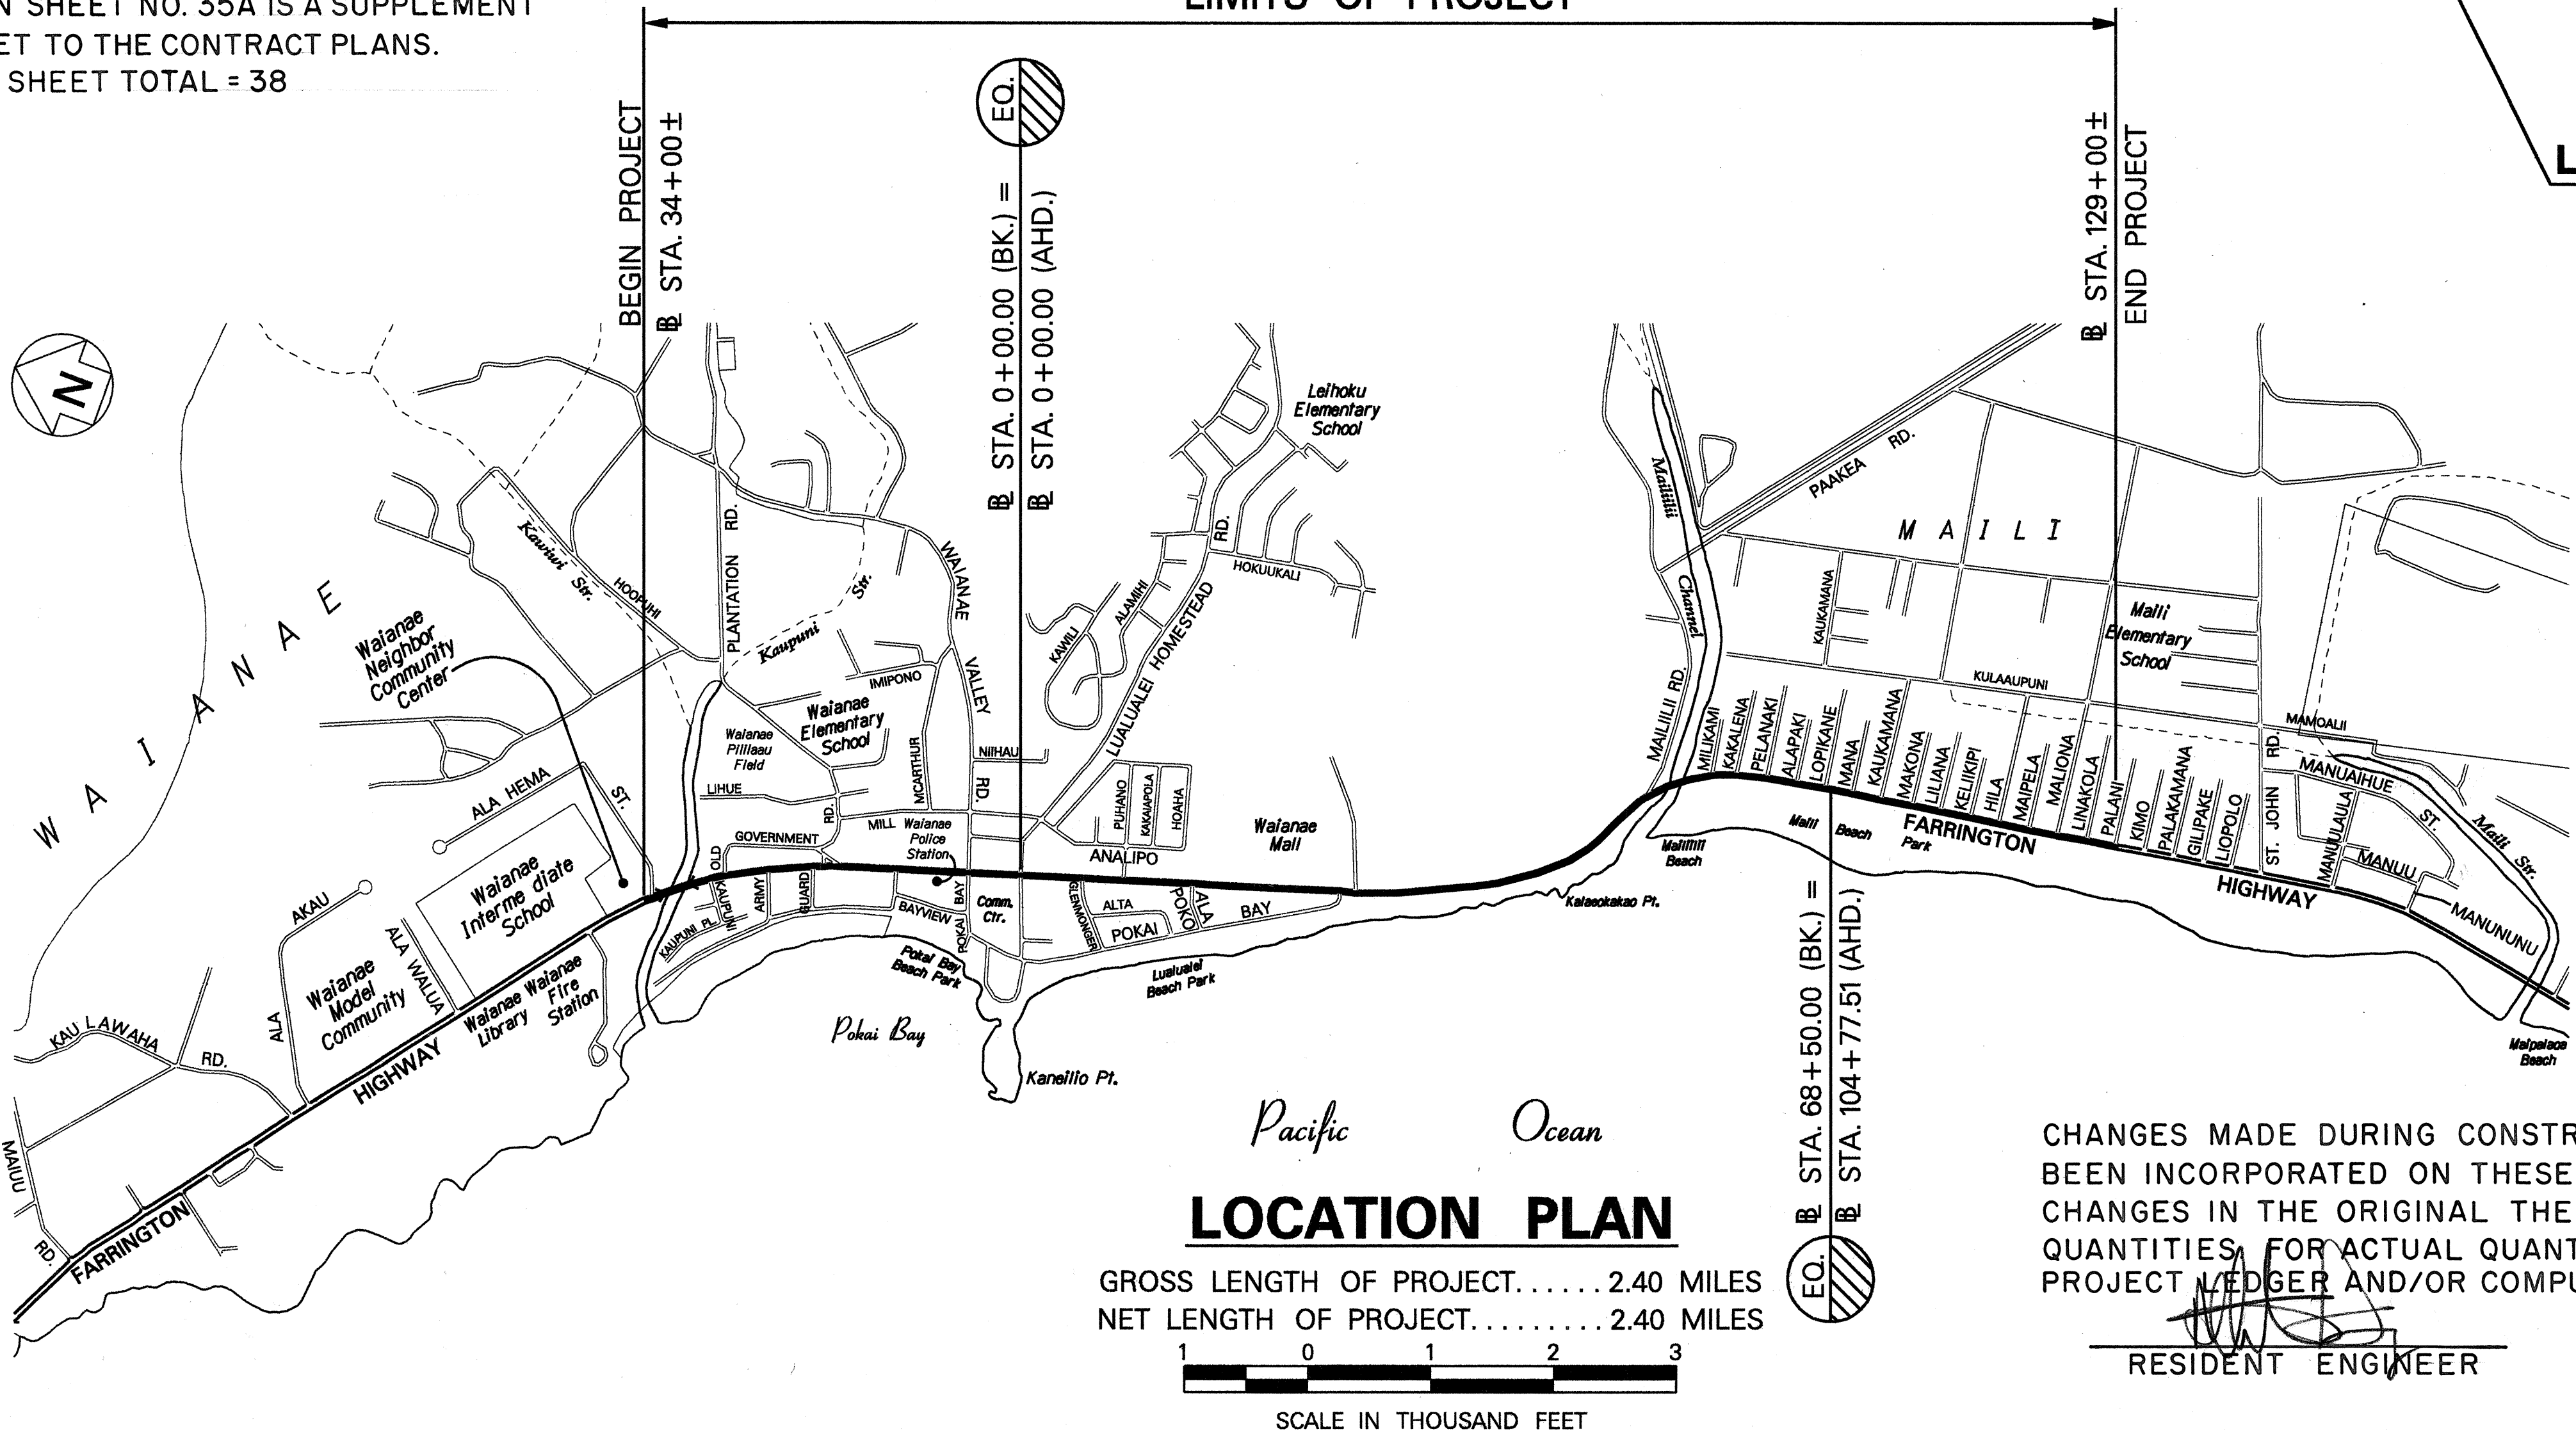

LOCATION PLAN
GROSS LENGTH OF PROJECT.....2.40 MILES
NET LENGTH OF PROJECT.....2.40 MILES
SCALE IN THOUSAND FEET

CHANGES MADE DURING CONSTRUCTION HAVE BEEN INCORPORATED ON THESE PLANS EXCEPT CHANGES IN THE ORIGINAL THEORETICAL QUANTITIES. FOR ACTUAL QUANTITIES, REFER TO PROJECT LEDGER AND/OR COMPUTATION BOOK.
RESIDENT ENGINEER
DATE 10/2/98

STATE OF HAWAII
DEPARTMENT OF TRANSPORTATION
HIGHWAYS DIVISION
HONOLULU, HAWAII
"AS-BUILT"
PLANS FOR
FARRINGTON HIGHWAY RESURFACING
ALA HEMA STREET TO PALANI STREET
FEDERAL AID PROJECT NO. STP-093-1(14)
DISTRICT OF WAIANAE
ISLAND OF OAHU

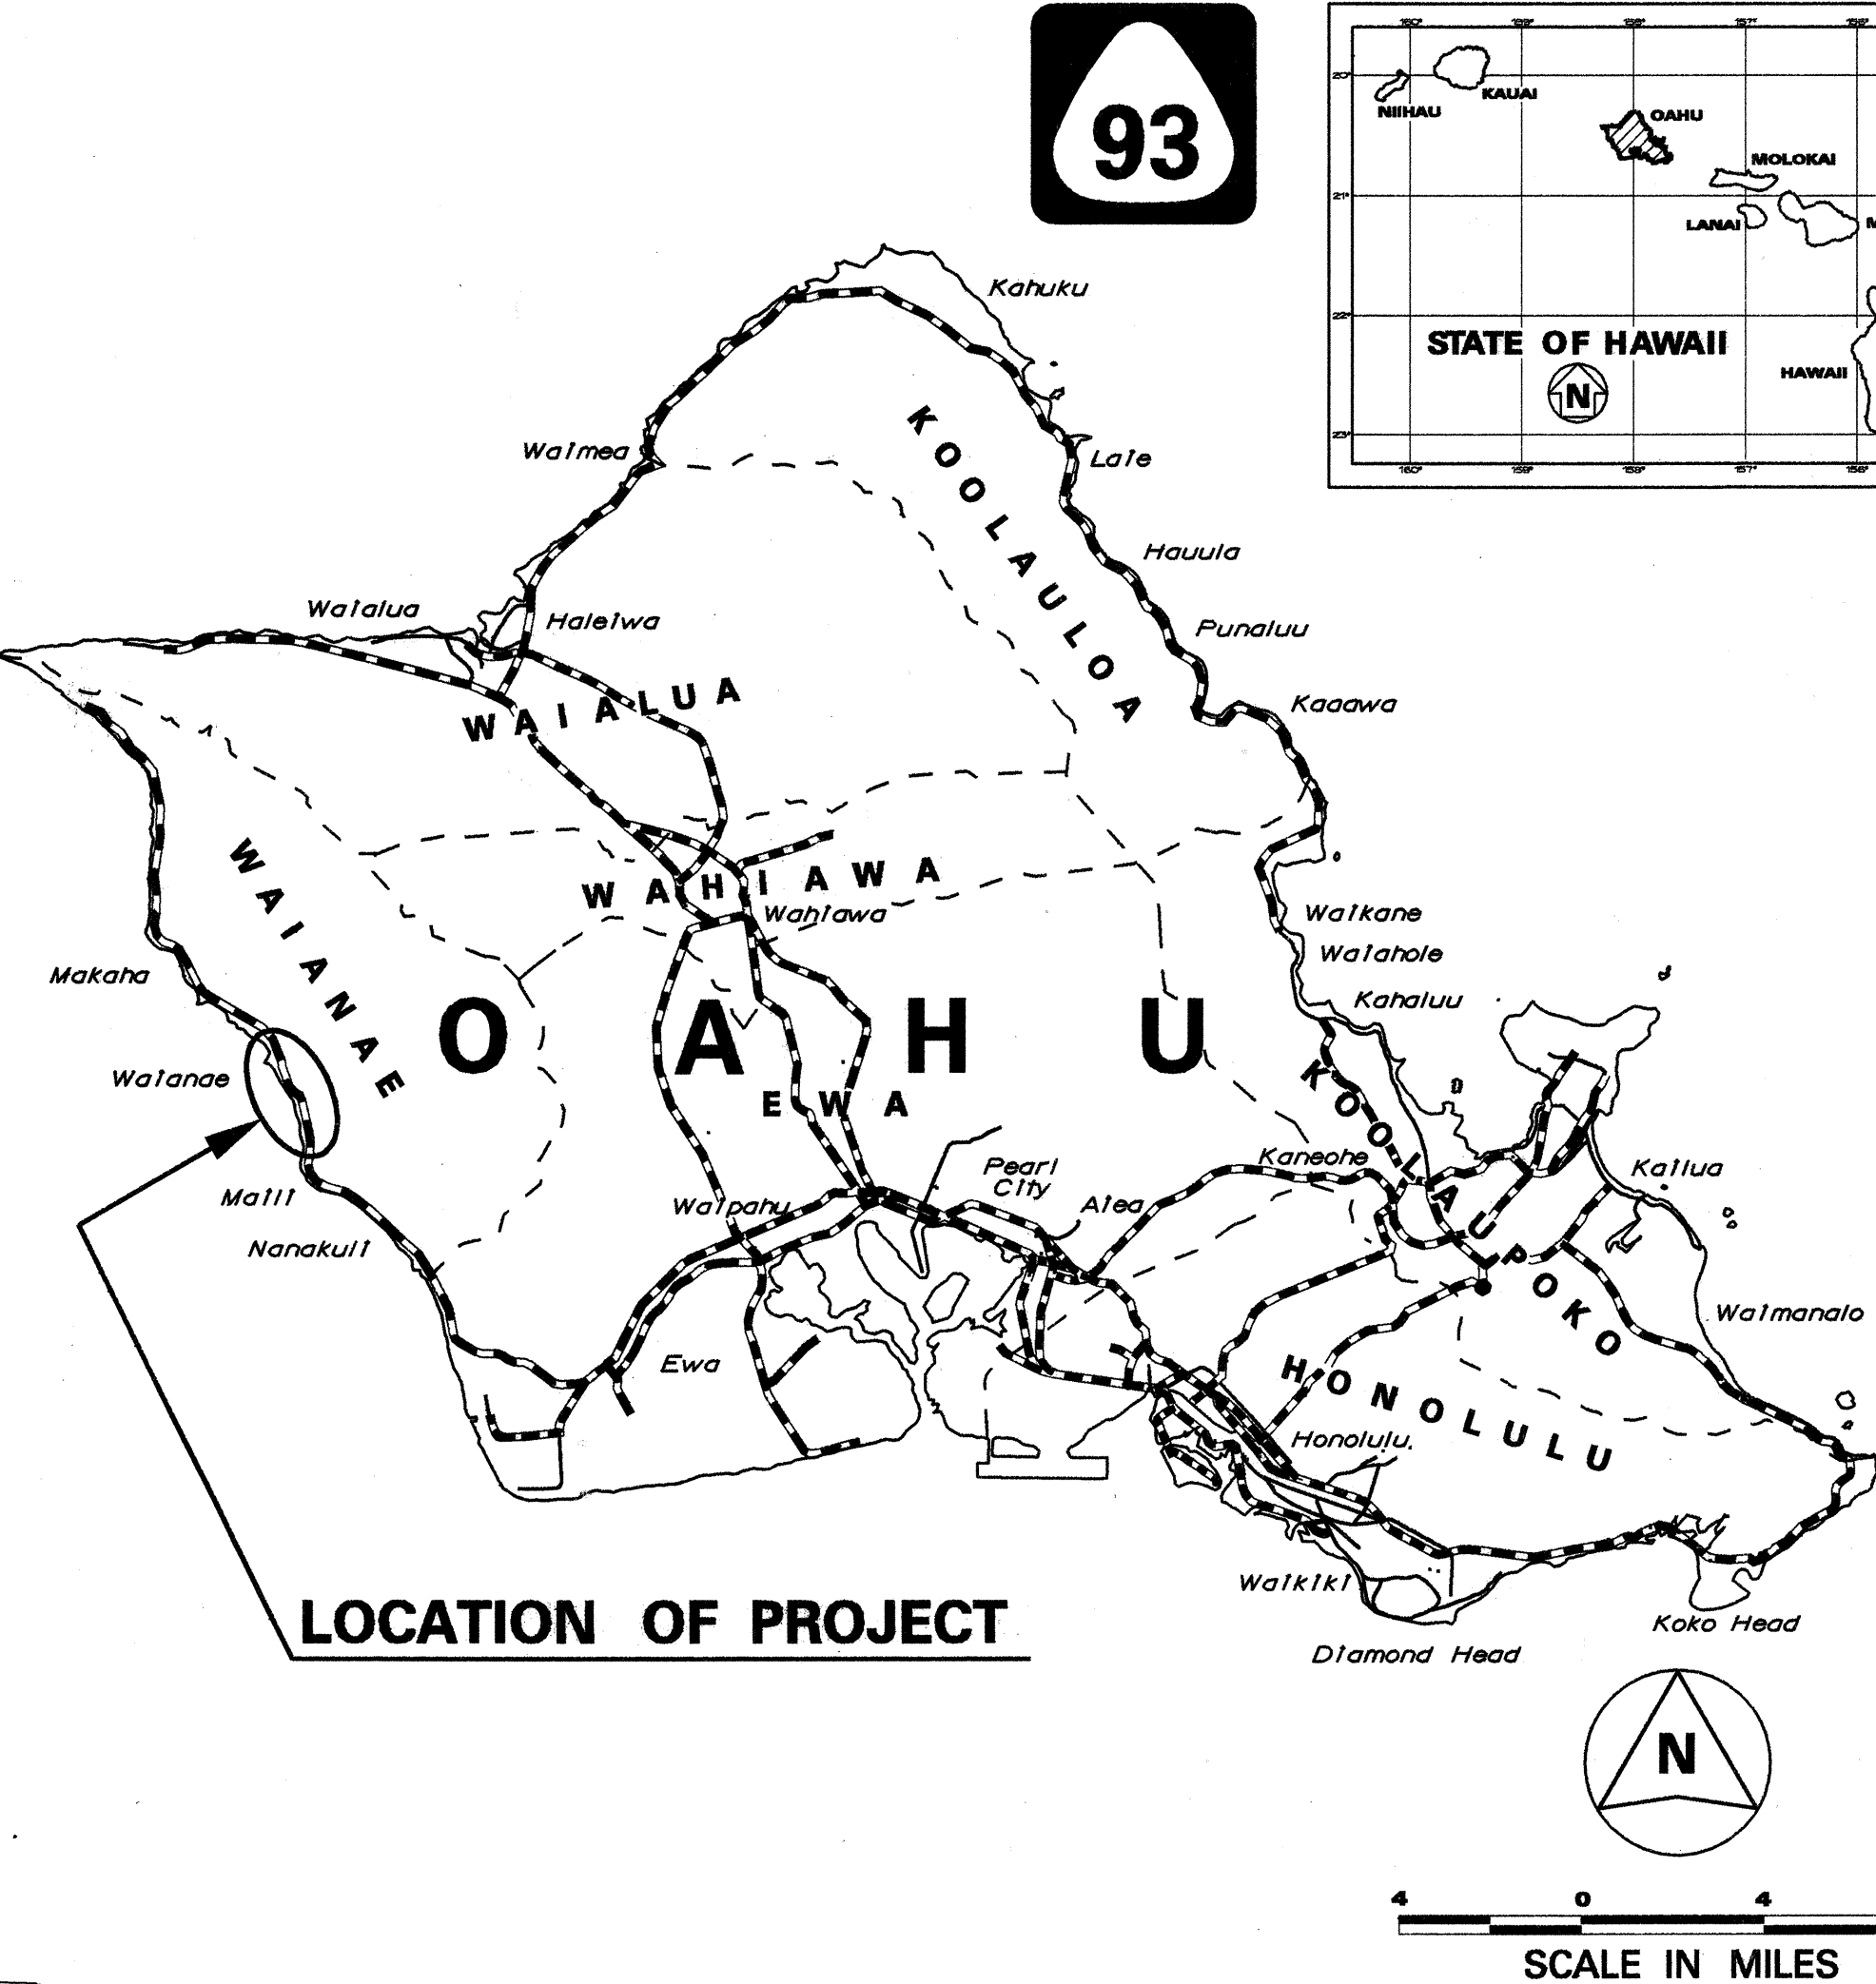

FEDERAL AID PROJECTS PREVIOUSLY CONSTRUCTED OR UNDER CONSTRUCTION
MILE POST 11.40 TO MILE POST 9.00

DESIGN DESIGNATION

ADT (1996)	40,480
ADT (2006)	57,300
DHV	4,300
D	65/35
T ₂₄	3.5 %
T _{DES}	5.0 %
V	35/45 M.P.H.

DEPARTMENT OF TRANSPORTATION
STATE OF HAWAII
APPROVED: [Signature]
DIR. OF TRANSPORTATION
DATE 7/2/96

FED. ROAD DIST. NO.	STATE	FED. AID PROJ. NO.	FISCAL YEAR	SHEET NO.	TOTAL SHEETS
HAWAII	HAW.	STP-093-1(14)	1996	1	37

