

INDEX TO DRAWINGS	
SHEET NO.	DESCRIPTION
1	TITLE SHEET
2	STANDARD PLANS SUMMARY
3-4	GENERAL NOTES
5	EXISTING CONDITION & SITE LAYOUT PLAN
6-9	TRAFFIC CONTROL PLANS
10	SYMBOL LIST
11	GENERAL NOTES
12	TRAFFIC SIGNAL PLAN
13	TRAFFIC SIGNAL INTERCONNECT PLAN
14	TRAFFIC SIGNAL SCHEDULE & DETAILS
15	TRAFFIC SIGNAL DETAILS
16	CONCRETE BASE DETAILS
17	LOOP DETECTOR DETAILS
18	TRAFFIC SIGNAL STANDARD & SIGNAL HEAD DETAILS

STATE OF HAWAII
DEPARTMENT OF TRANSPORTATION
HIGHWAYS DIVISION
HONOLULU, HAWAII




"AS-BUILT"

PLANS FOR
FARRINGTON HIGHWAY
INTERSECTION IMPROVEMENTS AT
PUHANO STREET

PROJECT NO. 93A-03-94

DISTRICT OF WAIANAE
ISLAND OF OAHU

FED. ROAD DIST. NO.	STATE	PROJ. NO.	FISCAL YEAR	SHEET NO.	TOTAL SHEETS
HAWAII	HAW.	93A-03-94	1996	1	18

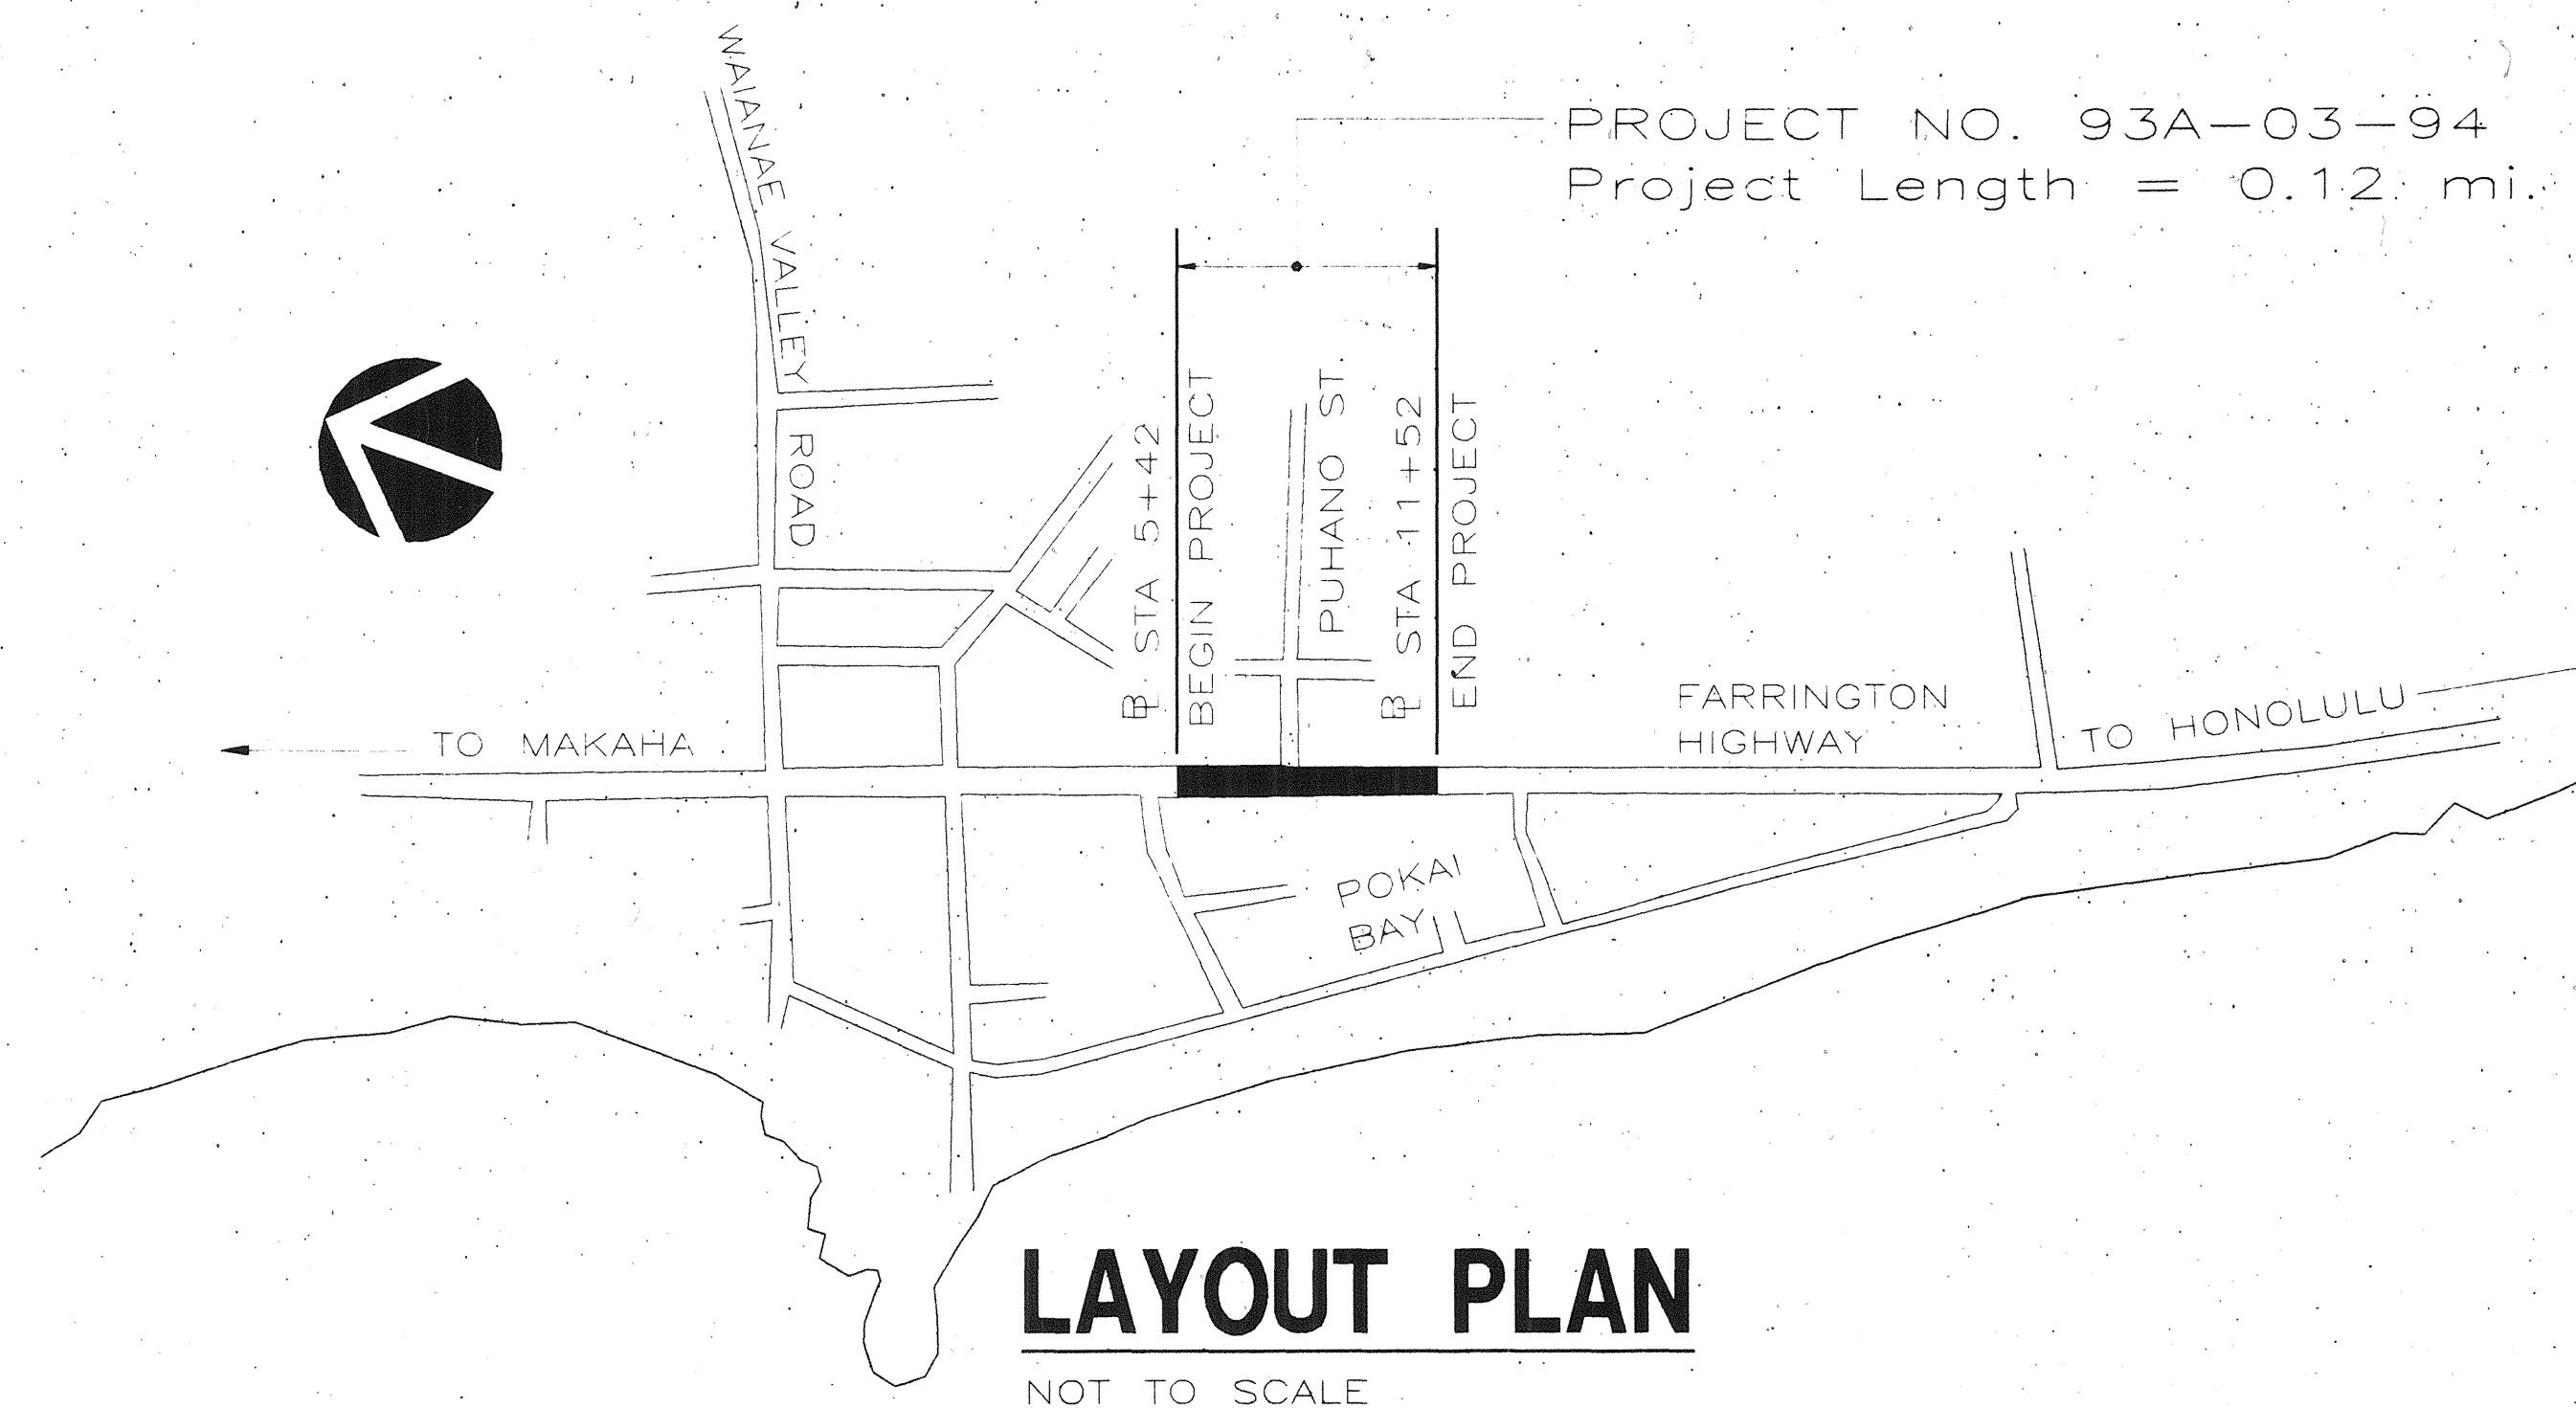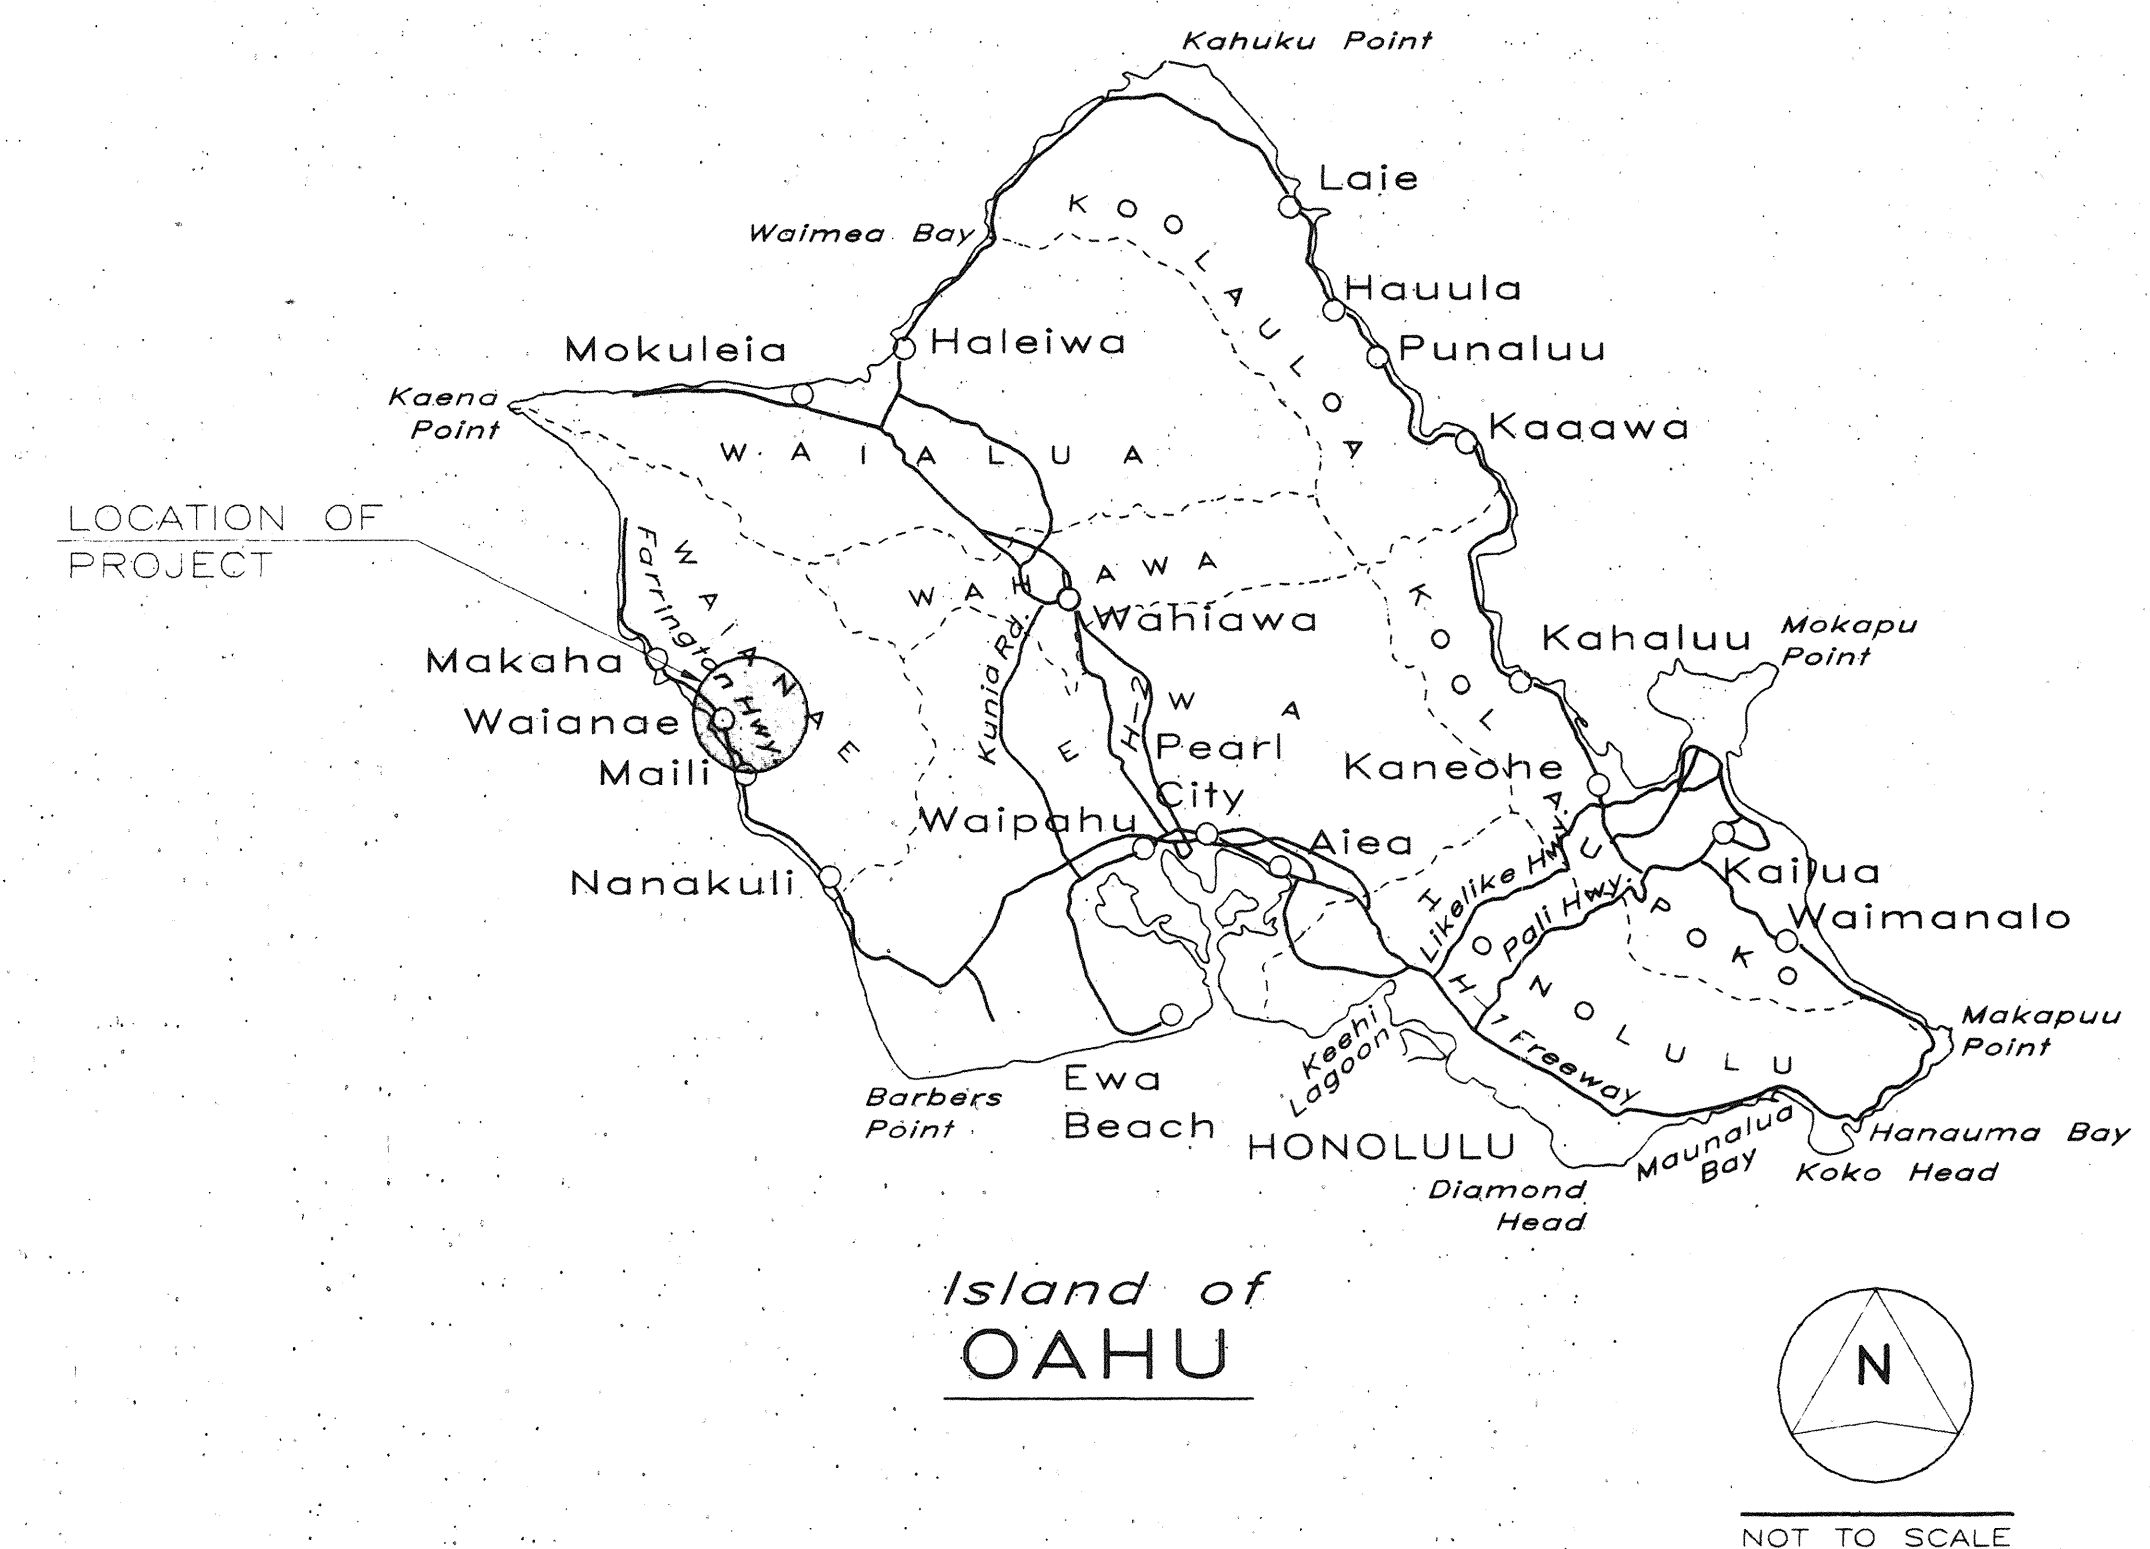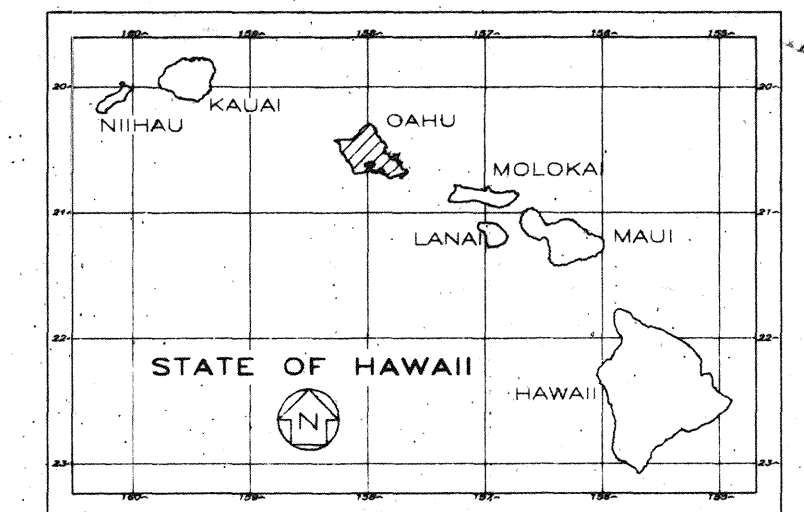

CHANGES MADE DURING CONSTRUCTION HAVE BEEN
NOTED IN RED ON THESE TRACINGS AND CHECKED BY:

RESIDENT ENGINEER

DATE

DEPARTMENT OF TRANSPORTATION
STATE OF HAWAII

APPROVED: *Kayn Koyashida* 5/24/96
DATE

DIR. OF TRANSPORTATION

SAM O. HIROTA, INC.
DESIGNED BY

K. KUNISHIGE
P. S. & E. BY

587-2173
PHONE

JUNE 1996
DATE